


FED. ROAD DIST. NO.	STATE	FED. AID PROJ. NO.	FISCAL YEAR	SHEET NO.	TOTAL SHEETS
HAWAII	HAW.	7-JO	1959	8	15


FINAL SURVEY	DATE	BY
SURVEYED		HFC
PLOTTED		GVC
NOTES BOOK		6/1/59
AREAS CHECKED		6/1/59

ORIGINAL SURVEY	DATE	BY
SURVEYED		
PLOTTED		
NOTES BOOK		
AREAS CHECKED		

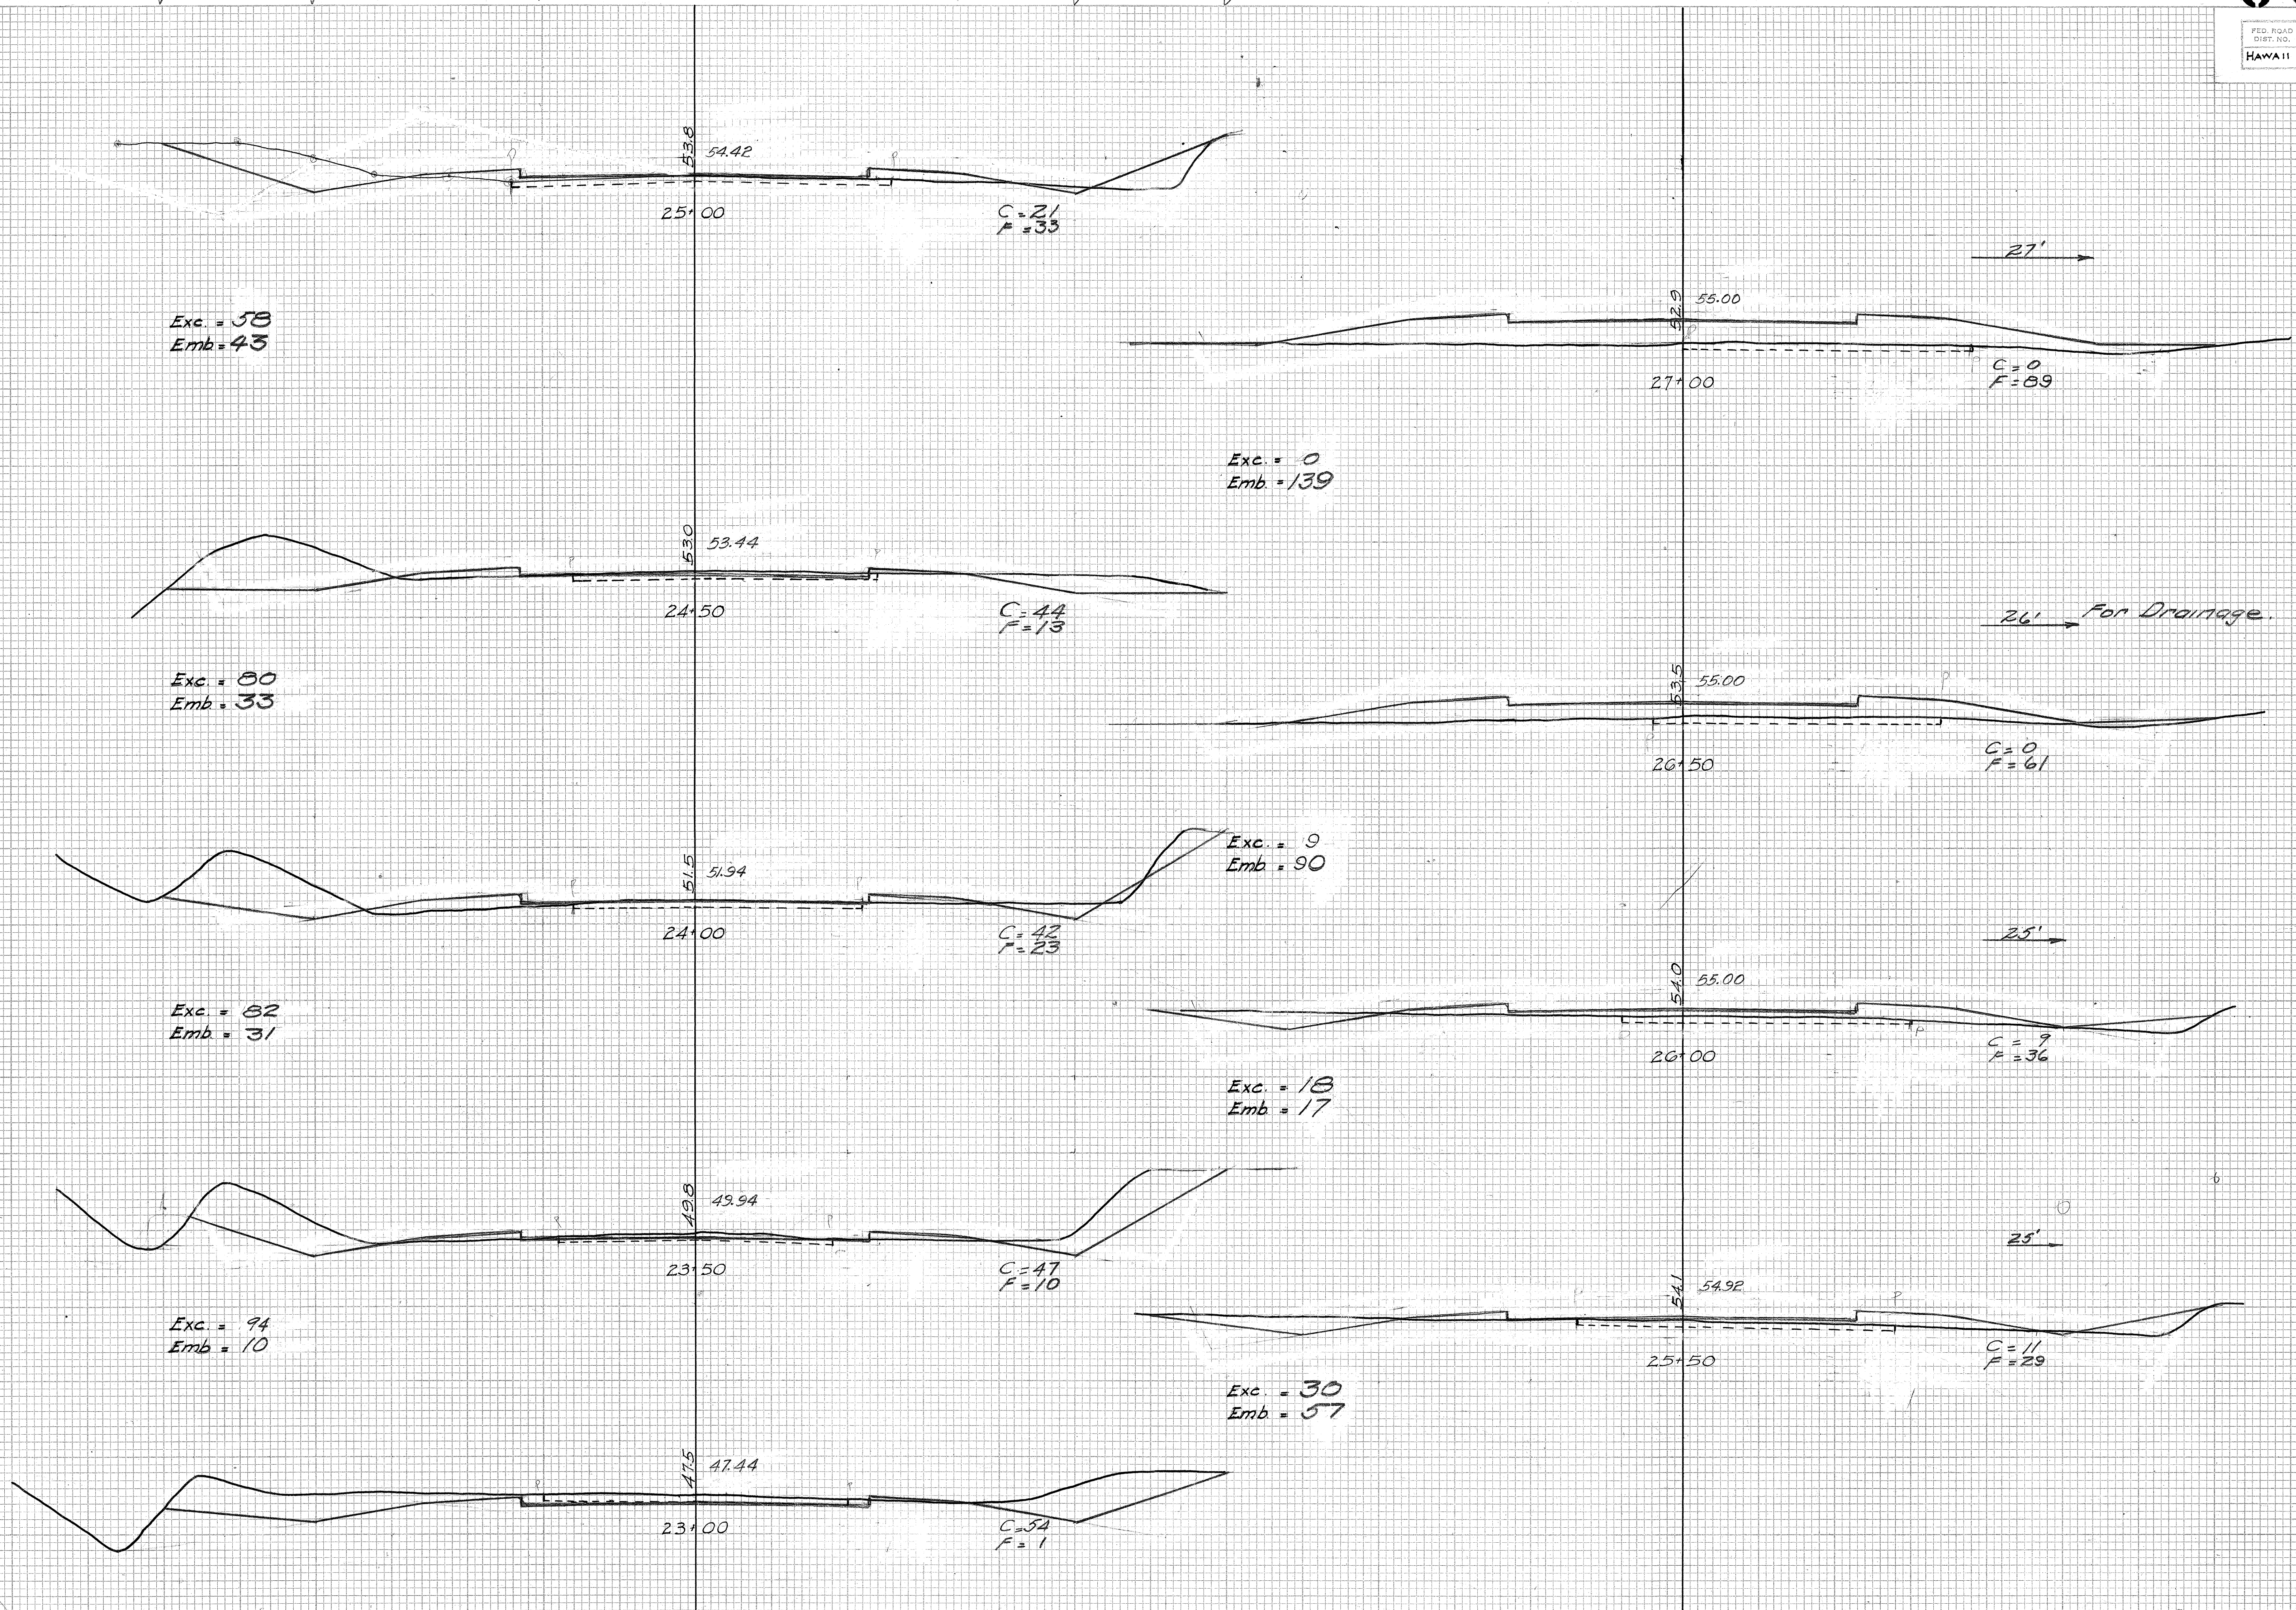

FINAL SURVEY	SURVEYED	BY	DATE
	PLOTTED	HHC	
	TEMPLATE	GVC	
NOTE BOOK	AREAS	HVC	
N.O.	AREAS CHECKED	6	10/27/80


ORIGINAL			
SURVEY	SURVEYED		
	PLOTTED		
	TEMPLATE		
NOTE BOOK	AREAS		
NO.	AREAS CHECKED		
	BY		DATE

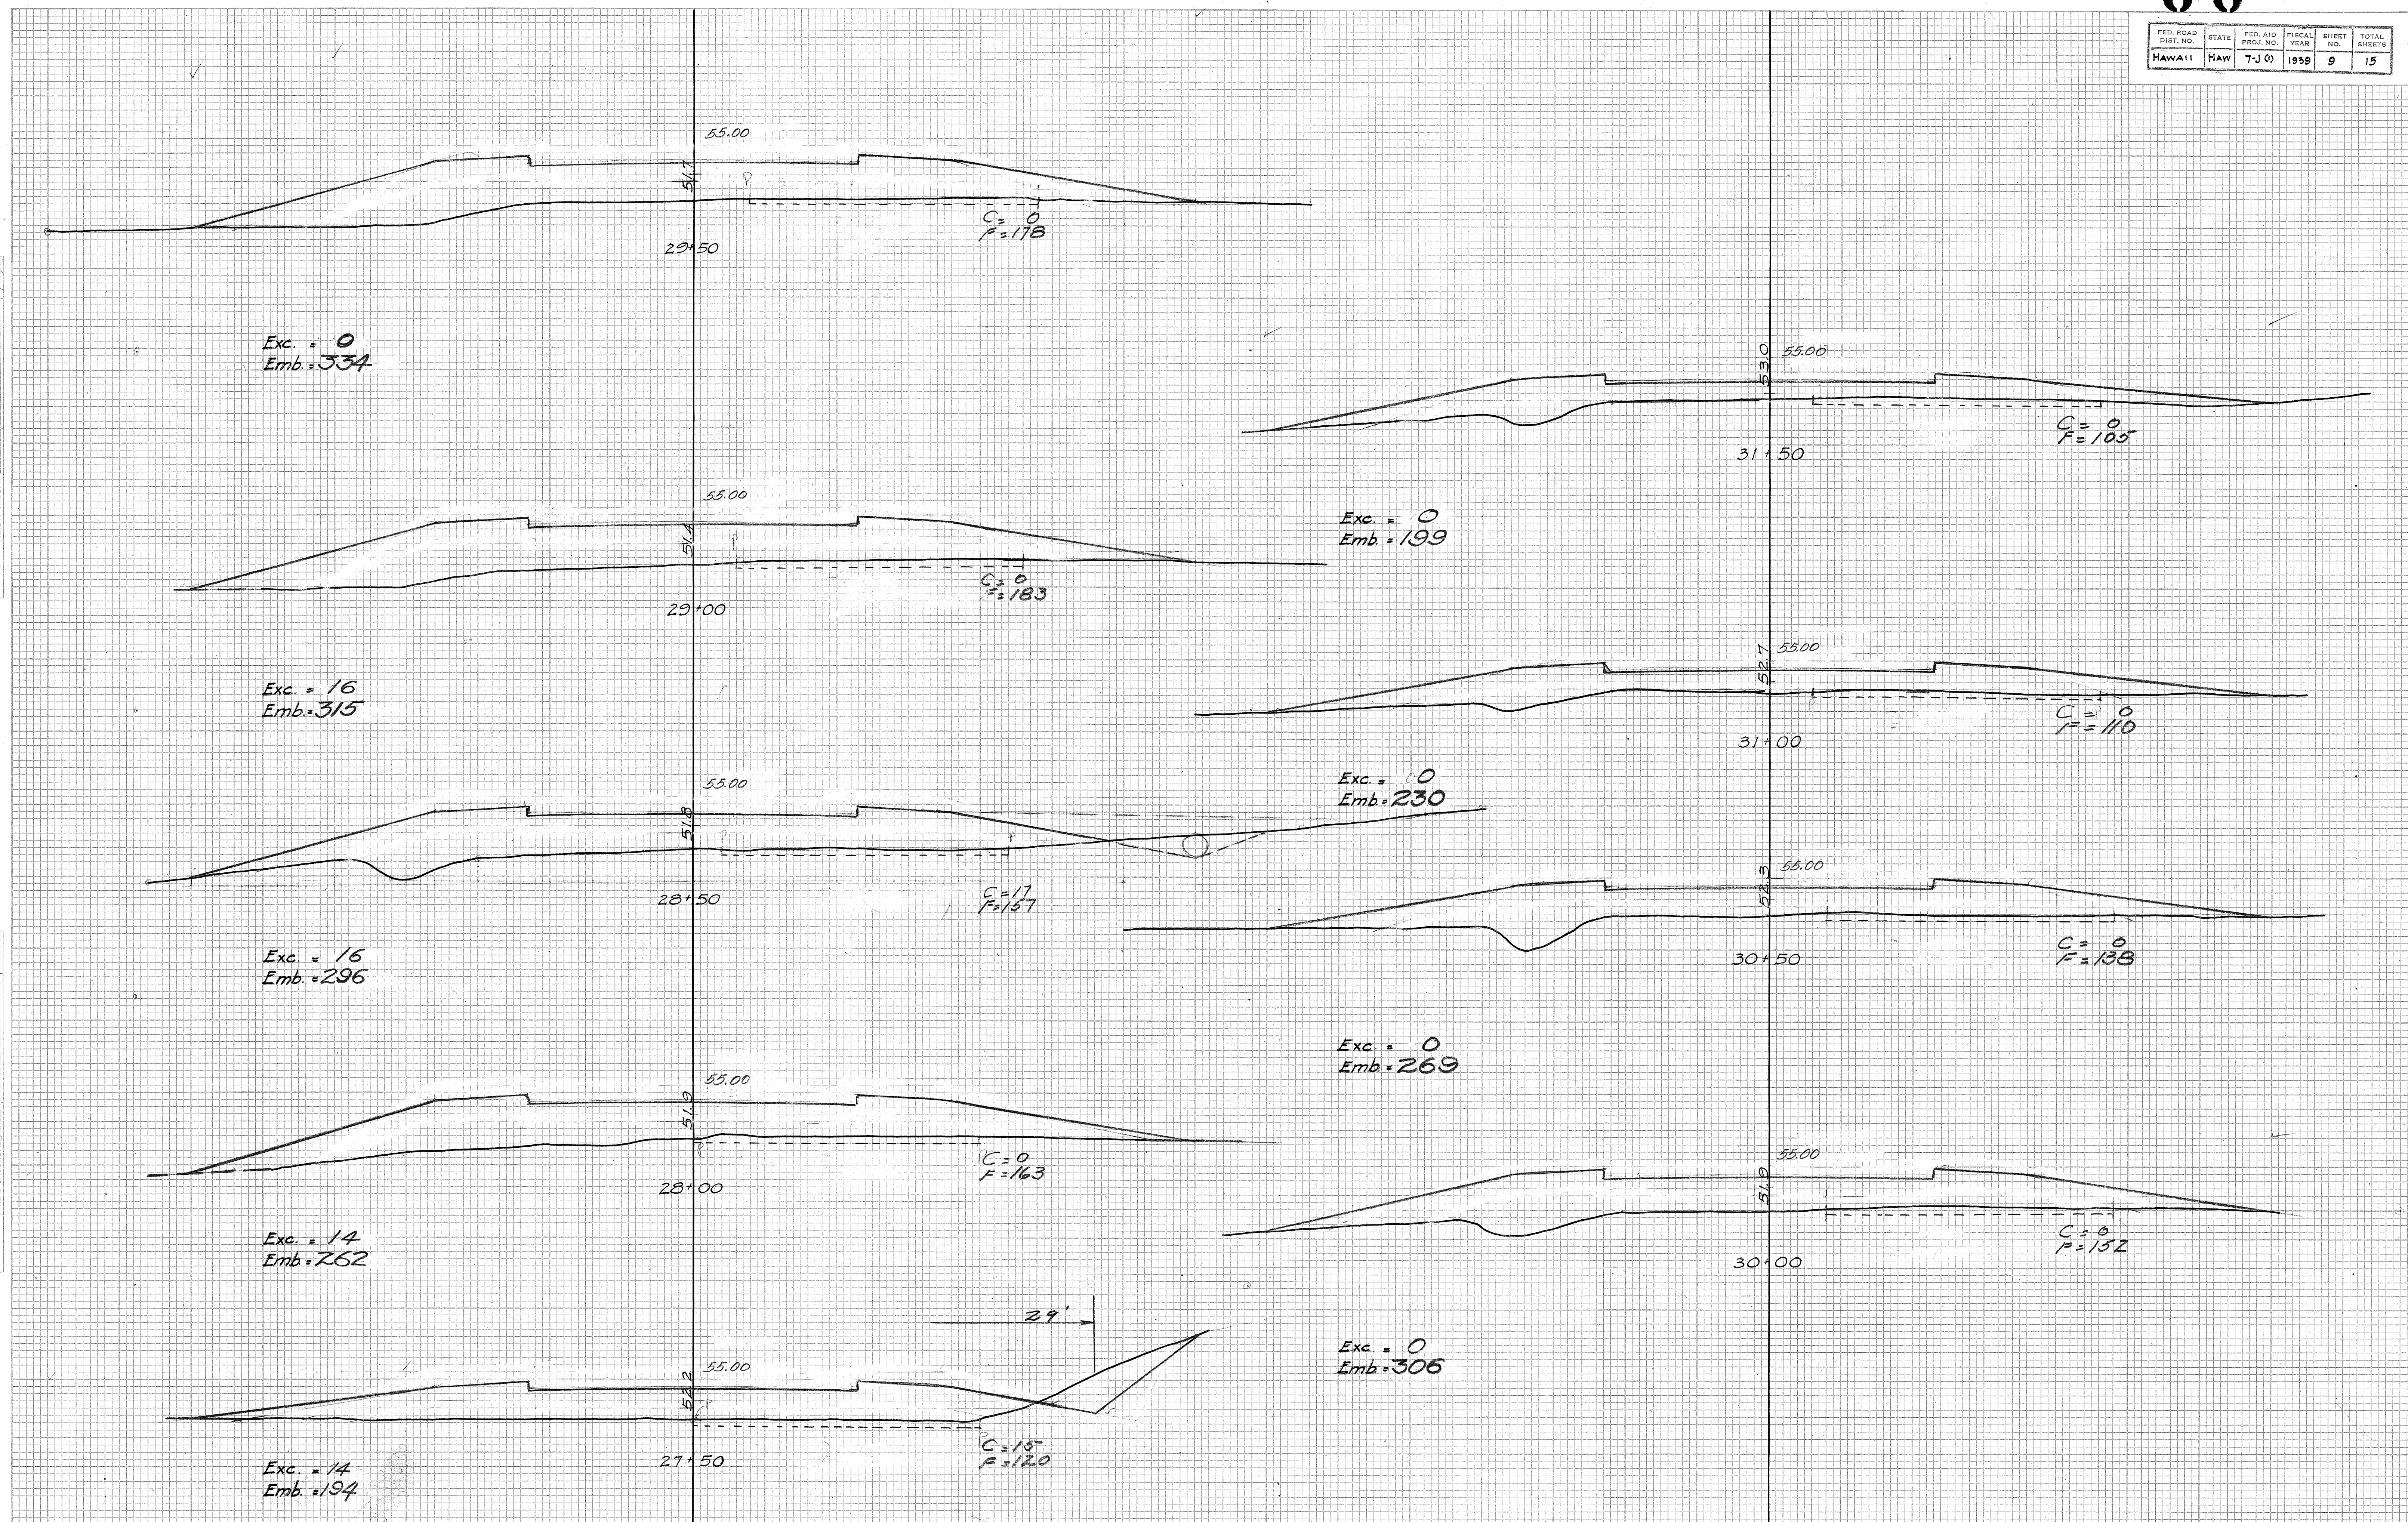

FED. ROAD DIST. NO.	STATE	FED. AID PROJ. NO.	FISCAL YEAR	SHEET NO.	TOTAL SHEETS
HAWAII	HAW	7-J (1)	1939	10	15

FINAL SURVEY	SURVEYED	BY	DATE
NOTE BOOK	PLOTTED	HFC	
NO.	TEMP. PLATE	GFC	
	AREAS CHECKED	GFC	10-2-39

ORIGINAL SURVEY	SURVEYED	BY	DATE
NOTE BOOK	PLOTTED		
NO.	TEMP. PLATE		
	AREAS CHECKED		

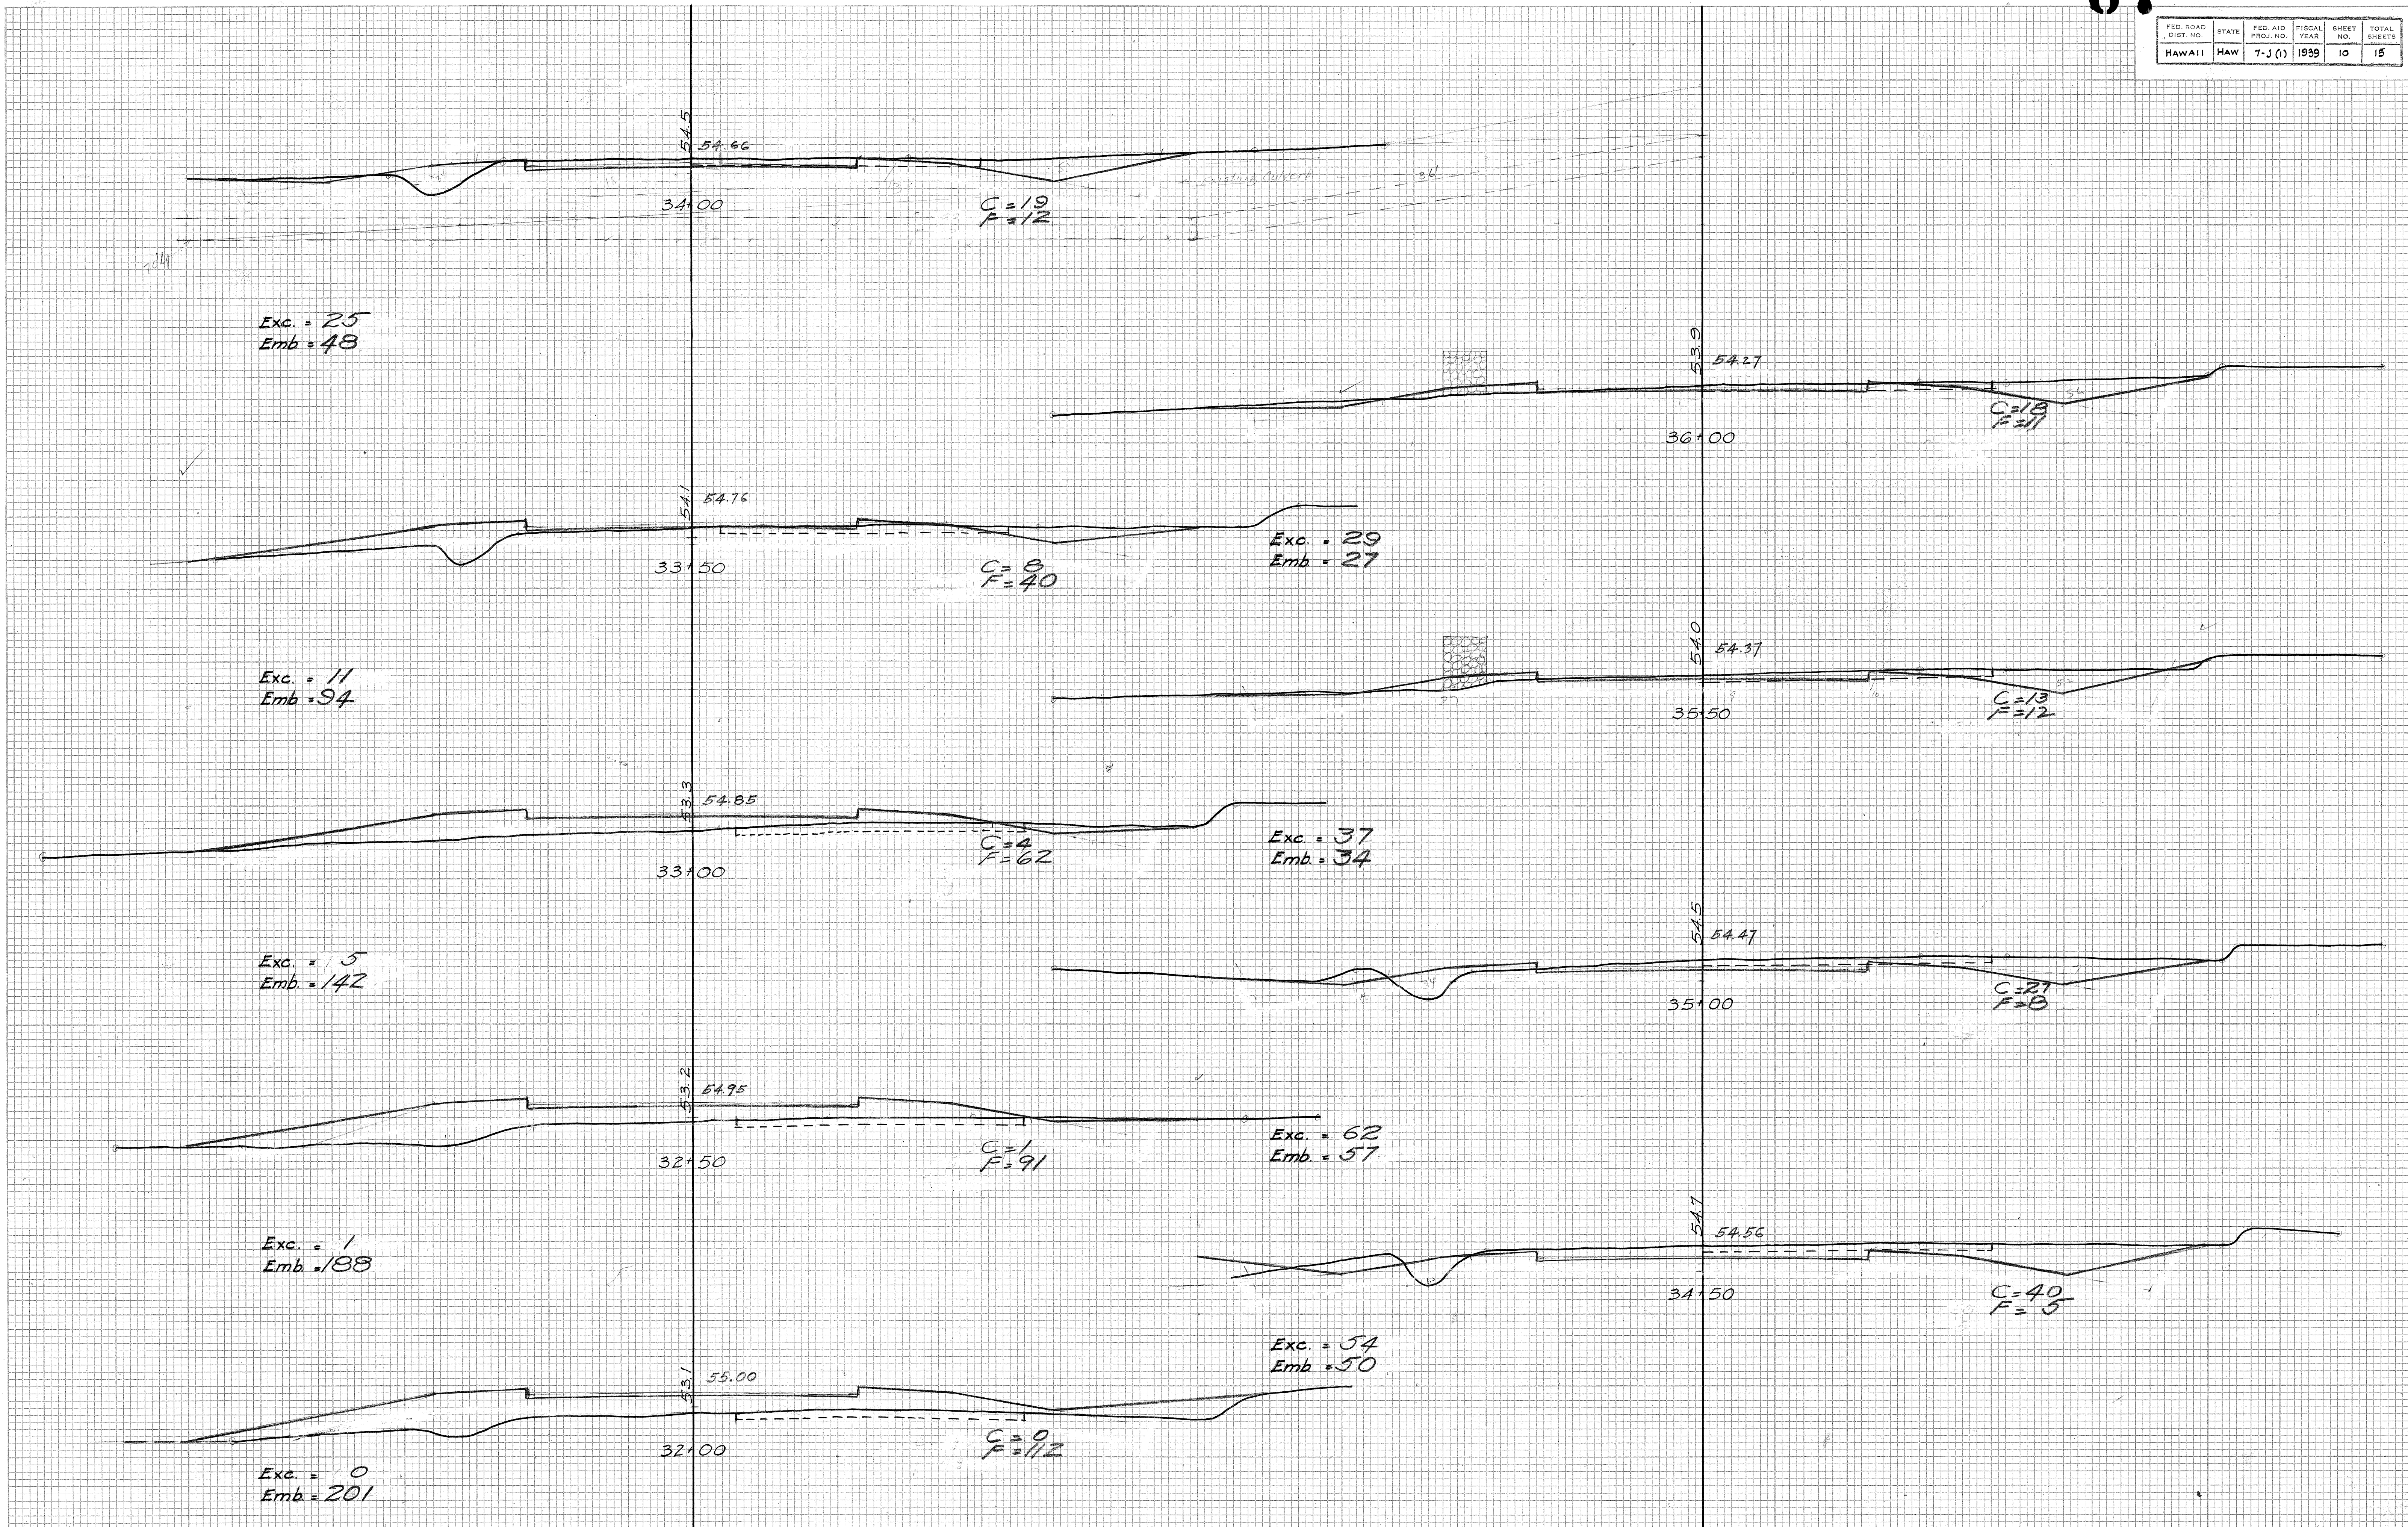


68

FED. ROAD DIST. NO.	STATE	FED. AID PROJ. NO.	FISCAL YEAR	SHEET NO.	TOTAL SHEETS
HAWAII	HAW	T-J 01	1959	11	15


FINAL SURVEY NO.	SURVEY PLOTTED	DATE
4499.11	10/31/59	

ORIGINAL SURVEY NO.	SURVEY PLOTTED	DATE
4499.11		

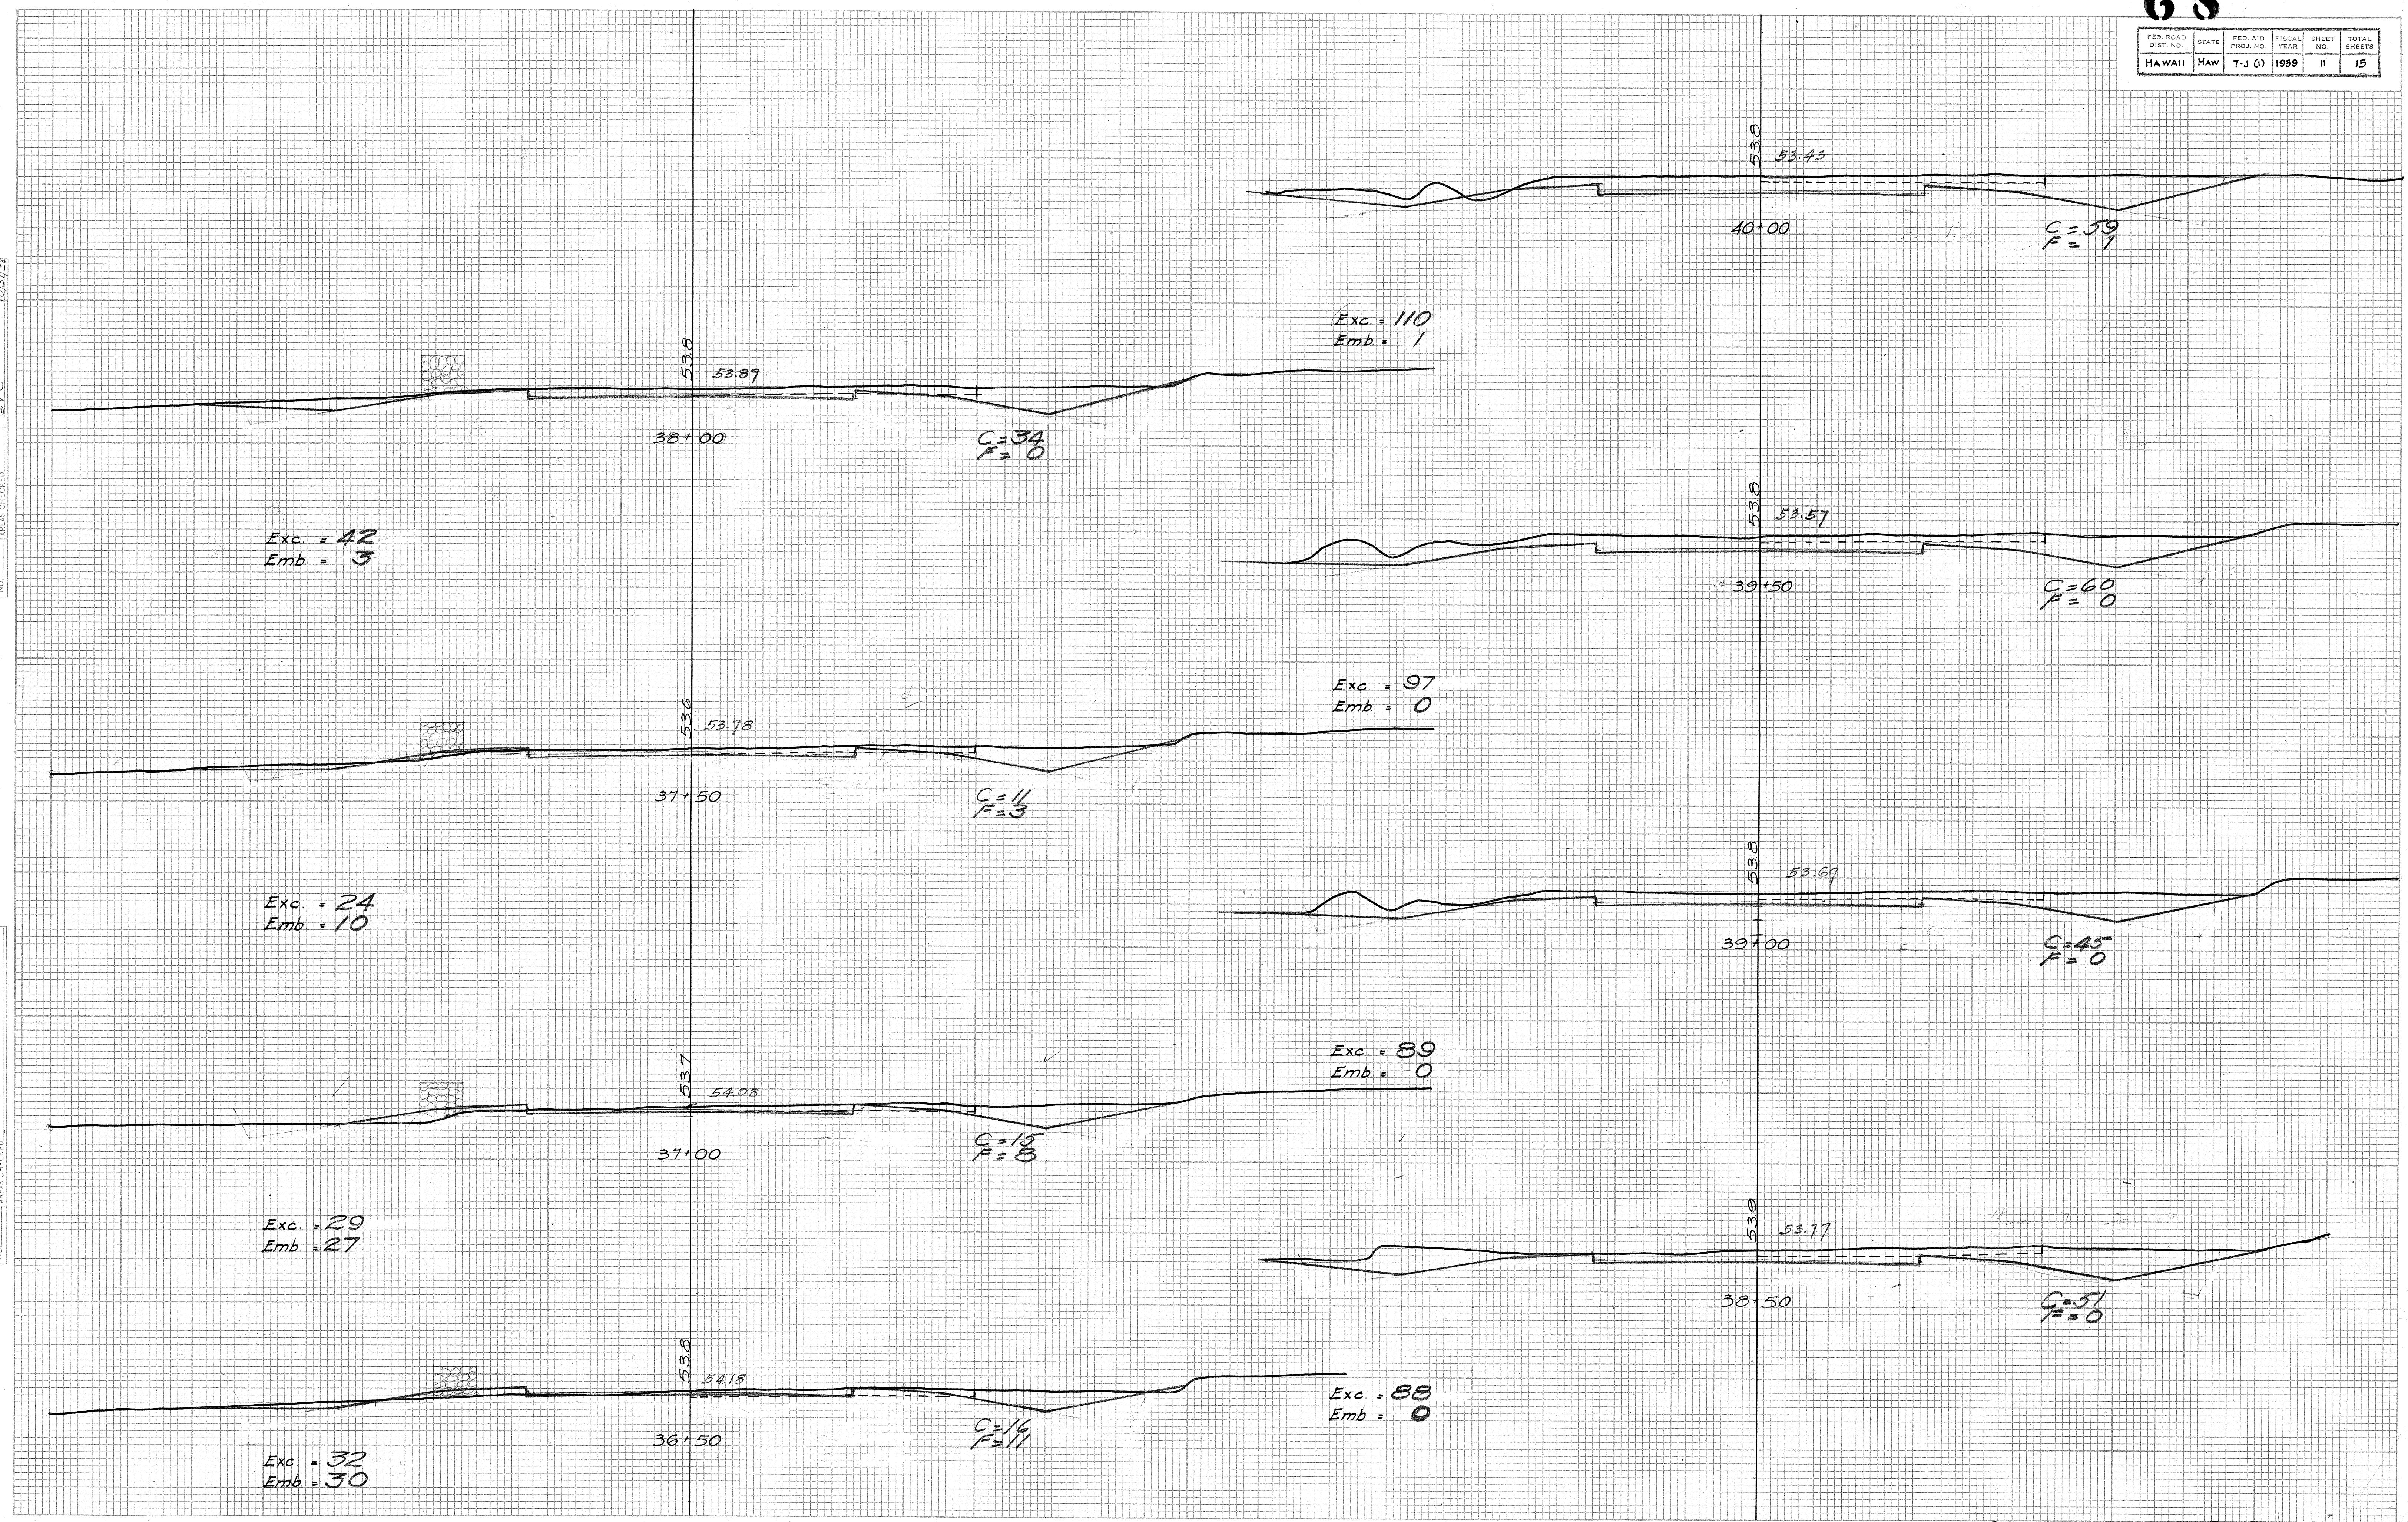


4499.11

ORIGINAL		BY	DATE
SURVEY			
PLOTTED			
TEMPLATE			
NOTE BOOK			
NO. _____			
AREAS CHECKED			

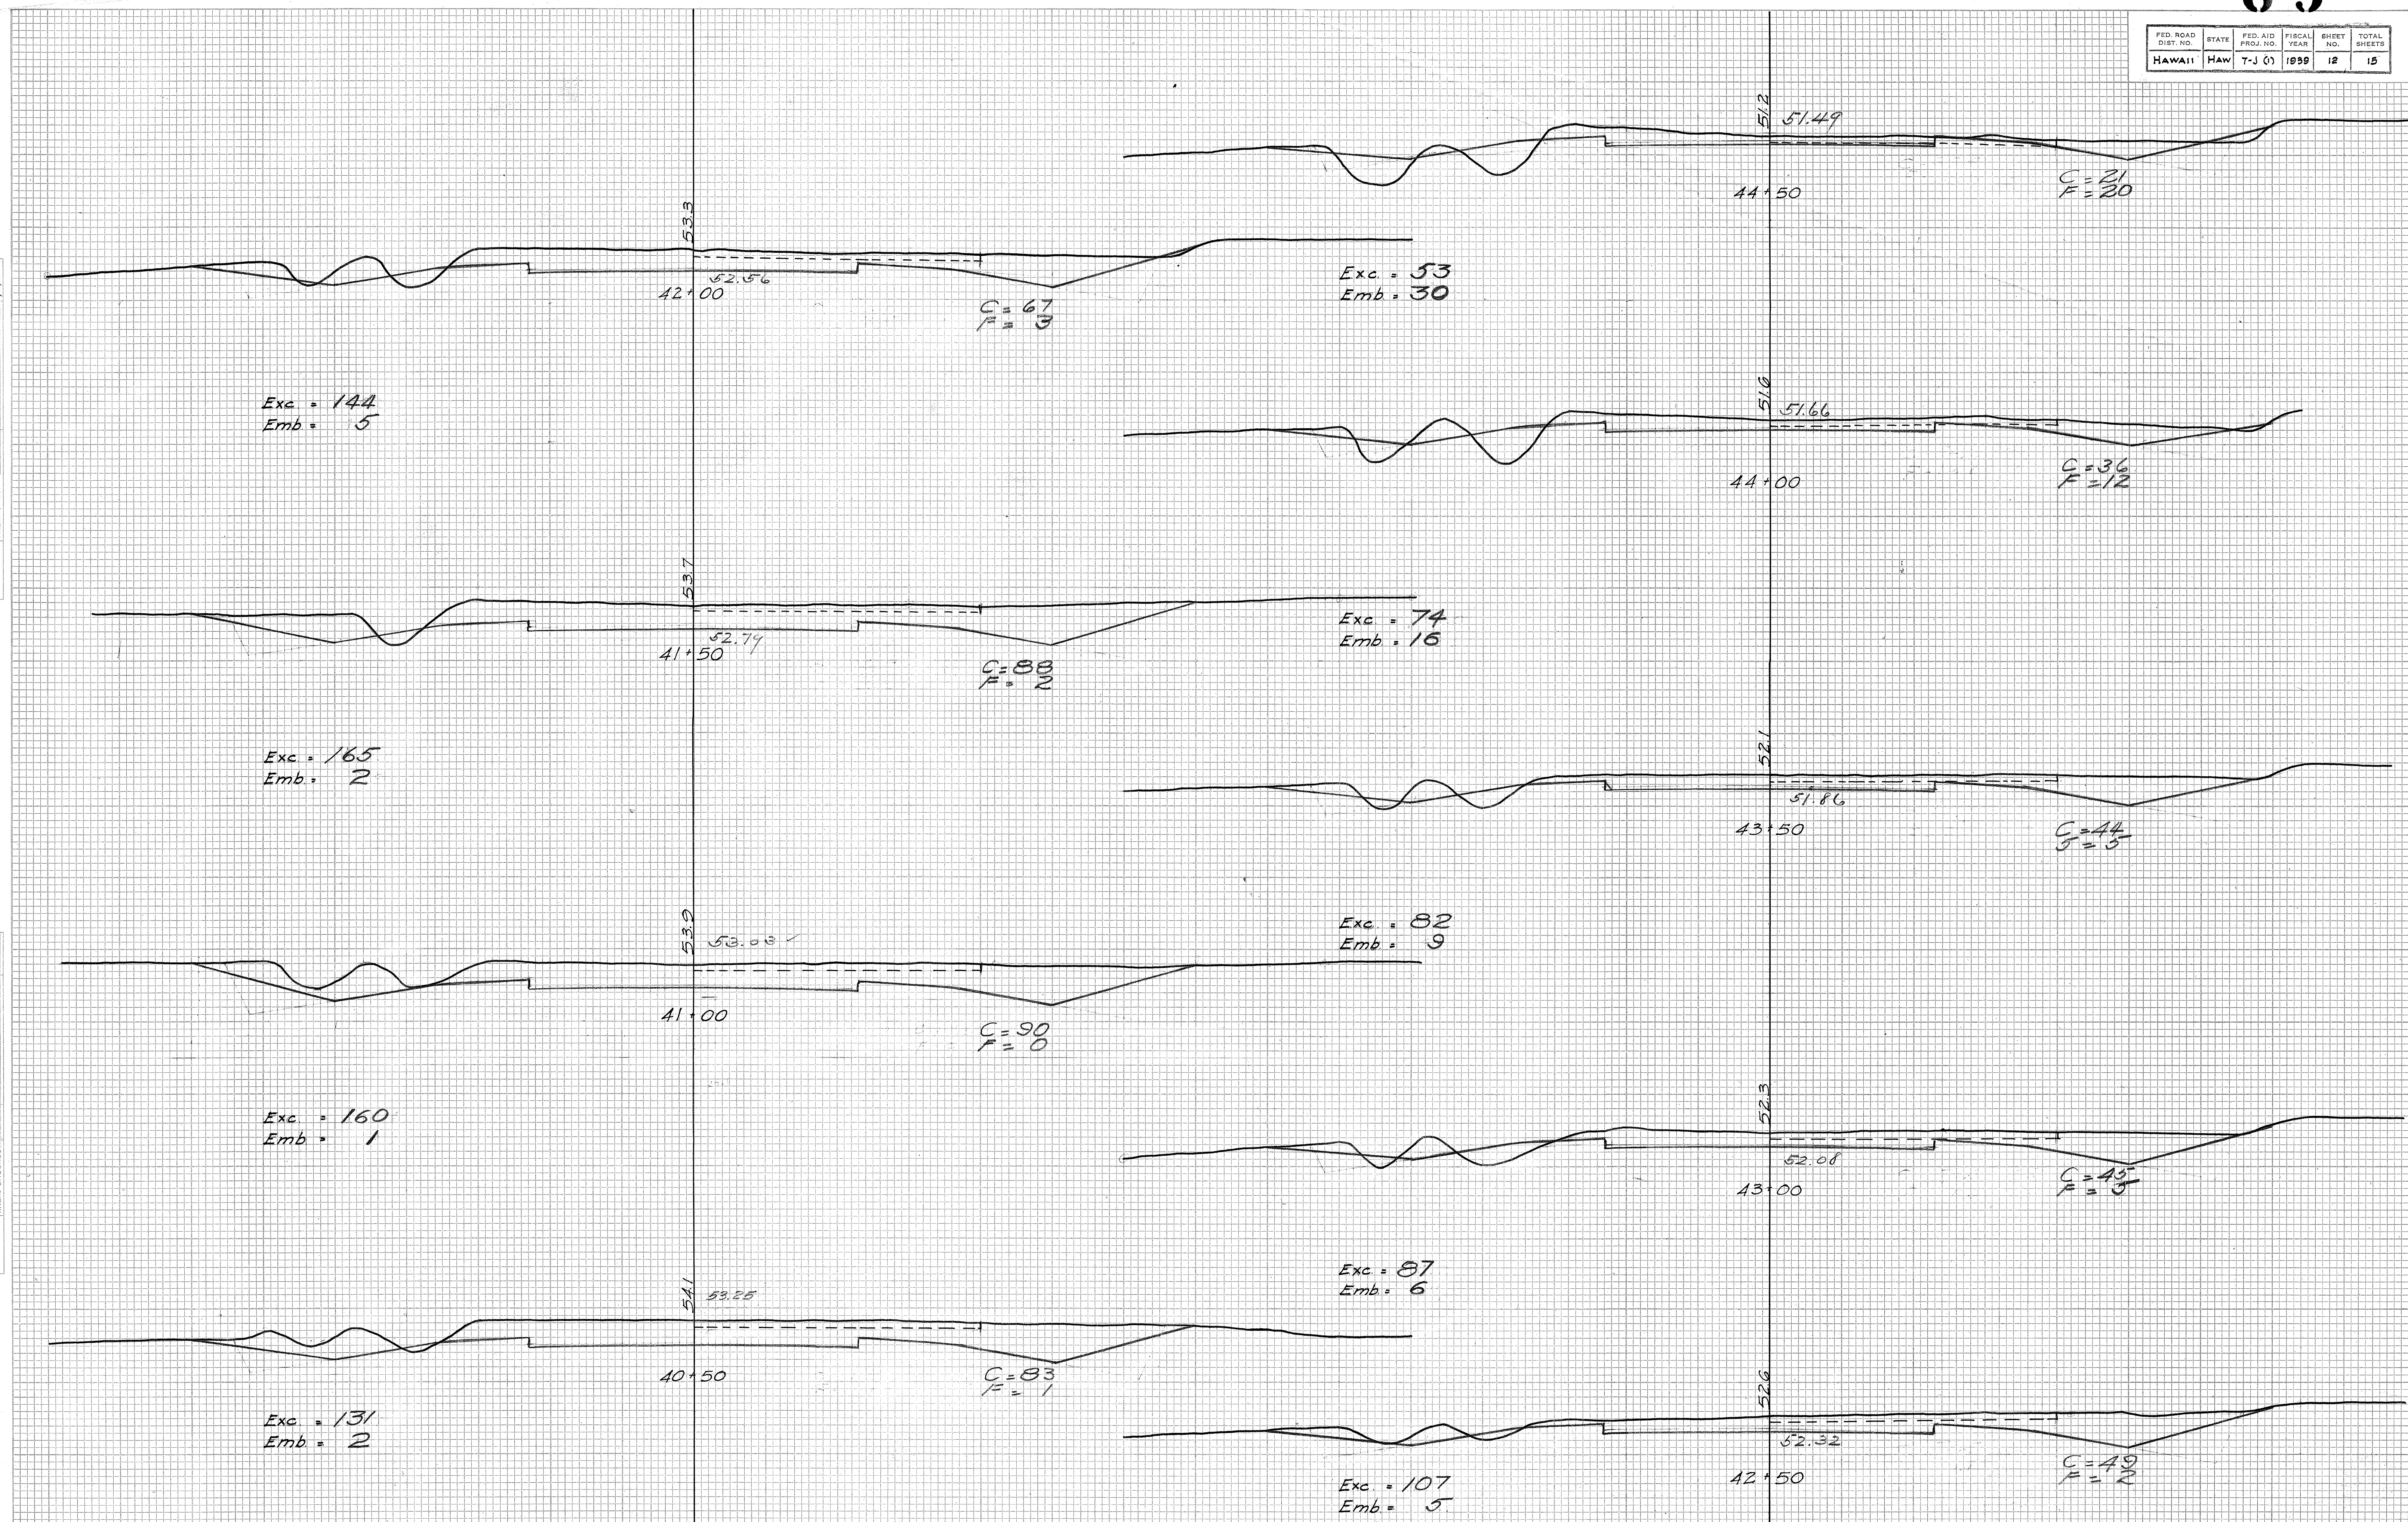

FINAL	SURVEYED	BY	DATE
SURVEY	PLOTTED	H/C	
NOTE BOOK	TEMPLATE	G/C	
No.	AREAS	F/H C	11/1/82
	AREAS CHECKED	G/V	









ORIGINAL SURVEY	SURVEYED	BY	DATE
	PLOTTED		
NOTE BOOK	TEMPLATE		
	AREAS		
No.	AREAS CHECKED		
	No.		

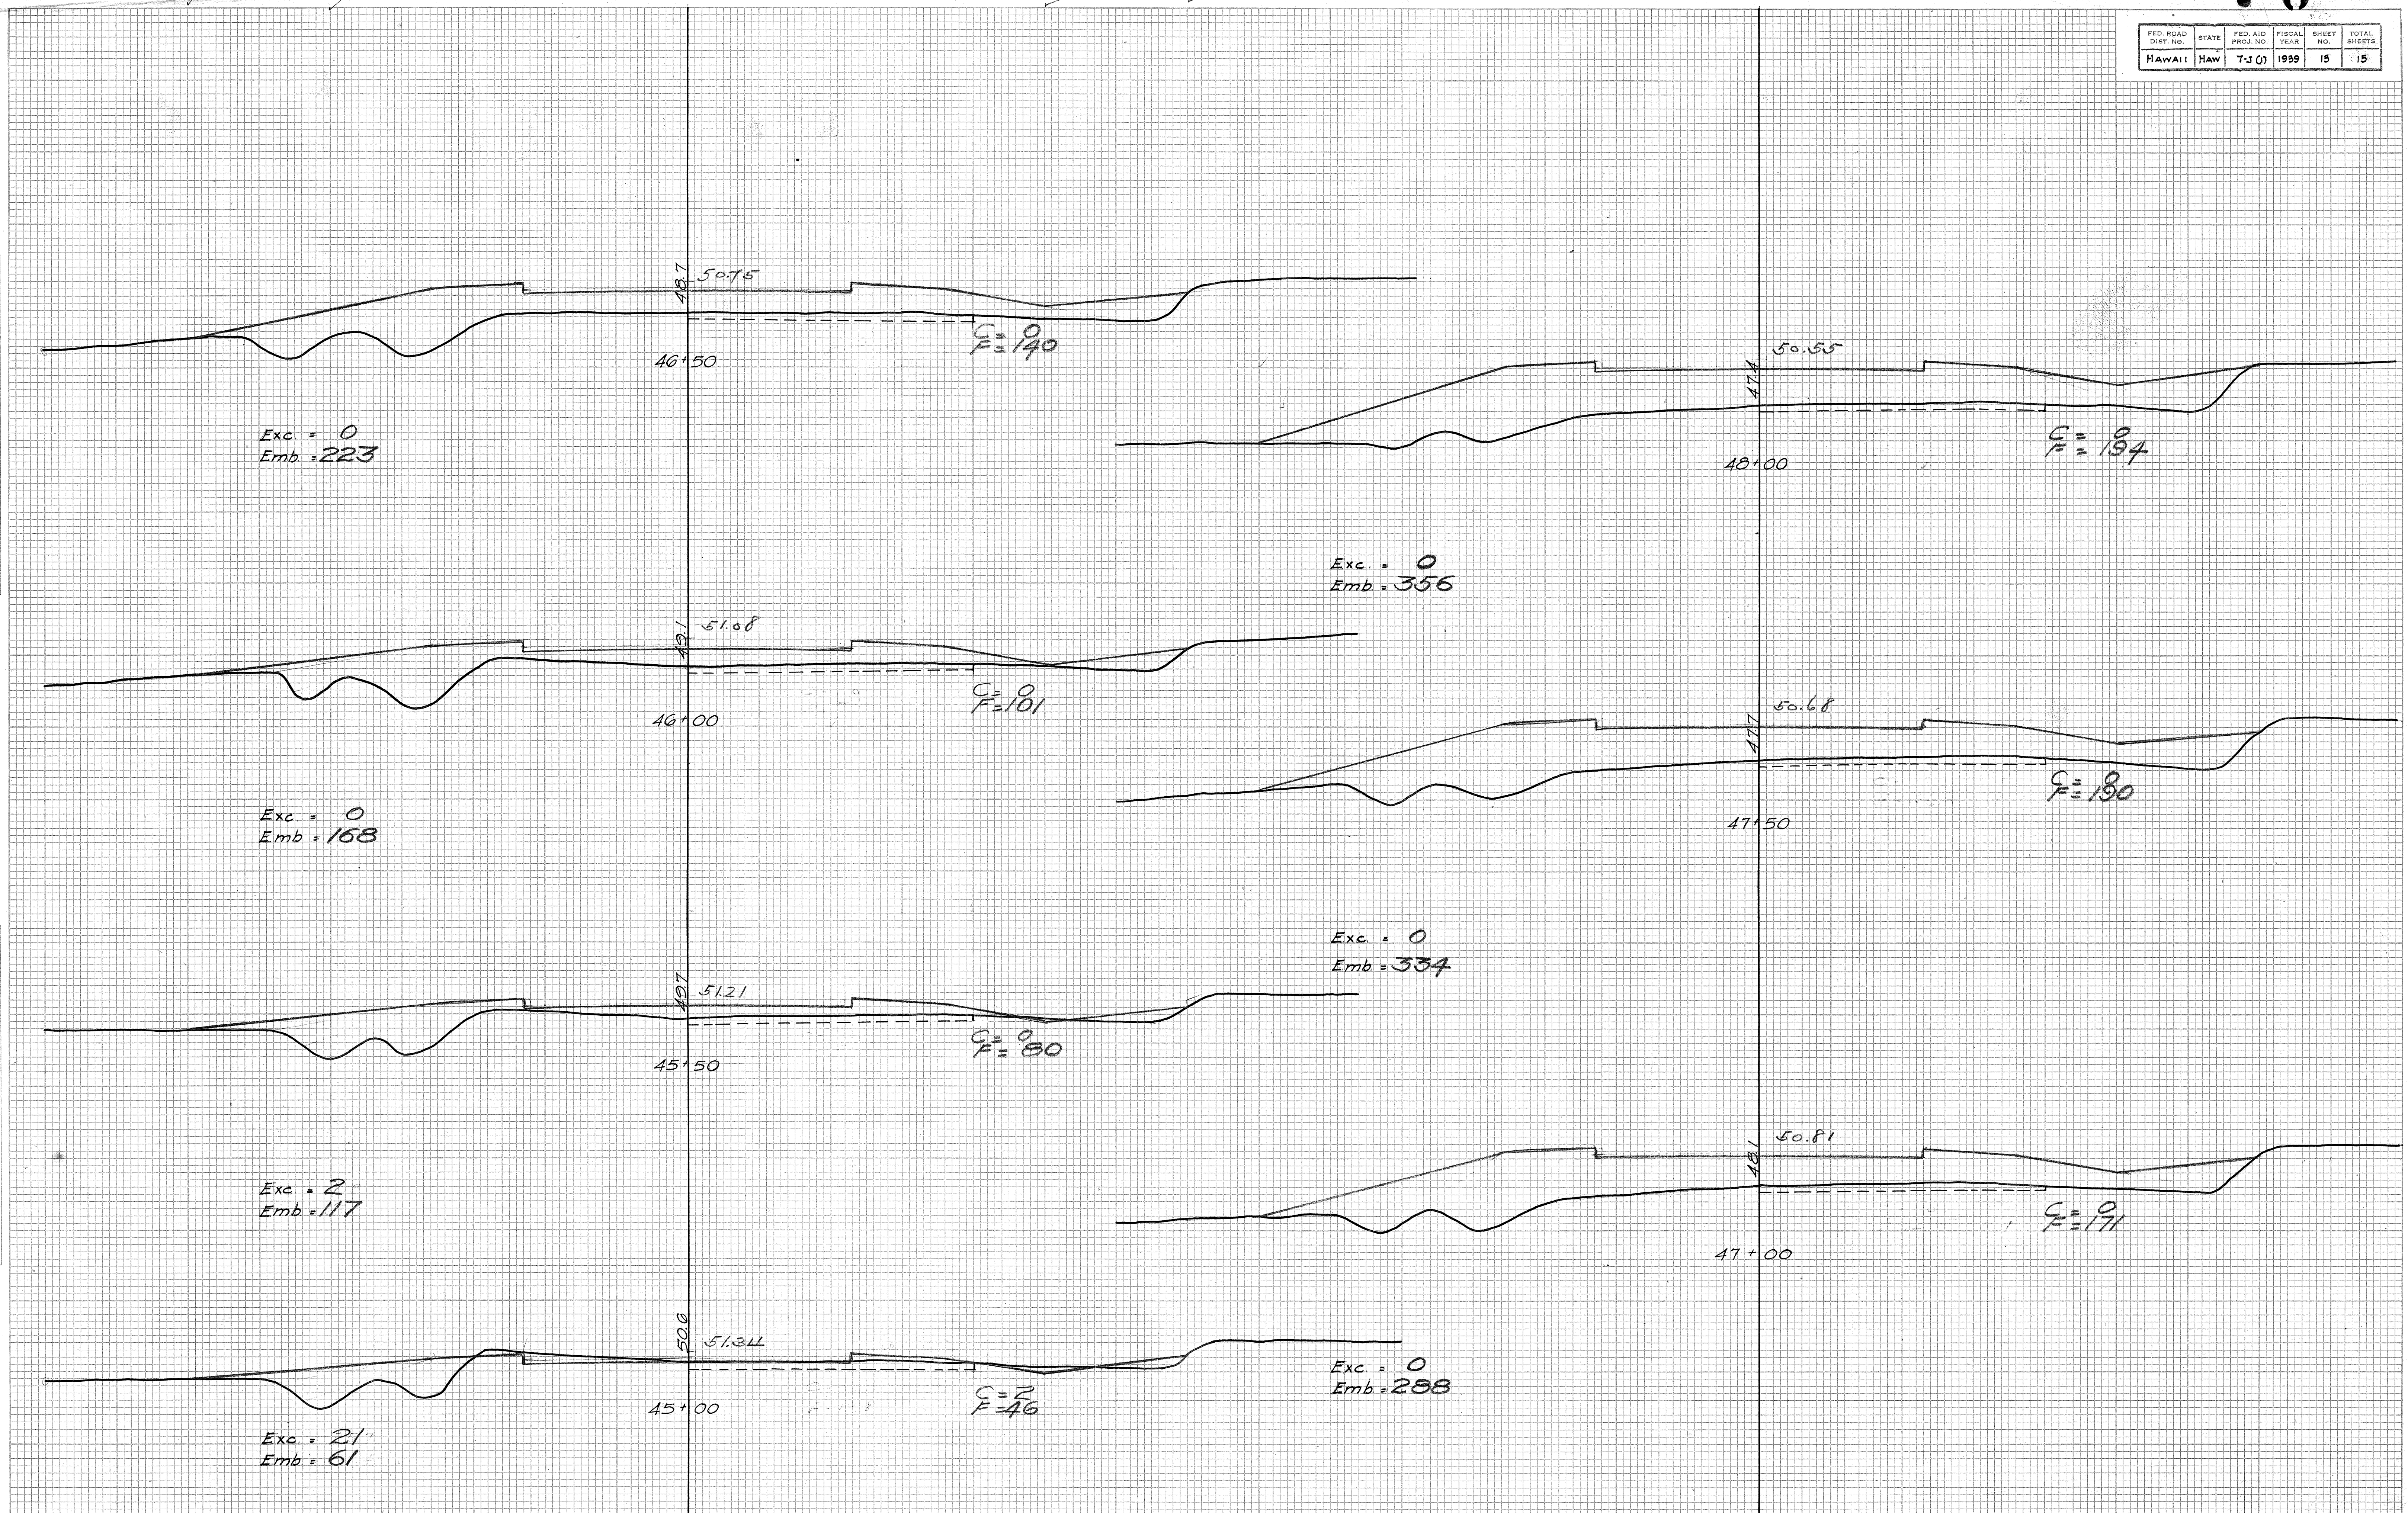

FED. ROAD DIST. NO.	STATE	FED. AID PROJ. NO.	FISCAL YEAR	SHEET NO.	TOTAL SHEETS
HAWAII	HAW	7-3 (1)	1939	14	15

DATE	11/1/38
BY	HHC
SURVEY	6110
NOTE BOOK	6110
NO.	6110

DATE	
BY	
SURVEY	
NOTE BOOK	
NO.	

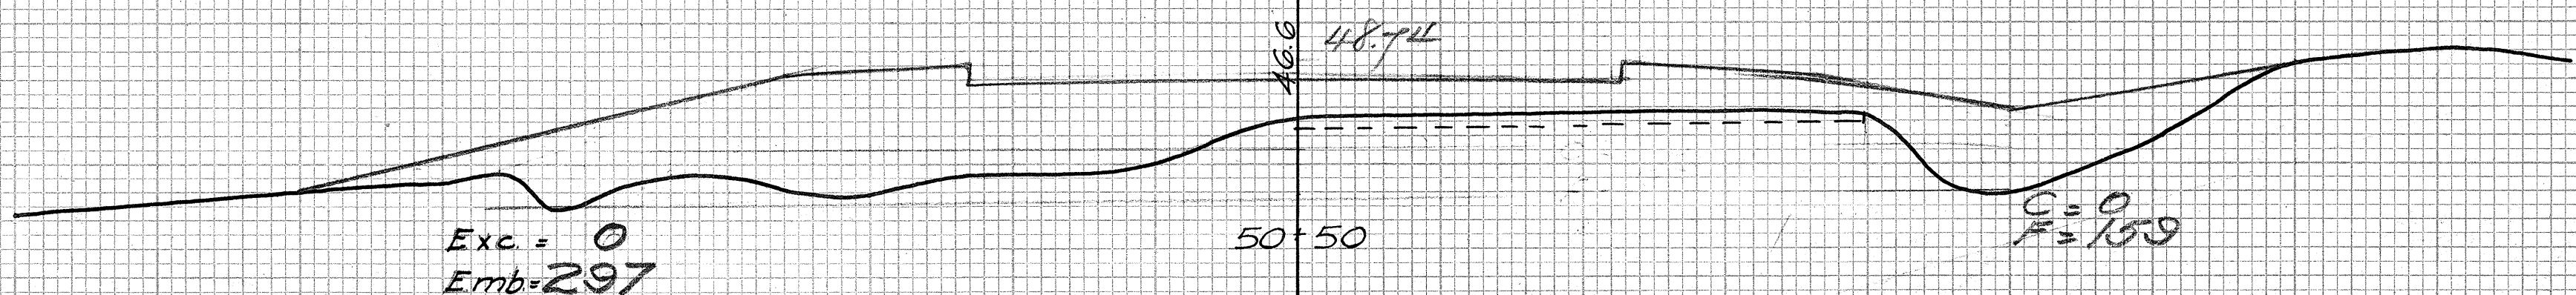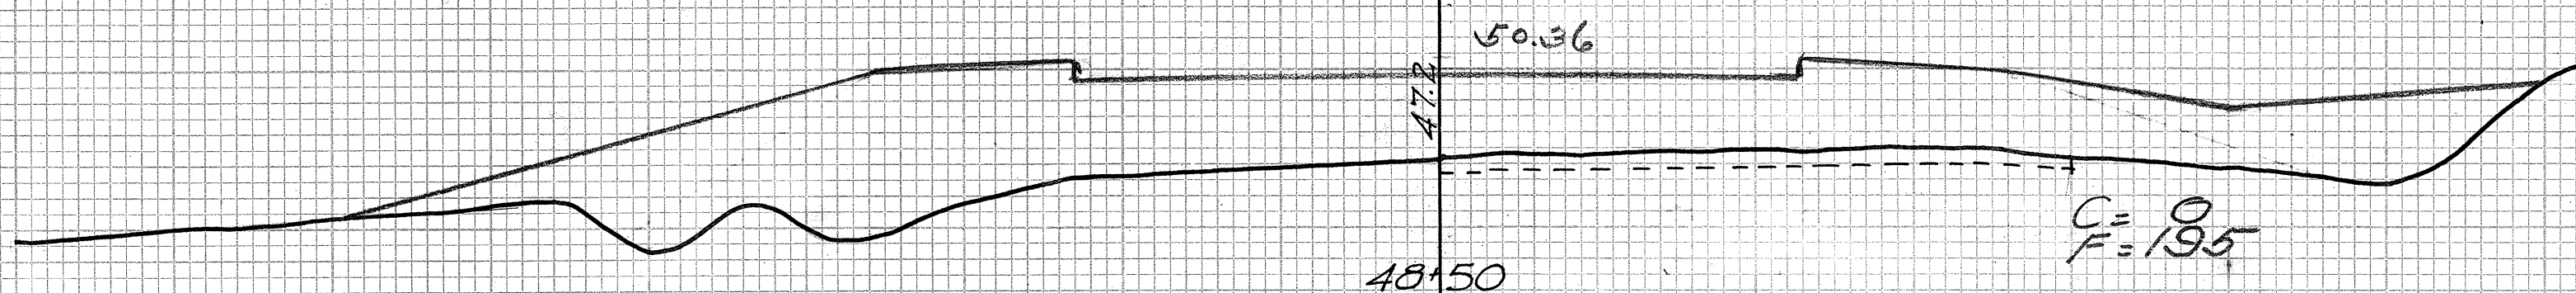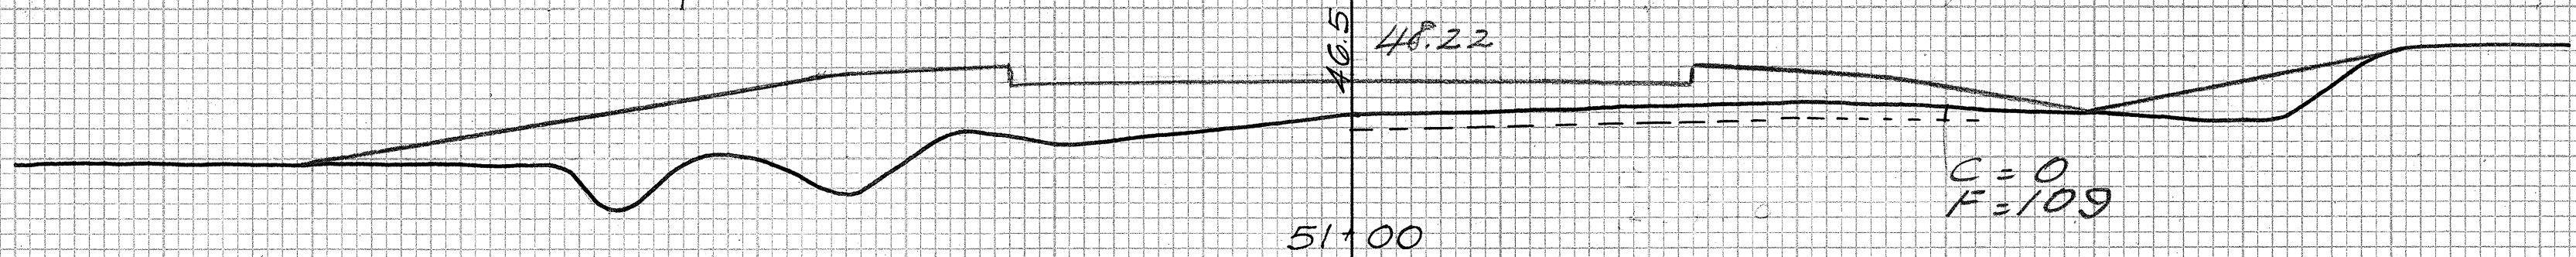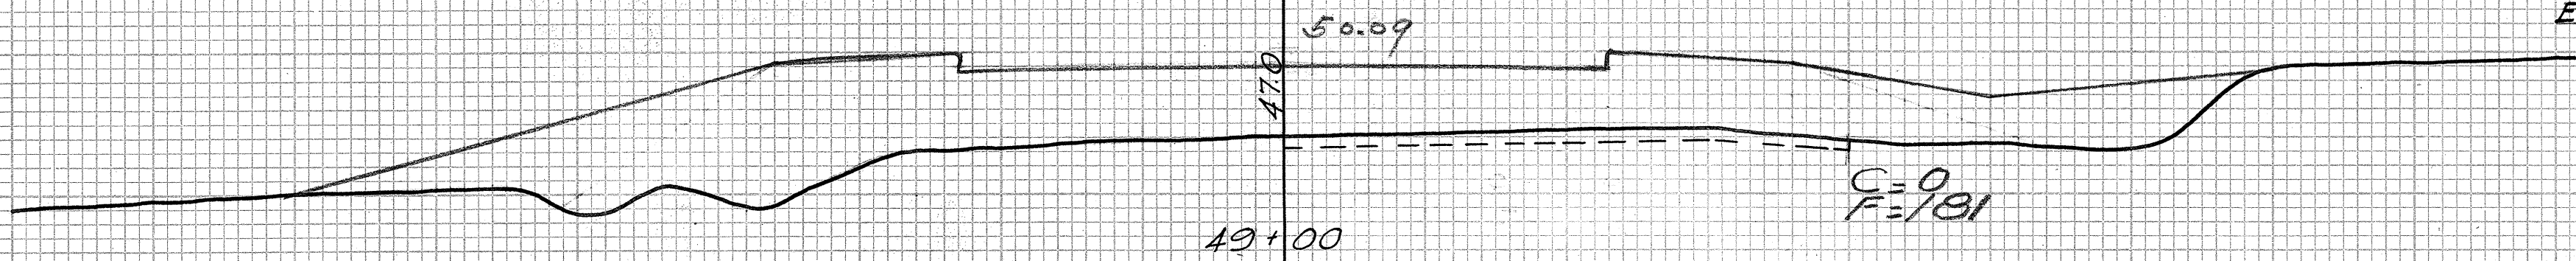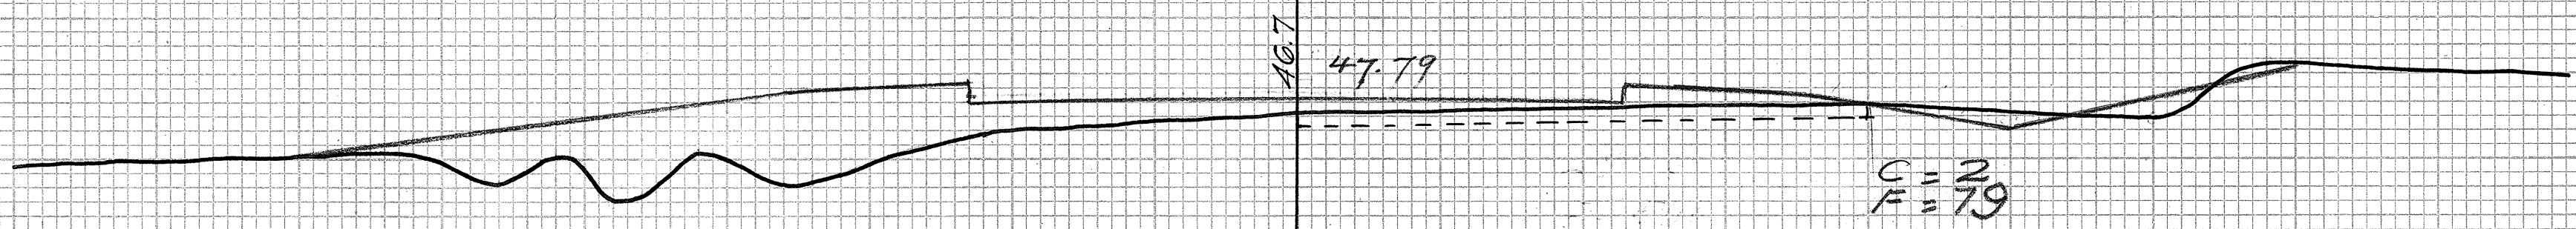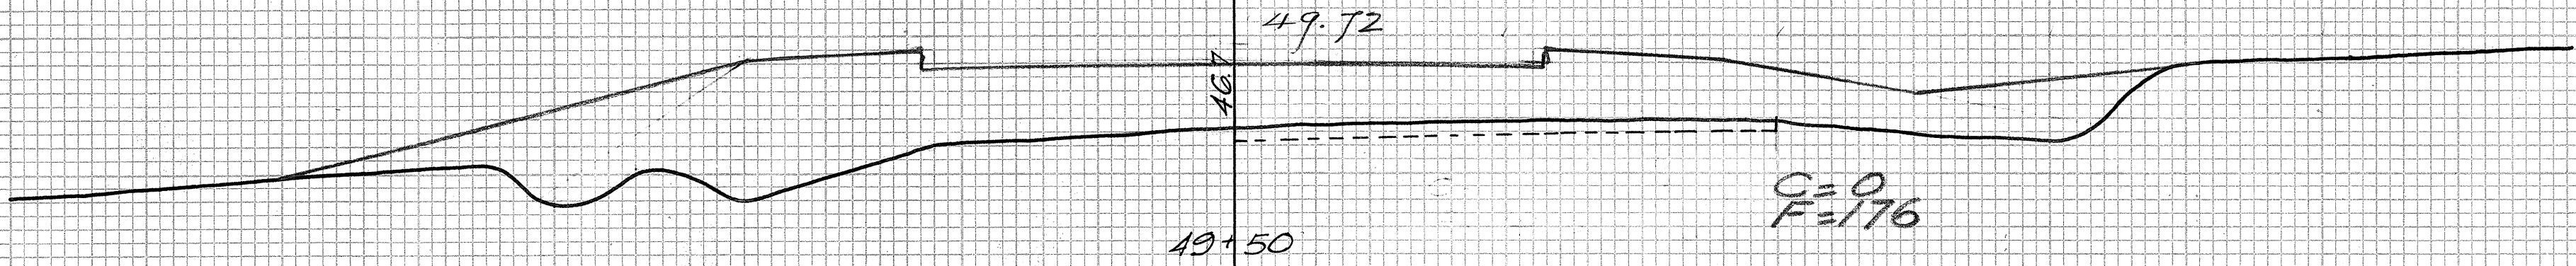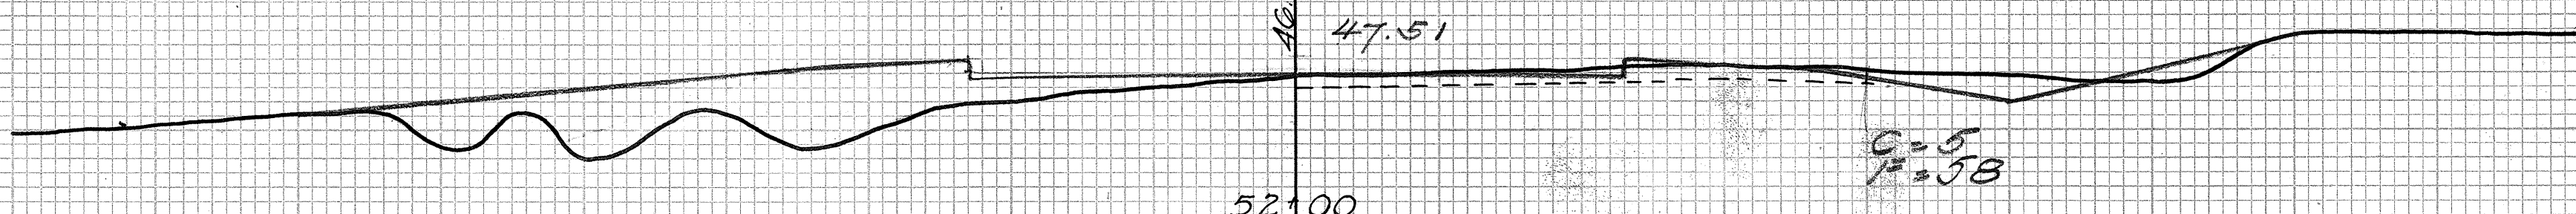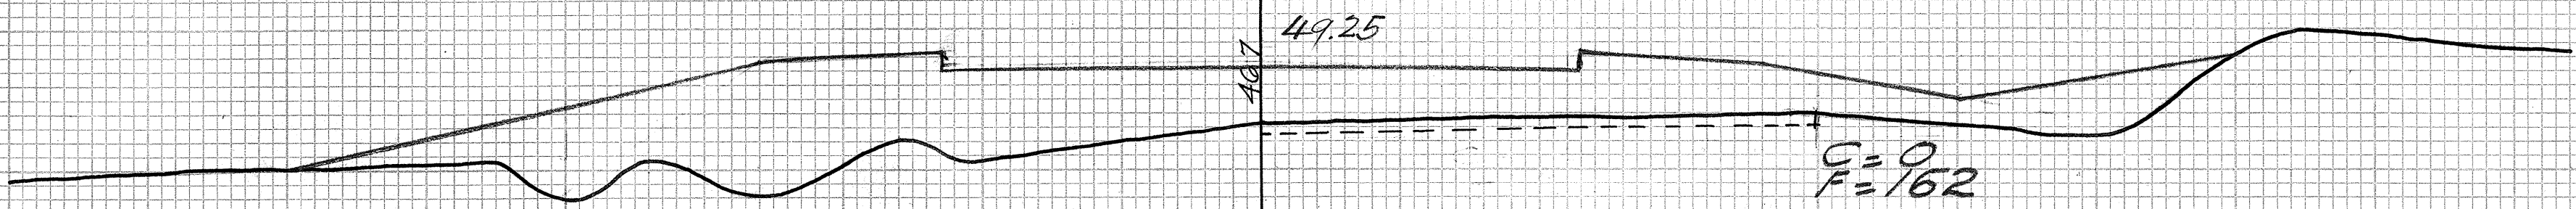

DATE	BY	FINAL SURVEY NO.	SURVEYED PLOTTED	NOTE BOOK	AREAS CHECKED
11/1/32	HHC				
	HVC				
	HVC				
	HVC				

DATE	BY	ORIGINAL SURVEY NO.	SURVEYED PLOTTED	NOTE BOOK	AREAS CHECKED

