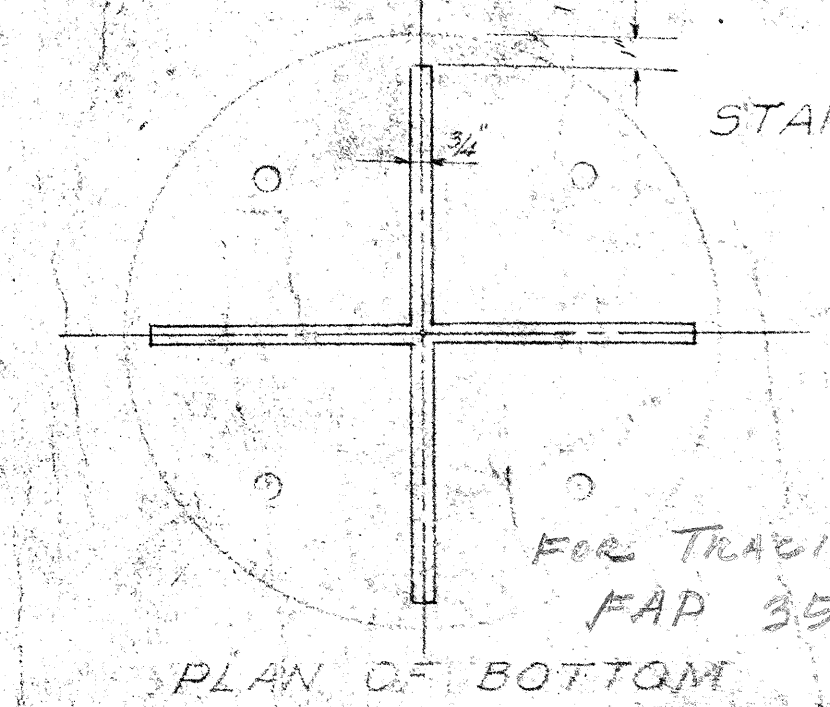
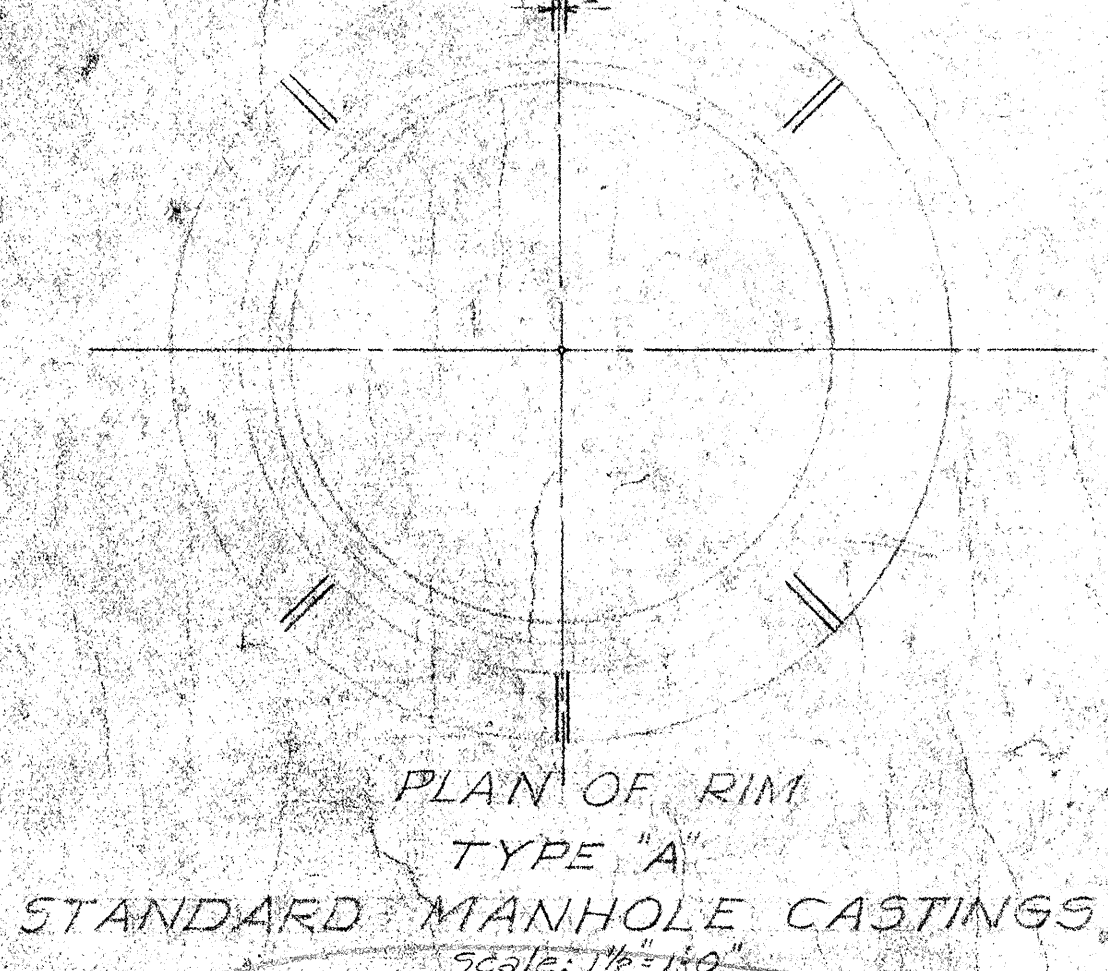
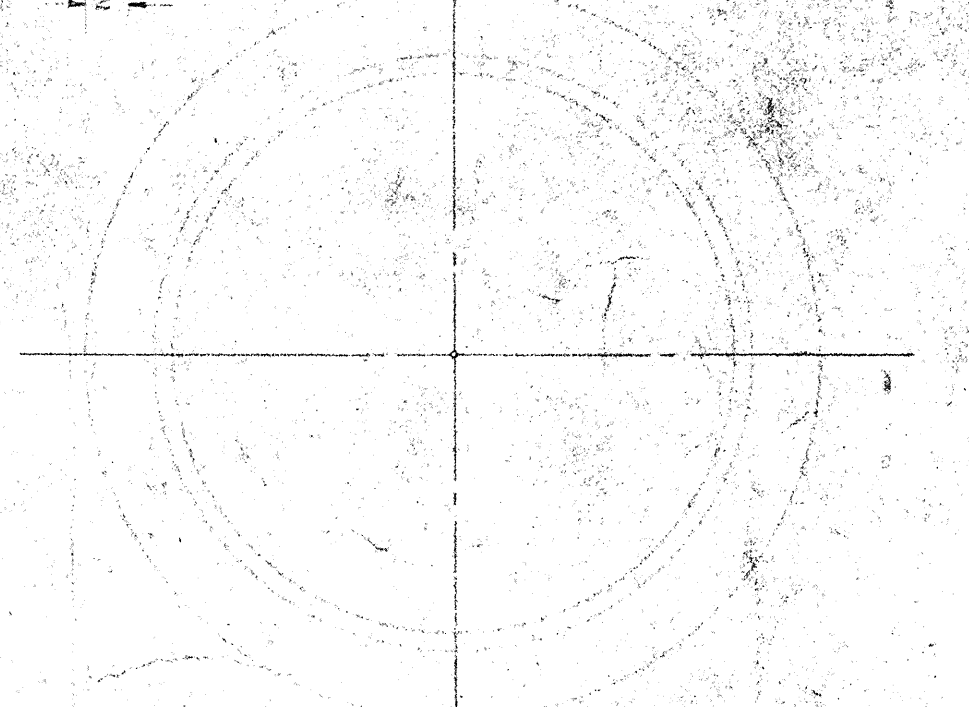
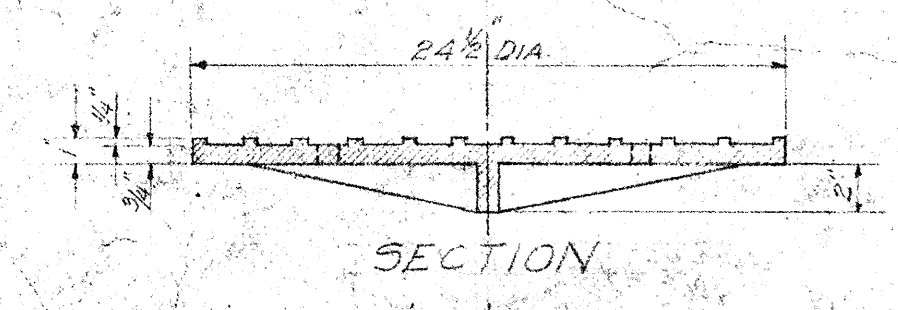
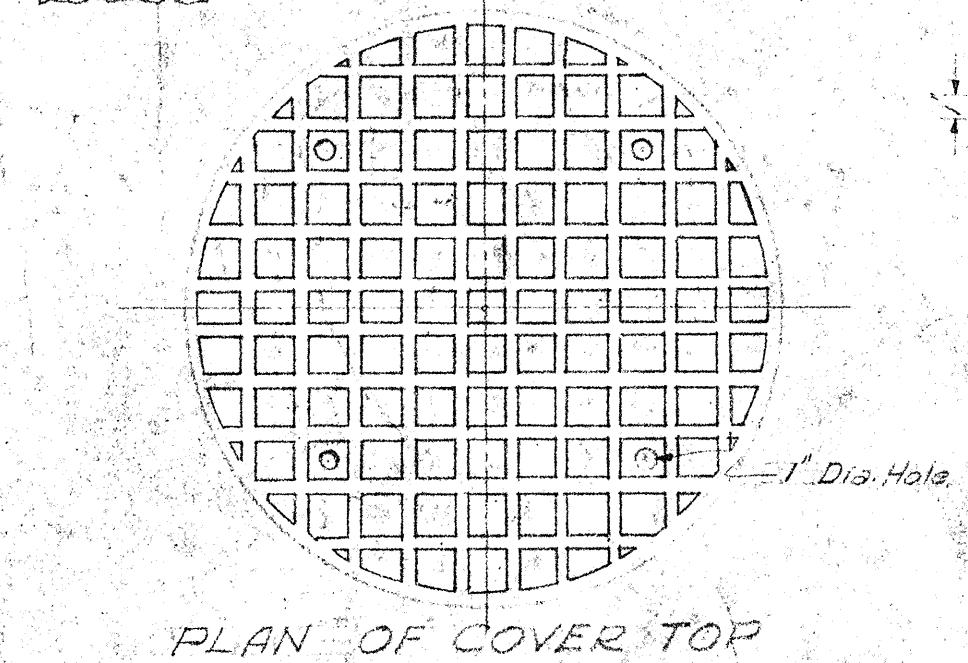
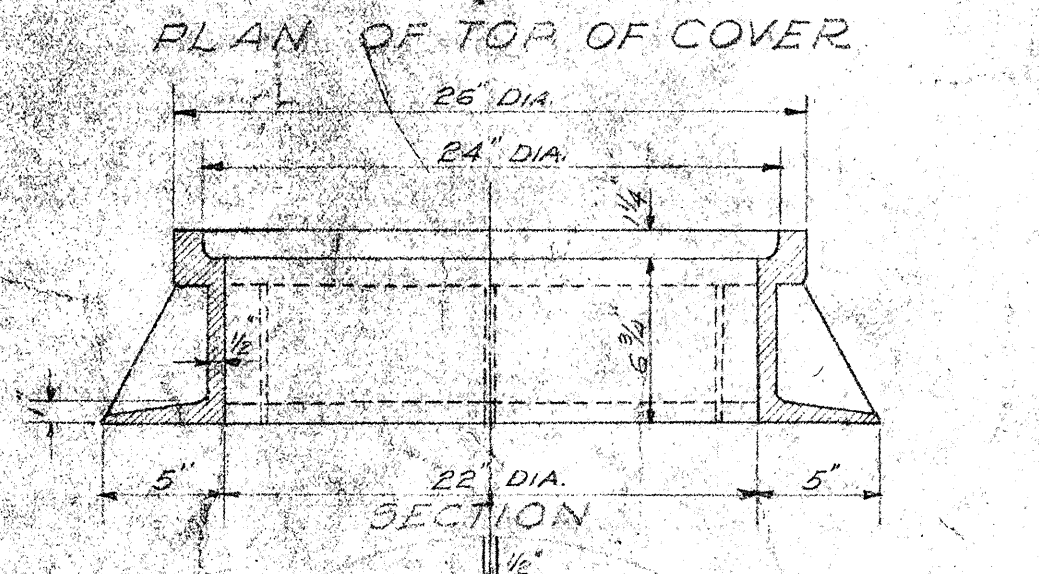
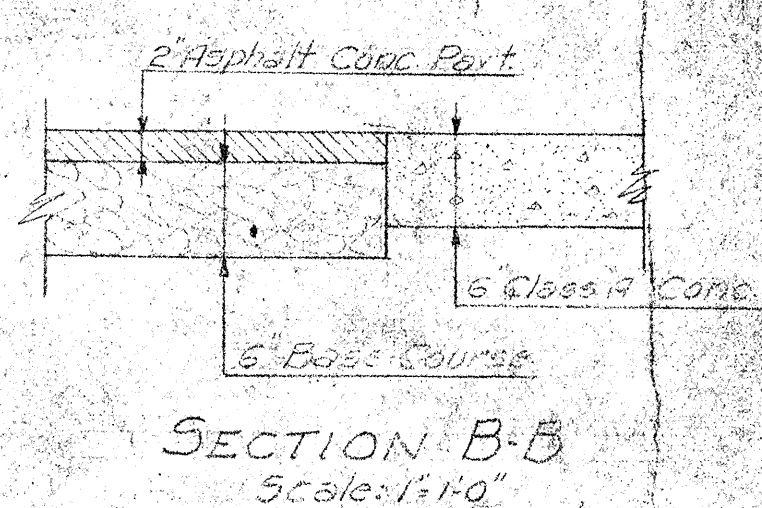
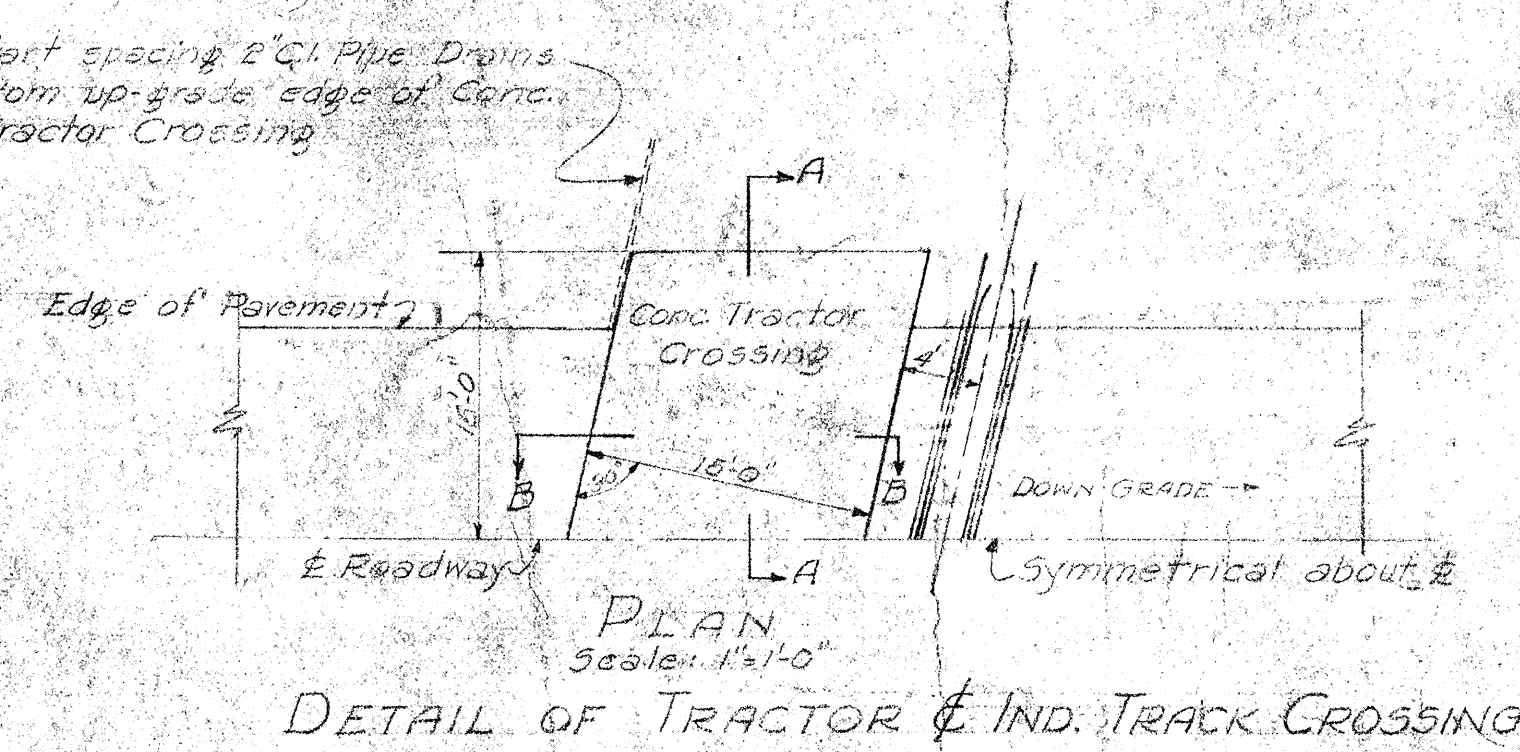
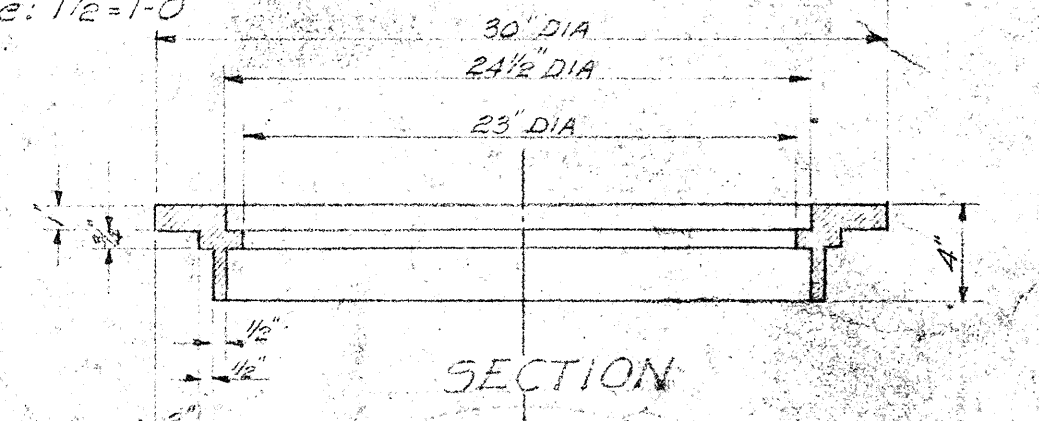
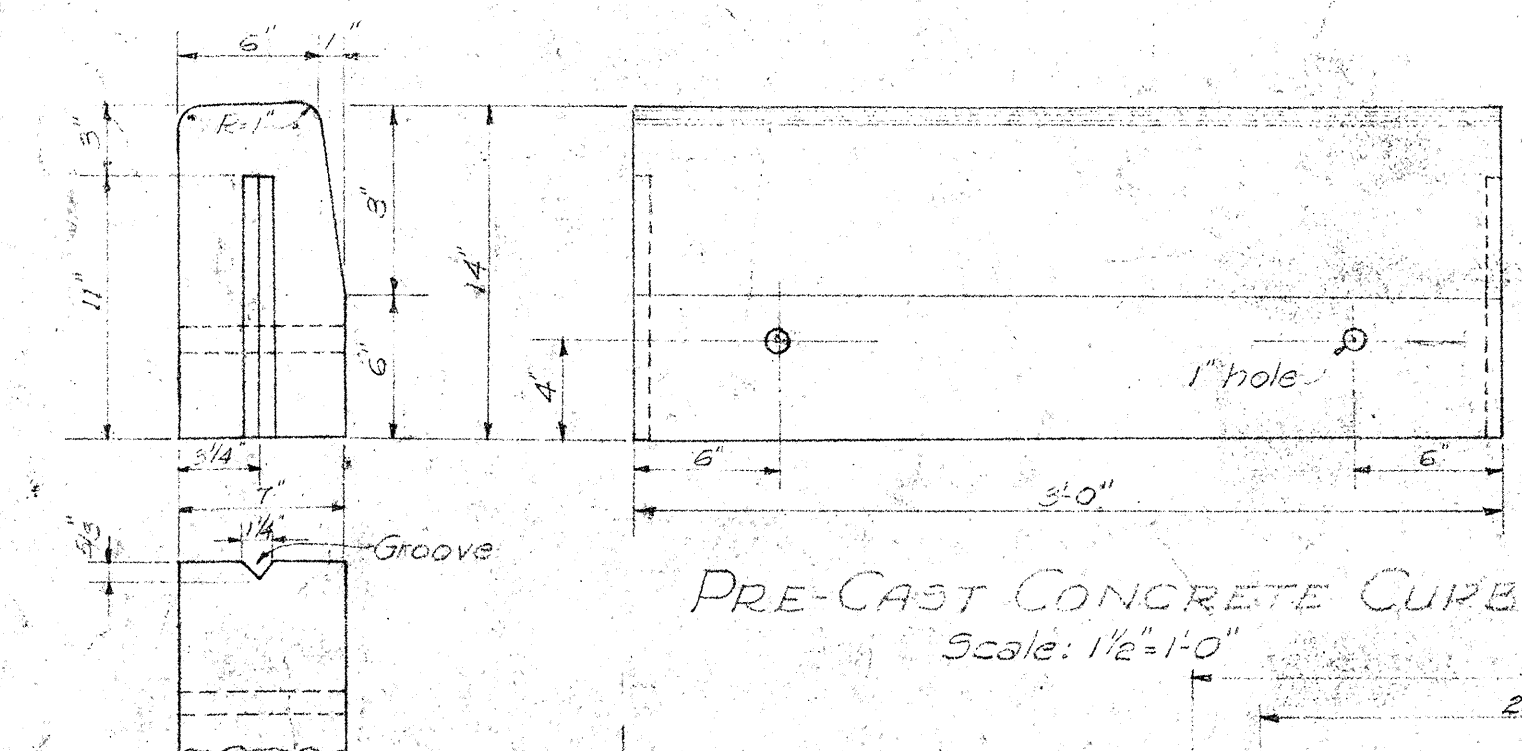
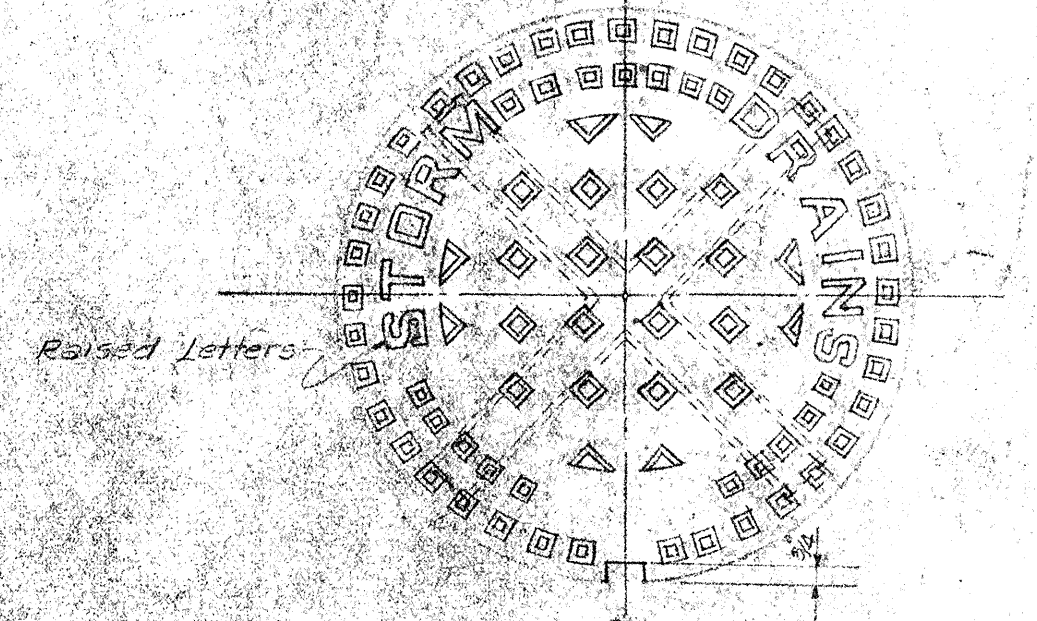
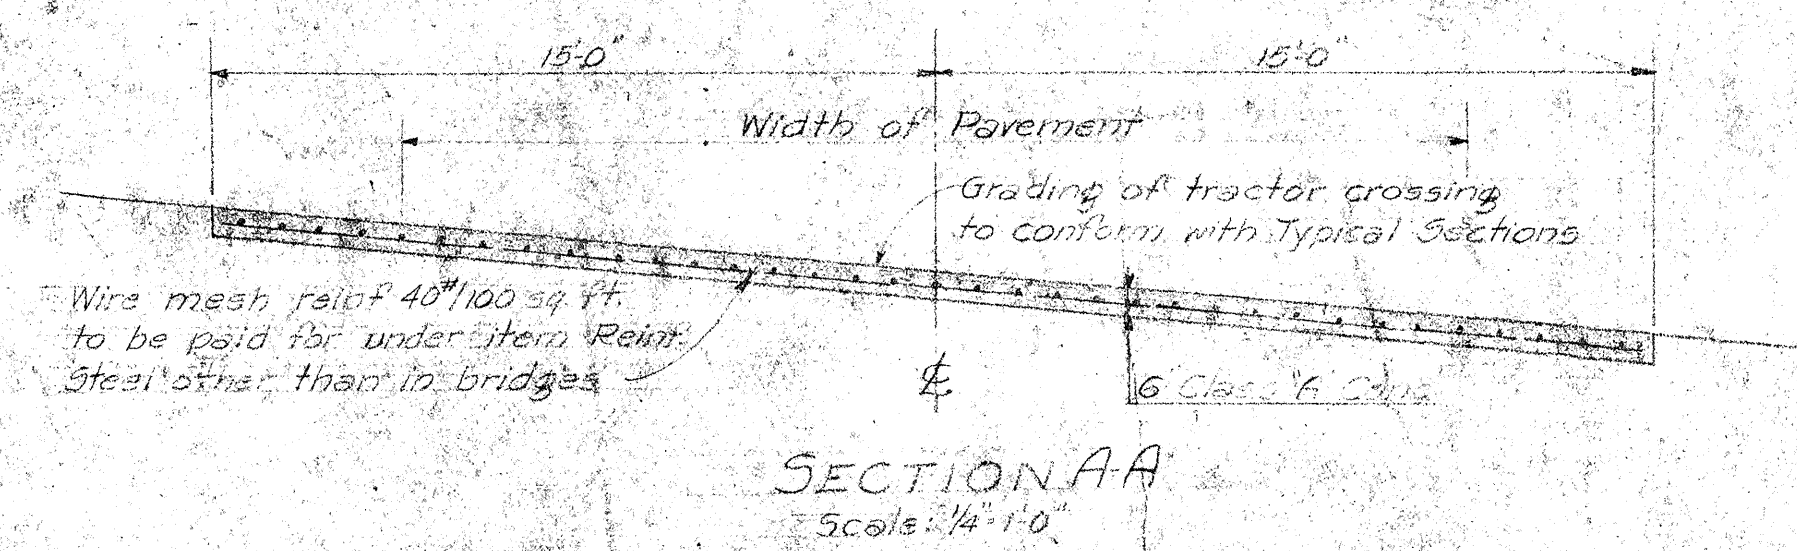
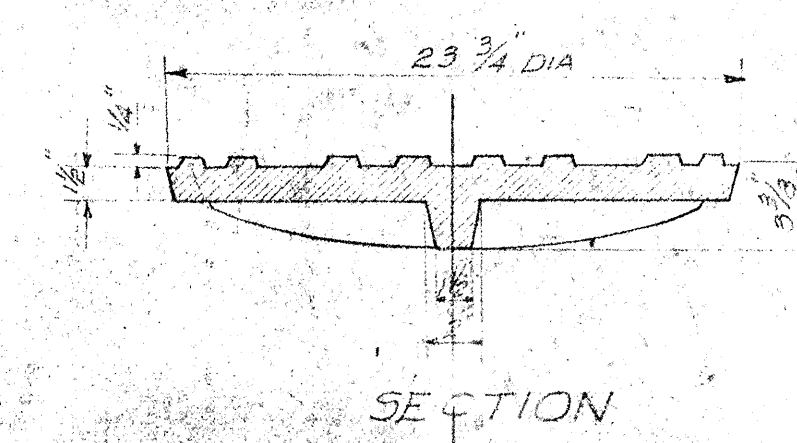
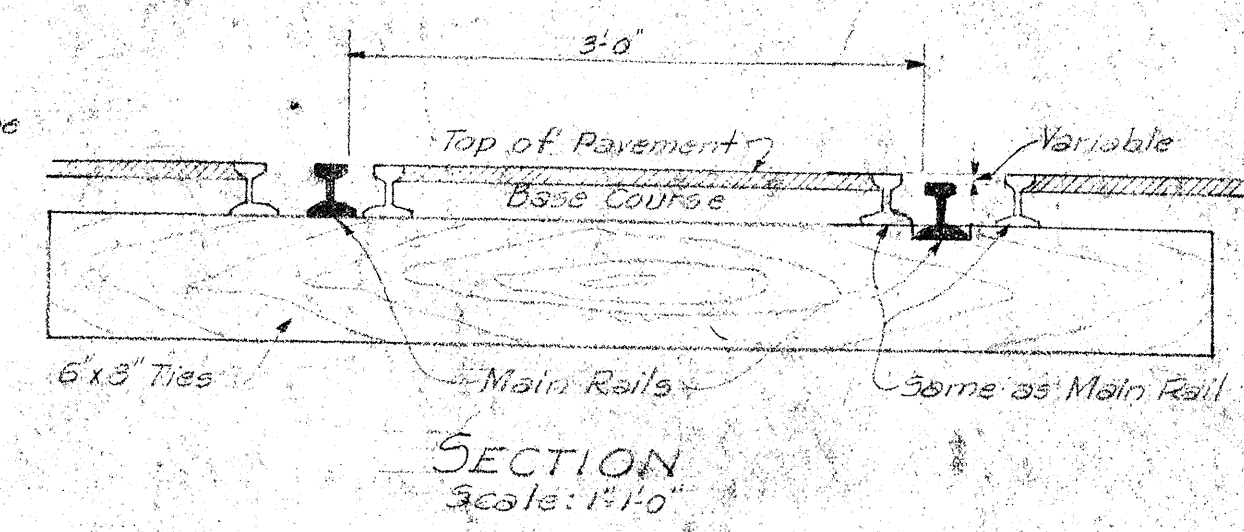
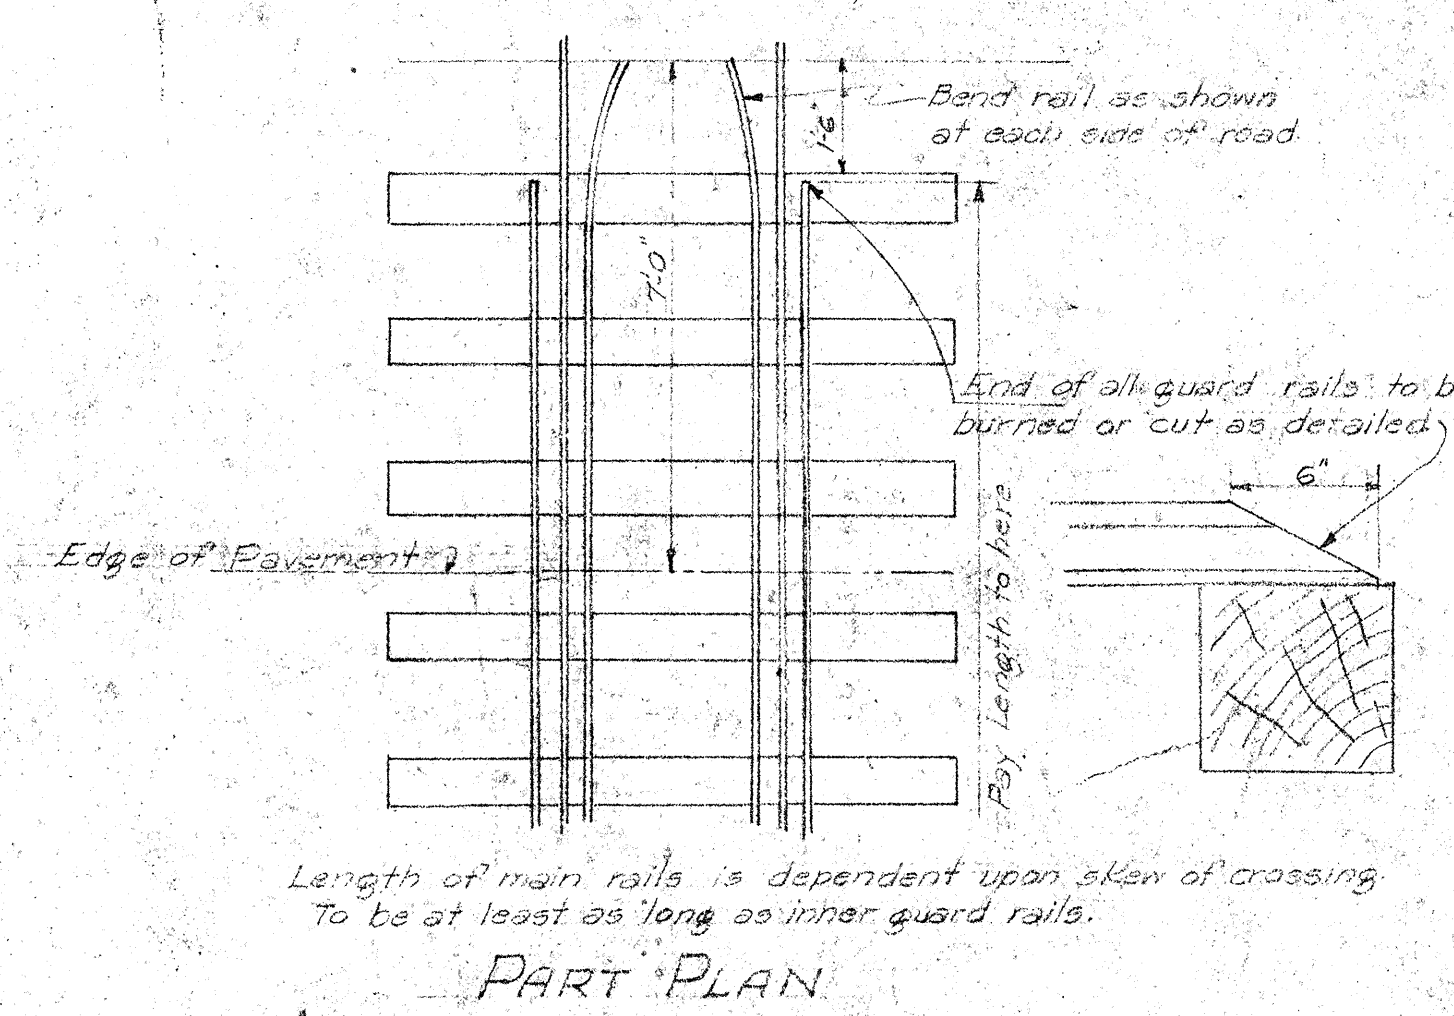
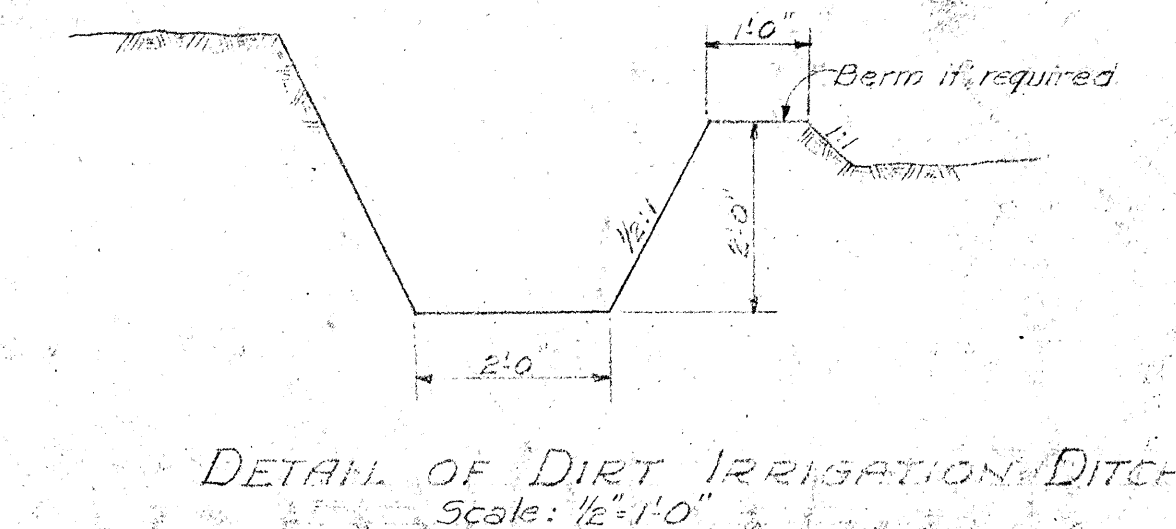
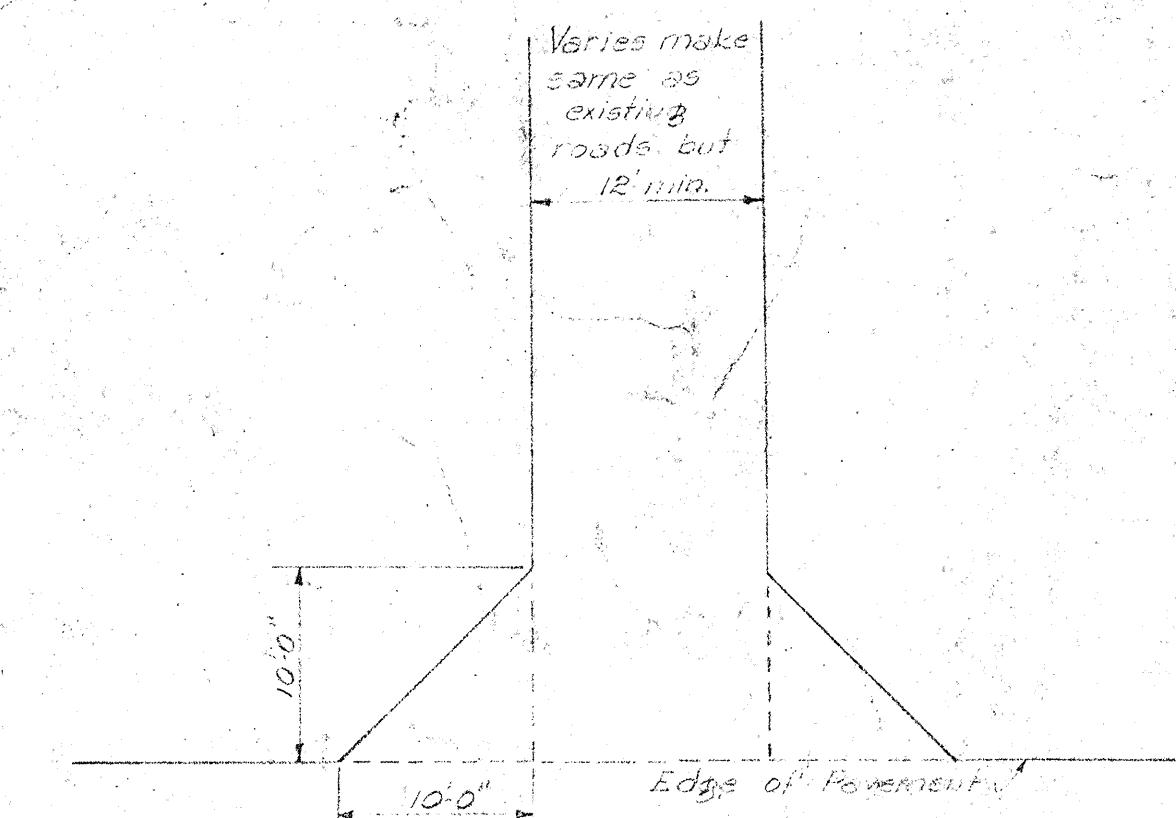
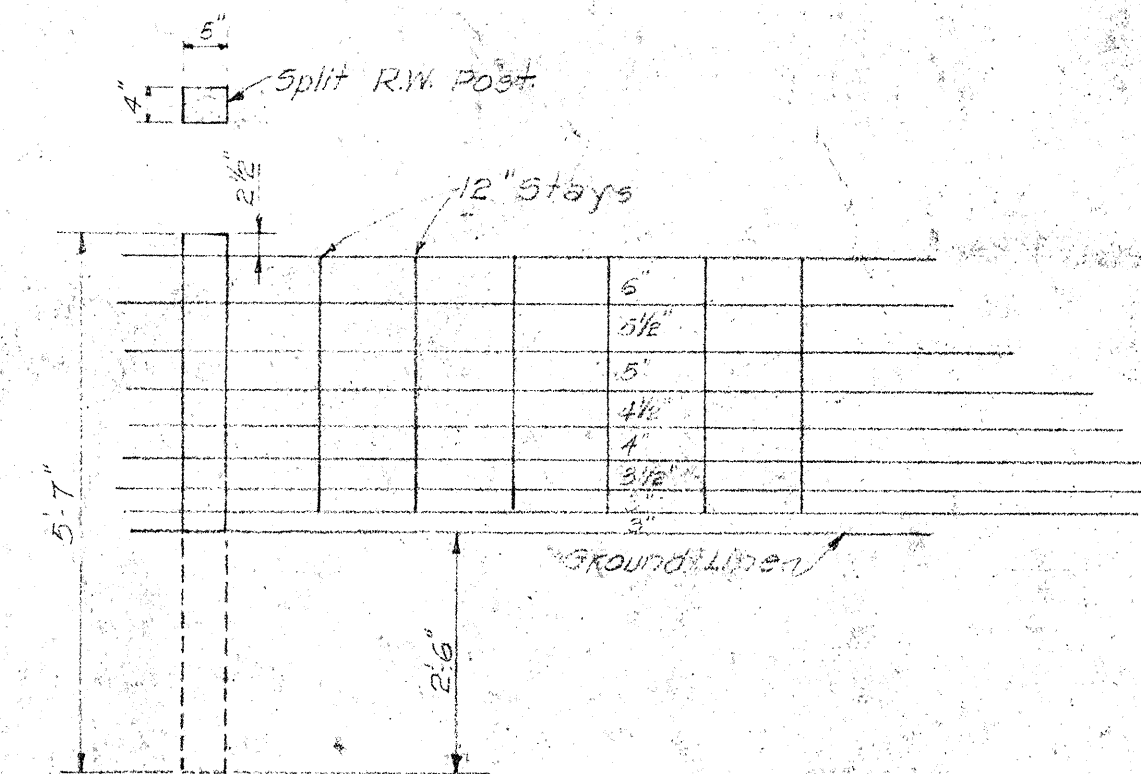
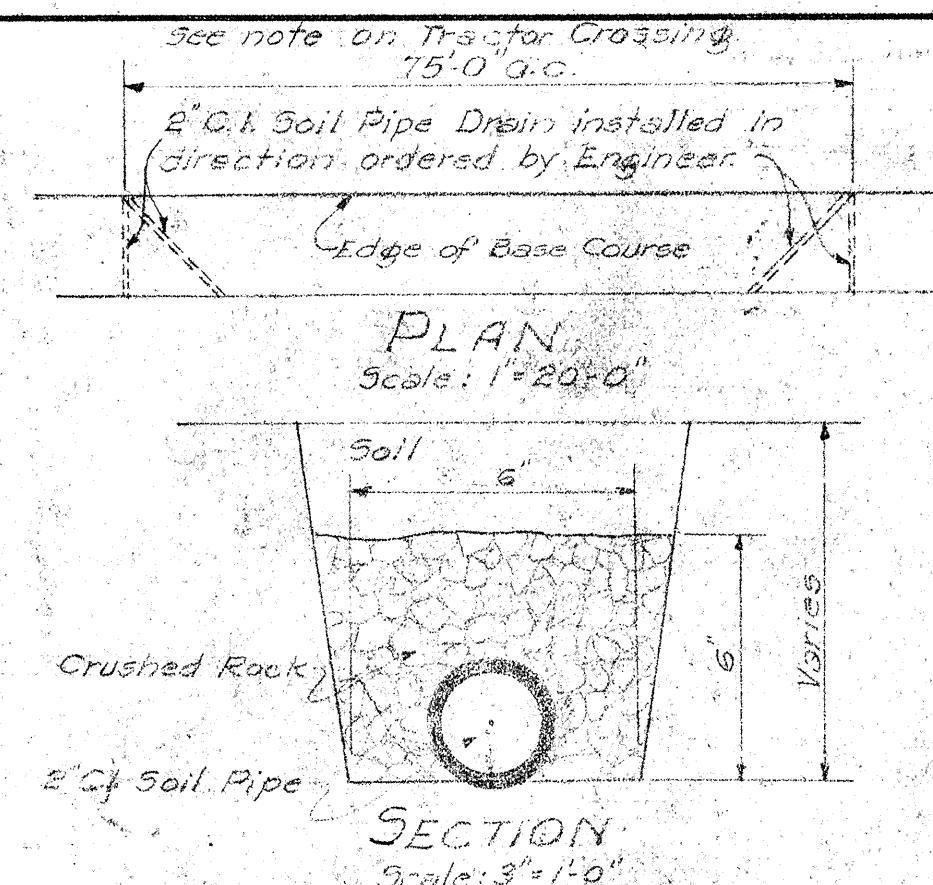


TERRITORIAL HIGHWAY DEPARTMENT
TERRITORY OF HAWAII
MISCELLANEOUS DETAILS
ROADS WAIALUA TOWARD KAENA POINT