


Datum Elevations based on U.S.C.&G.S. datum
Azimuths referred to Puulki Δ

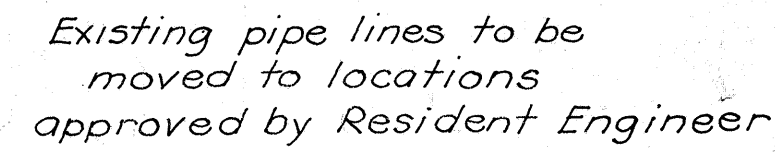


2

H. H. Chung.	Sept. 1938
G. V. Clark	Oct. "
H. H. Chung	Nov. "

FED. ROAD DIST. NO.	STATE	FED. AID PROJ. NO.	FISCAL YEAR	SHEET NO.	TOTAL SHEETS
HAWAII	HAW	21-C(1)	1939	4	9

HAWAII HAW 7-J(1) 1939 4 15

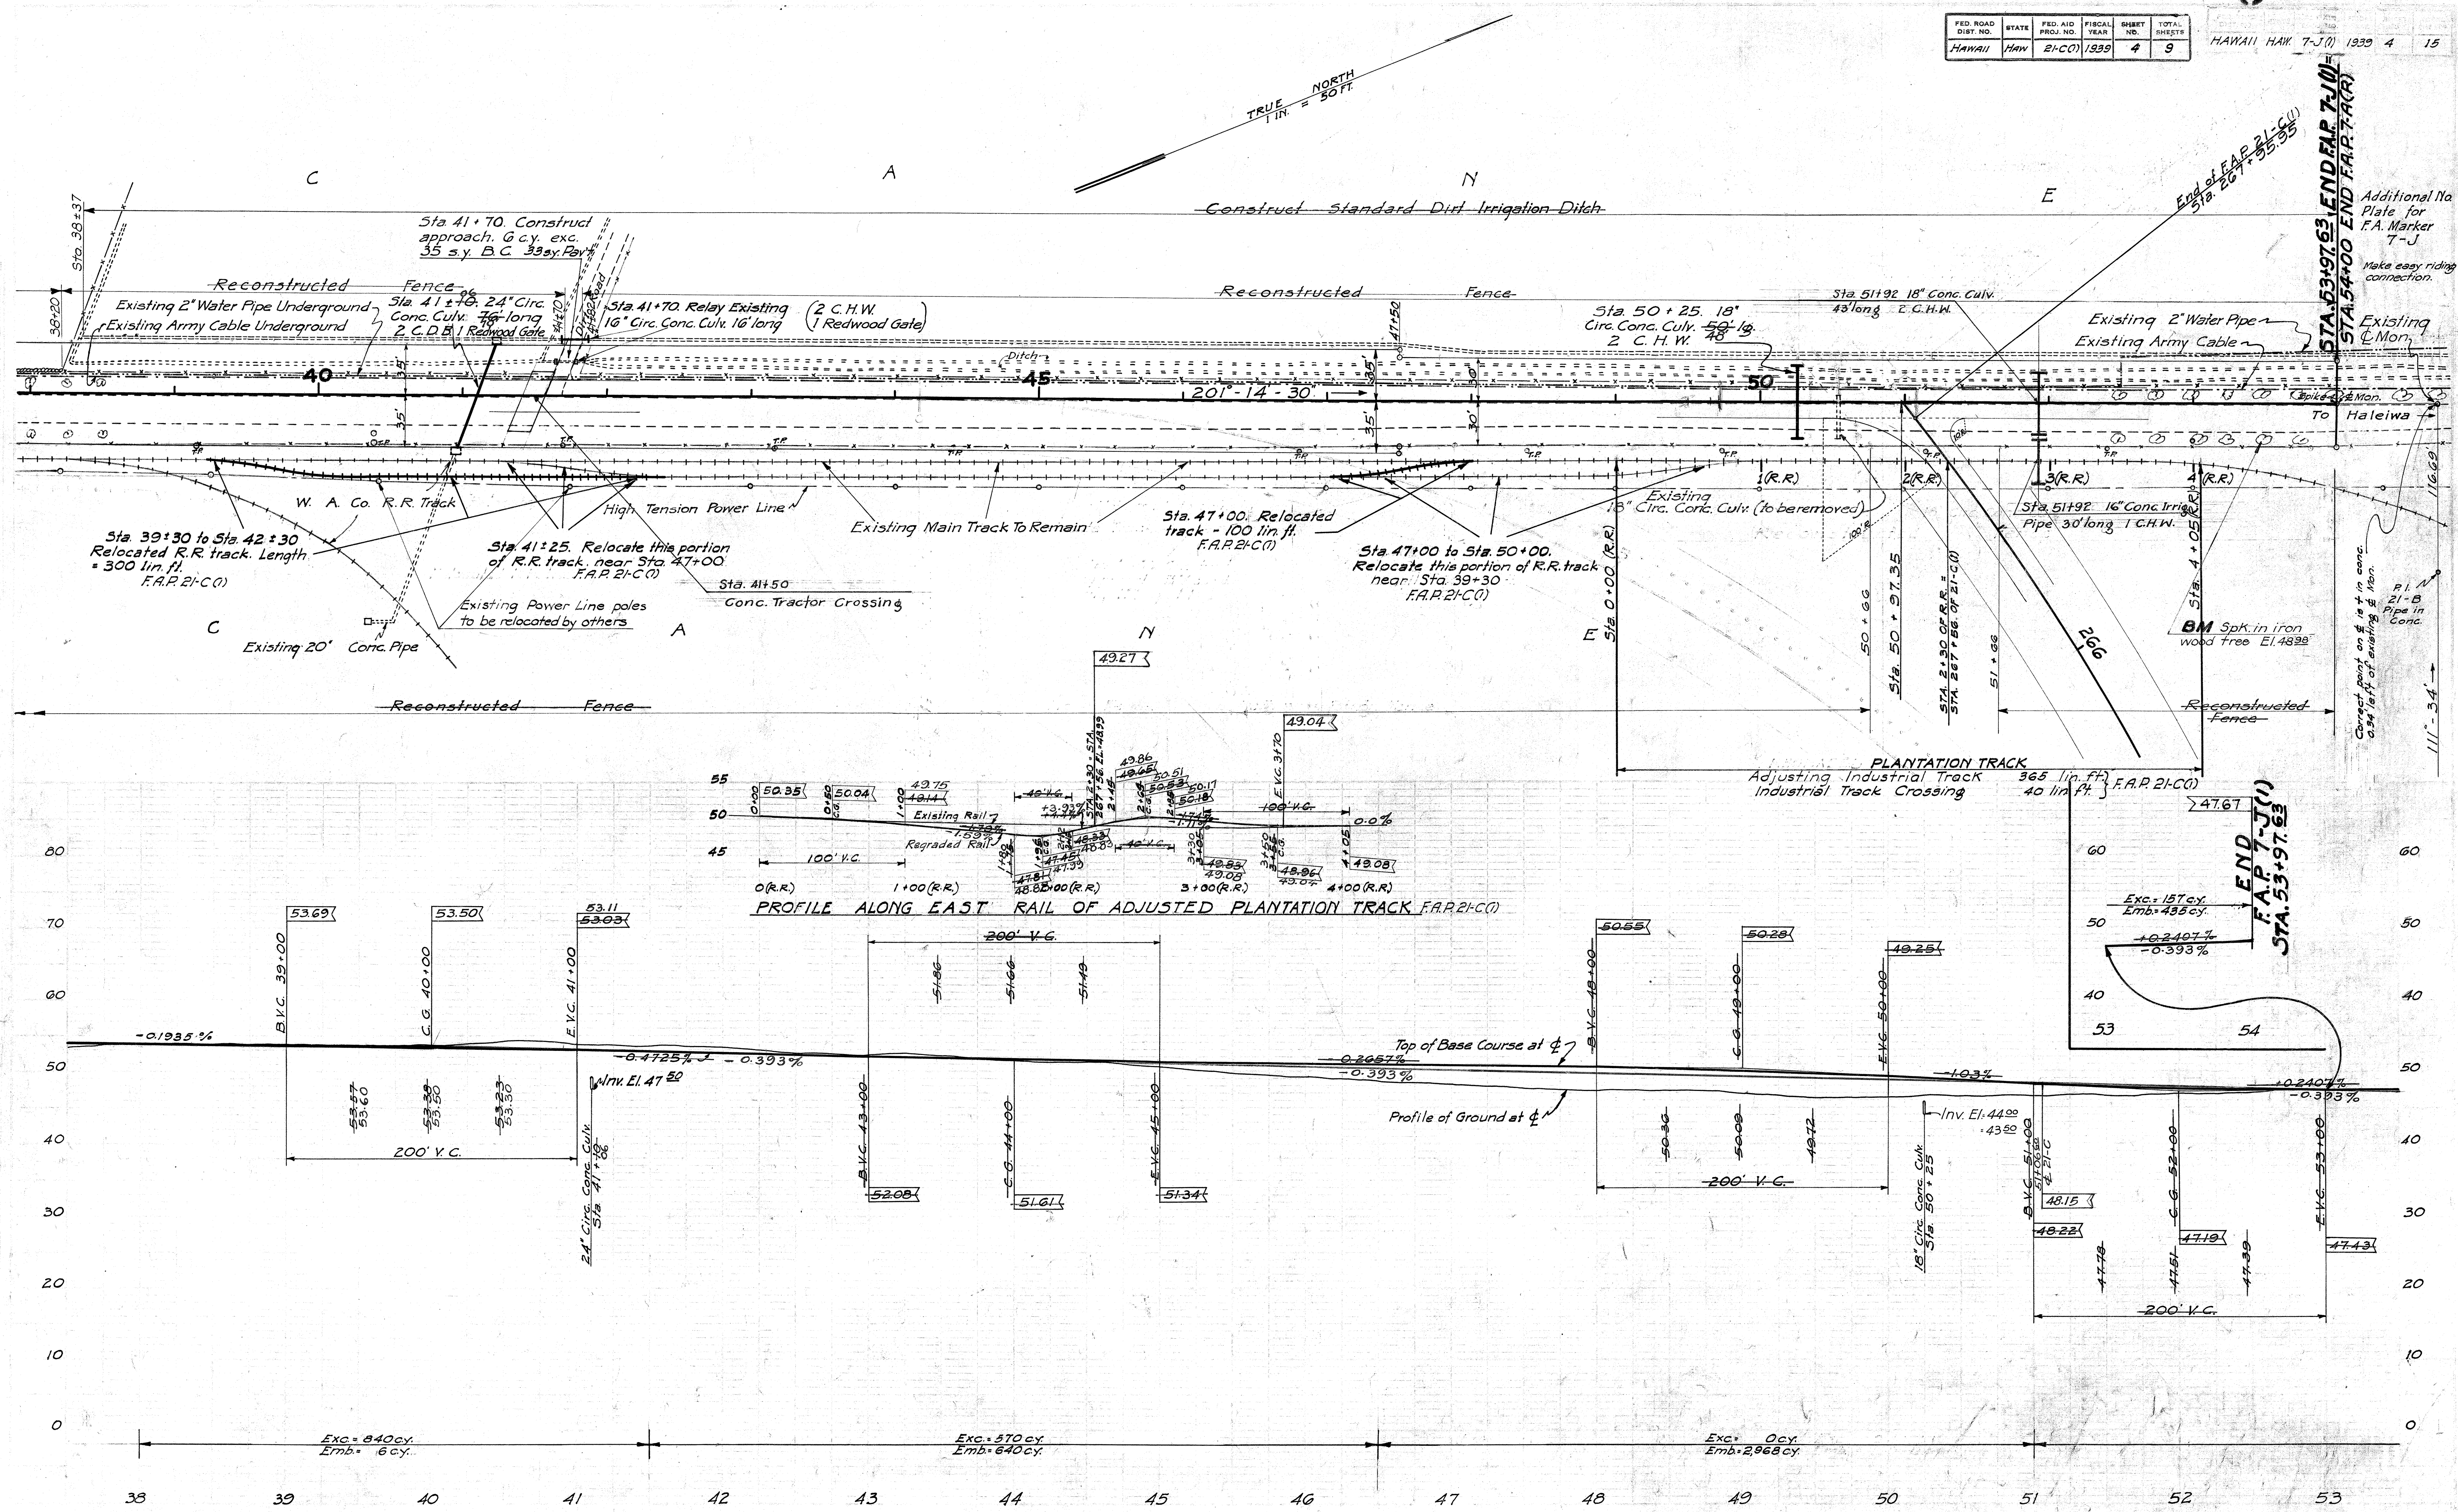

H.H. Chung
 G.V. Clark
 H.H. Chung
 Sept 1939
 Oct
 Nov

4498.4

4499.4