
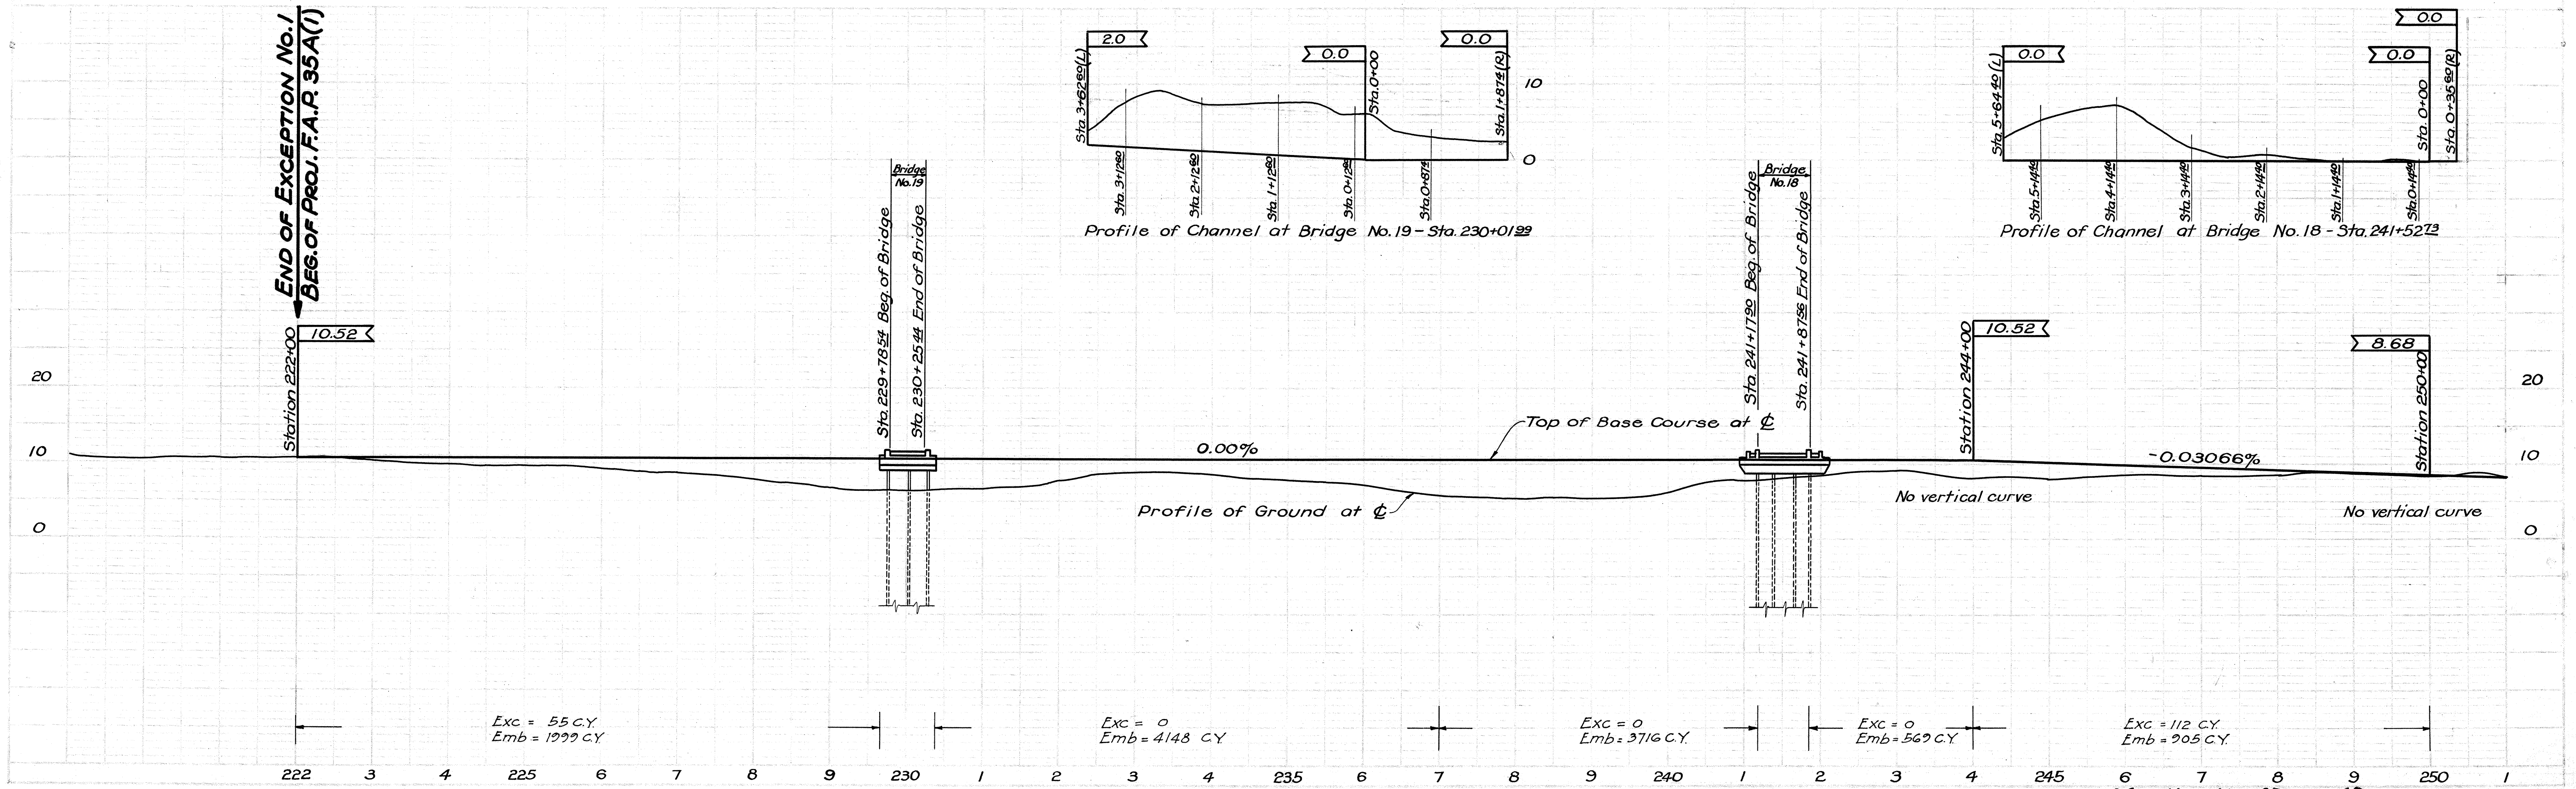






FED. ROAD DIST. NO.	STATE	FED. AID PROJ. NO.	FISCAL YEAR	SHEET NO.	TOTAL SHEETS
HAWAII	HAW	35A(1)	1939	3	33

Revised April 1940

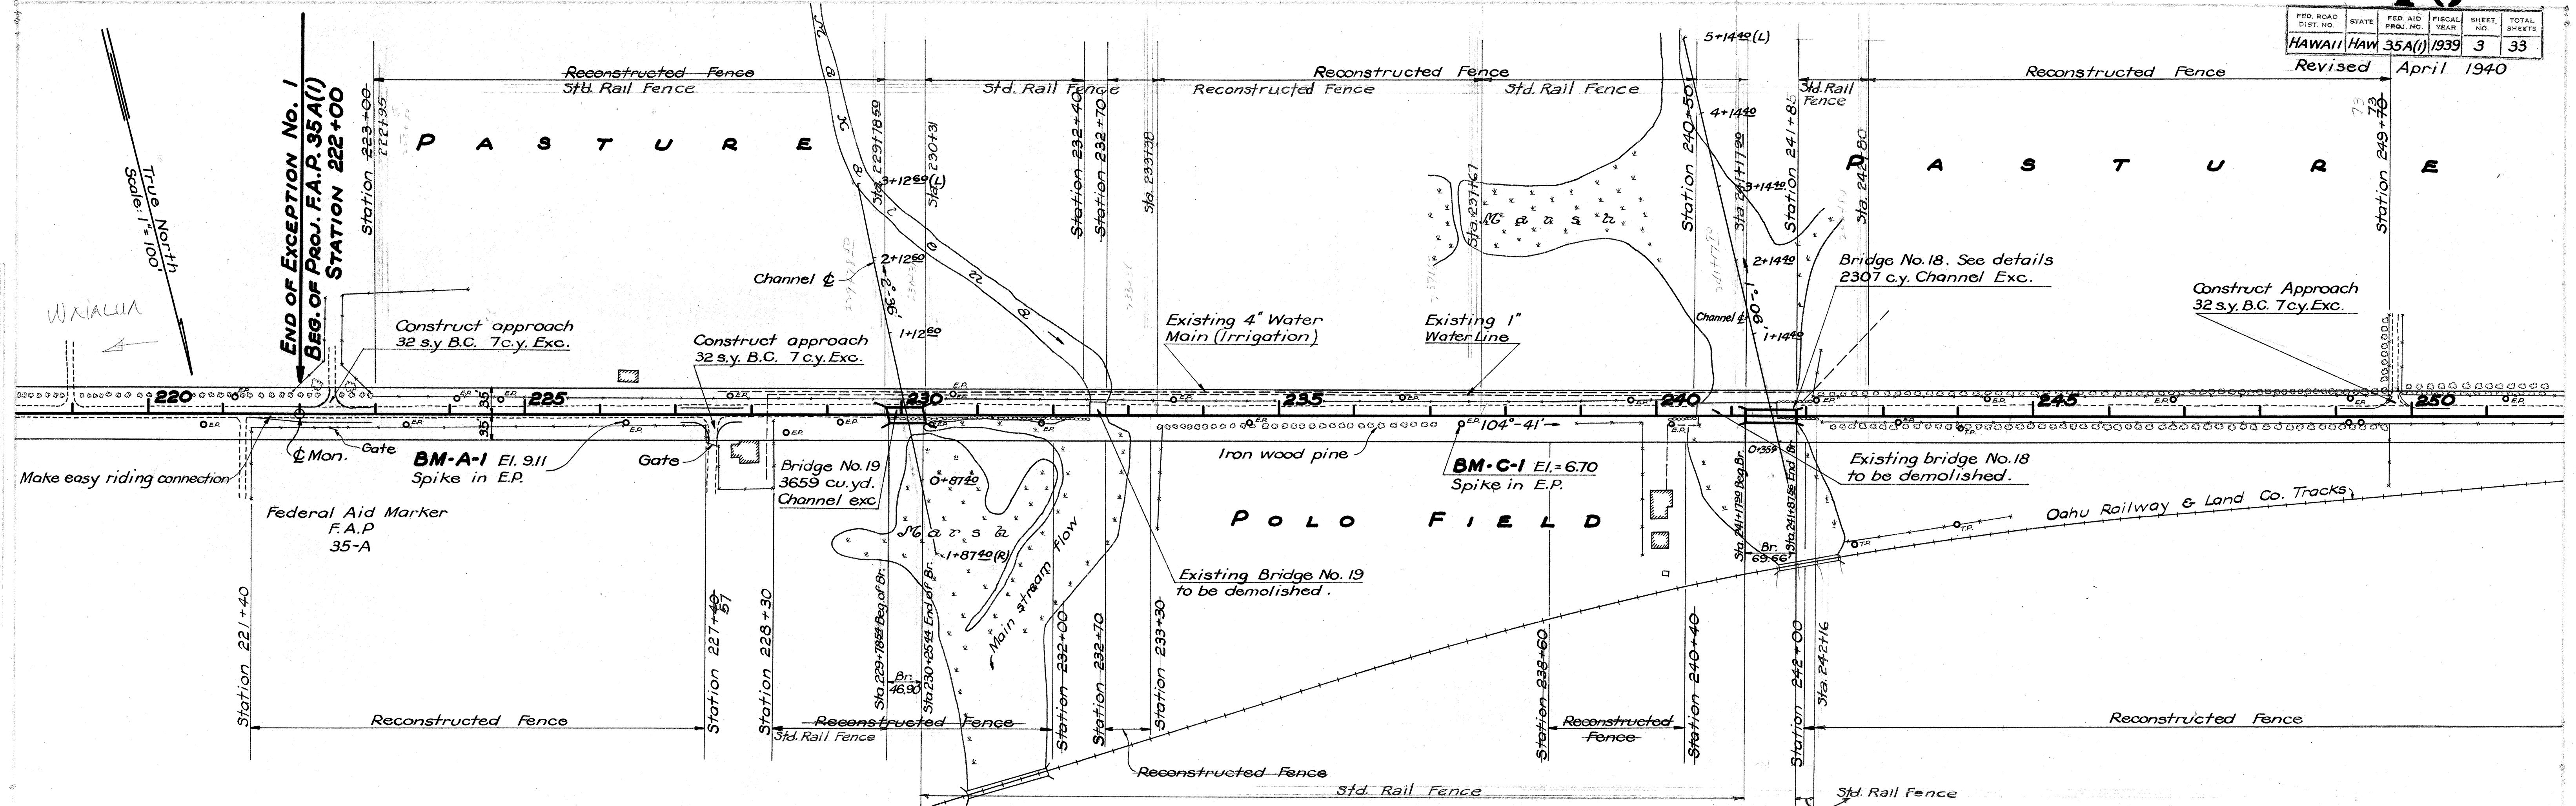


FED. ROAD DIST. NO.	STATE	FED. AID PROJ. NO.	FISCAL YEAR	SHEET NO.	TOTAL SHEETS
HAWAII	HAW.	35-A	1940	3A	33

F.A.P. 35-A (1)

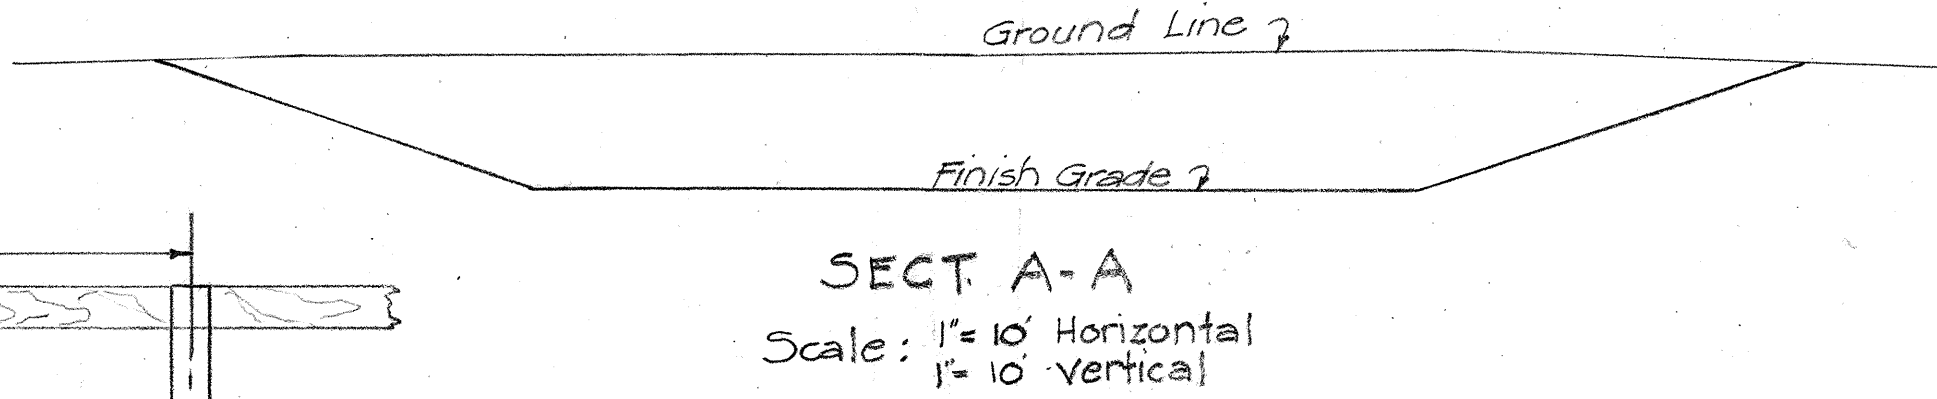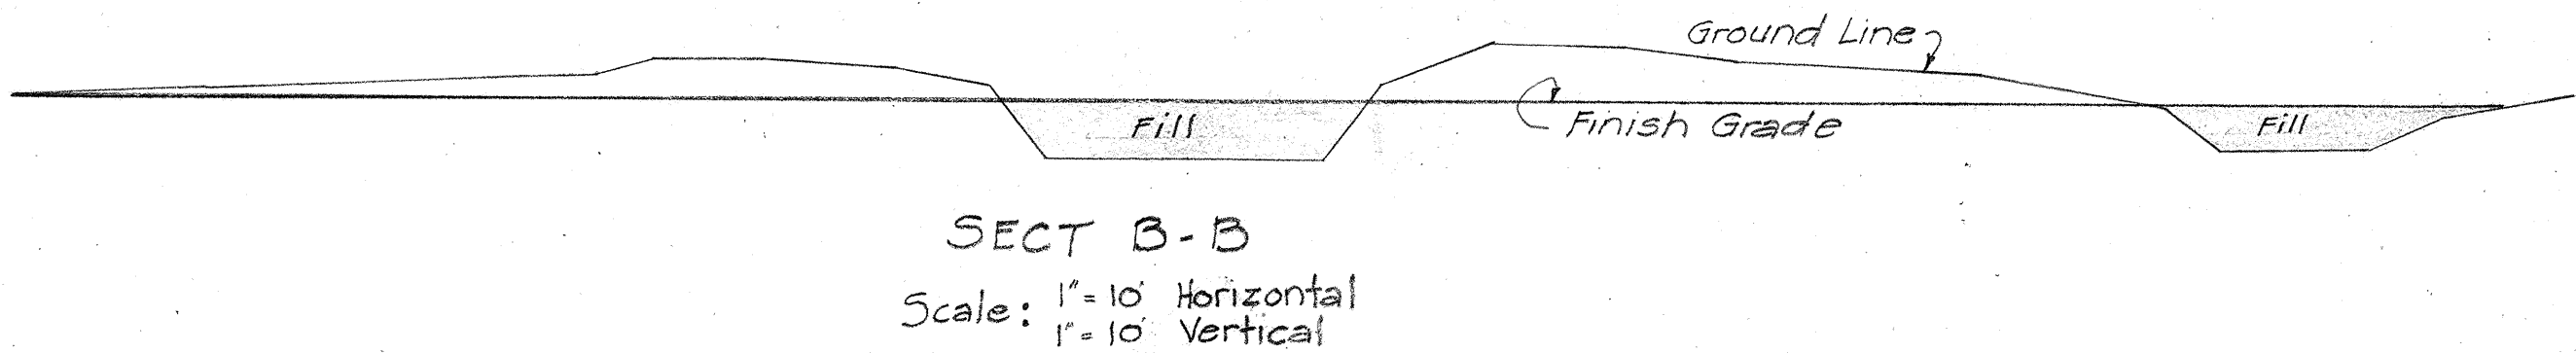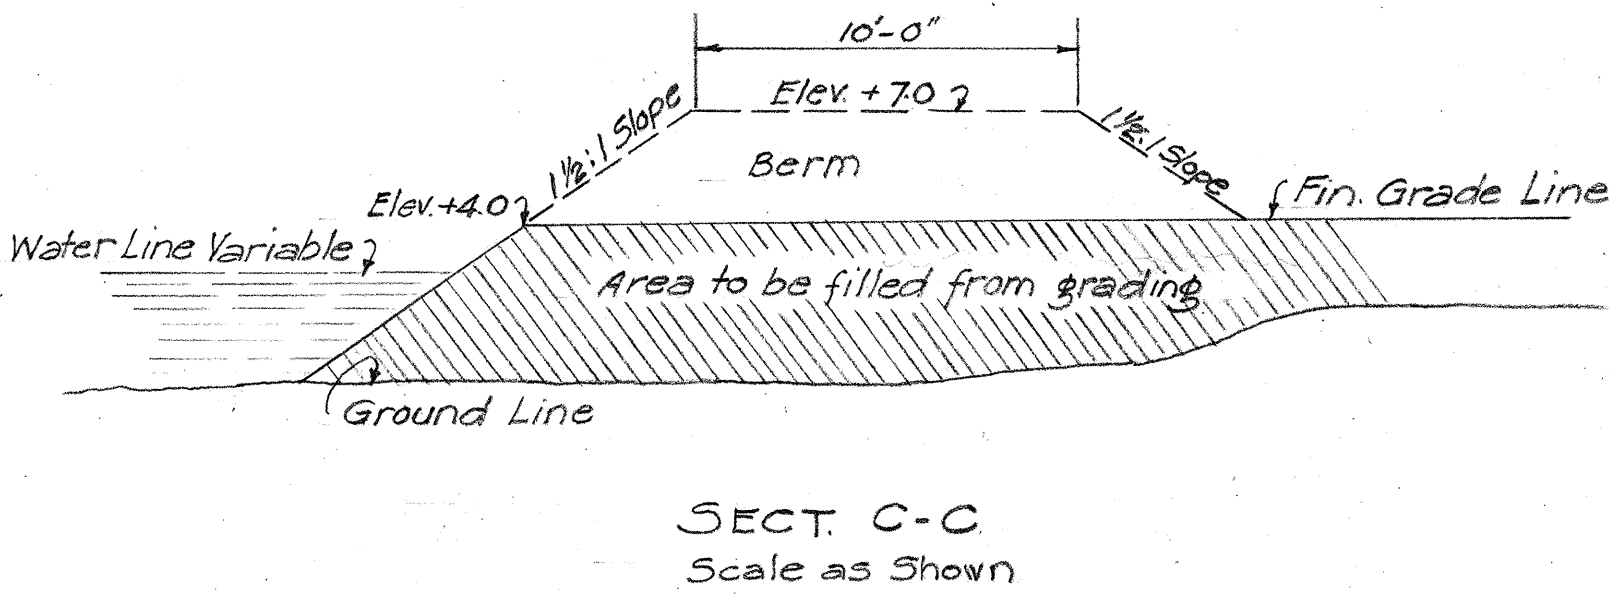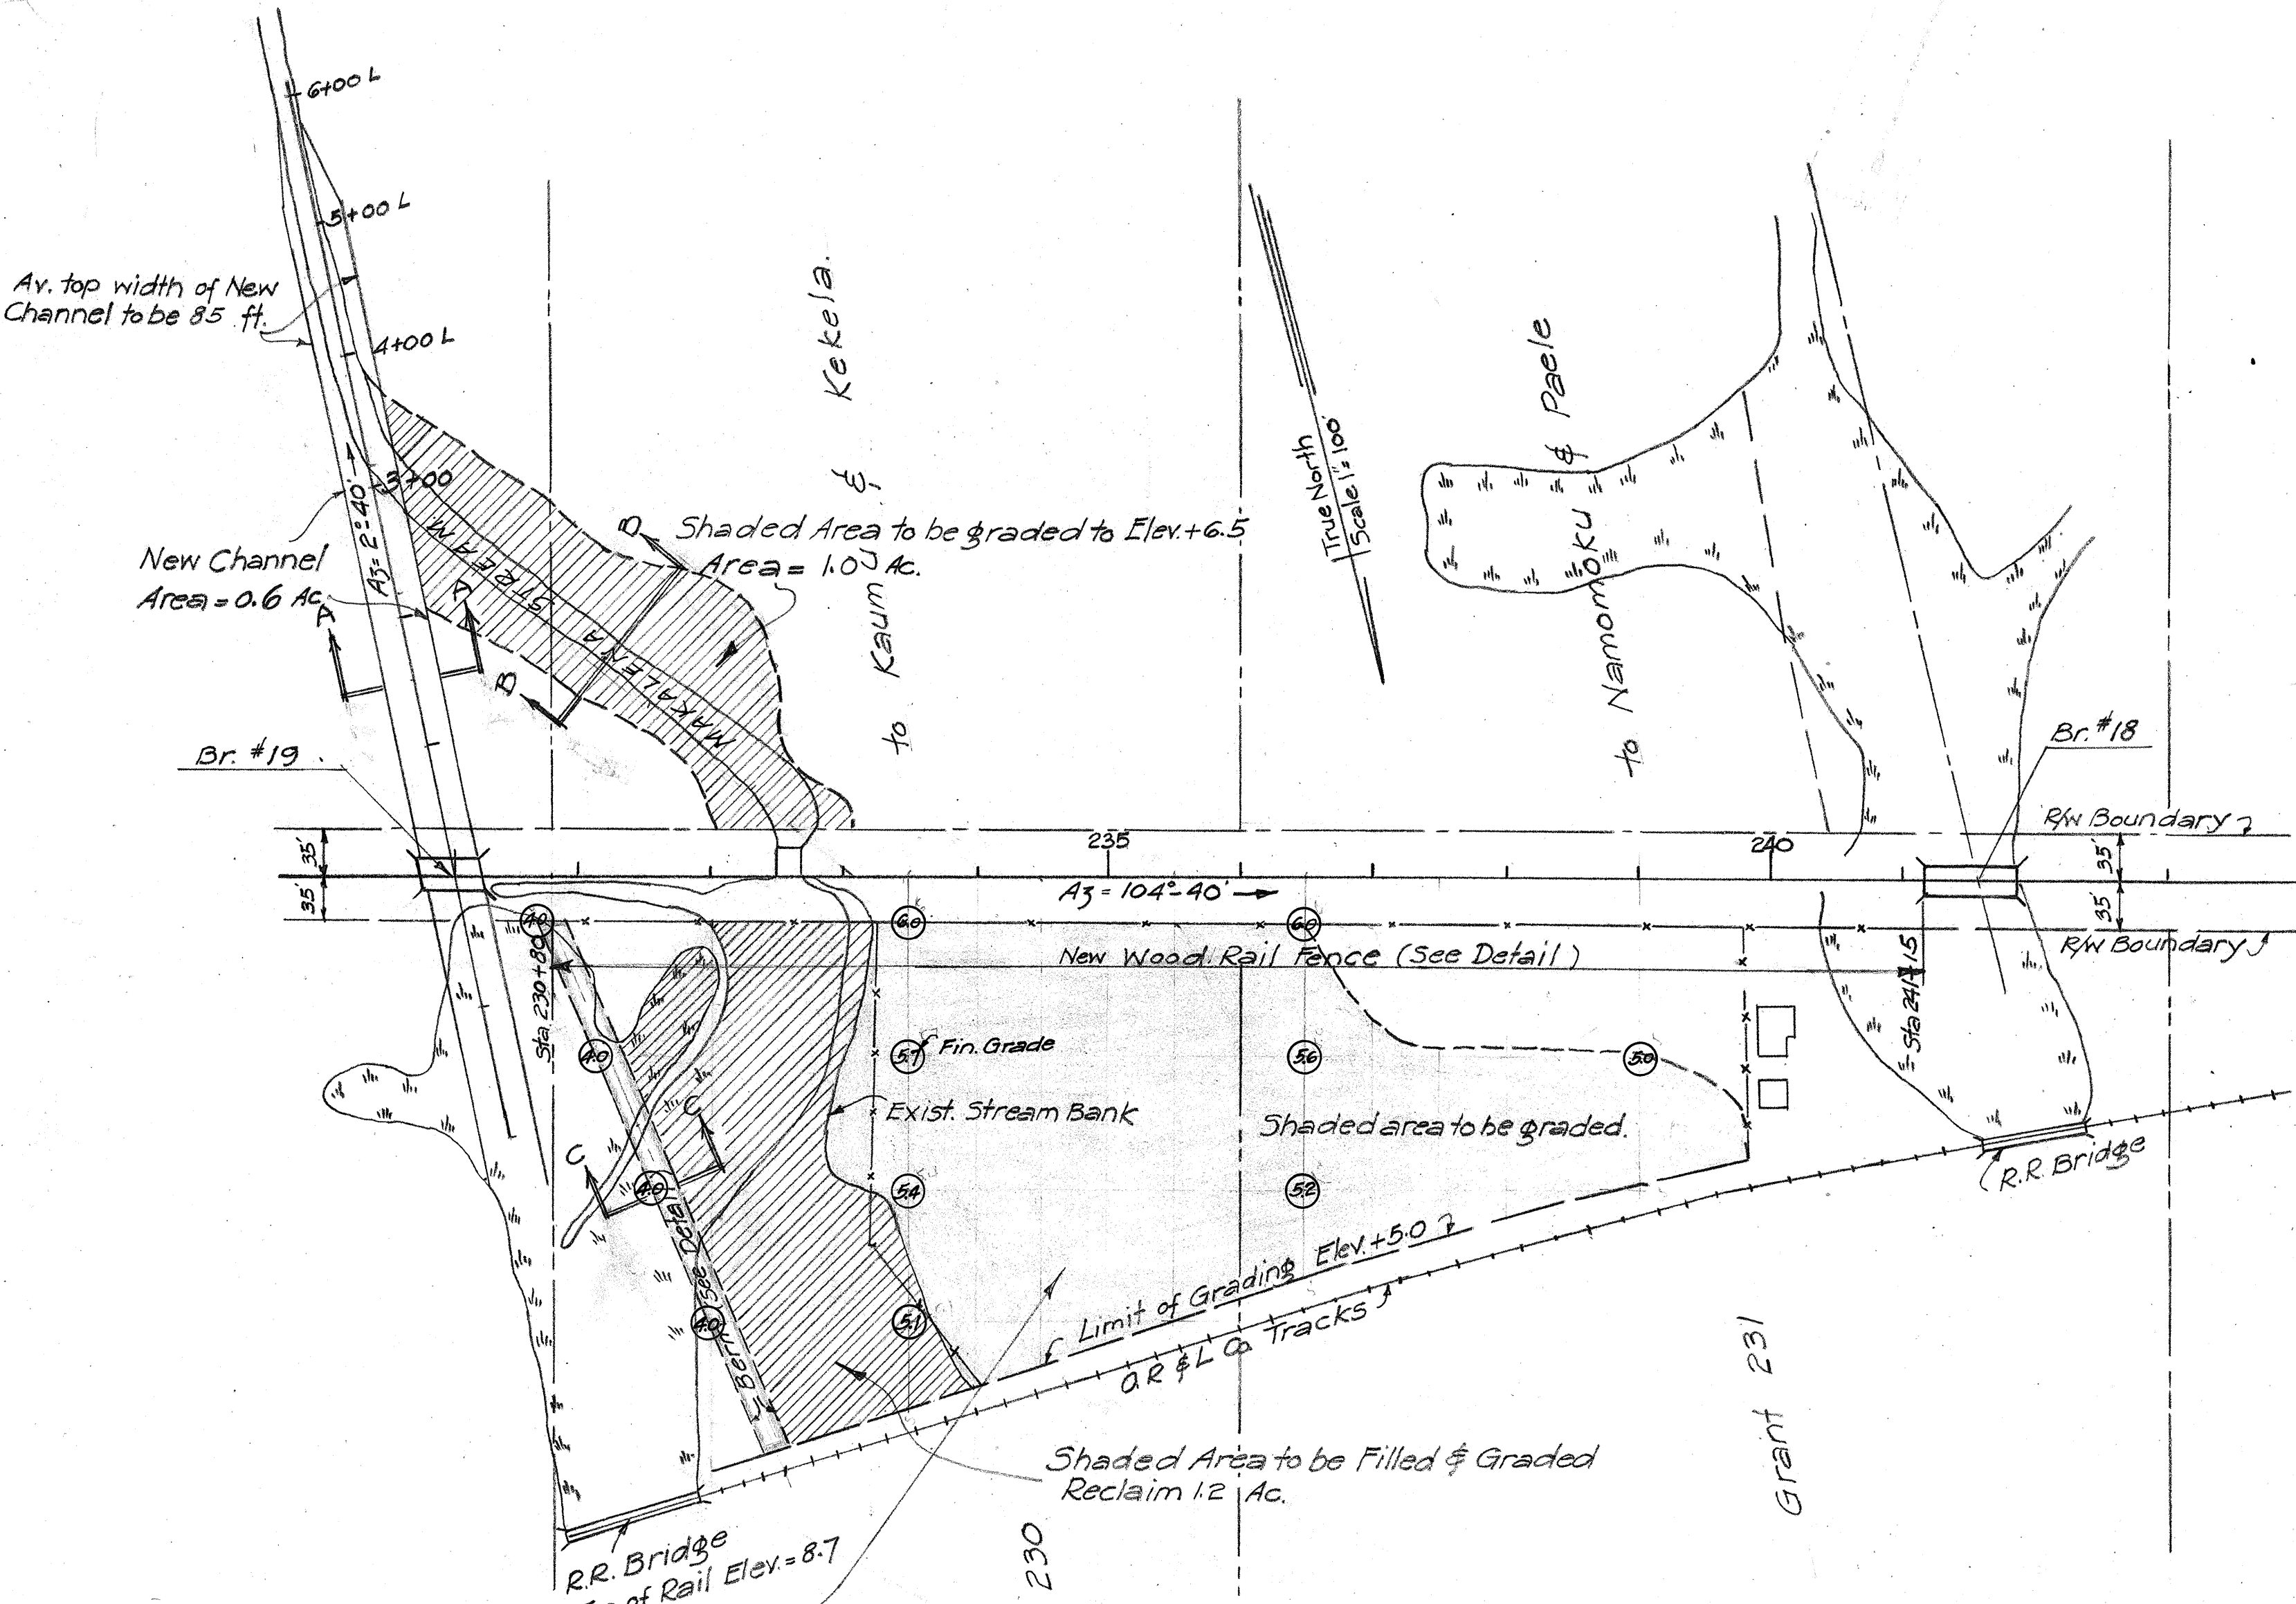

Reclaim Area	1.2 Ac.
"	1.0 "
Total	2.2 "
Less Area for New Channel	0.6 "
Net Reclaim	1.6 "

NOTE: This area will be fine graded to neat lines with a blade grader and in no instance shall vary from the true plane by more than 6 inches in 50 feet.

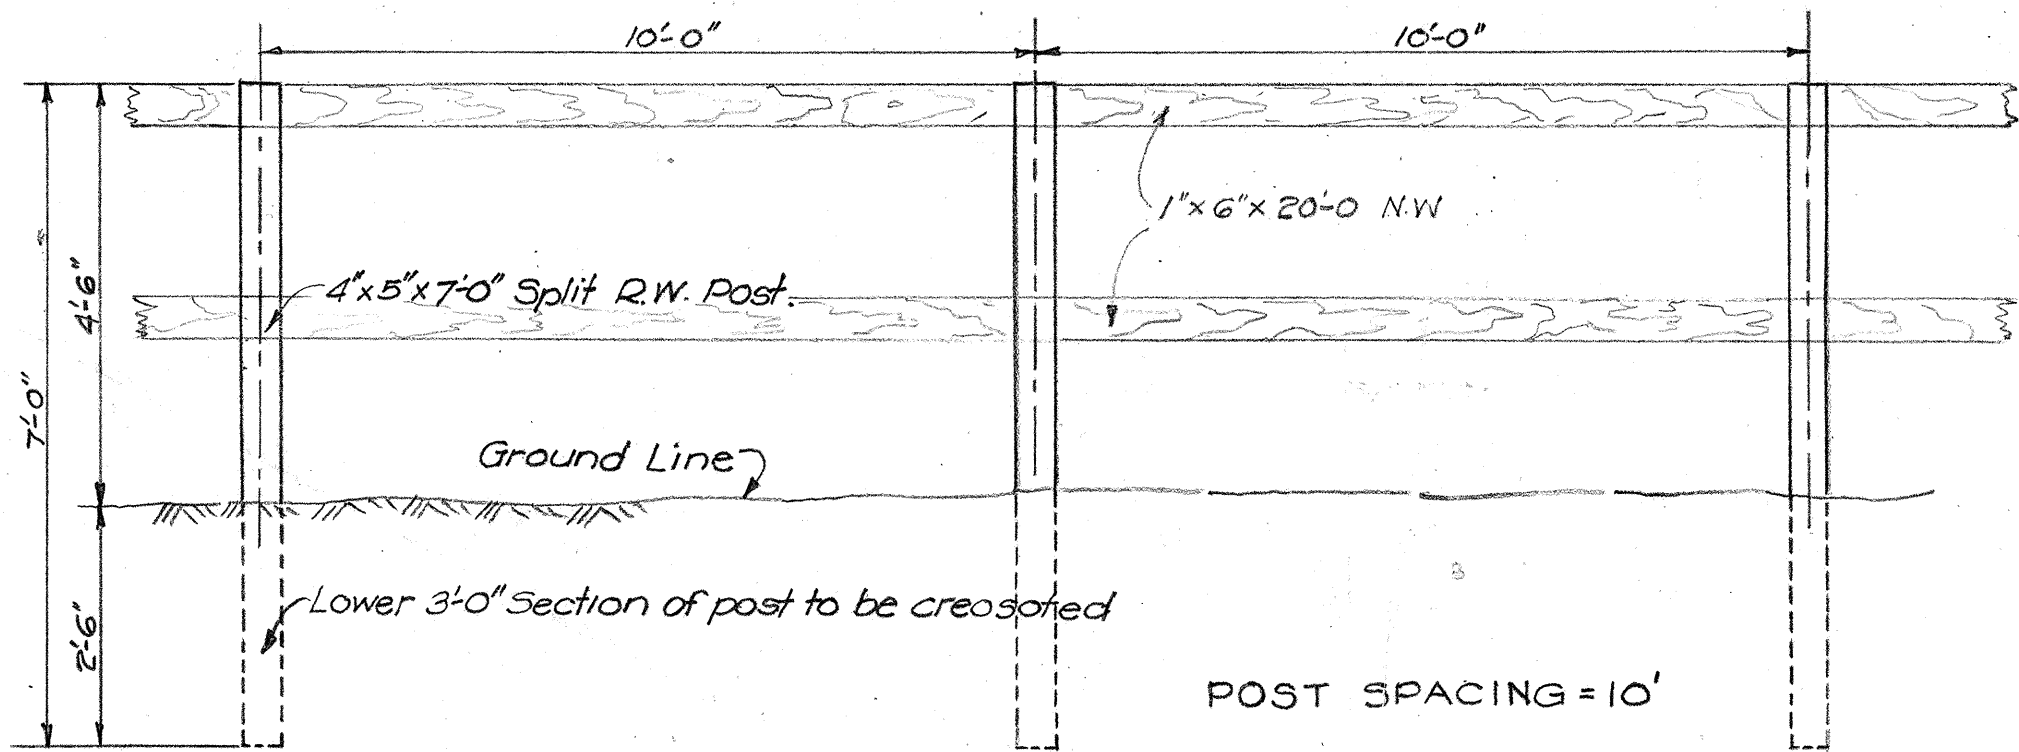

DETAILS OF WOOD RAIL FENCE
Scale as Shown.

TERRITORIAL HIGHWAY DEPARTMENT
TERRITORY OF HAWAII

BORROW PIT "D"
F.A.P. 35-A



5003-3A

5003.31




FED. ROAD DIST. NO.	STATE	FED. AID PROJ. NO.	FISCAL YEAR	SHEET NO.	TOTAL SHEETS
HAWAII	HAW	35A(1)	1939	4	33

Revised April 1940

Curve Data
 $\Delta = 4^\circ 45' 30''$
 $R = 8594.37$
 $D = 0^\circ 40' 00''$
 $T = 357.08$
 $C = 713.54$
 $L_c = 713.75$
 $S.E. = 0.0136$

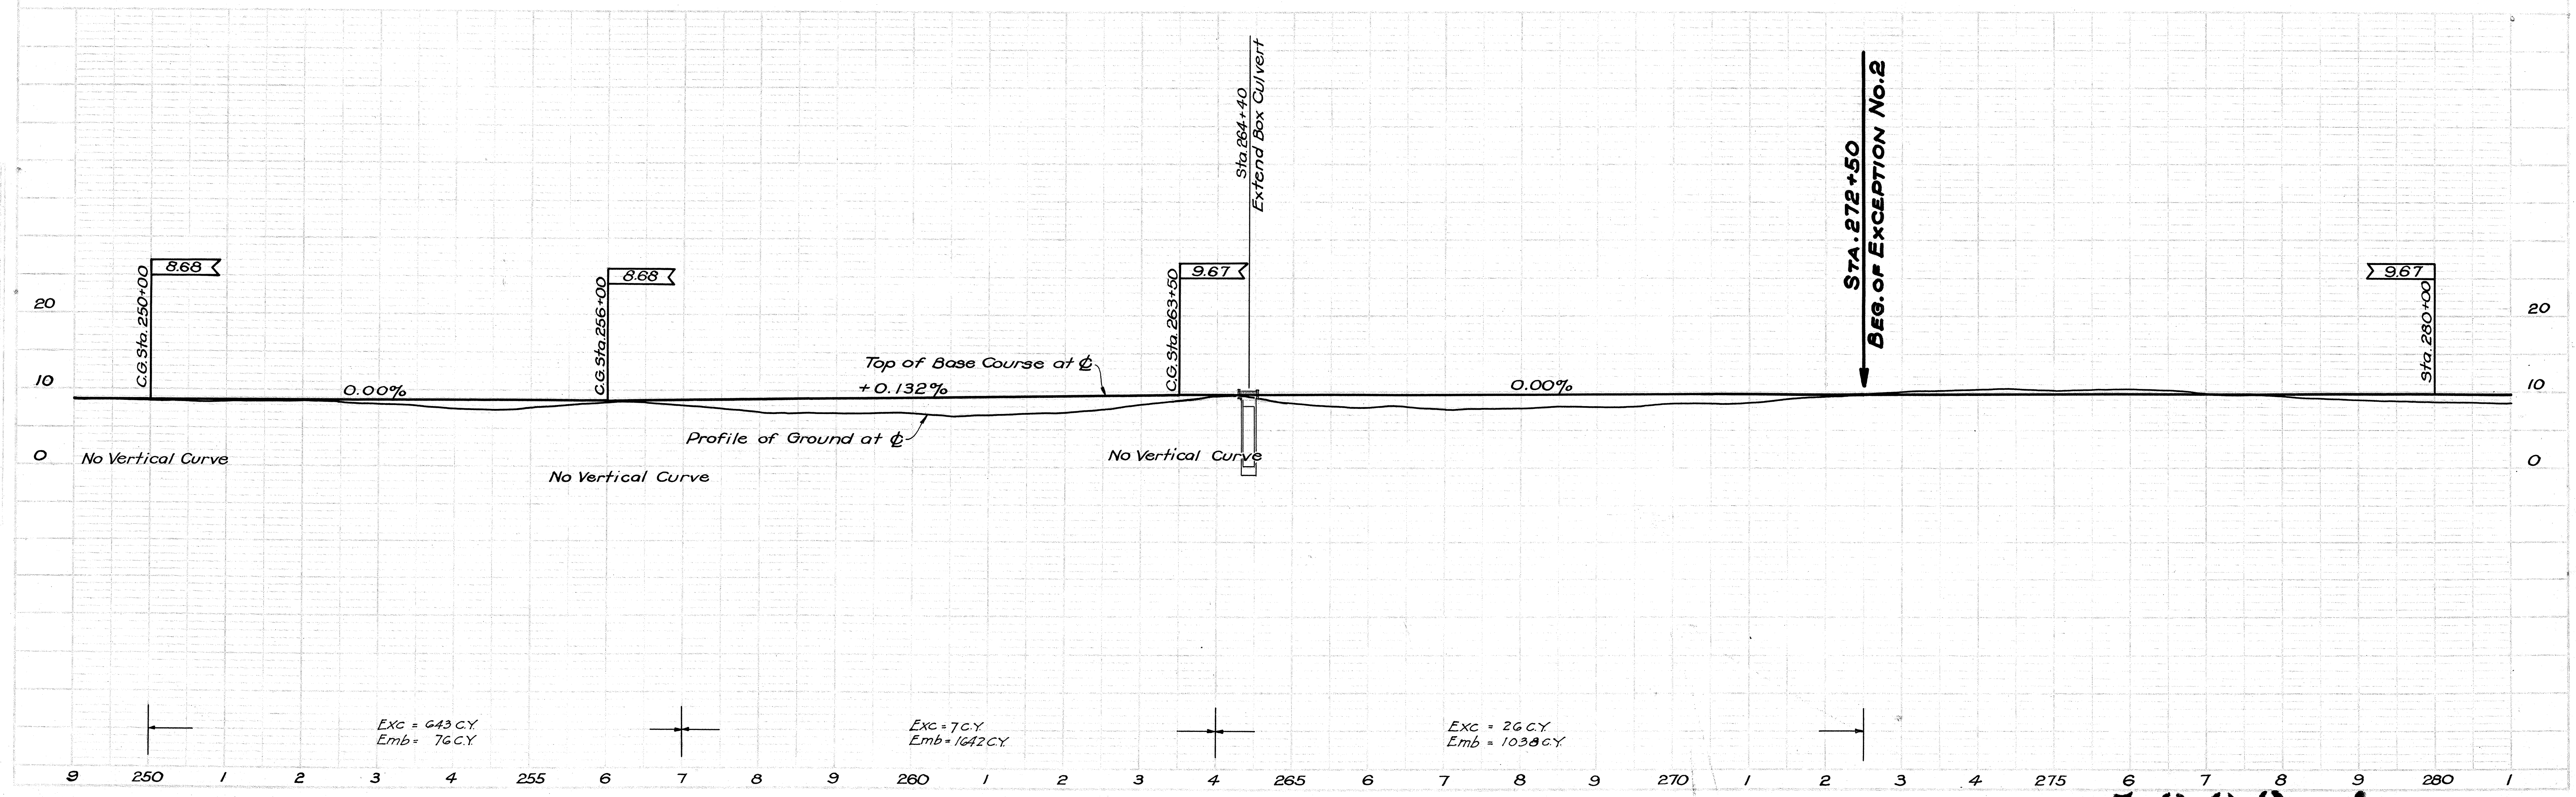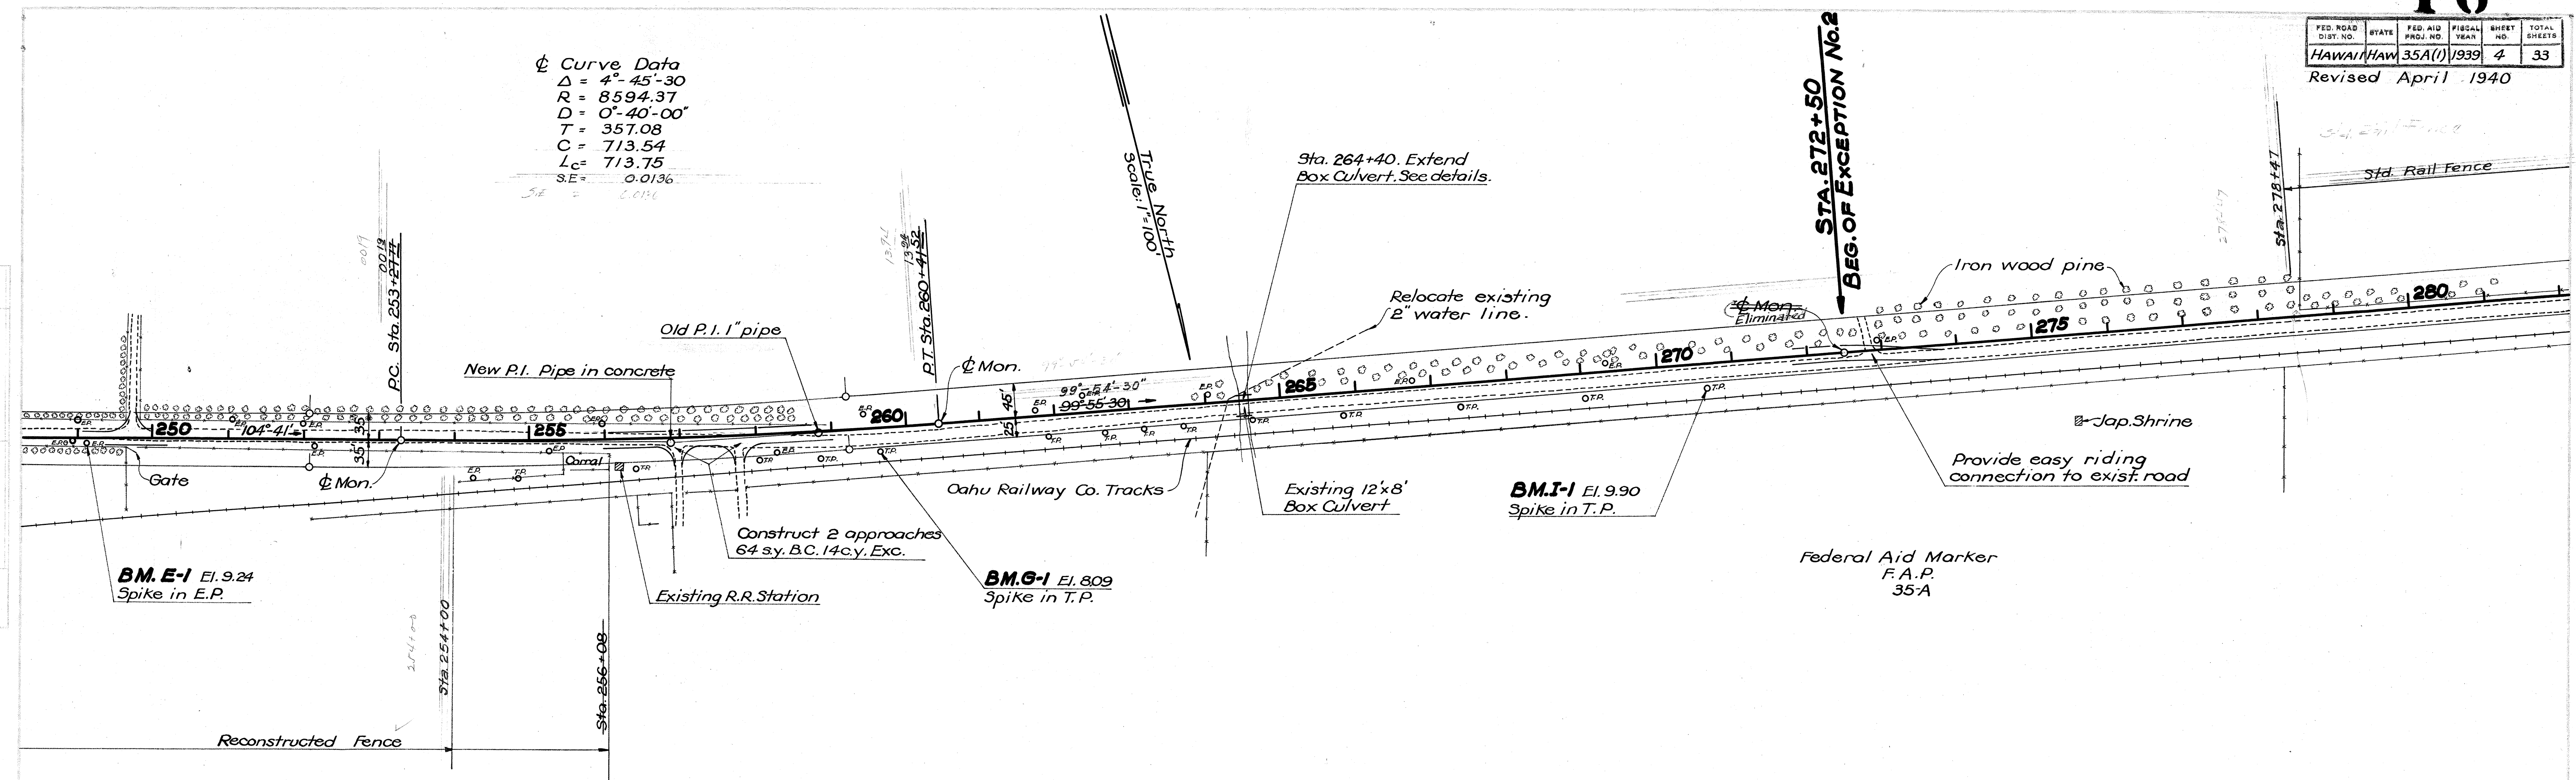

FED. ROAD DIST. NO.	STATE	FED. AID PROJ. NO.	FISCAL YEAR	SHEET NO.	TOTAL SHEETS
HAWAII	HAW.	35.401	1939	5	33

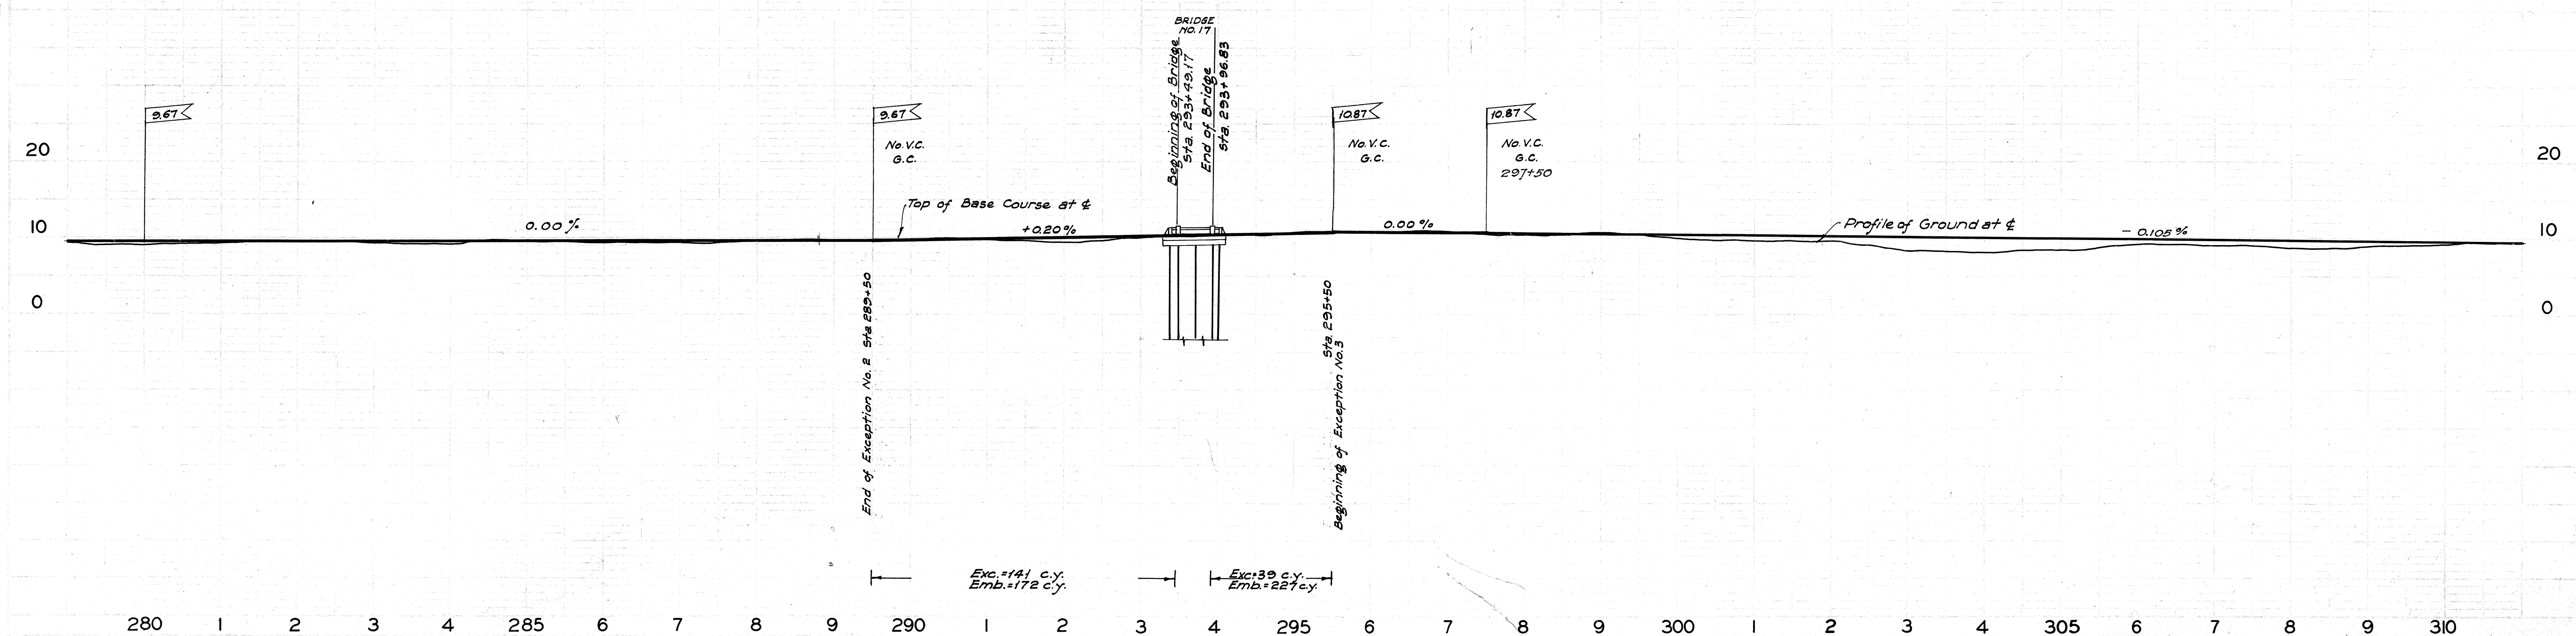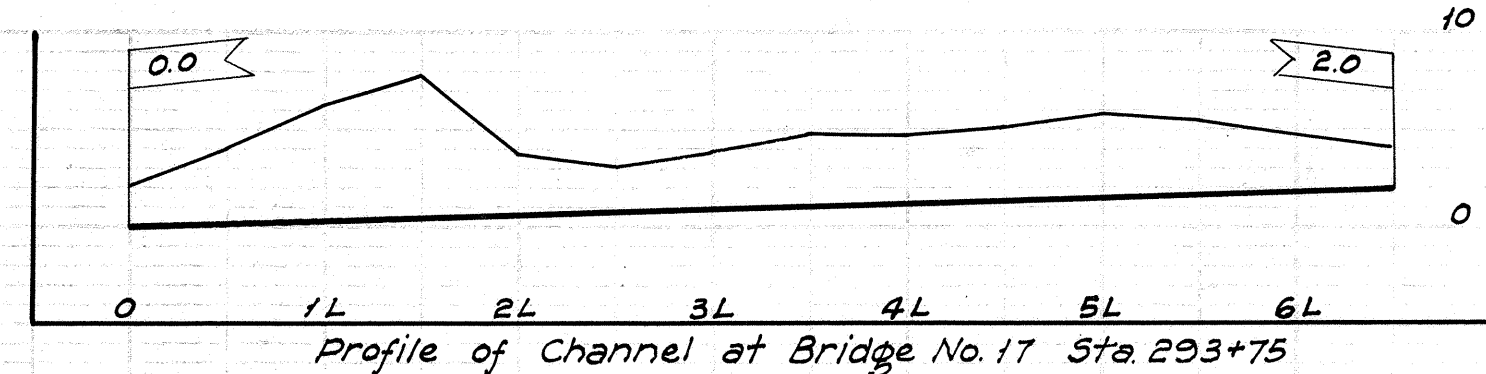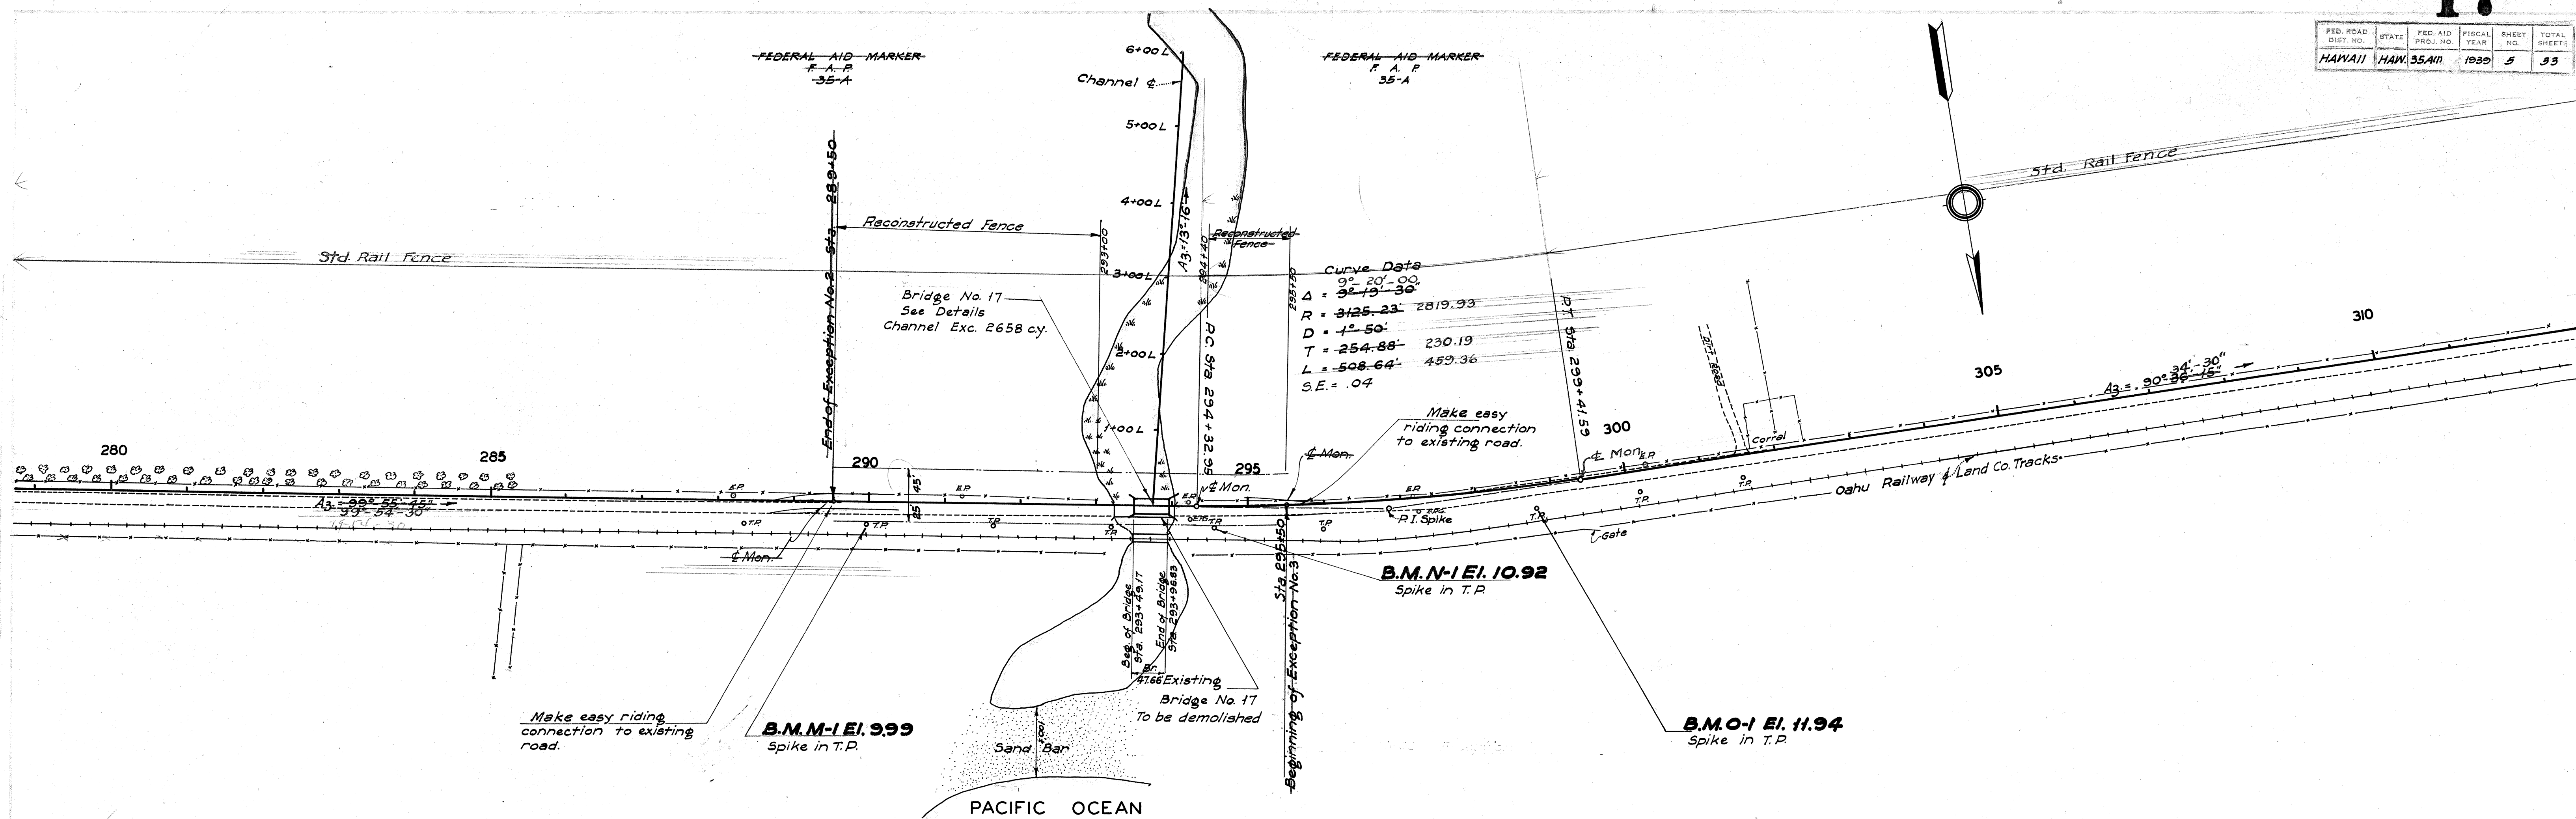

FED. ROAD DIST. NO.	STATE	FED. AID PROJ. NO.	FISCAL YEAR	SHEET NO.	TOTAL SHEETS
HAWAII	HAW	55411	1939	6	33

