


FINAL SURVEY NO.	SURVEYED BY	DATE

ORIGINAL SURVEY NO.	SURVEYED BY	DATE

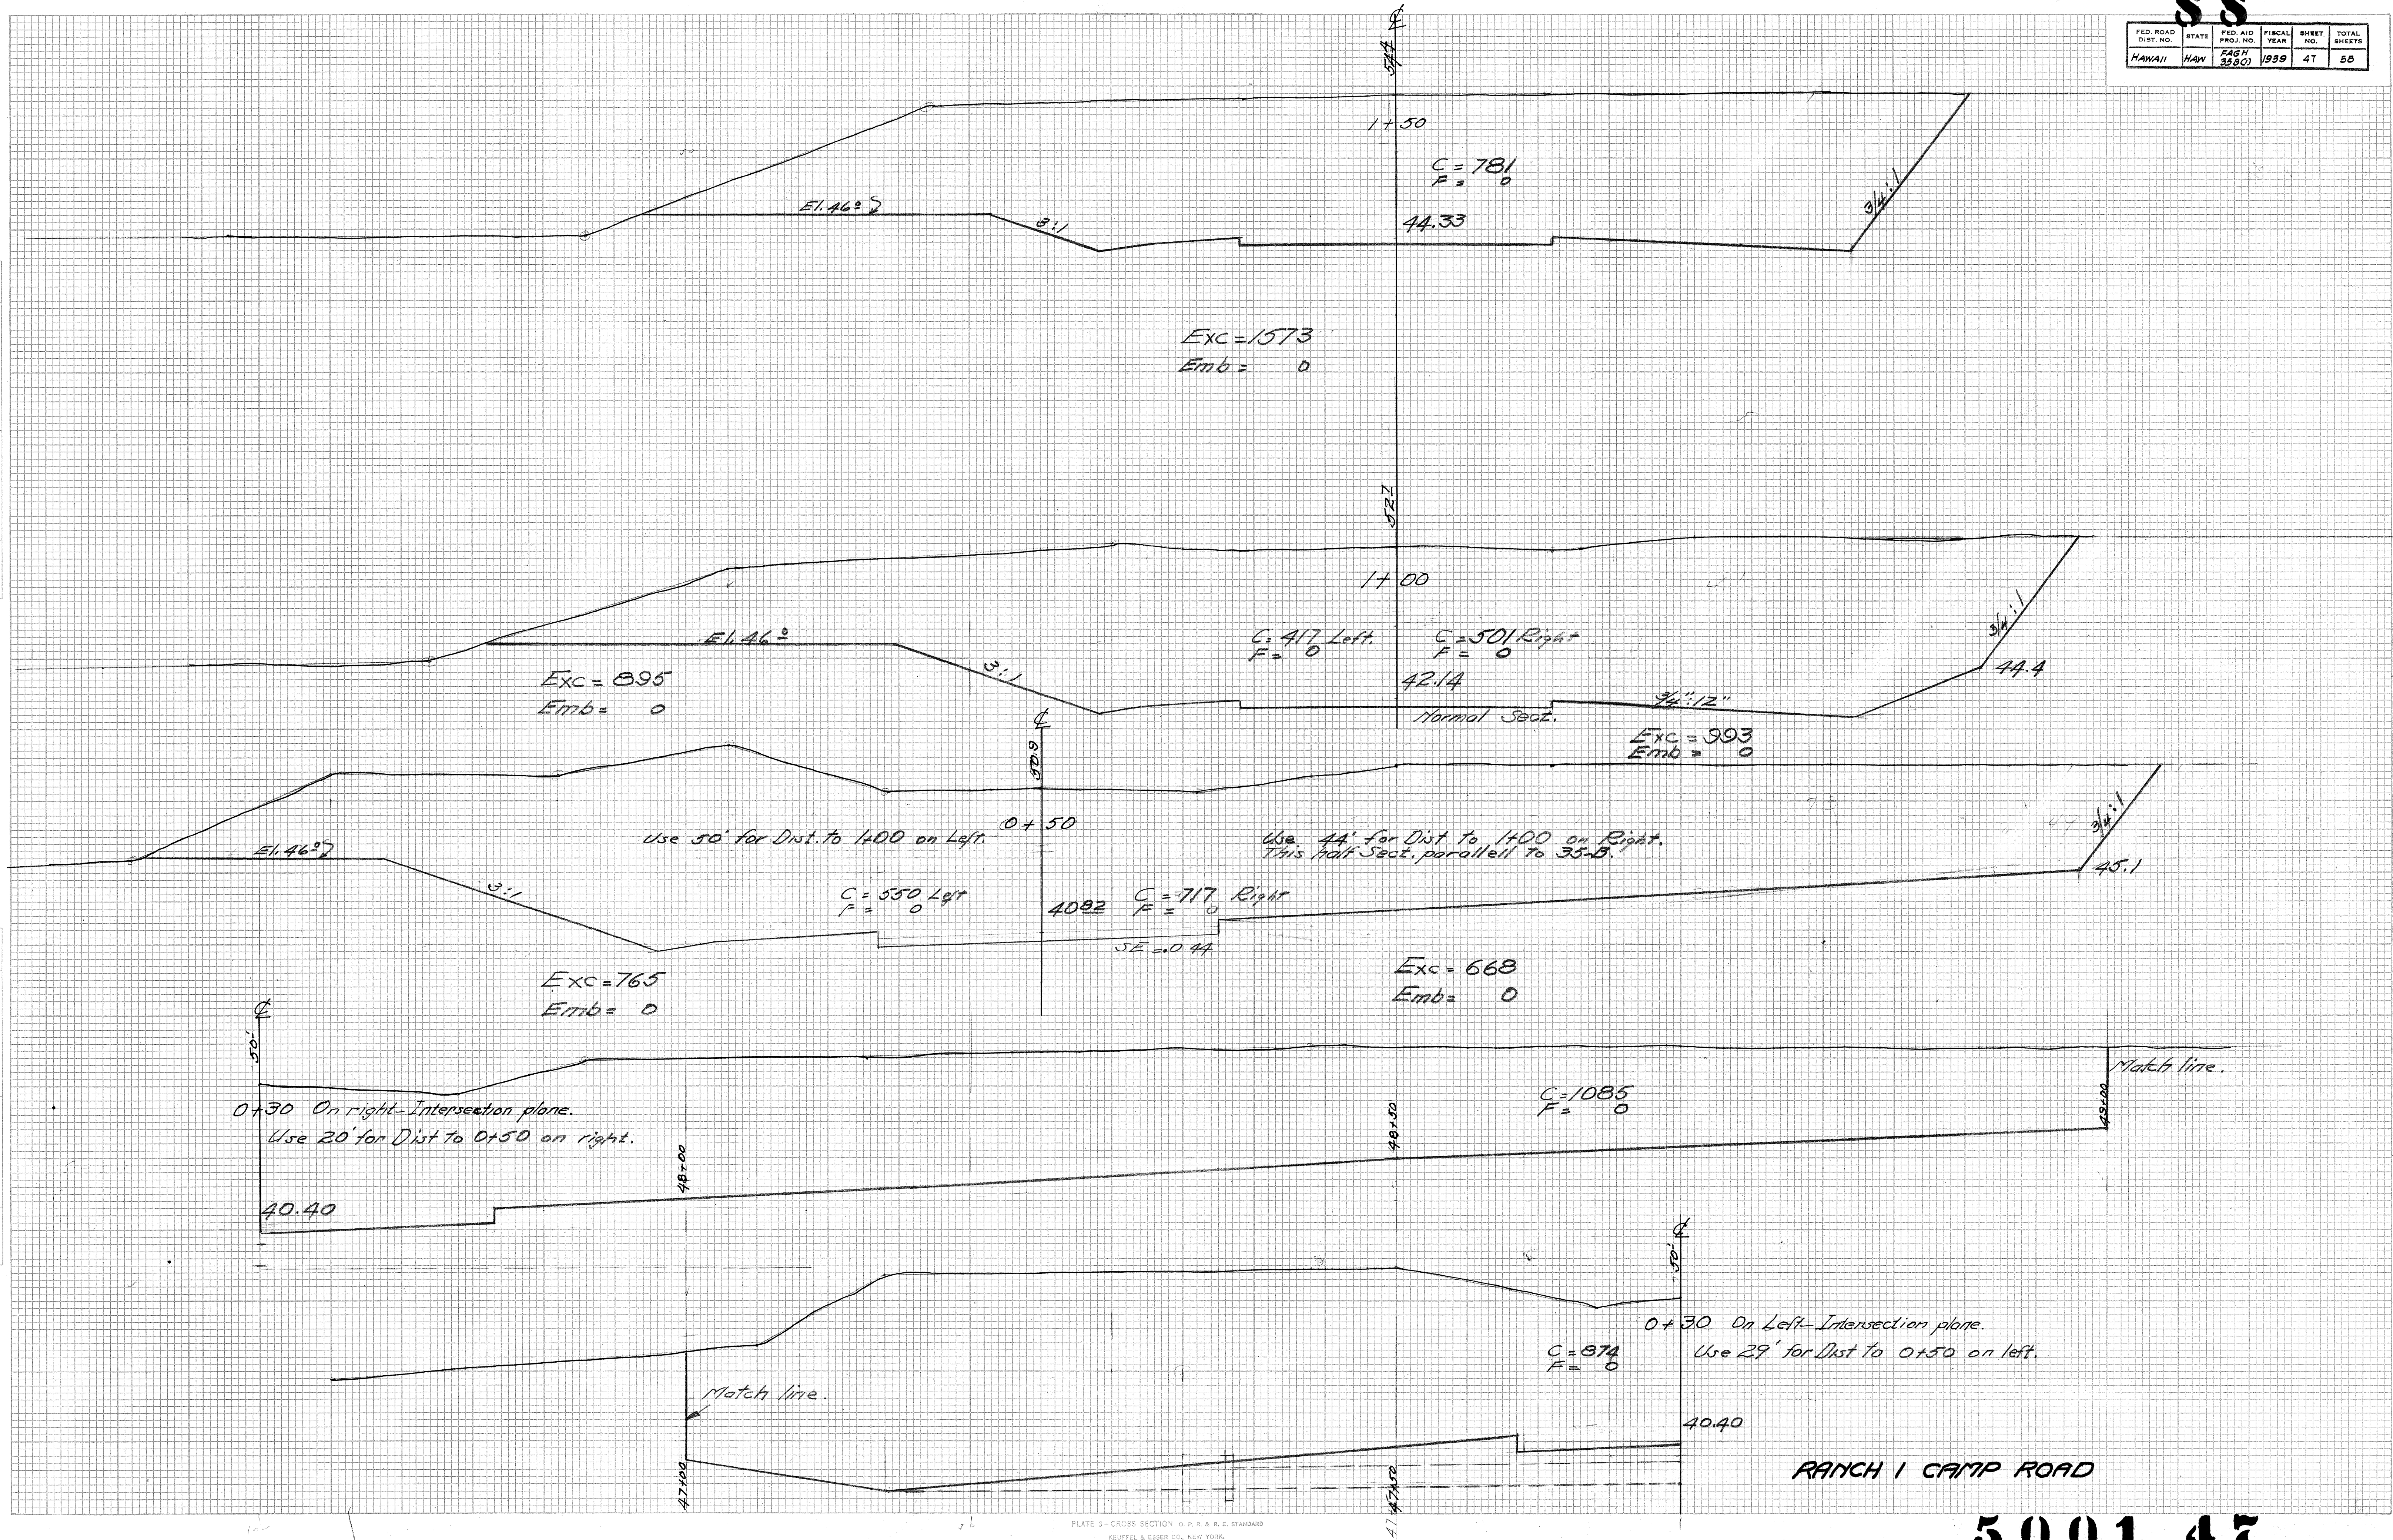


89

DIST. NO.	STATE	FED. AID PROJ. NO.	FISCAL YEAR	SHEET NO.
HAWAII	HAW	5580	1939	48

DATE	BY	FINAL SURVEY	NO.
4/11/39	HVC	NO. 1	
5/1/39	GVC	NO. 2	
5/1/39	HVC	NO. 3	
5/1/39	HVC	NO. 4	

DATE	BY	ORIGINAL SURVEY	NO.
4/11/39	HVC	NO. 1	
5/1/39	GVC	NO. 2	
5/1/39	HVC	NO. 3	
5/1/39	HVC	NO. 4	





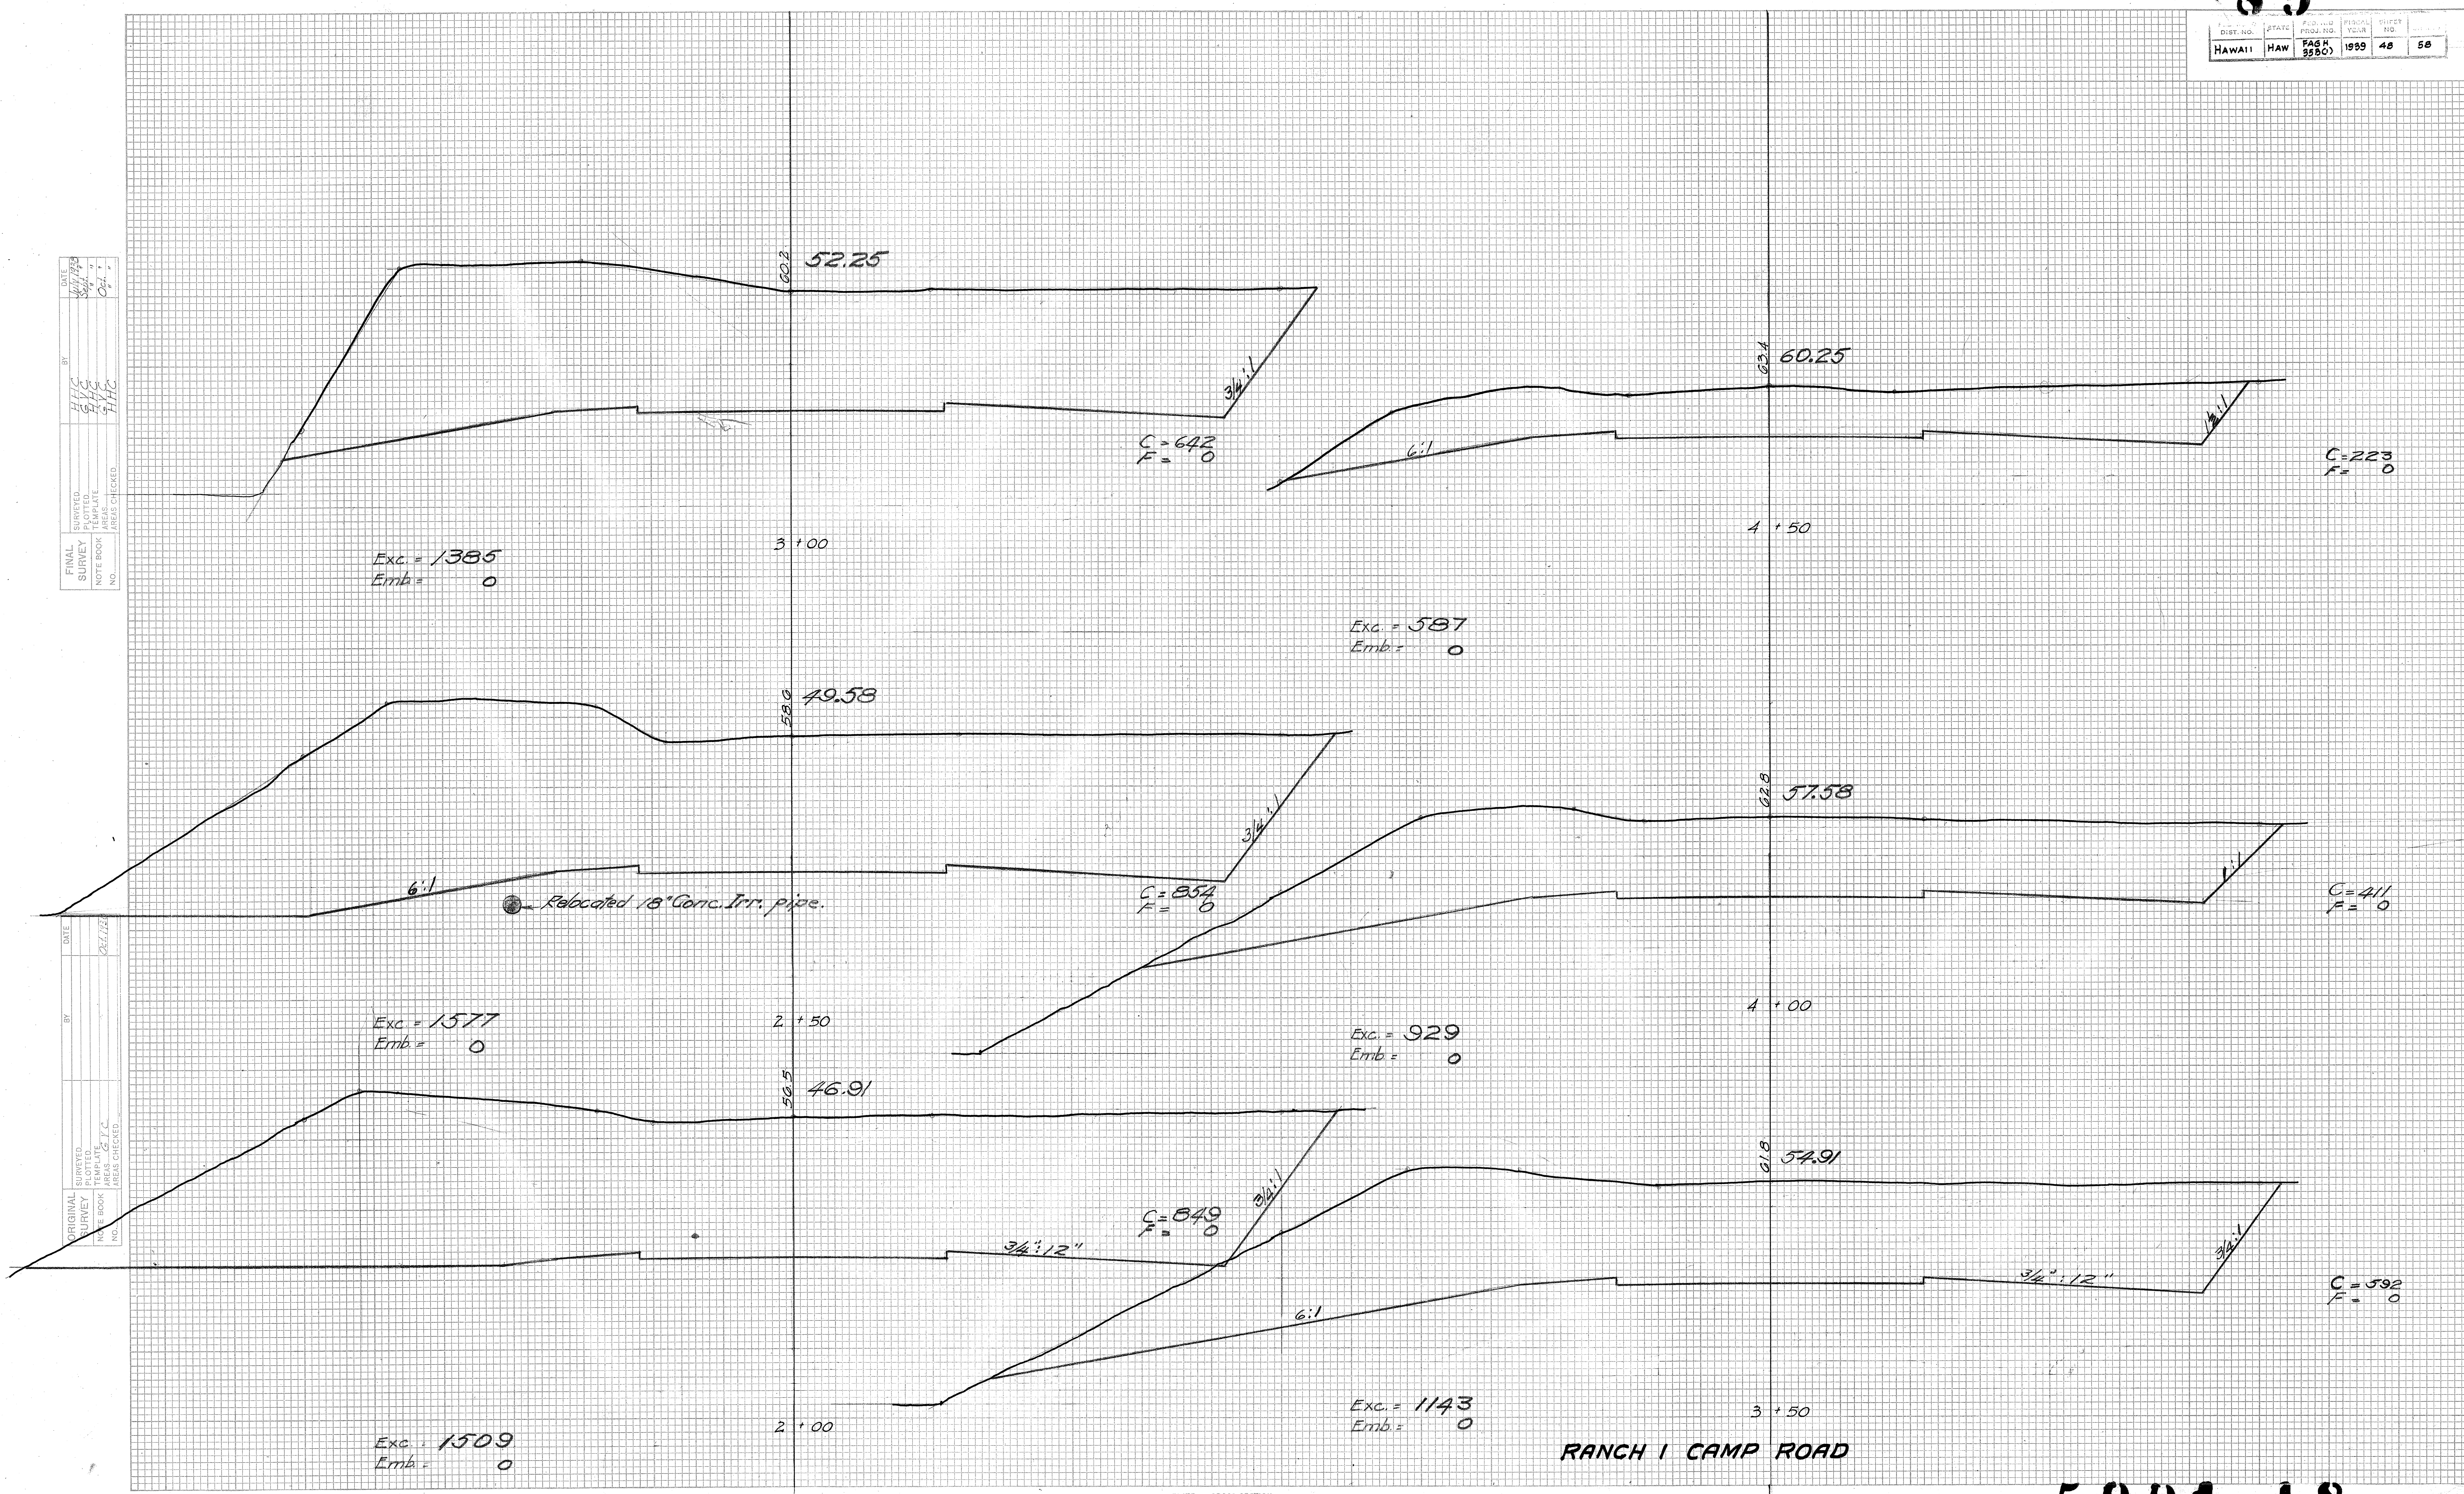


5001.48

FED. ROAD DIST. NO.	STATE	FED. AID PROJ. NO.	FISCAL YEAR	SHEET NO.	TOTAL SHEETS
HAWAII	HAW	FAGH 88000	1999	48	58

DATE	BY	REVIEWED	DATE
10/1/99	HHC	HHC	10/1/99
10/1/99	HHC	HHC	10/1/99
10/1/99	HHC	HHC	10/1/99

ORIGINAL	REVIEWED	DATE
NO.	NO.	10/1/99
NO.	NO.	10/1/99
NO.	NO.	10/1/99

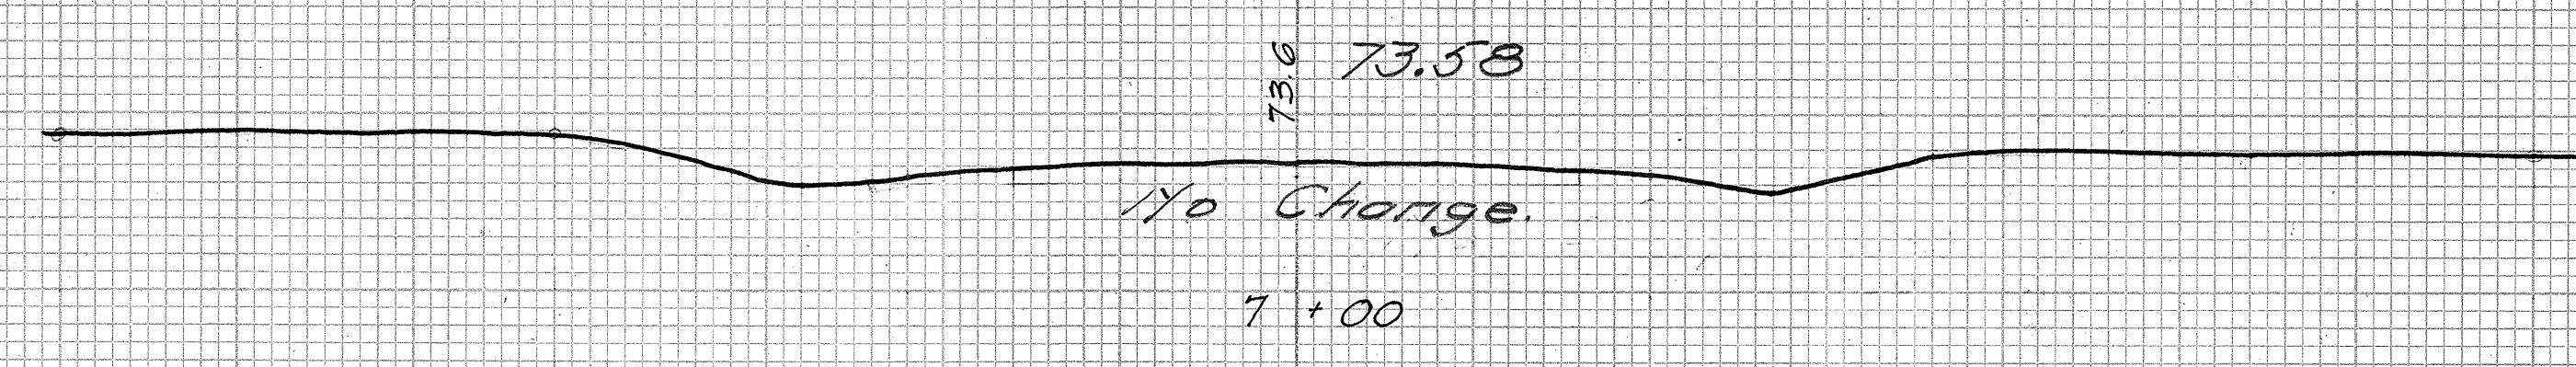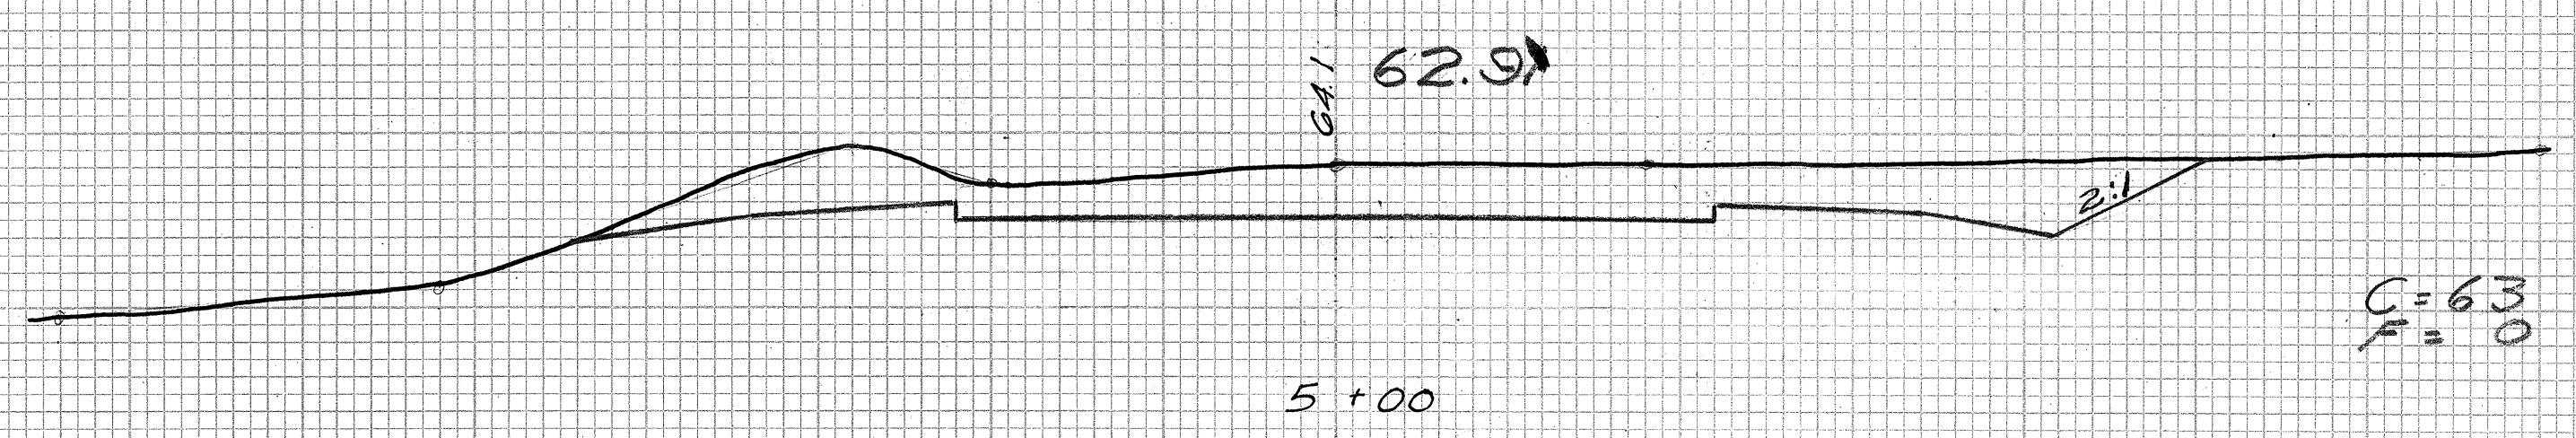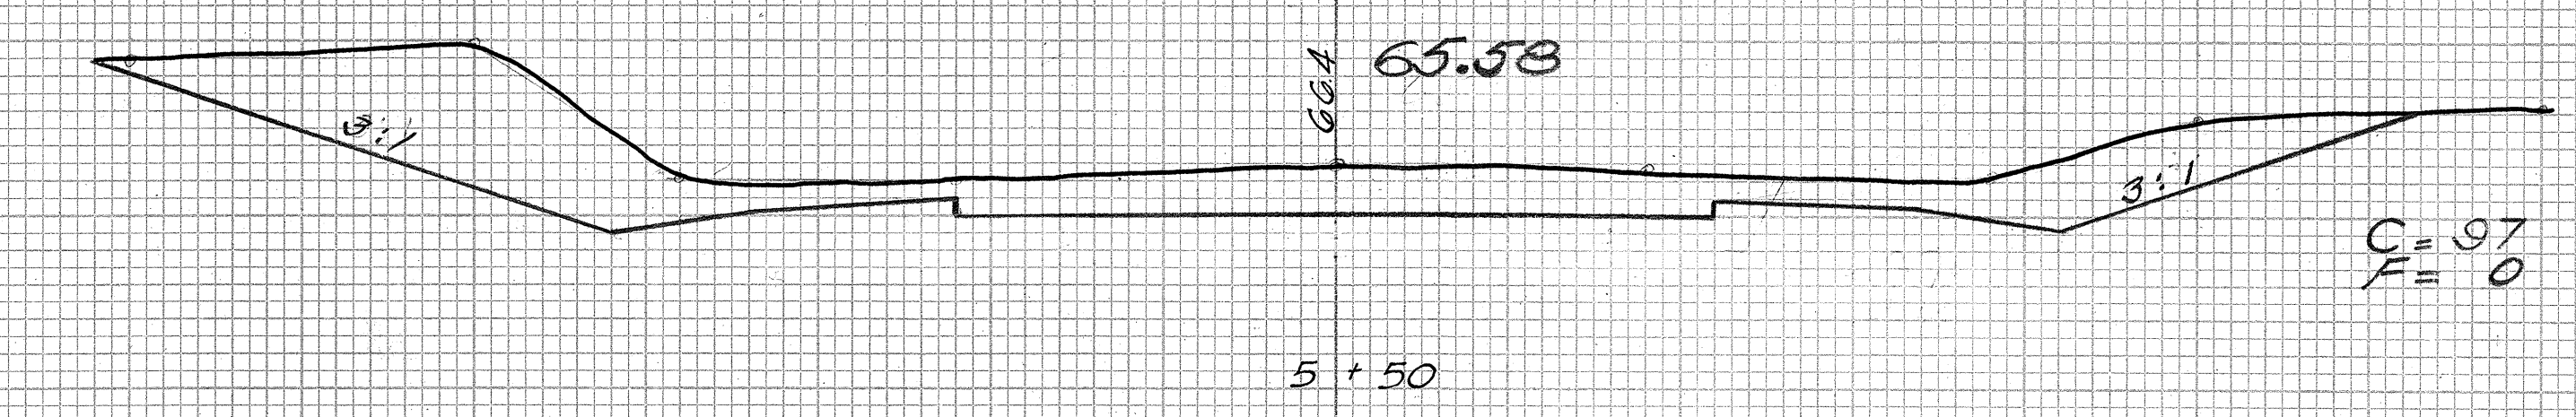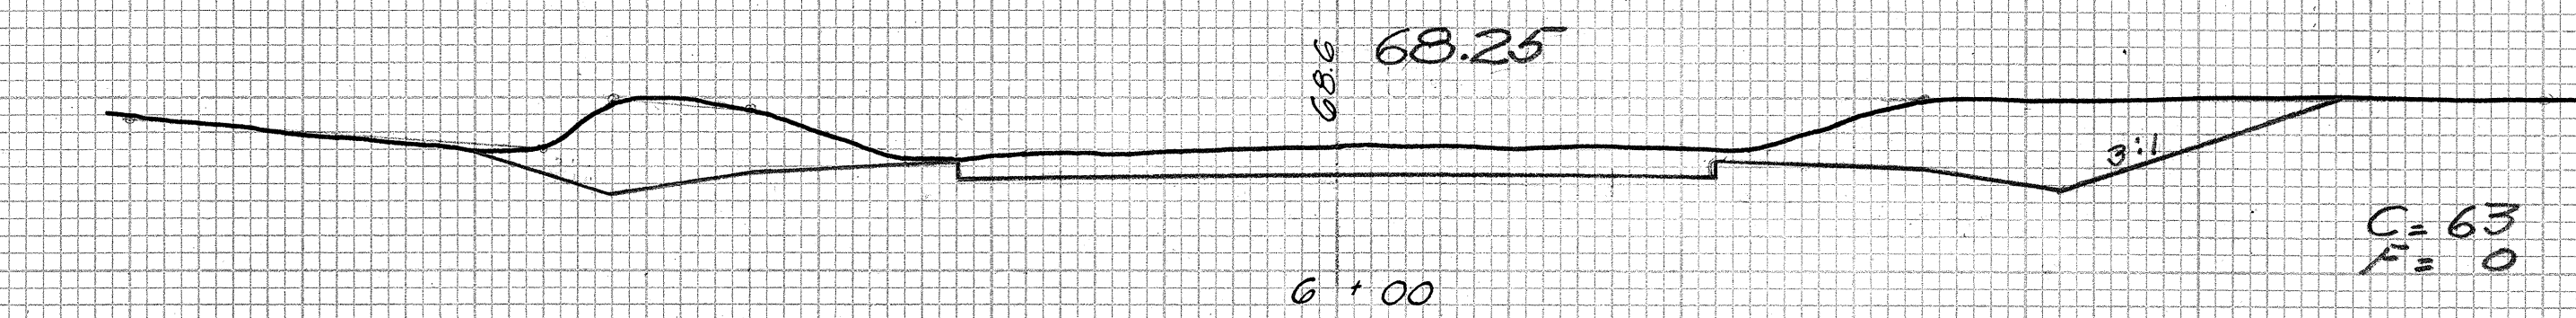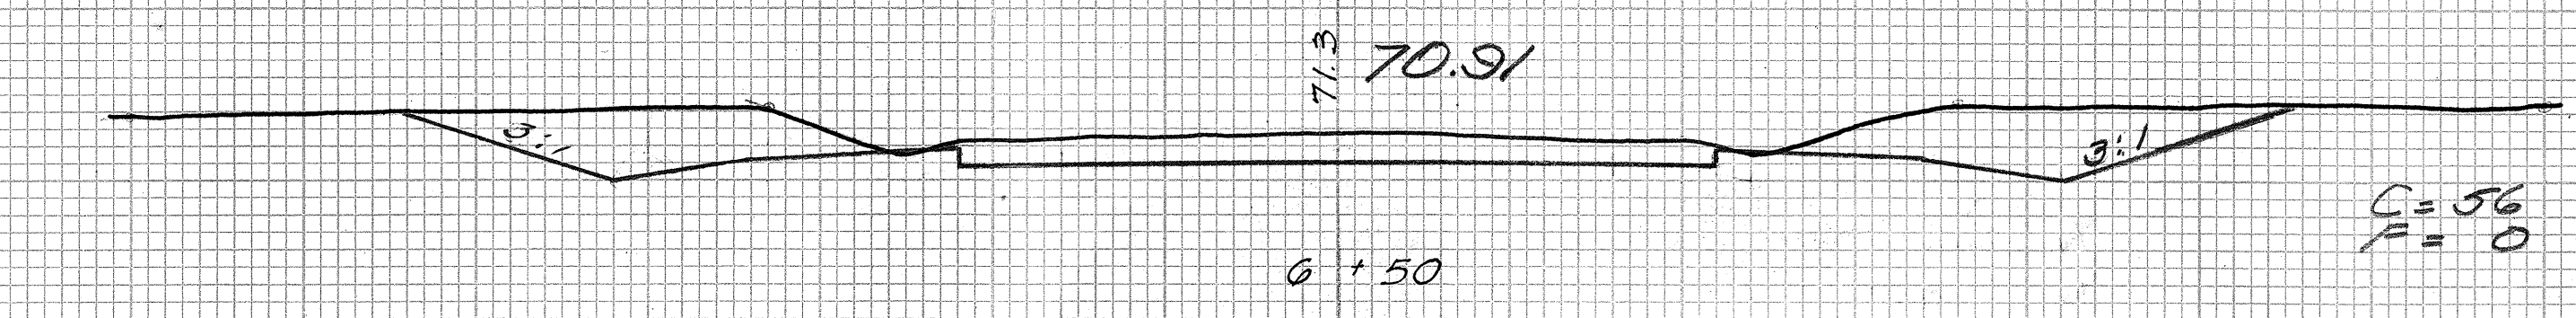

RANCH / CAMP ROAD