
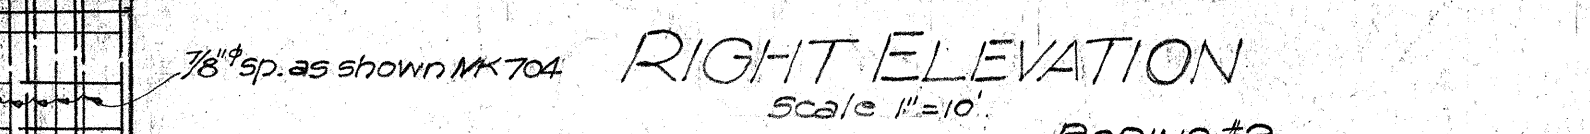
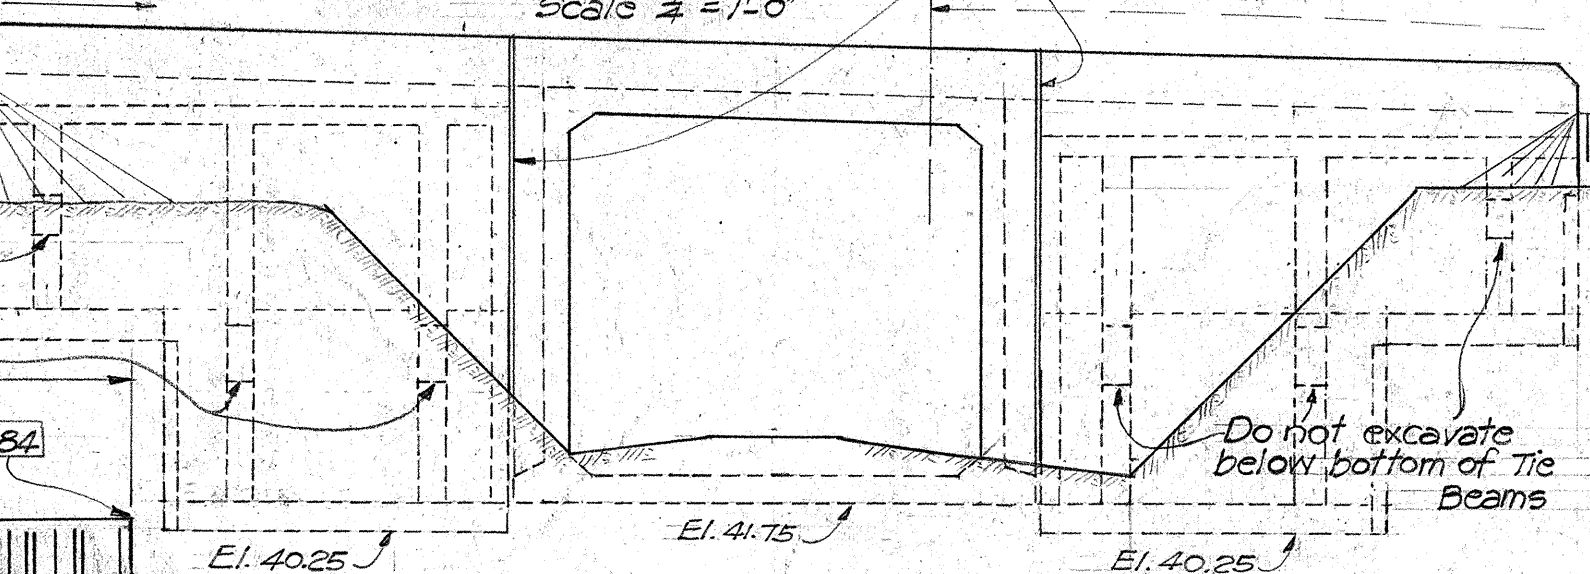
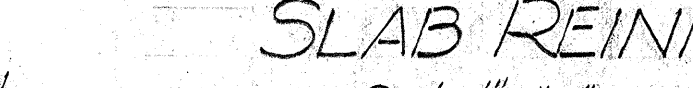


FED. ROAD DIST. NO.	STATE	FED. AID PROJ. NO.	FISCAL YEAR	SHEET NO.	TOTAL SHEETS
HAWAII	HAW	FAGH 35B(1)	1939	14	58

Asphalt concrete pavement 6.57 tons

Asphalt concrete pavement 6.57 tons

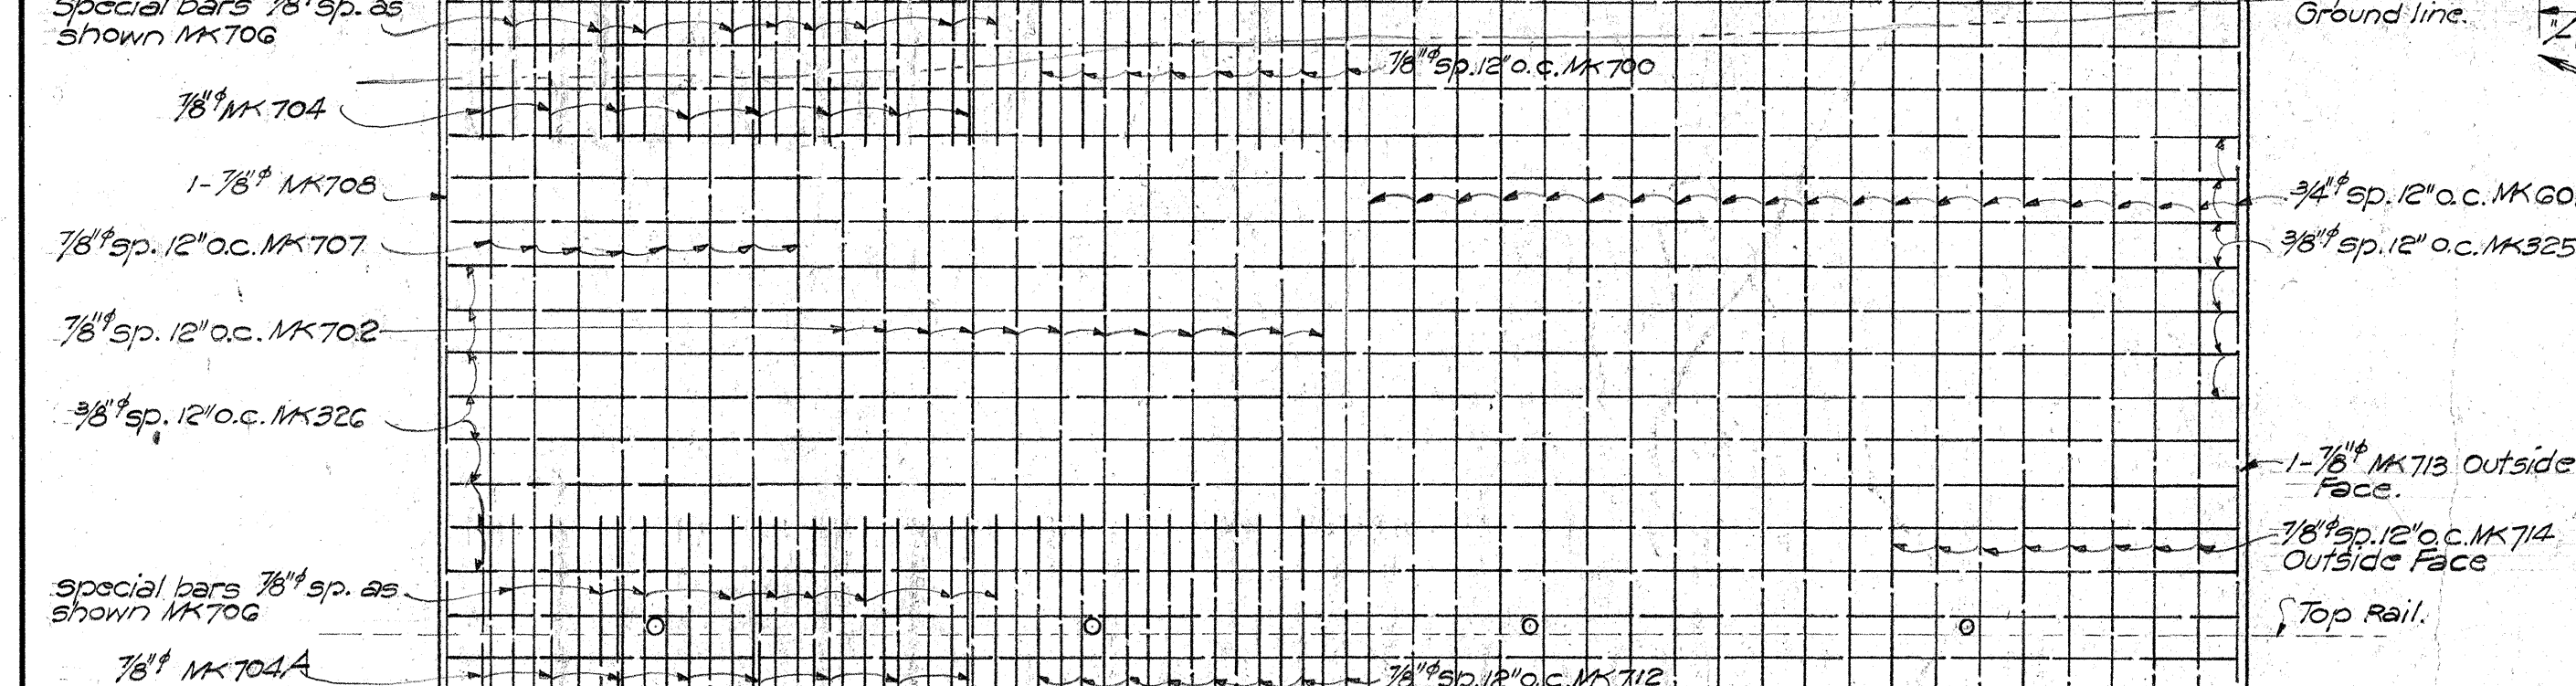


TERRITORIAL HIGHWAY DEPARTMENT
TERRITORY OF HAWAII
HIGHWAY OVERPASS
Sta. 10+0043
Waialua-Kaena Pt. Road. *F.A.G.H. 35 B.*
Sept. 1939


5001.14

- Revision: Transverse reinf. in top & bottom slab changed to $\frac{5}{8}$ " sp. 10' o.c.
- Weep holes added.
- Reinf. steel total changed.
- ¹⁰/₁₆ Level shoulders at wing walls

ORIGINAL PLAN	SURVEY PLOTTED BY _____ DATE _____ DESIGNED BY <u>W. R. BARTLES</u> DRAWN BY _____ TRACED BY _____ QUANTITIES BY <u>T. J. KING</u> QUANTITIES CHECKED BY <u>T. J. KING</u> CHECKED BY _____
NOTE BOOK	
No. _____	

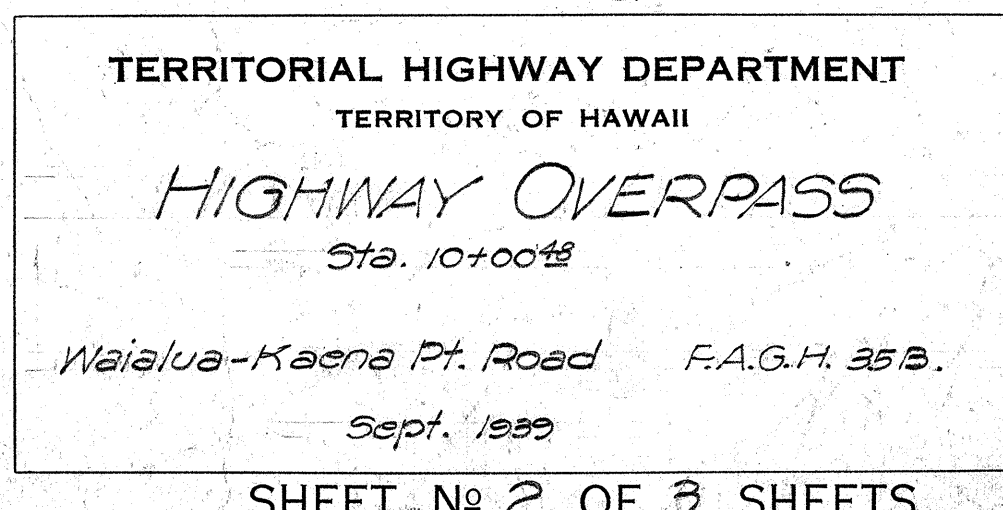

ORIGINAL PLAN	SURVEY PLOTTED BY DESIGNED BY DRAWN BY	DATE
	ALFRED E. BARSTELS	5-27-23
	TRACED BY	"
	QUANTITIES BY	"
	THEMATIC CHECKED BY	"
	CHECKED BY	"
NOTE BOOK		
No.		

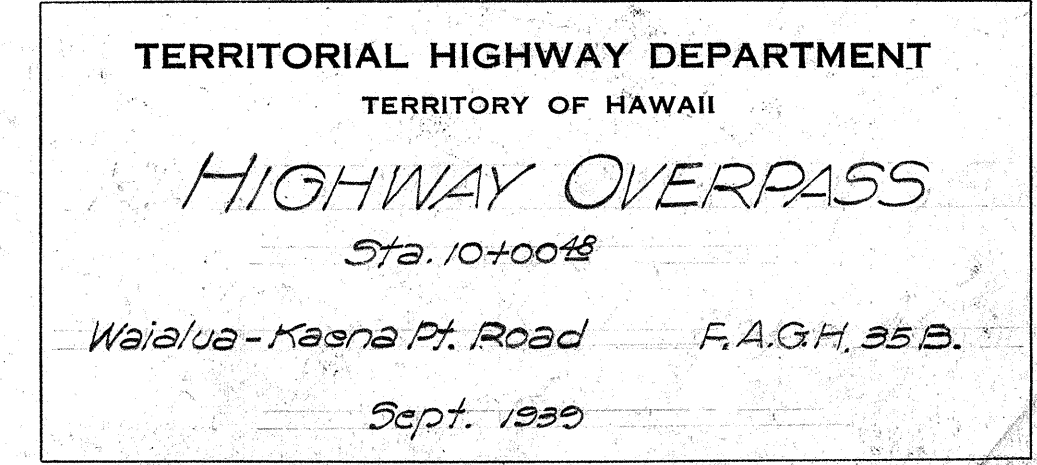

ORIGINAL PLAN	SURVEY PLOTTED BY DESIGNED BY <i>M. C. PARTELLS</i> DRAWN BY <i>J. TING</i>	DATE " <i>Aug. 1935</i> " <i>Sept. 35</i> " <i>"</i> " <i>"</i> " <i>"</i>
NOTE BOOK	TRACED BY <i>J. TING</i> QUANTITIES CHECKED BY <i>P. KING</i>	" <i>"</i> " <i>"</i> " <i>"</i> " <i>"</i> " <i>"</i>
No.	CHECKED BY	" <i>"</i>