



FED. ROAD DIST. NO.	STATE	FED. AID PROJ. NO.	FISCAL YEAR	SHEET NO.	TOTAL SHEETS
HAWAII	HAW.	F.A.G.H. 35-B(1)	1939	6	58

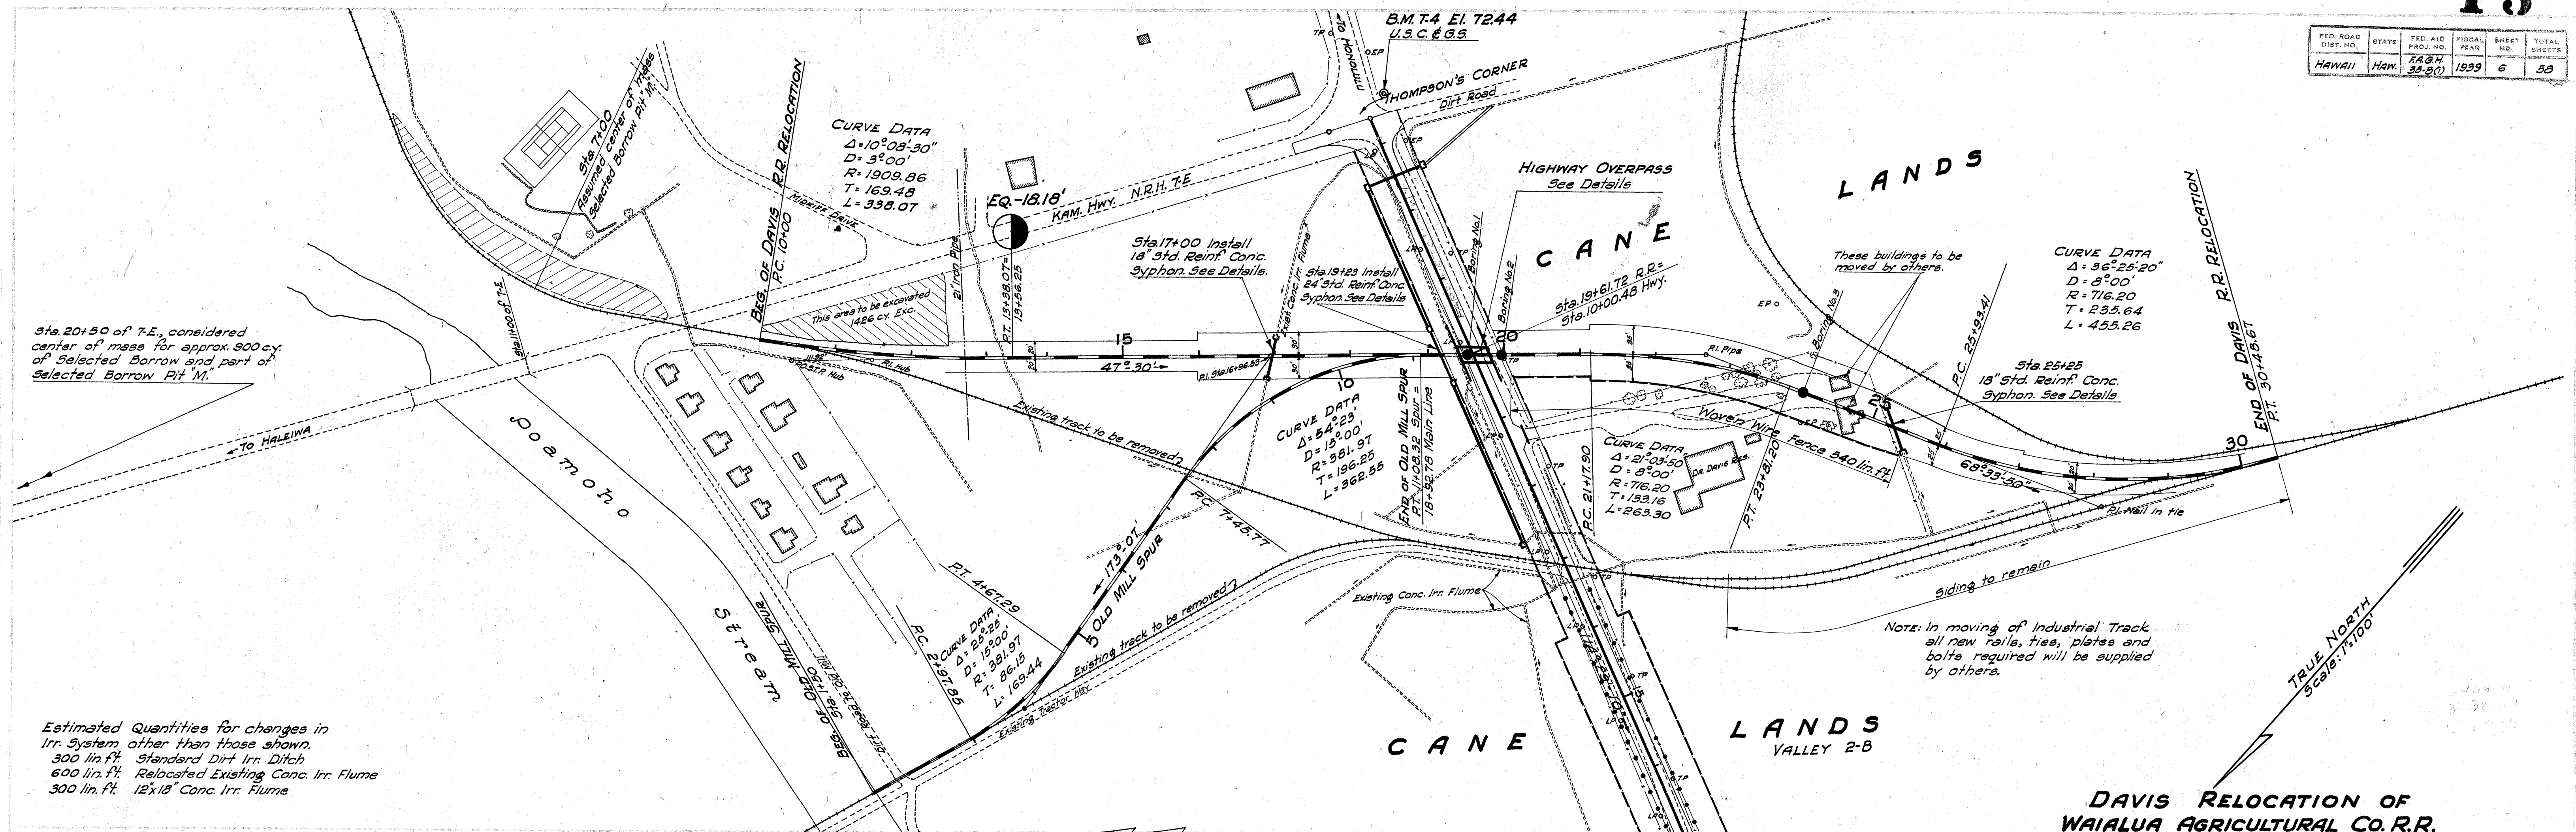

Estimated Quantities for changes in
Irr. System other than those shown.

300 lin. ft.	Standard Dirt Irr. Ditch
600 lin. ft.	Relocated Existing Conc. Irr. Flume
300 lin. ft.	12"x18" Conc. Irr. Flume


DAVIS RELOCATION OF
WAIALUA AGRICULTURAL CO. R.R.

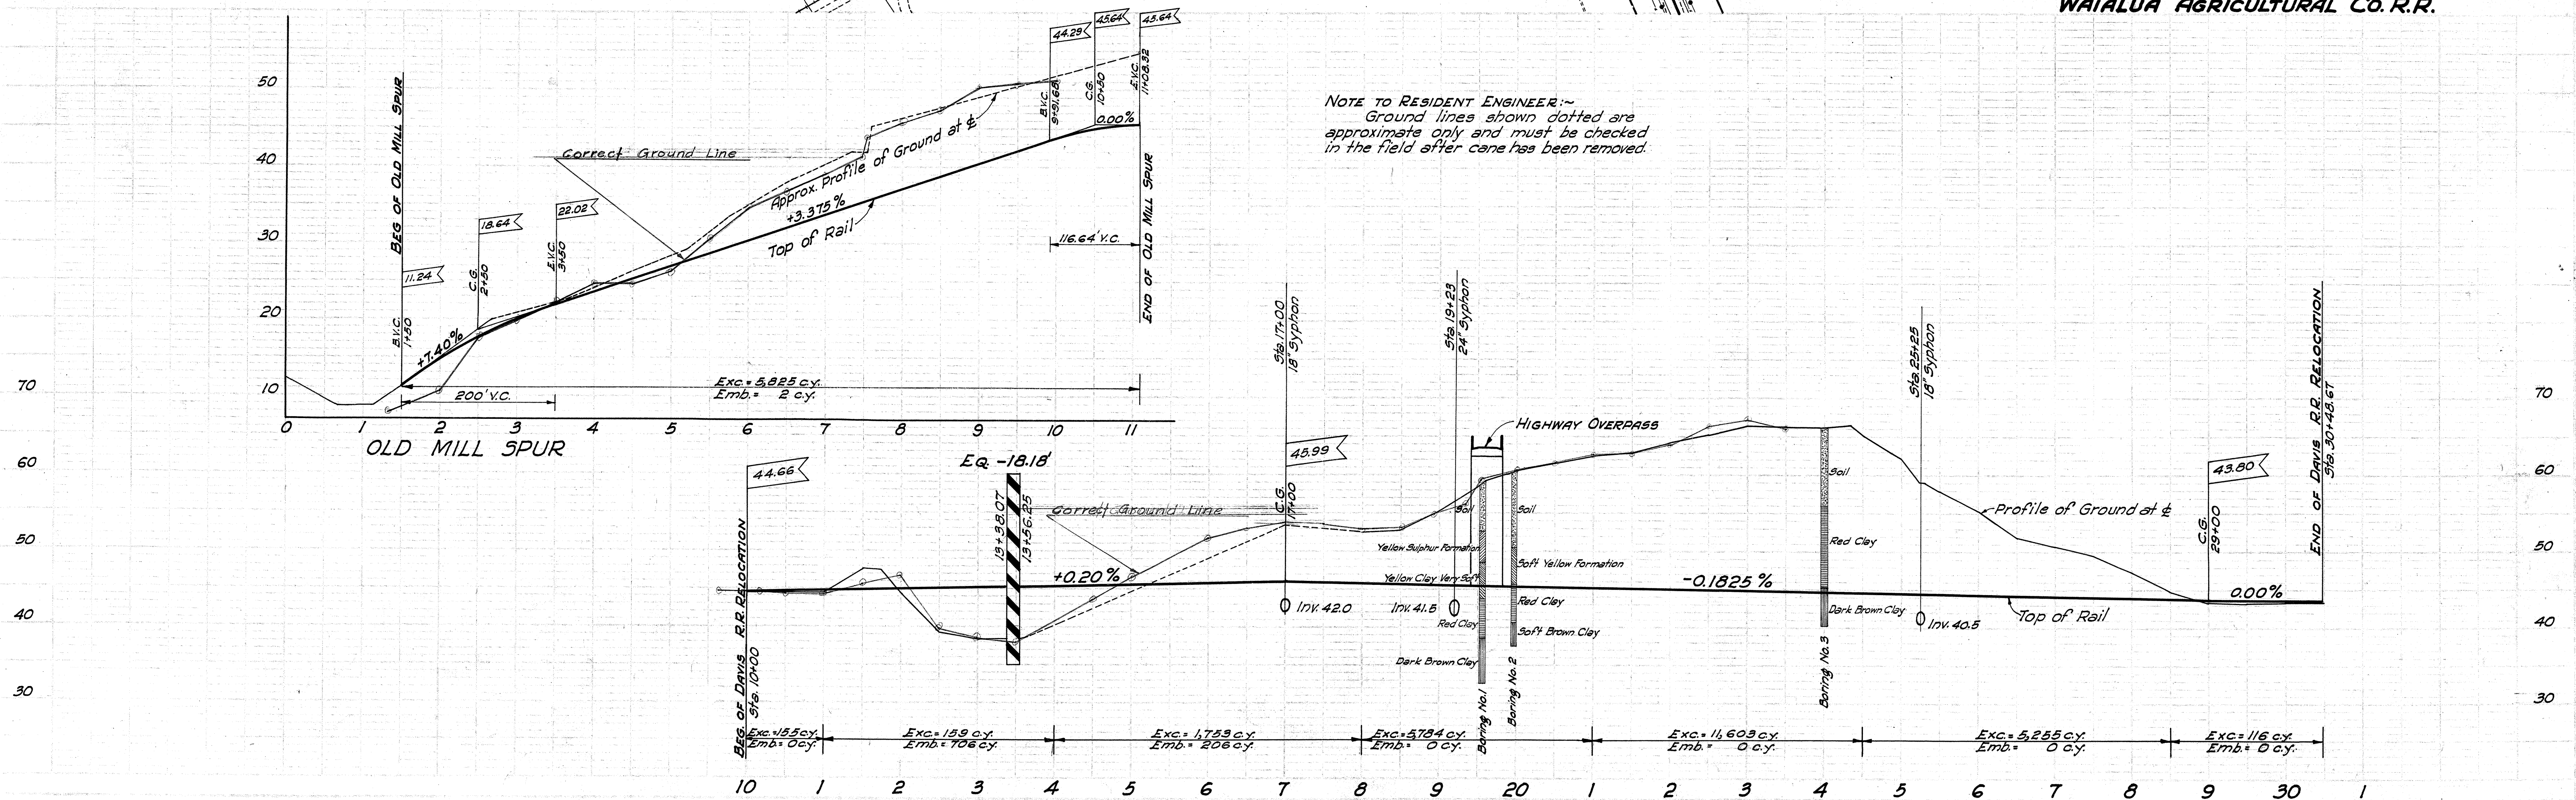

NOTE TO RESIDENT ENGINEER:~
Ground lines shown dotted are
approximate only and must be checked
in the field after cane has been removed.

5001.6

FED. ROAD DIST. NO.	STATE	FED. AID PROJ. NO.	FISCAL YEAR	SHEET NO.	TOTAL SHEETS
HAWAII	HAW.	F.A.G.M. 25-8(7)	1939	7	50

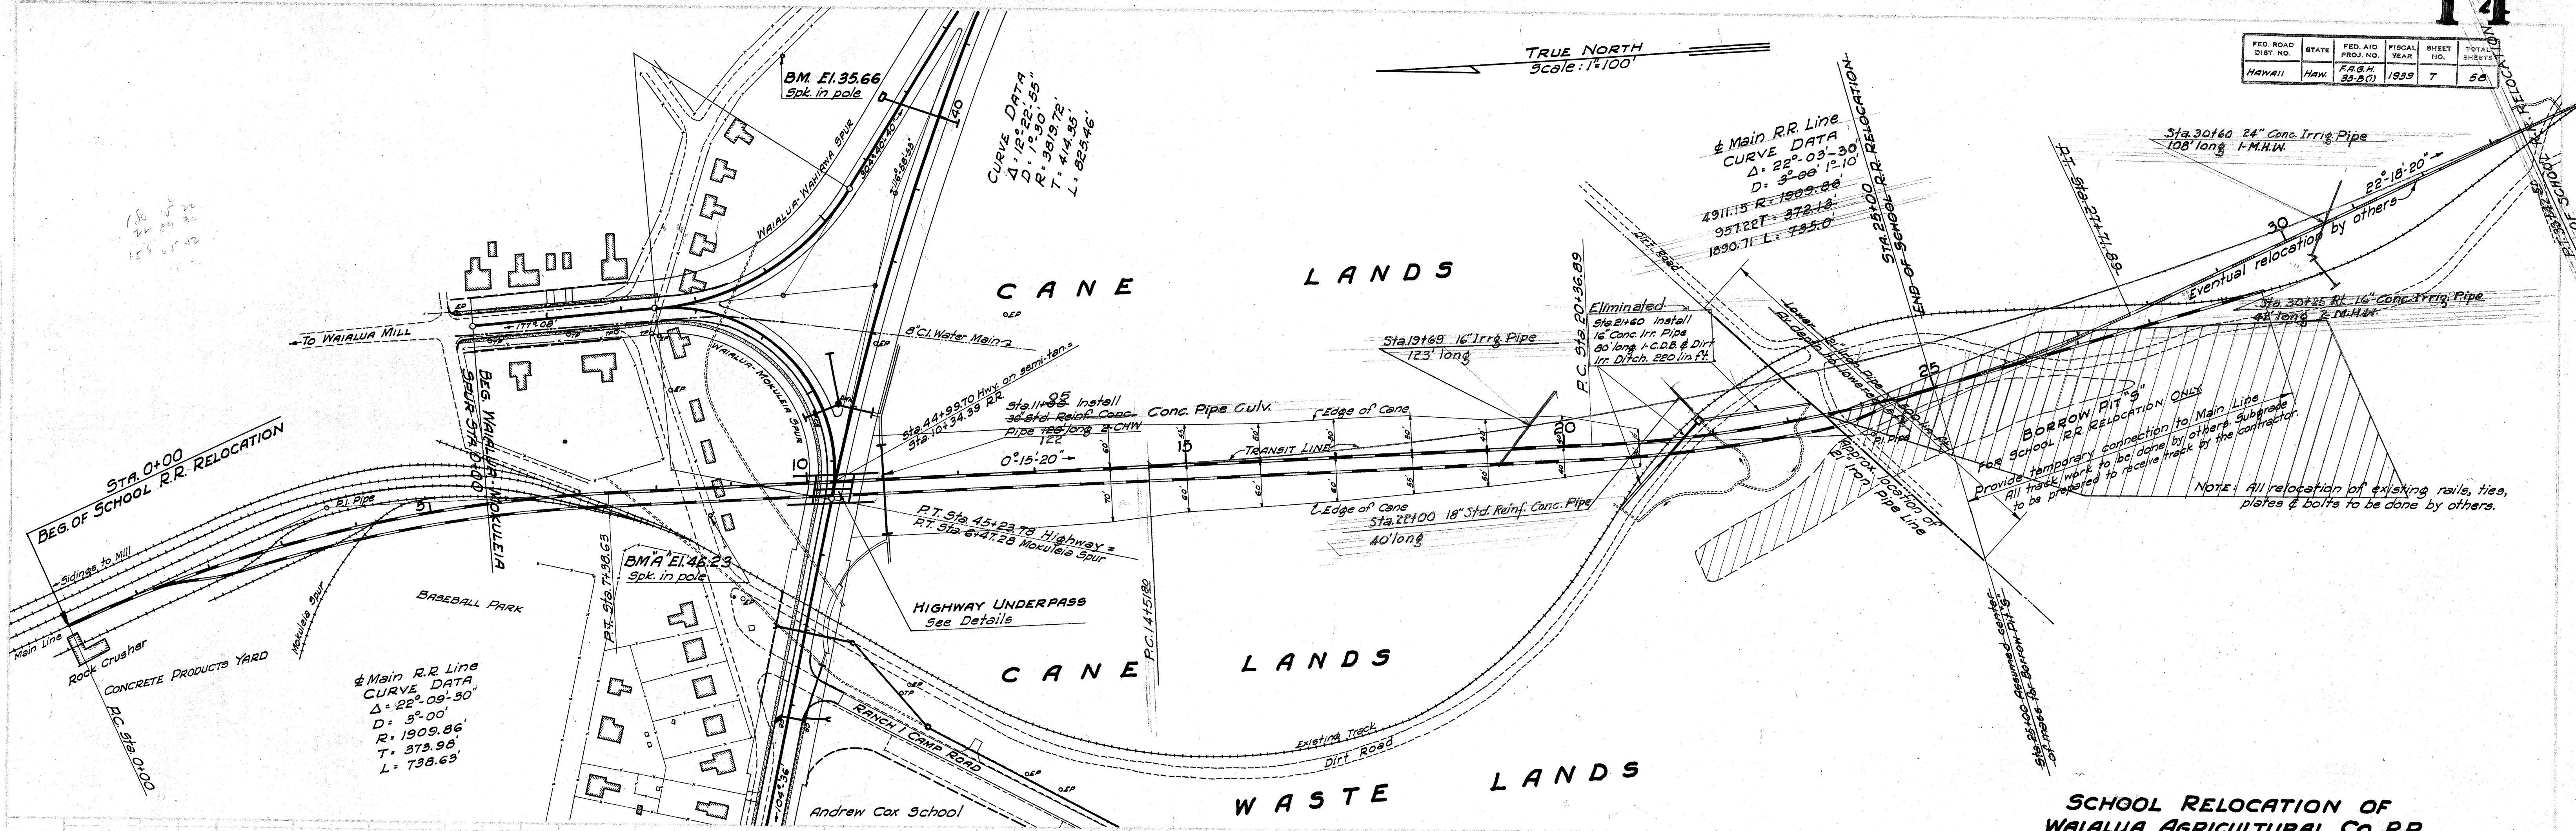

SCHOOL RELOCATION OF
WAILUA AGRICULTURAL CO. R.R.

