



FED. ROAD DIST. NO.	STATE	FED. AID PROJ. NO.	FISCAL YEAR	SHEET NO.	TOTAL SHEETS
HAWAII	HAW.	F.R.G.H. 35-B(1)	1939	3	58

LIST OF COMMON ABBREVIATIONS

C.R.M. Cement Rubble Masonry
D.R.M. Dry Rubble Masonry
Circ. Conc. Culv't Circular Concrete Culvert
which is either
(a) Cast in place Concrete Culvert or
(b) Concrete Pipe Culvert
Box Culv't. Various Reinf. Concrete Box Culverts as detailed.
C.D.I. Concrete Drop Intake
M.D.I. Masonry Drop Intake
C.H.W. Concrete Head Wall
M.H.W. Masonry Head Wall
■ C.B. Catch Basin
D.M.H. Drainage Manhole
• T.R. Telephone Pole
• E.P. Wood Electric Pole
• L.R. Lamp Pole
C.D.B. Concrete Diversion Box
• D.M.H. Manhole
S.B. Selected Borrow

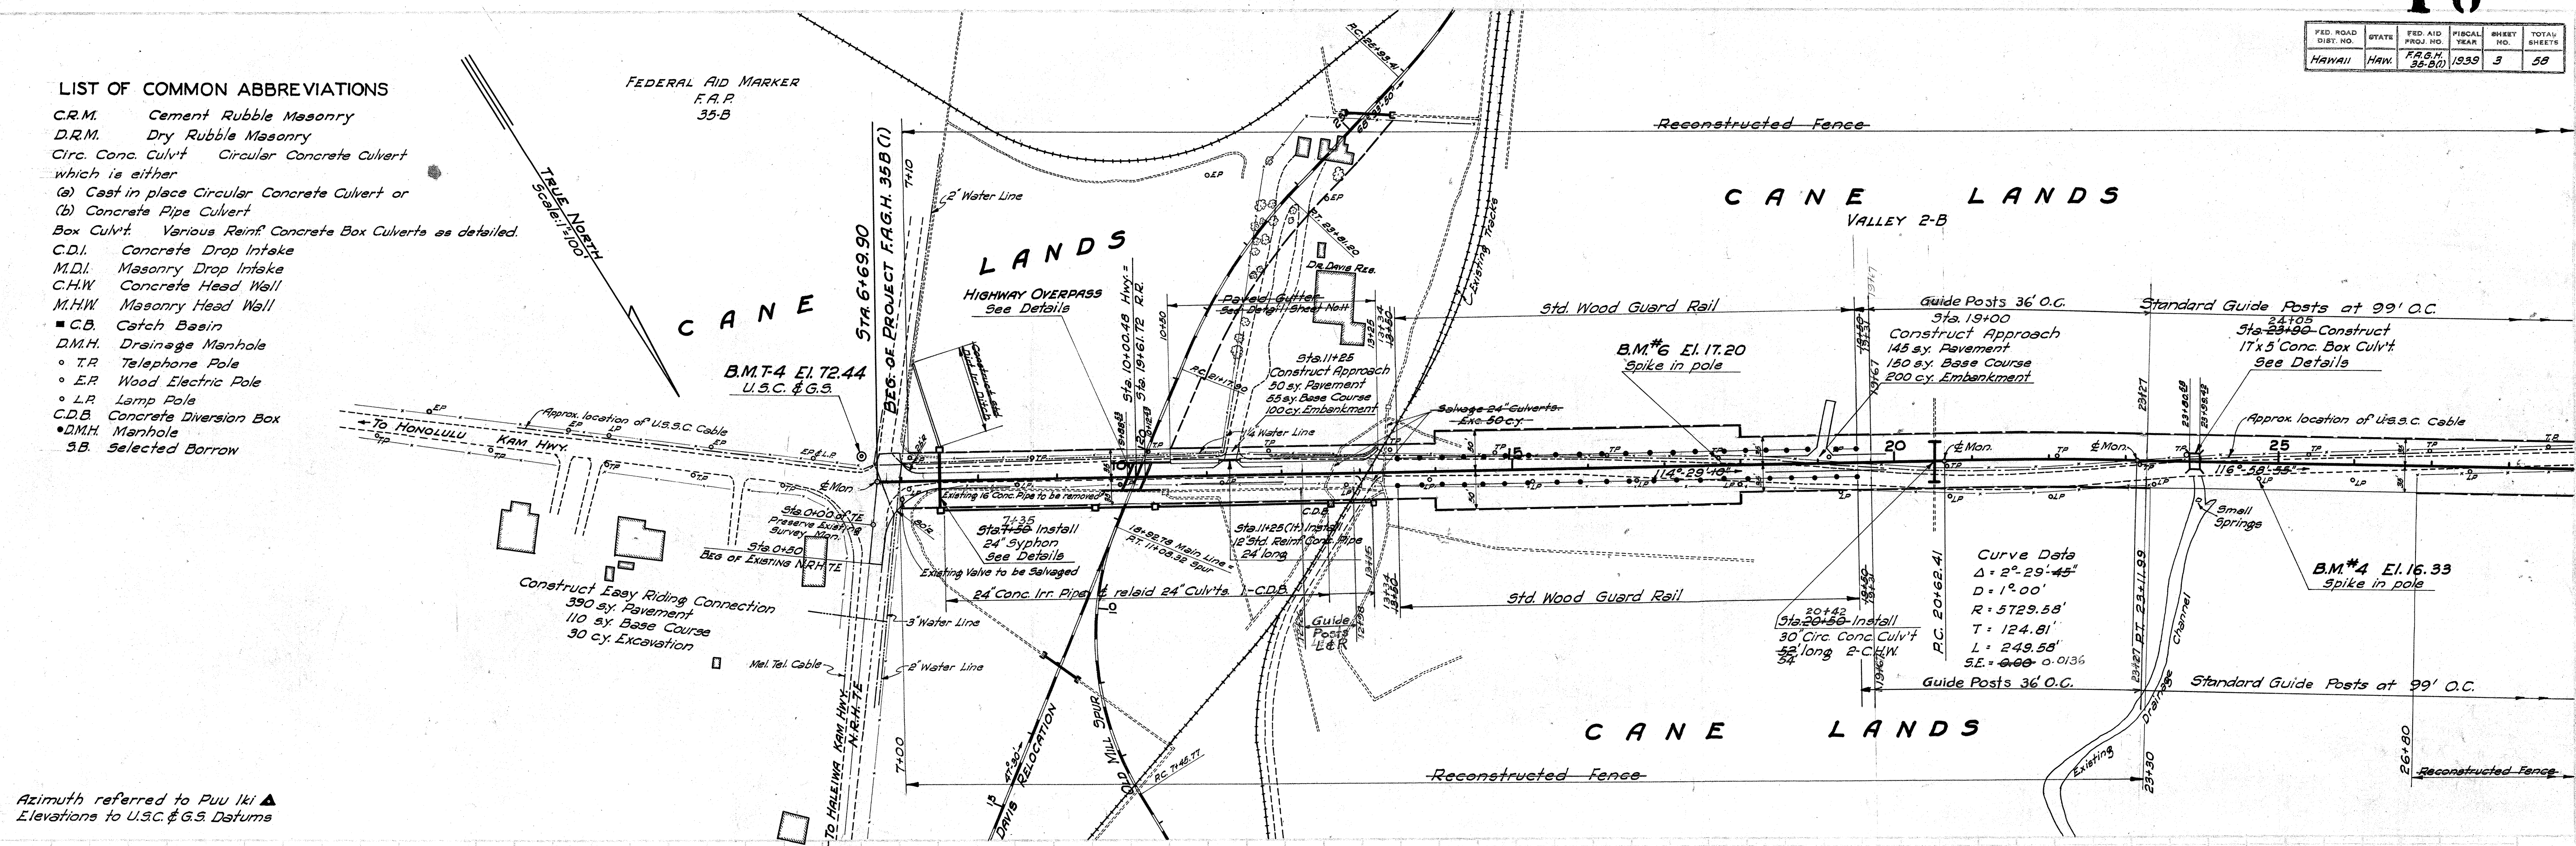


*Azimuth referred to Puu Iki ▲
Elevations to U.S.C. & G.S. Datums*

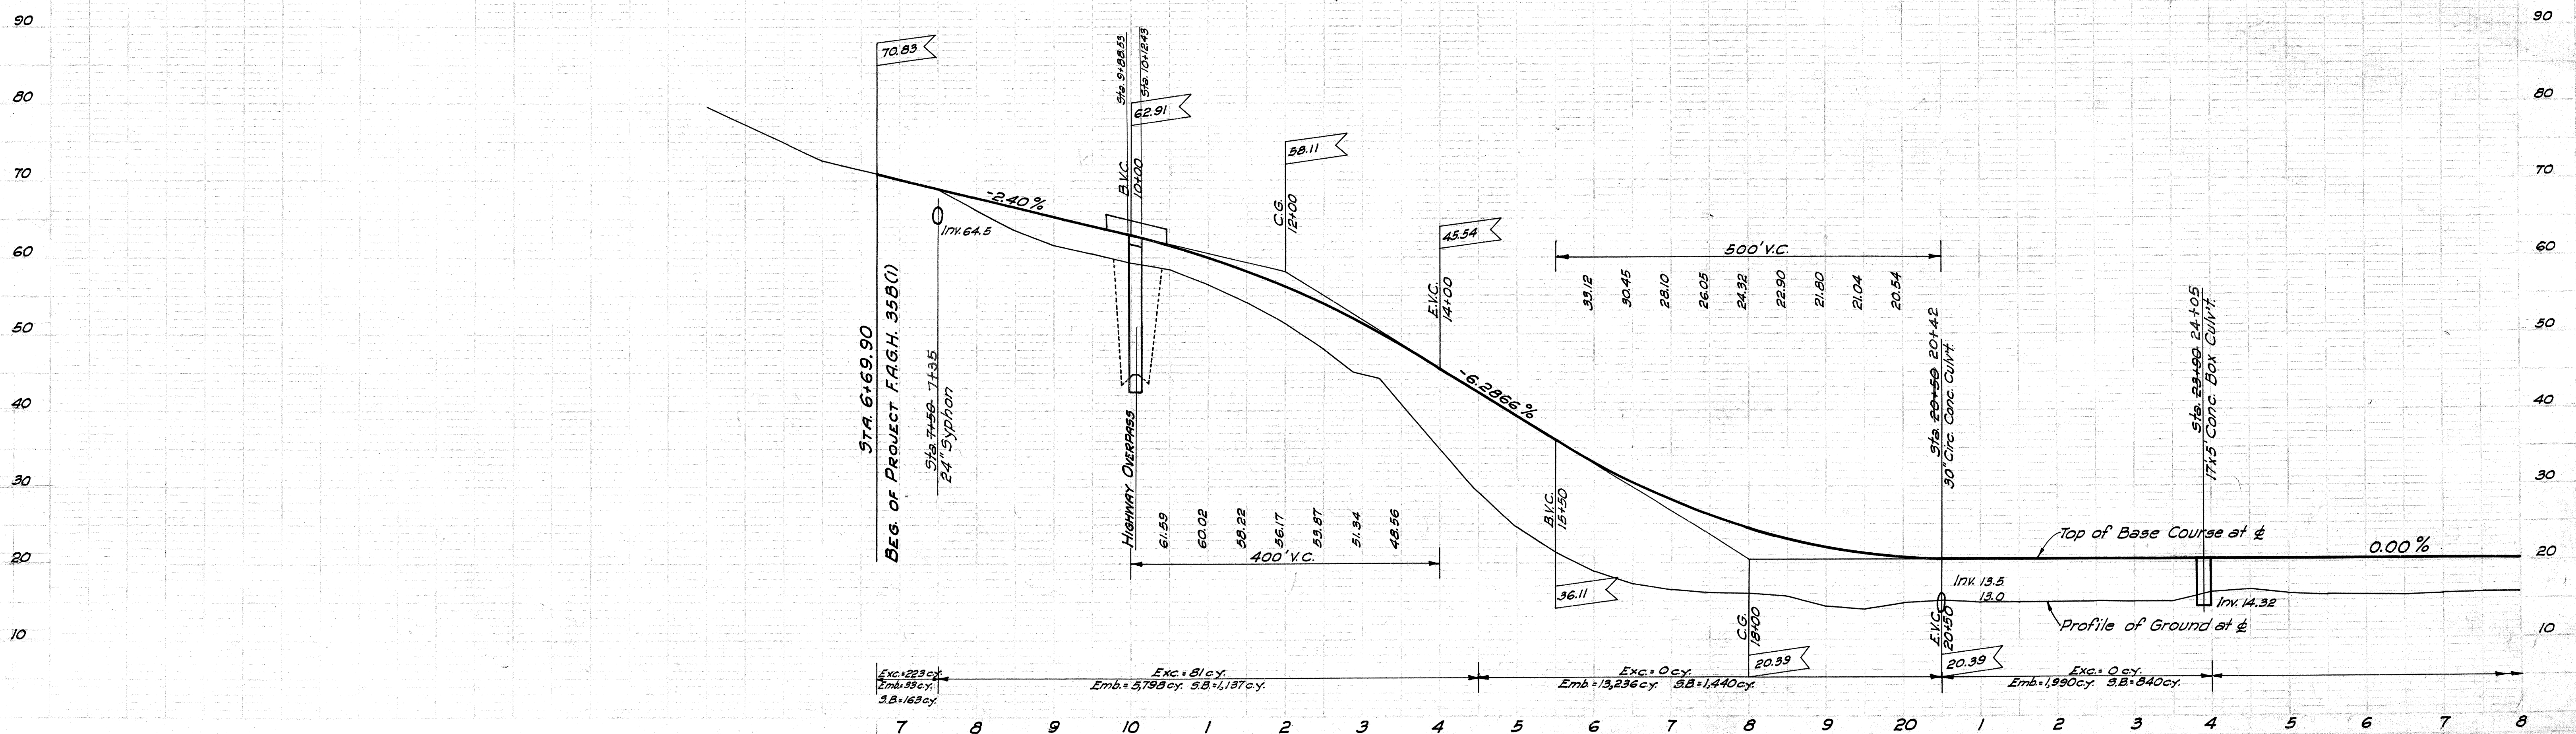

5001.3

10

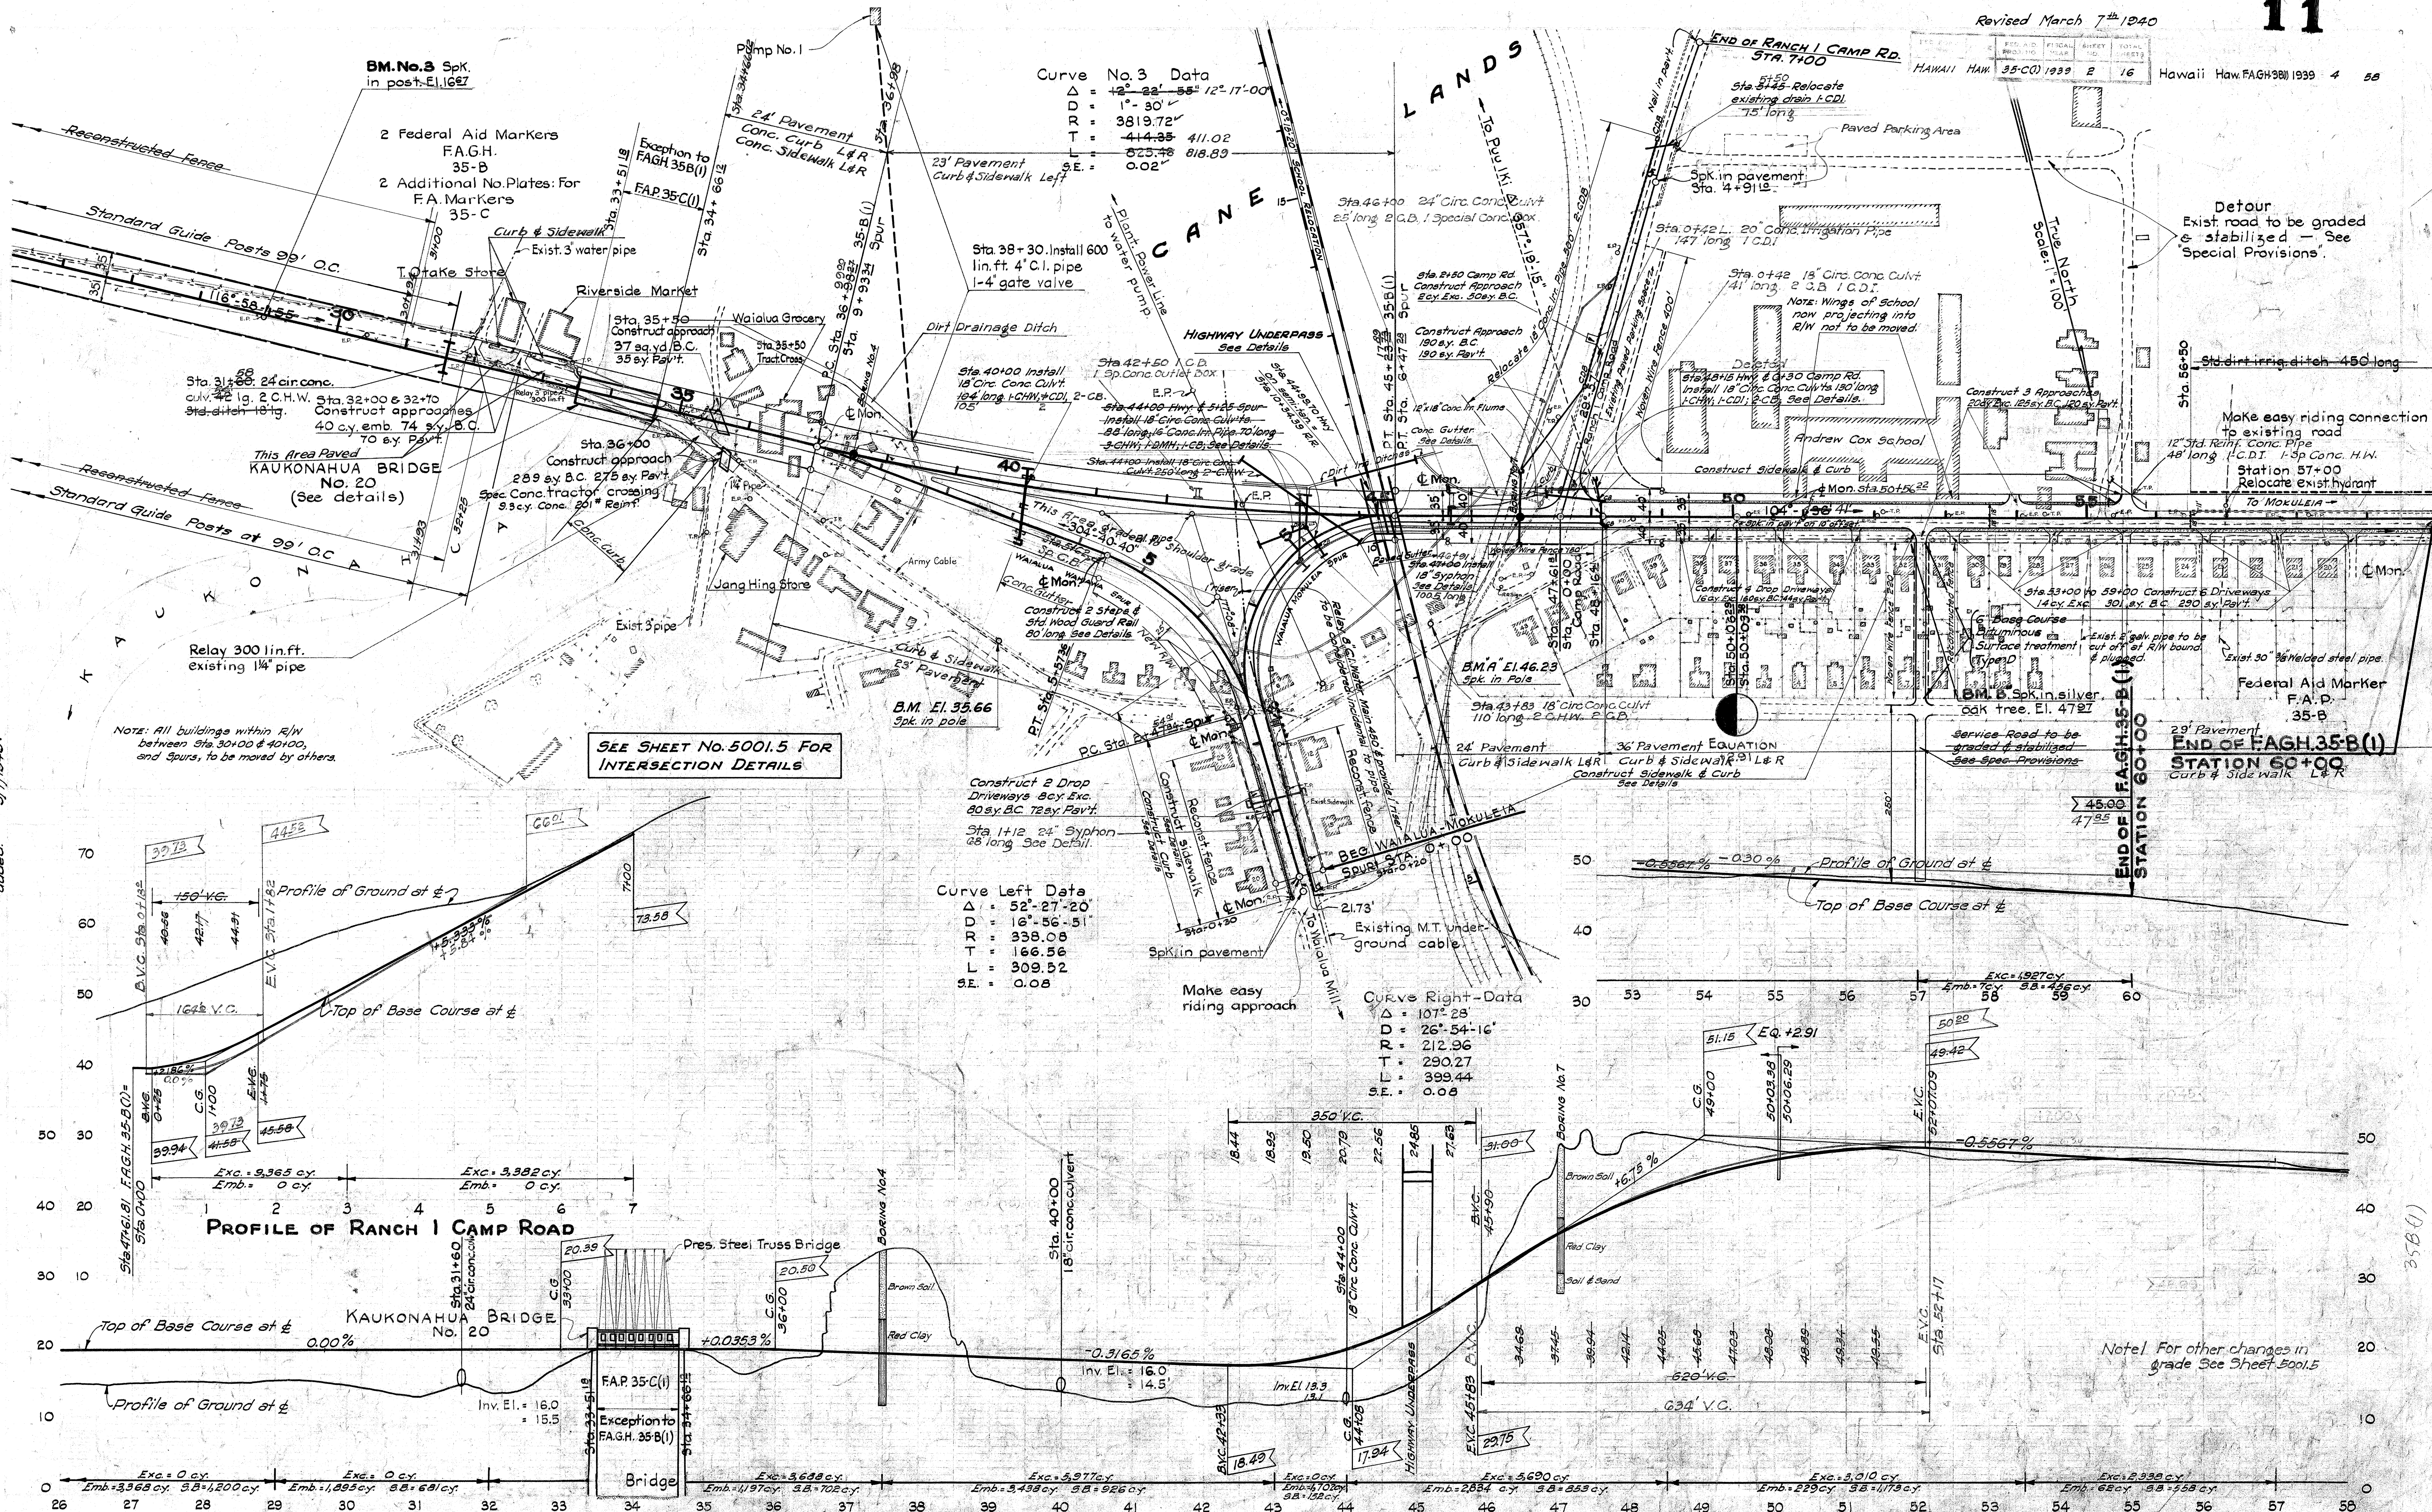

5002.2

5001.4

5 e-1-3