

INDEX TO DRAWINGS	
SHEET No.	DESCRIPTION
1	TITLE SHEET
2	PLAN & PROFILE
3	STANDARD BRIDGE DETAILS (C.)
4-10	BRIDGE DETAILS

FED. ROAD DIST. NO.	STATE	FED. AID PROJ. NO.	FISCAL YEAR	SHEET NO.	TOTAL SHEETS
HAWAII	HAW.	35-C(1)	1939	1	16

TERRITORY OF HAWAII
TERRITORIAL HIGHWAY DEPARTMENT
HONOLULU T.H.


PLANS OF
WAIALUA-KAENA PT. ROAD
FEDERAL AID PROJECT NO. 35-C(1)

DISTRICT OF WAIALUA
ISLAND OF OAHU

CONVENTIONAL SIGNS

EXISTING ROAD	
EXISTING FENCE	
BOUNDARY LINE (NOT FENCED)	
EXISTING STONE FENCE	
RAILROAD	
CENTER LINE ROADWAY	
LARGE TREE	
CULVERTS	


TRUE NORTH
SCALE = 1:10,000

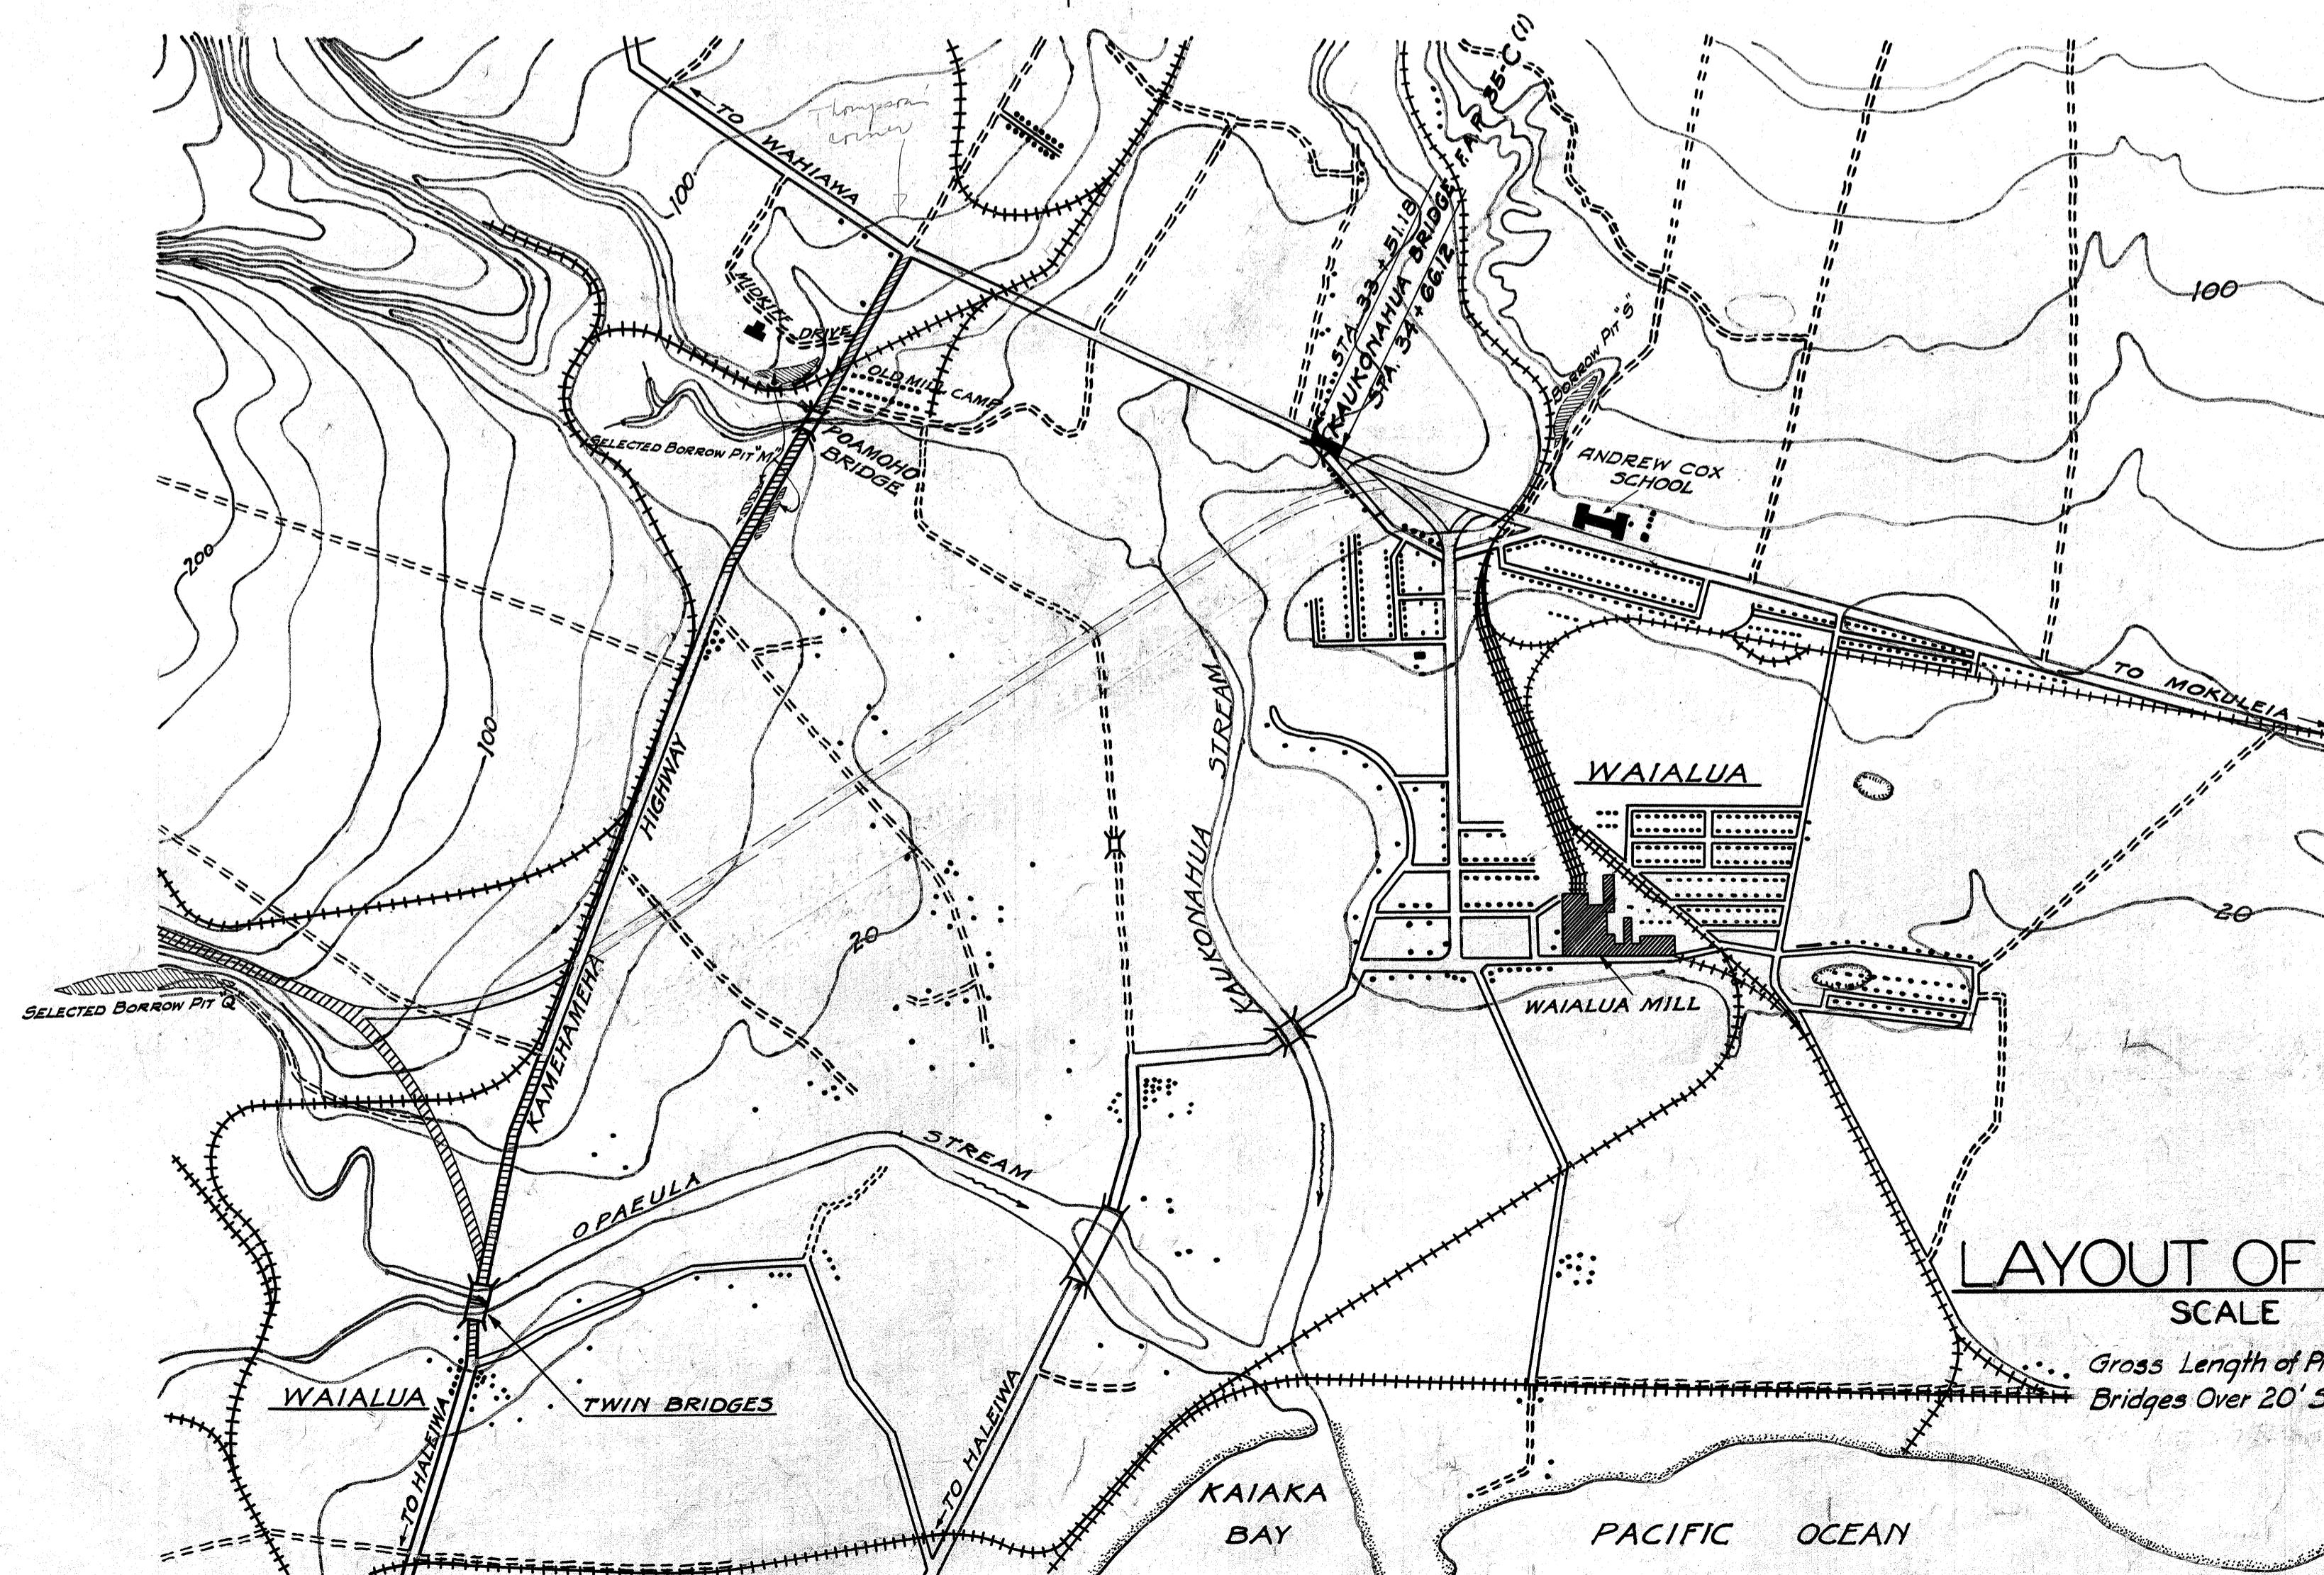

LAYOUT OF PROJECT

SCALE 1:10,000

Gross Length of Project = 0.021 mi.
Bridges Over 20' Span = 0.021 "

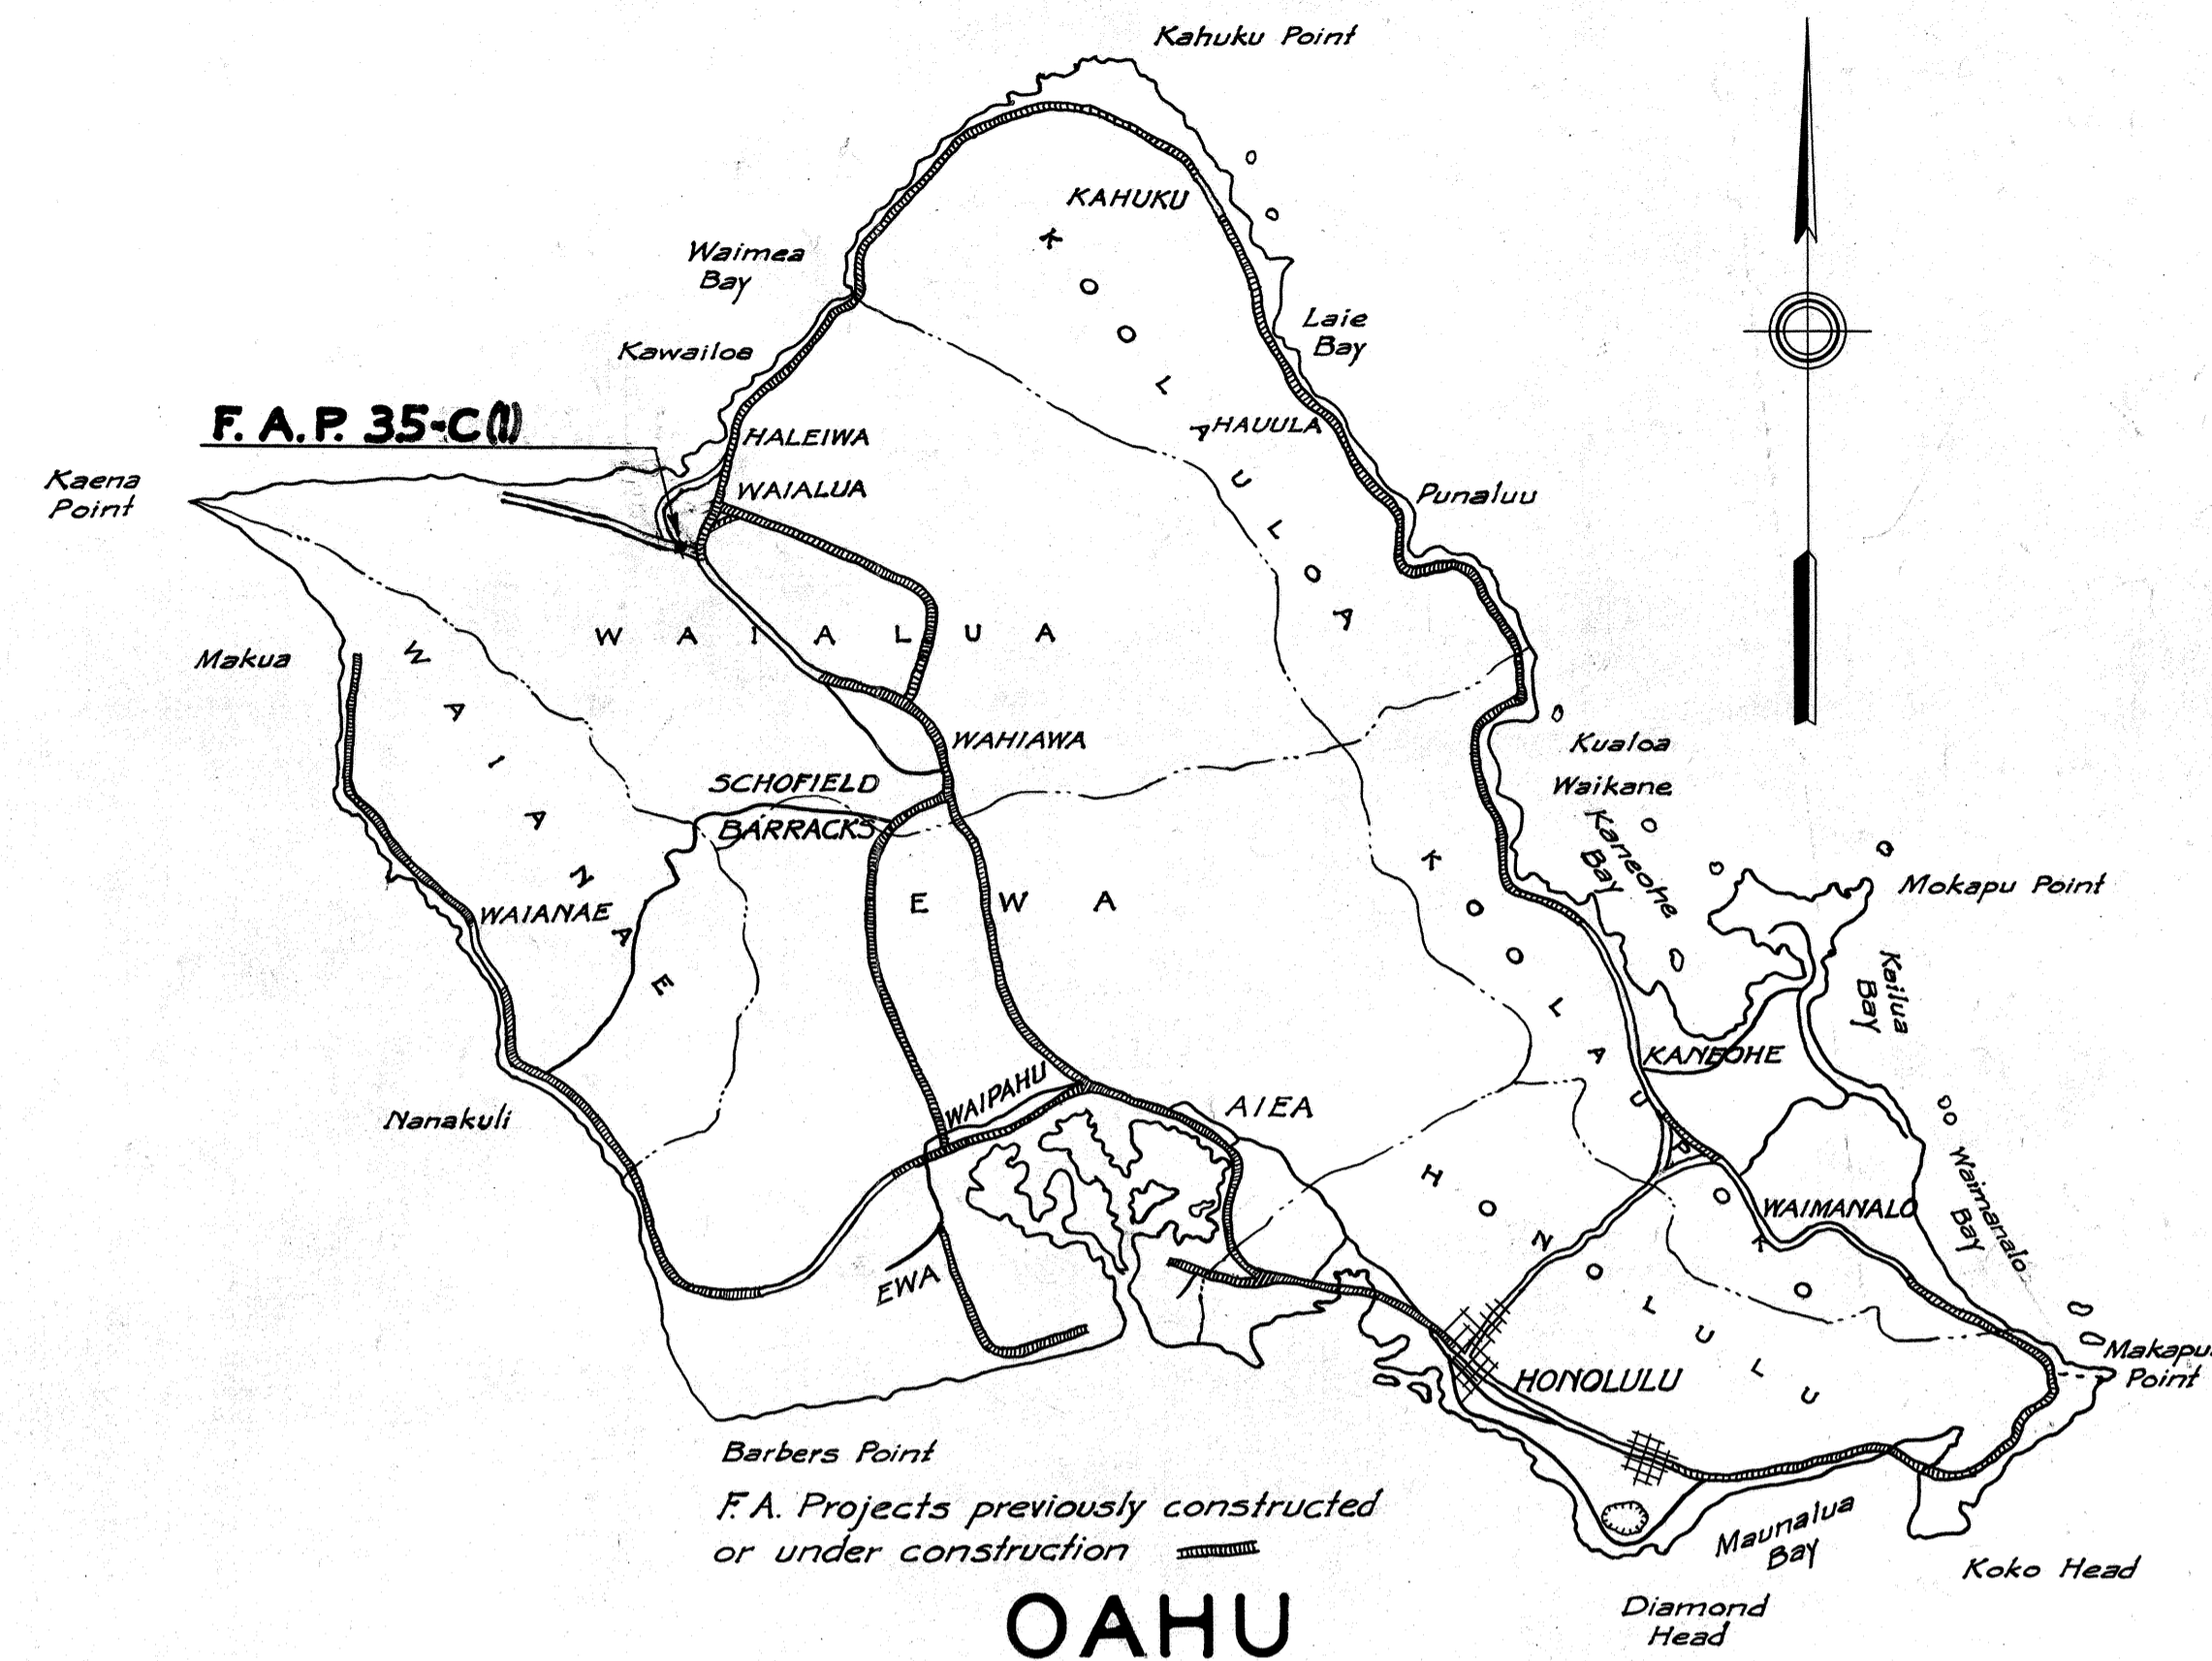

ORIGINAL PLAN	DATE
SURVEYED BY	Dec. 1938
DESIGNED BY	
DRAWN BY	
CHECKED BY	
NOTE BOOK	
QUANTITIES CHECKED BY	
NO.	

RECOMMENDED FOR APPROVAL

DISTRICT ENGINEER, Pub. Rds. Adm. Federal Works Agency

RECOMMENDED FOR APPROVAL

CHIEF WESTERN REGION, Pub. Rds. Adm. Federal Works Agency

APPROVED

COMMISSIONER, Pub. Rds. Adm. Federal Works Agency

APPROVED

Luigi Blum
Date 5/18/39
TERRITORIAL HIGHWAY ENGINEER