
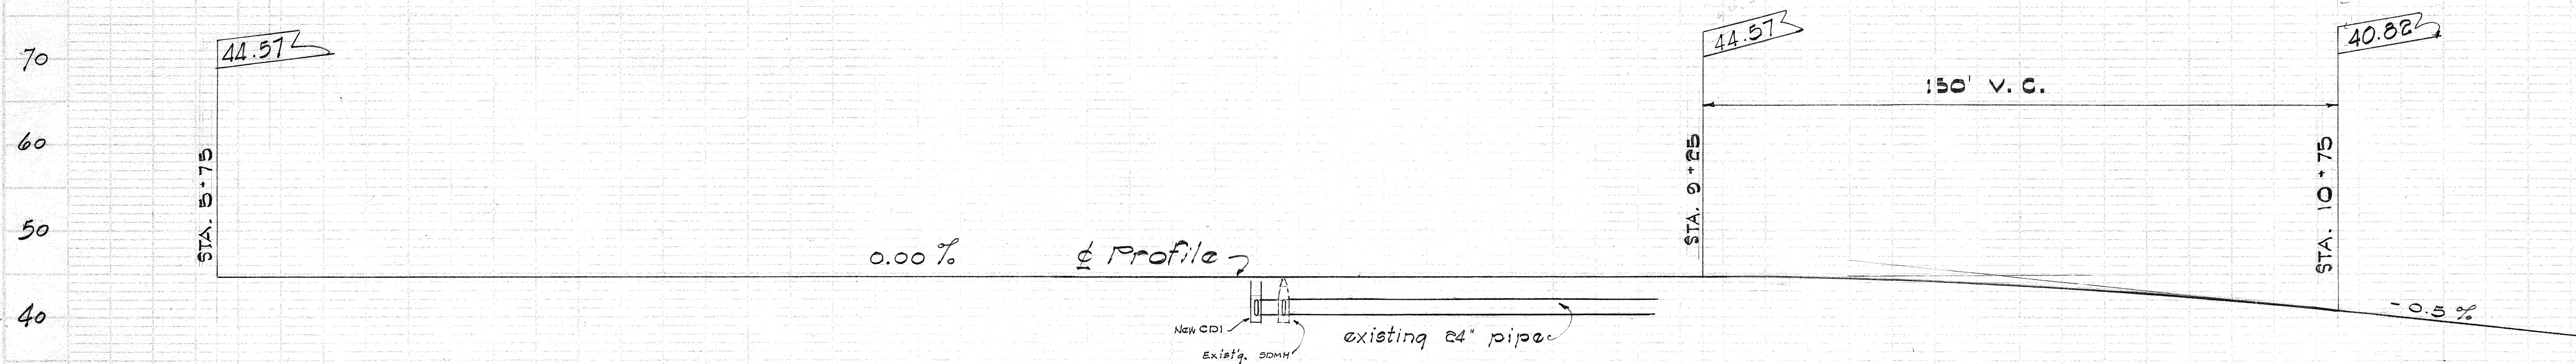


PLAN	DATE	BY	CHECKED
DESIGNED			
NOTED			
APPROVED			
DATE			

PROFILE	DATE	BY	CHECKED
DESIGNED			
NOTED			
APPROVED			
DATE			

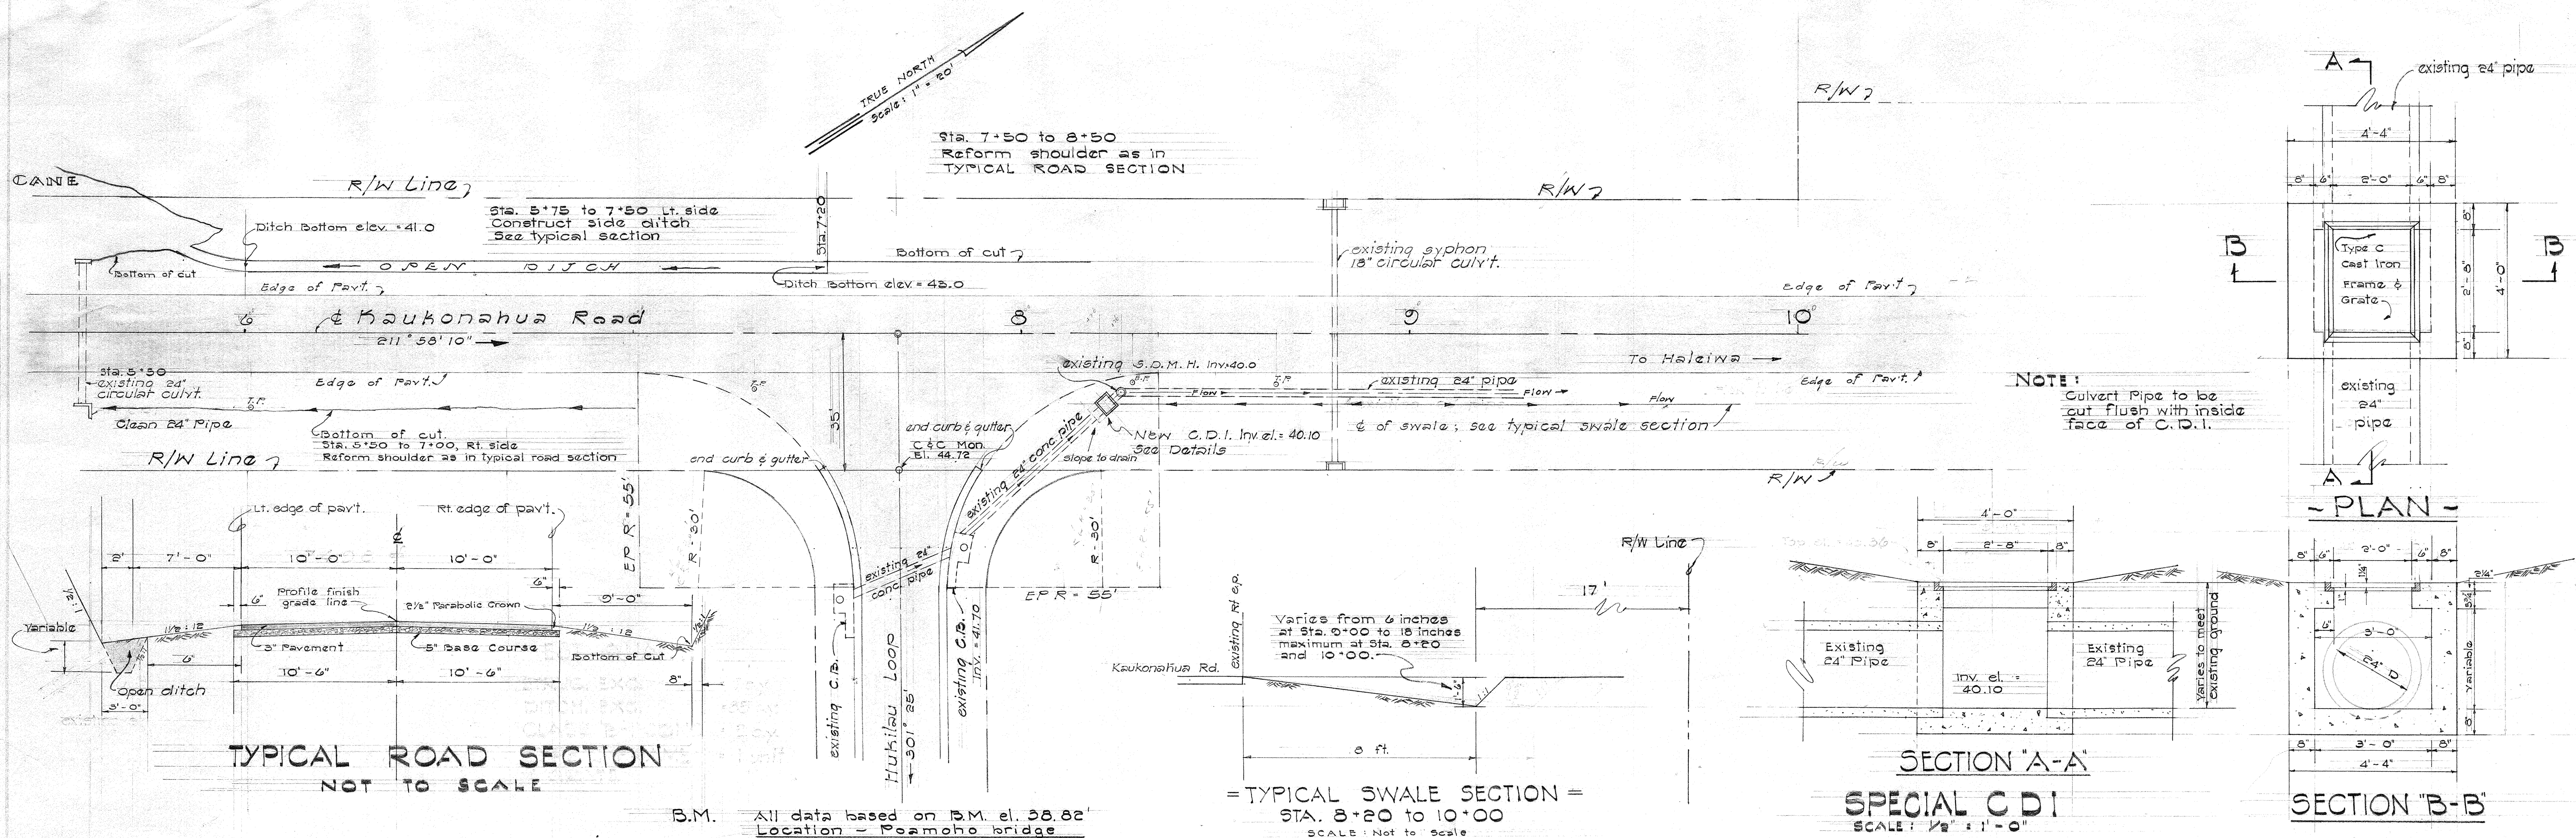

APPROVED
J.C. Myatt
 CHIEF ENGINEER

DATE

4/27/62

DEPARTMENT OF TRANSPORTATION
 HIGHWAYS DIVISION
 STATE OF HAWAII
 DRAINAGE IMPROVEMENTS
 INTERSECTION - HUKILAU LOOP
 & KAUKONAHUA ROAD
 PROJ. NO. A-85-01-62
 (NRH 7 E)
 Scale: As Shown Date March 14, 1962