IN	DEX TO DRAWINGS
SHEET NO.	DESCRIPTION
l	TITLE SHEET
2	PLAN, TYPICAL SECTIONS & GENERAL NOTES
3	TYPICAL DETAILS - RAISED PAVEMENT MARKERS
75	
,	



STATE OF HAWAII


## OF TRANSPORTATION DEPARTMENT DIVISION HIGHWAYS


HONOLULU, HAWAII

"AS-BUILT"

## PLANS FOR FARRINGTON HIGHWAY RESURFACING CAMPBELL RANCH ROAD TOWARD MOKULEIA BEACH PARK PROJECT NO. 930B-01-73

DISTRICT OF WAIALUA ISLAND OF OAHU

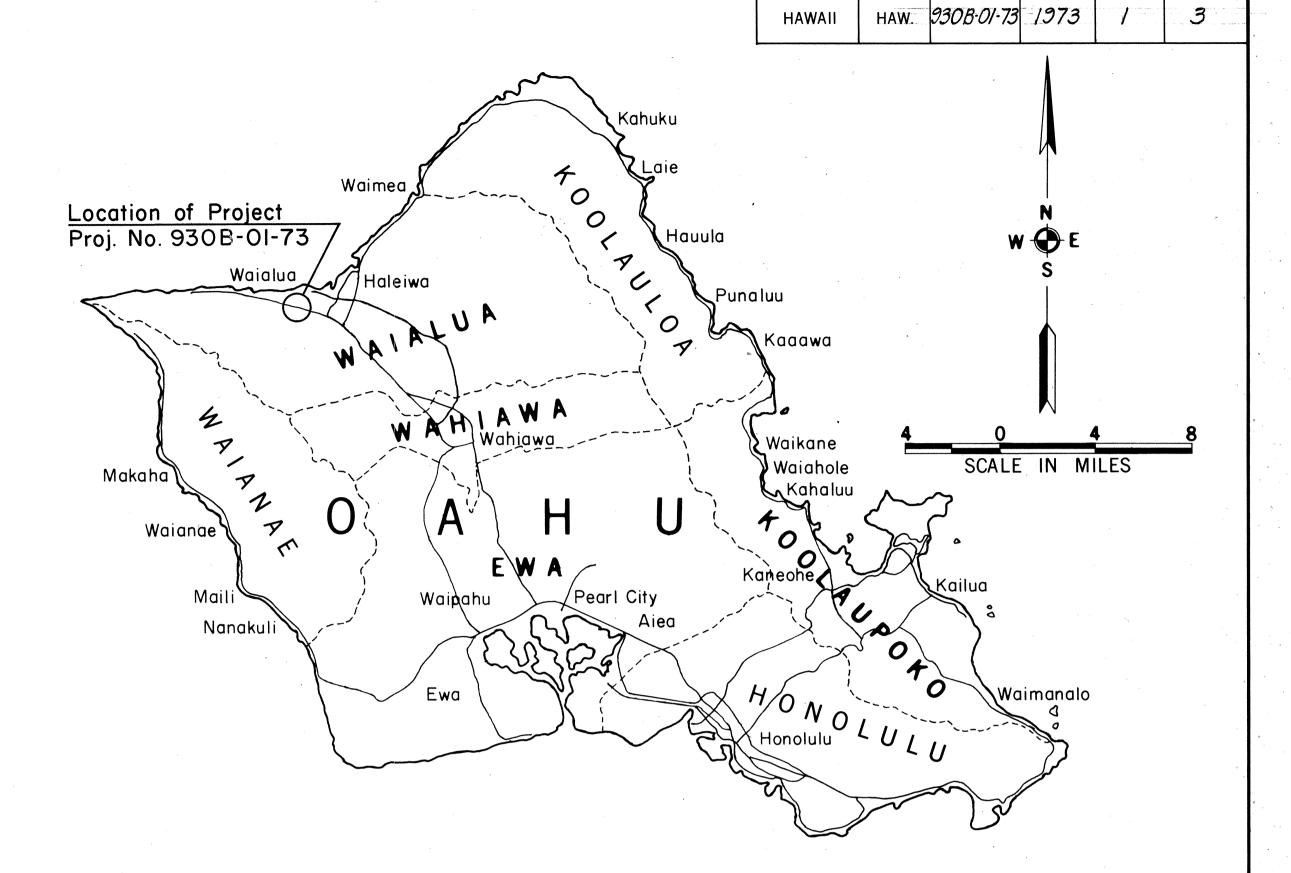

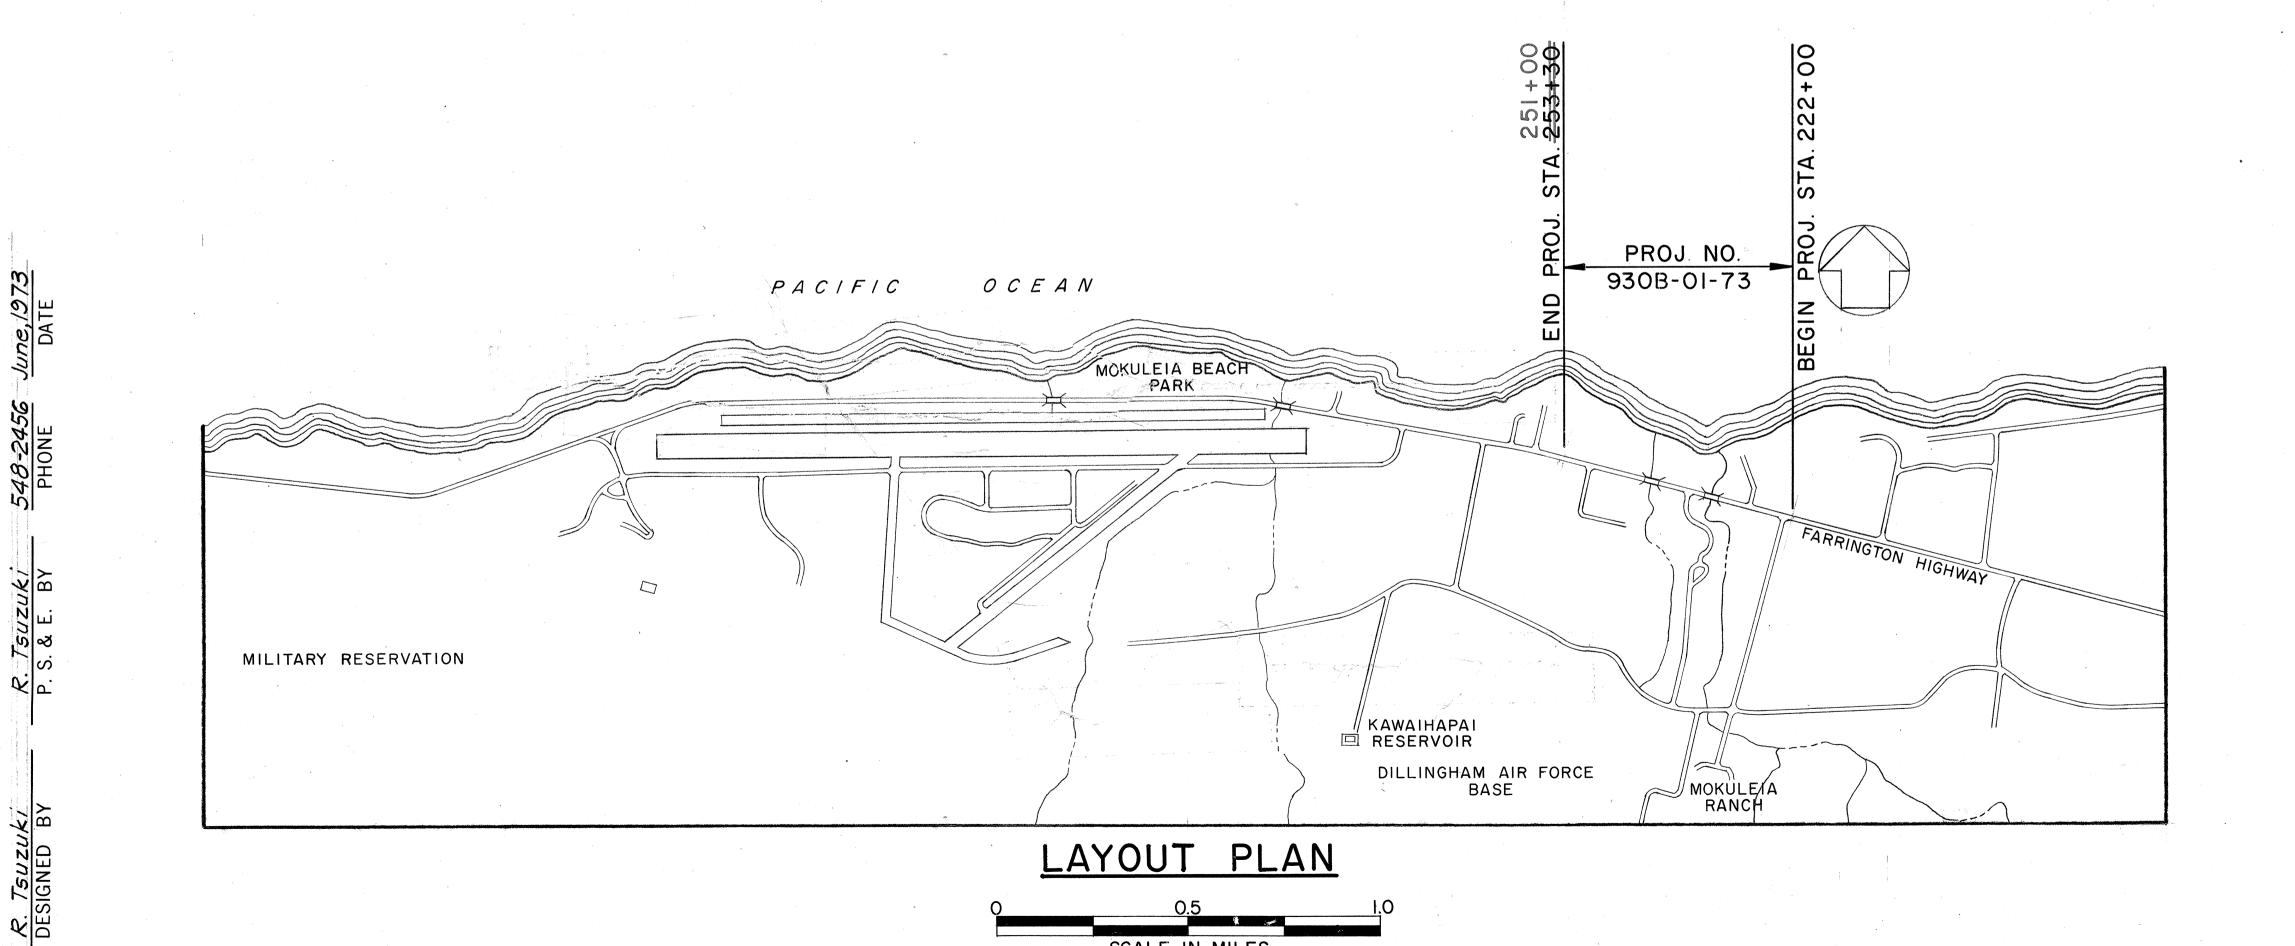

SCALE IN MILES

PROJ. LENGTH .... 0.593 mi.

ALL CHANGES MADE DURING CONSTRUCTION HAVE BEEN INCORPORATED ON THESE PLANS IN RED EXCEPT CHANGES IN THE ORIGINAL THEORETICAL QUANTITIES. FOR ACTUAL QUANTITIES, REFER TO PROJECT LEDGER AND/OR COMPUTATION BOOK.

8-14-81 DATE

DEPARTMENT OF TRANSPORTATION STATE OF HAWAII APPROVED: 9/17/73

FOR DIR. OF TRANSPORTATION

DD-8-7-10

DATE