IN	DEX	TO	DR	AWINGS	6
SHEET NO.	DESCRIPTION				
1	TITLE SHEET				
2	LIGH	HTING	PLAN	(930C-0I	-73)
3	LIGH	TING	PLAN	(930C-01-	-73)
4	LIGH	ITING	PLAN	(HWY-0-0	02-73)
5	LIGH	ITING	PLAN	(HWY-0-	02-73)
6	MISC	C. DET	AILS		
		·			
				•	
·					
,					
			\$		
	÷				



STATE OF HAWAII

DEPARTMENT OF TRANSPORTATION HIGHWAYS DIVISION

> HONOLULU, HAWAII "AS - BUILT"


PLANS FOR INSTALLATION OF FARRINGTON HIGHWAY STREET LIGHTS WAIALUA, OAHU

PROJECT NO. 930C-01-73

AND WEED JUNCTION STREET LIGHTS WAIALUA, OAHU

PROJECT NO. HWY-0-02-73

DISTRICT OF WAIALUA ISLAND OF OAHU CROZIER DRIVE END PROJECT
NO. HWY-0-02-73
STA. 71+91, BASELINE &
STA. 68+26.5, 7-A(R) BEGIN PROJECT NO. HWY-0-02-73 STA. 34+96, 7-J(1) WAIALUA BEGIN PROJECT NO. 930C-01-73 STA. 82+90 HIGH SCHOOL T.O MILE END PROJECT NO. 930C-01-73 STA. 35+10 THOMPSON CORNER LENGTH OF PROJECT: APPROX. 2.6 MILES

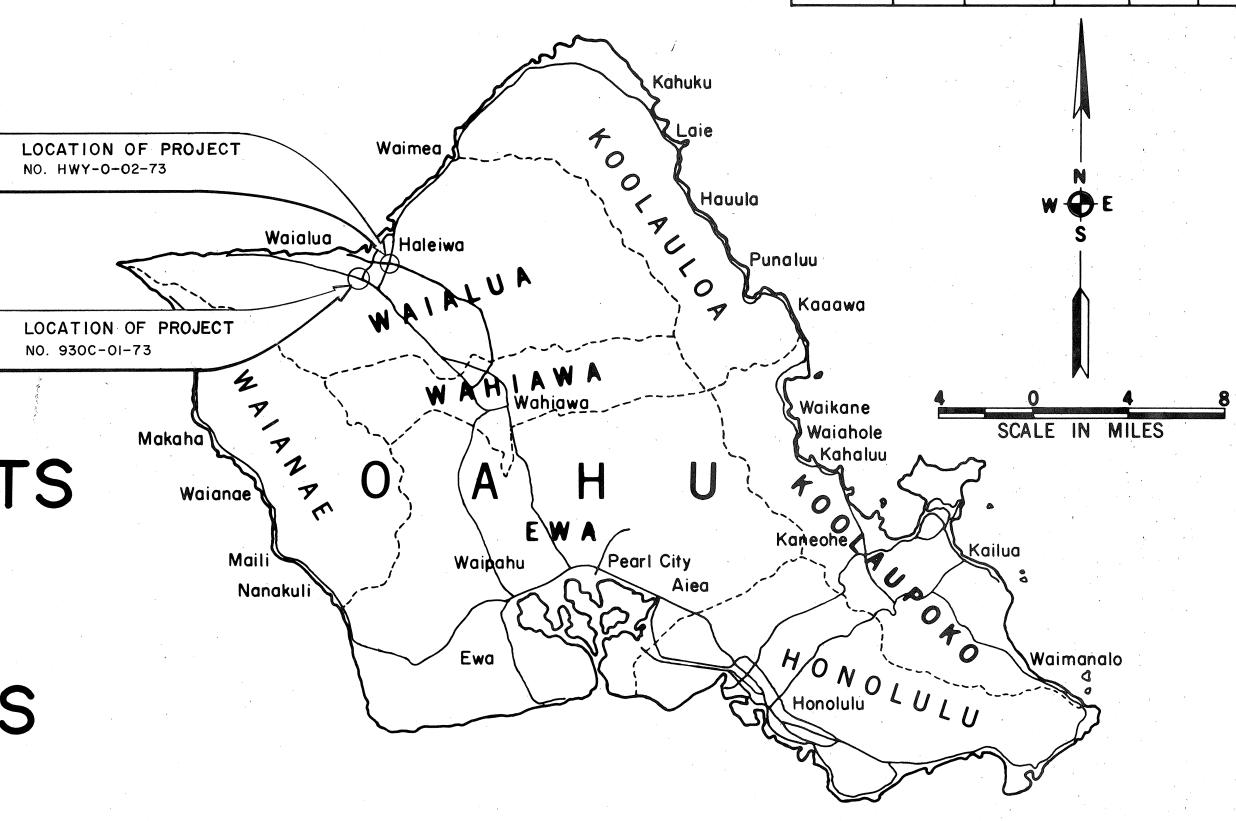


NO CHANGES WERE MADE DURING CONSTRUCTION ON THESE PLANS EXCEPT CHANGES IN THE ORIGINAL THEORETICAL QUANTITIES. FOR ACTUAL QUANTITIES, REFER TO PROJECT LEDGER AND/OR COMPUTATION BOOK.

> David Jamashers
> PROJECT ENGINEER 3/16/78

APPROVALS:

Mchar for G.Y. HAWAIIAN TELEPHONE CO.

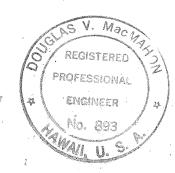

DEPARTMENT OF TRANSPORTATION STATE OF HAWAII

APPROVED:

FOR DIR. OF TRANSPORTATION

THIS WORK WAS PREPARED BY ME OR UNDER MY SUPERVISION.