



STATE OF HAWAII

OF DEPARTMENT TRANSPORTATION HIGHWAYS DIVISION


HONOLULU, HAWAII

PLANS FOR

DRAINAGE IMPROVEMENTS FARRINGTON HIGHWAY AT WAIALUA

PROJECT NO. 930 BC - 01-75

DISTRICT OF WAIALUA ISLAND OF OAHU

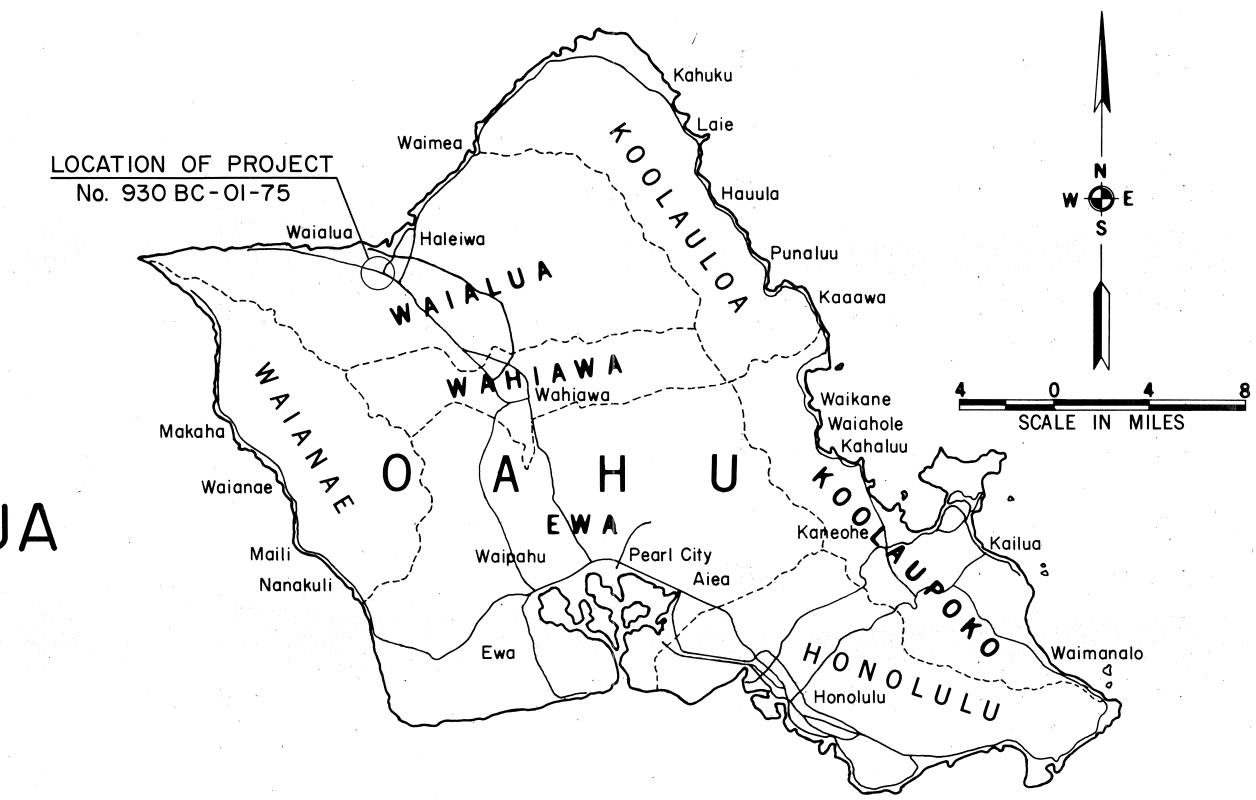


ALL CHANGES MADE DURING CONSTRUCTION HAVE BEEN INCORPORATED ON THESE PLANS IN RED EXCEPT CHANGES IN THE ORIGINAL THEORETICAL QUANTITIES. FOR ACTUAL QUANTITIES, REFER TO PROJECT LEDGER AND/OR COMPUTATION BOOK.

STATE PROJ. NO.

HAW. 930BC-01-75 1976

RESIDENT ENGINEER

DATE

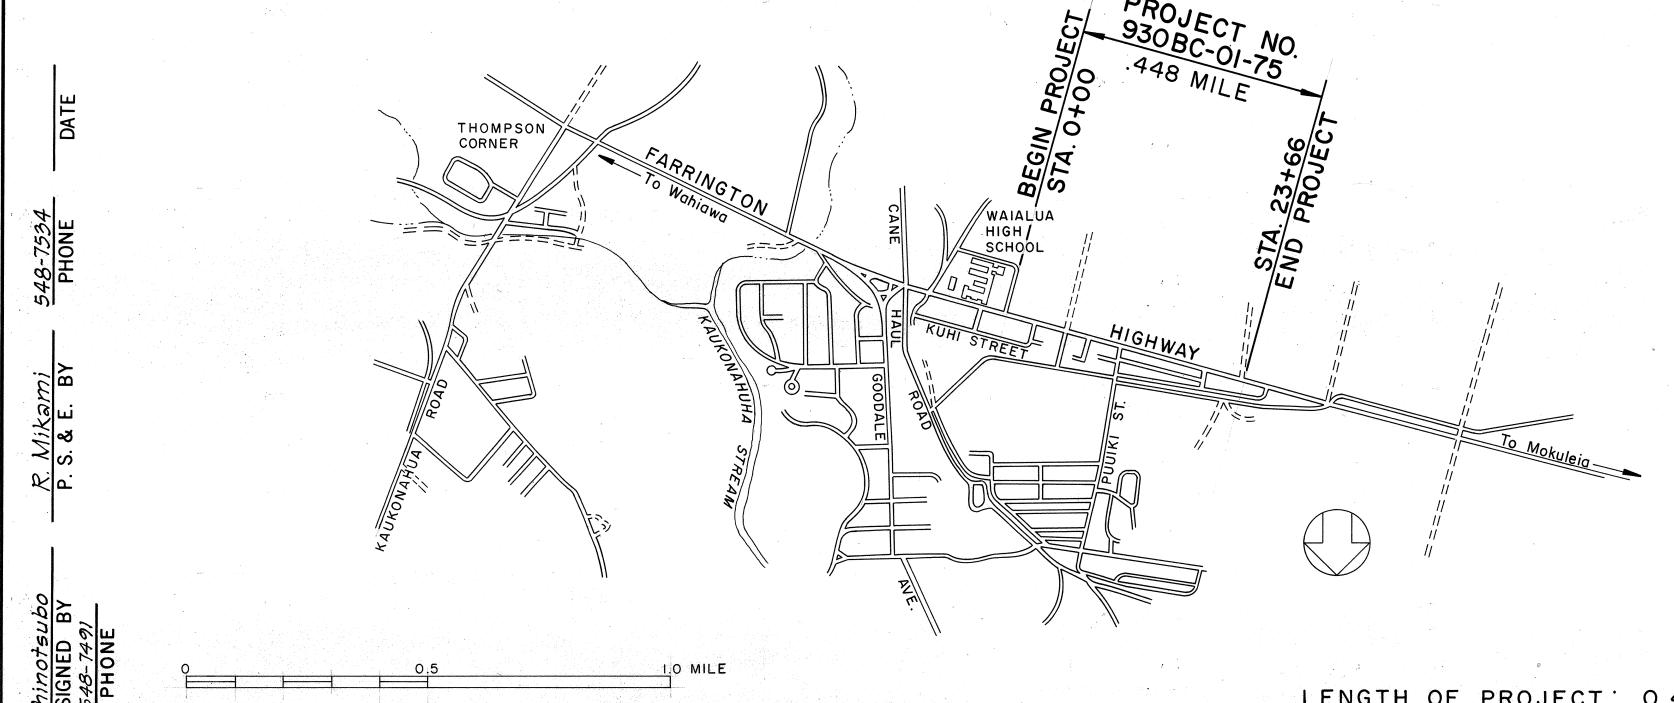

LENGTH OF PROJECT: 0.448 Mi.

LOCATION PLAN DEPARTMENT OF TRANSPORTATION STATE OF HAWAII

DIR. OF TRANSPORTATION