	INDEX TO DRAWINGS
SHEET NO.	DESCRIPTION
	TITLE SHEET
2	STANDARD PLANS SUMMARY
3	GENERAL NOTES
4 - 6	TYP. SECT. & MISC. PAVING DETAILS
7 - 15	ROADWAY PLANS
16 - 23	GUARDRAIL & IMPACT ATTENUATOR
	CONNECTION, & CONC. CULVT. EXT.
24 - 26	DRAINAGE
27 - 36	TRAFFIC NOTES & PAVEMENT
	MARKING & SIGNING
37 - 39	HIGHWAY LIGHTING RELOC.
	ph and the property of the pro
/	
2 ',	


STATE OF HAWAII


DEPARTMENT OF TRANSPORTATION

HIGHWAYS DIVISION
HONOLULU, HAWAII
"AS-BUILT"
PLANS FOR

FARRINGTON HIGHWAY RESURFACING
KAUKONAHUA ROAD TOWARD MAKALEHA BRIDGE
FEDERAL AID PROJECT NO. RS-0930(5)

DISTRICT OF WAIALUA ISLAND OF OAHU

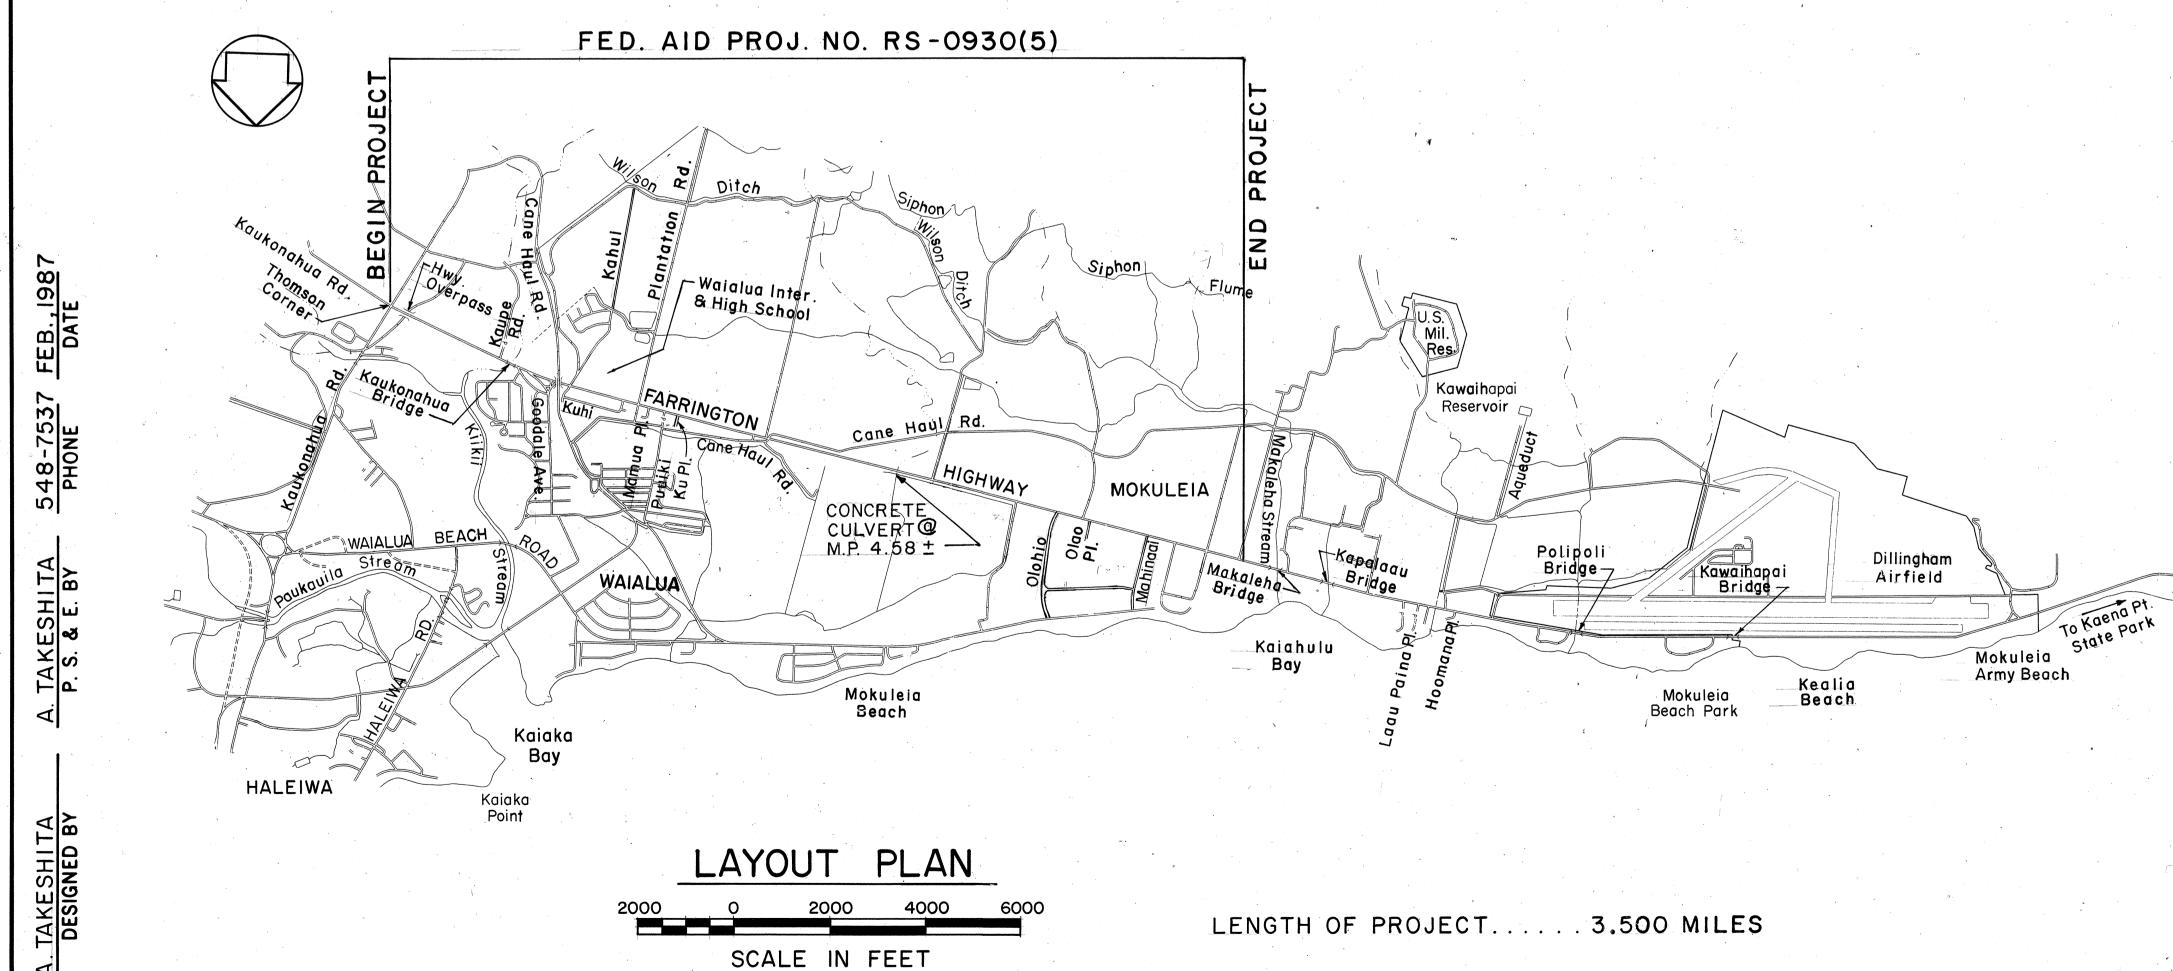

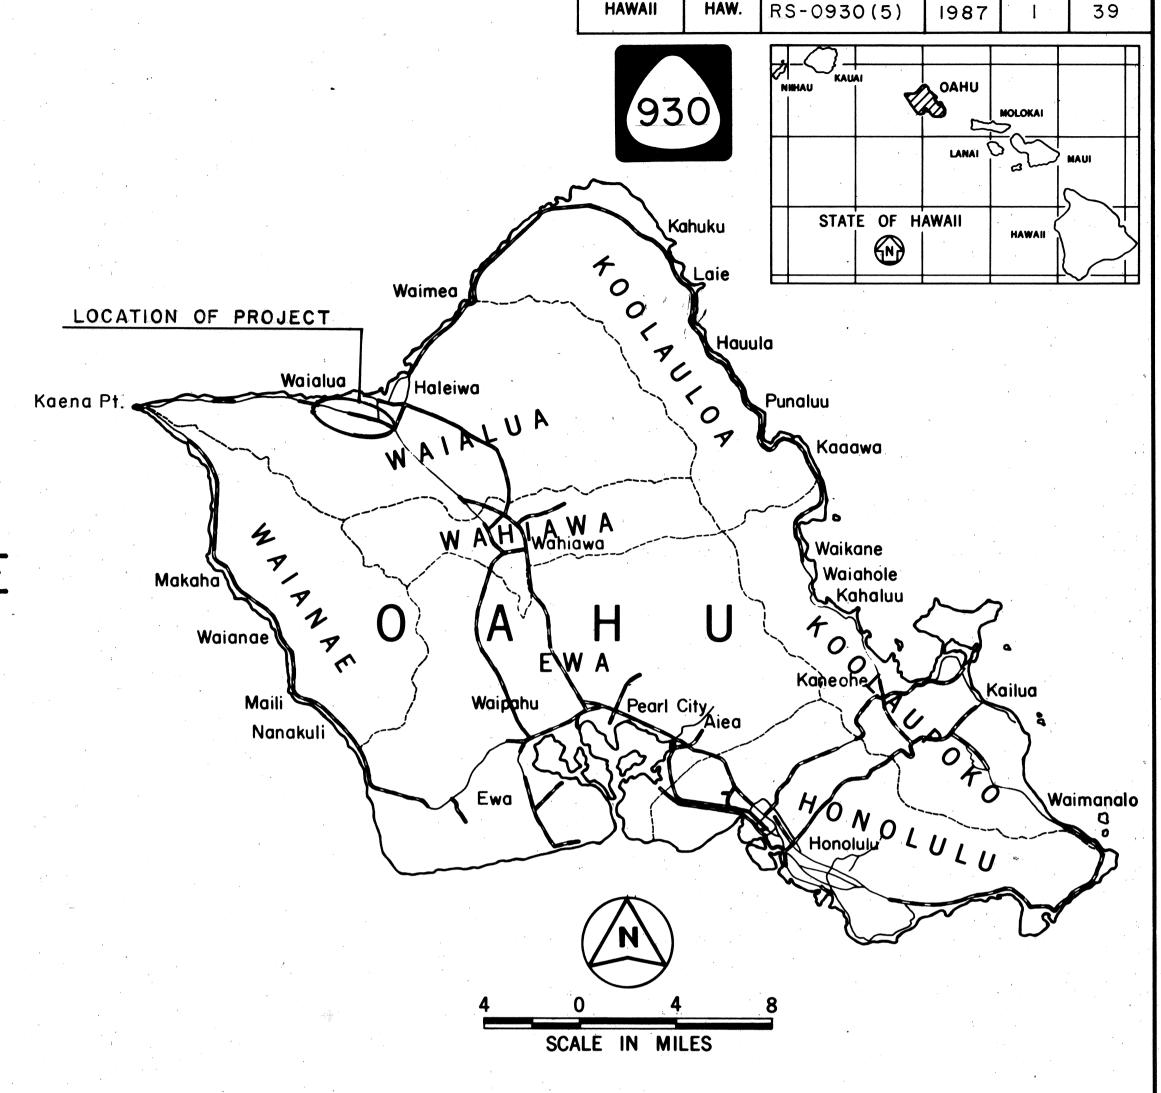

FEDERAL AID PROJECTS PREVIOUSLY CONSTRUCTED
OR UNDER CONSTRUCTION

DESIGN DESIGNATION

TO PUUIKI ST. DILLINGHAM AIRFIELD

CURRENT ADT (1986) 6,500 3,200
DESIGN ADT (1996) 7,300 3,600
DHV 700 300
D. 50/50 60/40
T₂₄ 3.5% 3.5%

CHANGES MADE DURING CONSTRUCTION HAVE BEEN INCORPORATED ON THESE PLANS EXCEPT CHANGES IN THE ORIGINAL THEORETICAL QUANTITIES, FOR ACTUAL QUANTITIES, REFER TO PROJECT LEDGER AND/OR COMPUTATION BOOK.

RESIDENT ENGINEER

12/12/88 DATE

KAUKONAHUA RD. PUUIKI ST. TO

DEPARTMENT OF TRANSPORTATION
STATE OF HAWAII

APPROVED:

TOR

DIR. OF TRANSPORTATION

DATE

FISCAL YEAR

FED. AID PROJ. NO.