

DATE	BY	FINAL SURVEY	SURVEYED
		PLOTTED	DATE
		NOTE BOOK	AREAS CHECKED
		NO.	

DATE	BY	ORIGINAL SURVEY	SURVEYED
		PLOTTED	DATE
		NOTE BOOK	AREAS CHECKED
		NO.	

FED. ROAD DIST. NO.	STATE	FED. AID PROJ. NO.	FISCAL YEAR	SHEET NO.	TOTAL SHEETS
HAWAII	HAW.	5223(2)	1951	25	30

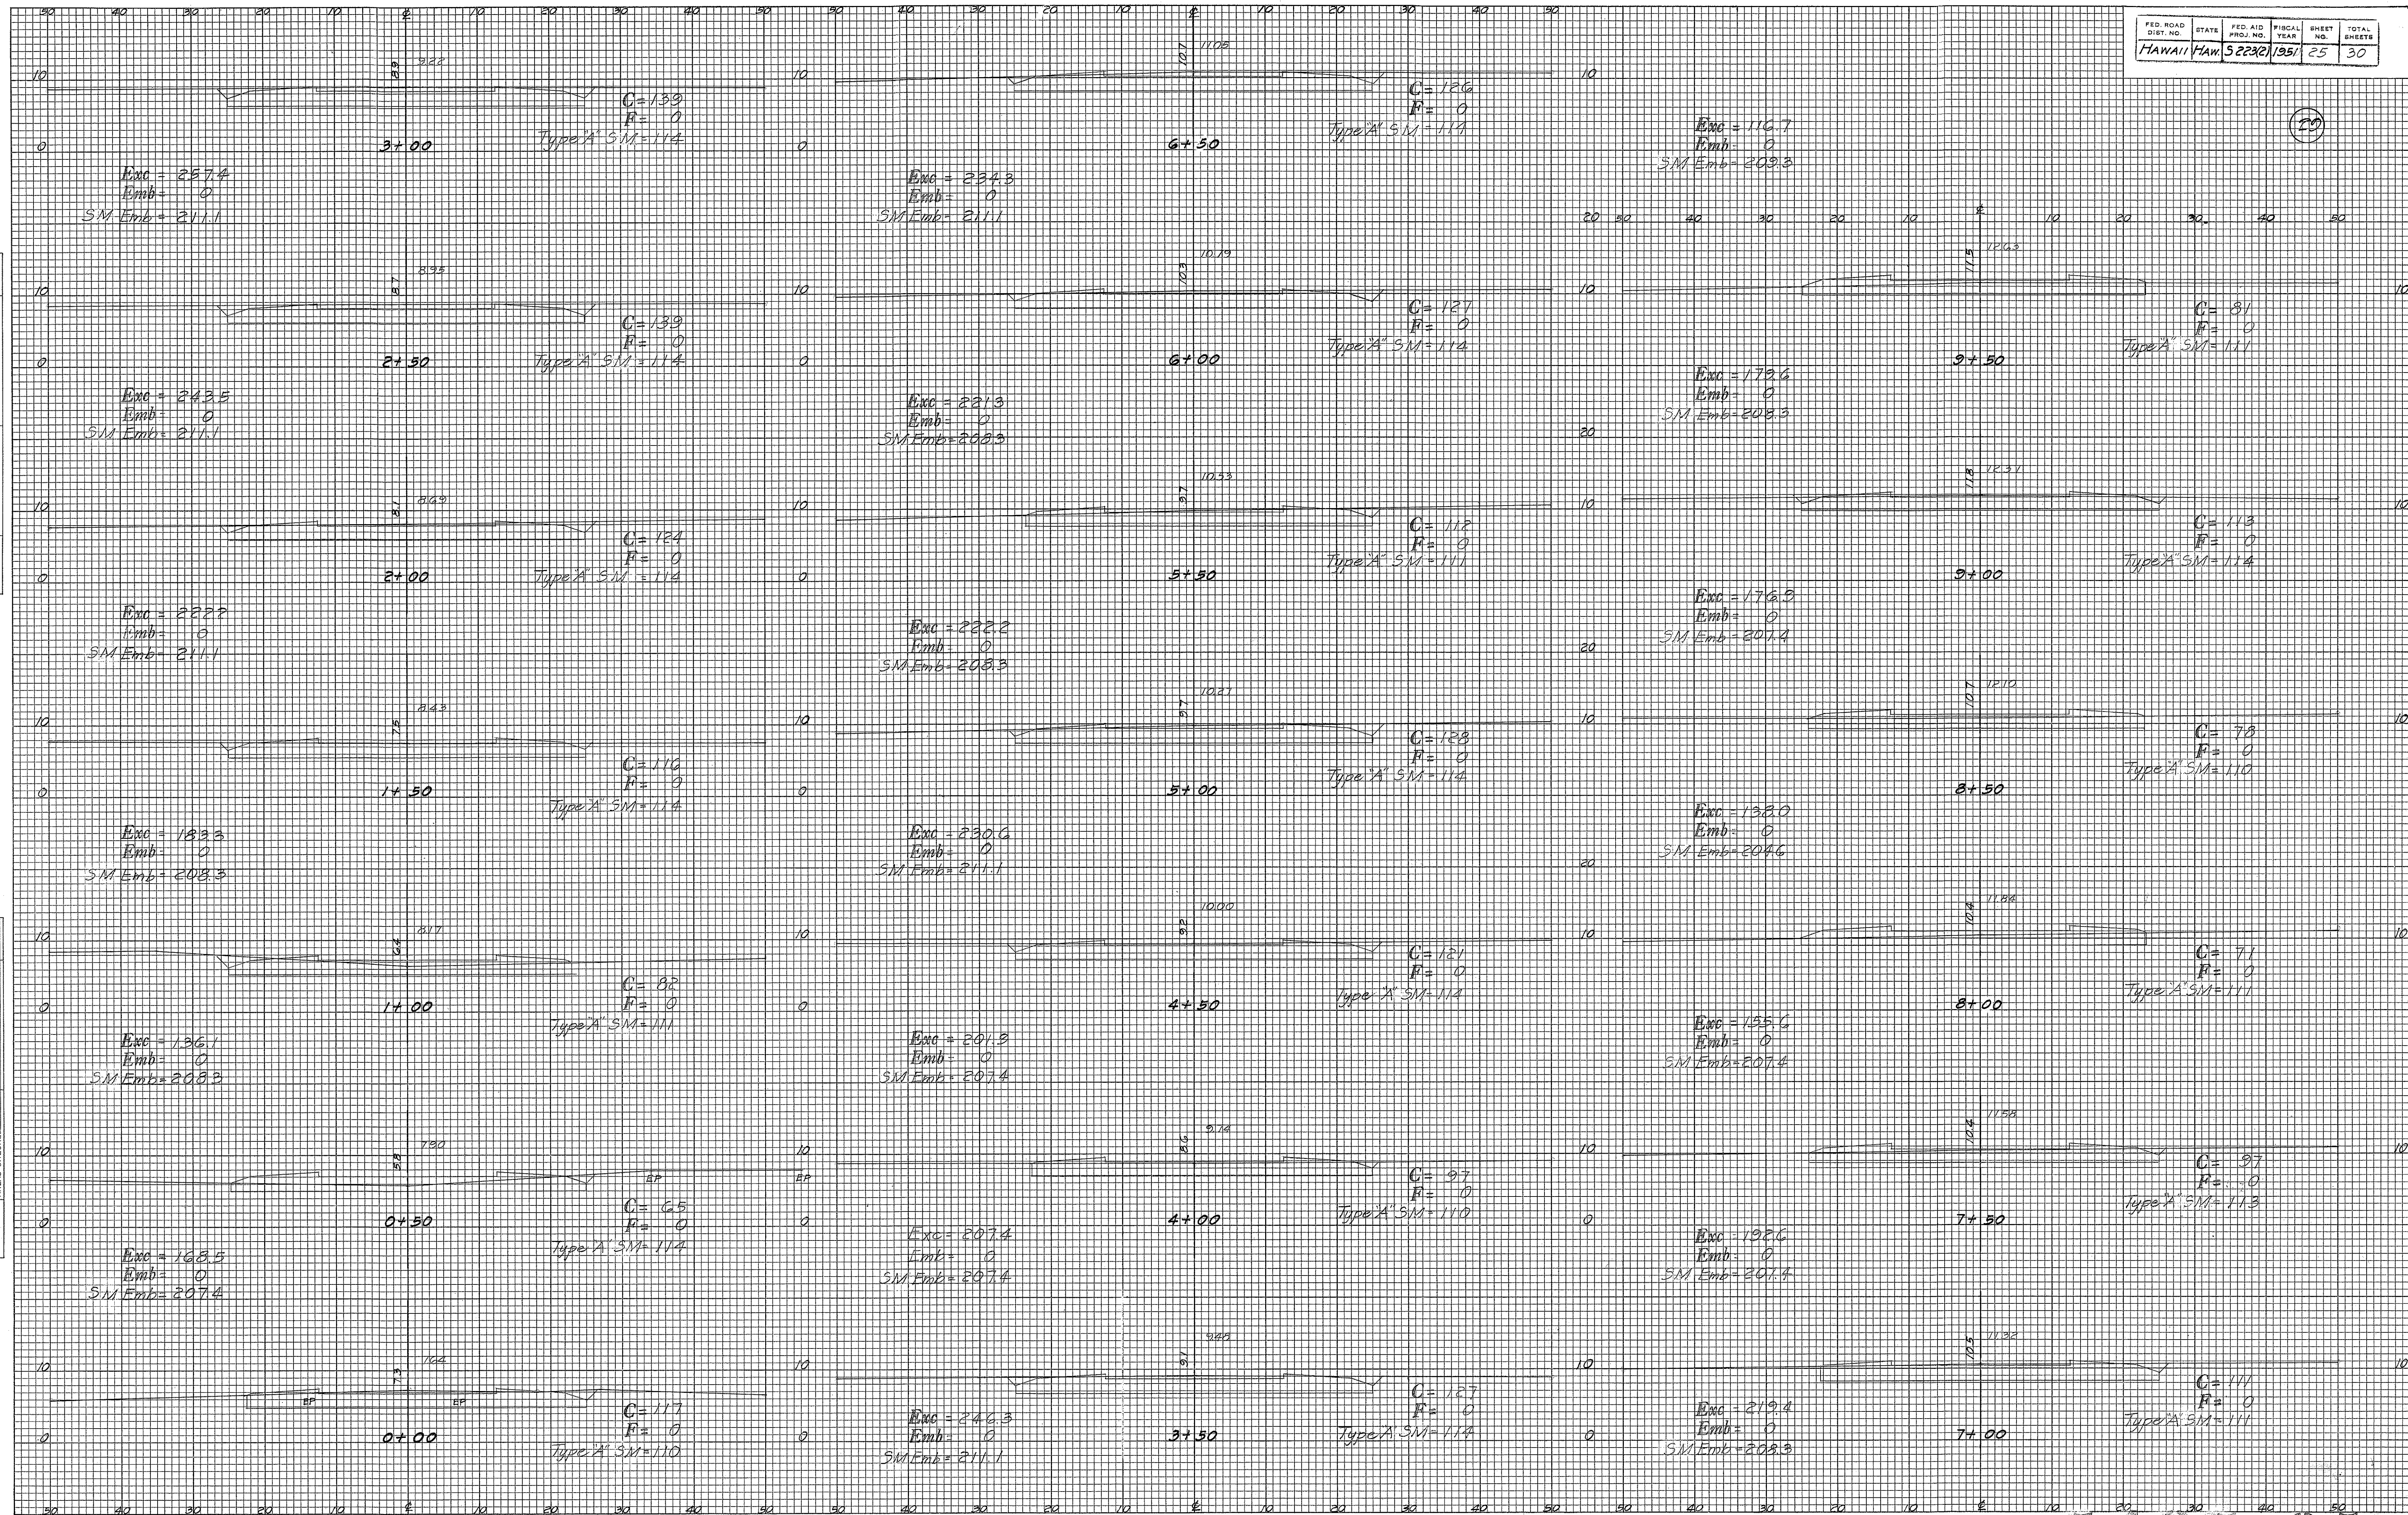



PLATE 3 - CROSS SECTION O.P.R. & R.E. STANDARD
KEUFFEL & ESSER CO., NEW YORK.

K & E CO. No. 345-3 MADE IN U.S.A. 48999-3

5425.25

DATE _____ BY _____
 SURVEYED _____
 PLANTED _____
 NOTE BOOK _____
 AREAS CHECKED _____
 NO. _____

DATE _____ BY _____
 SURVEYED _____
 PLANTED _____
 NOTE BOOK _____
 AREAS CHECKED _____
 NO. _____

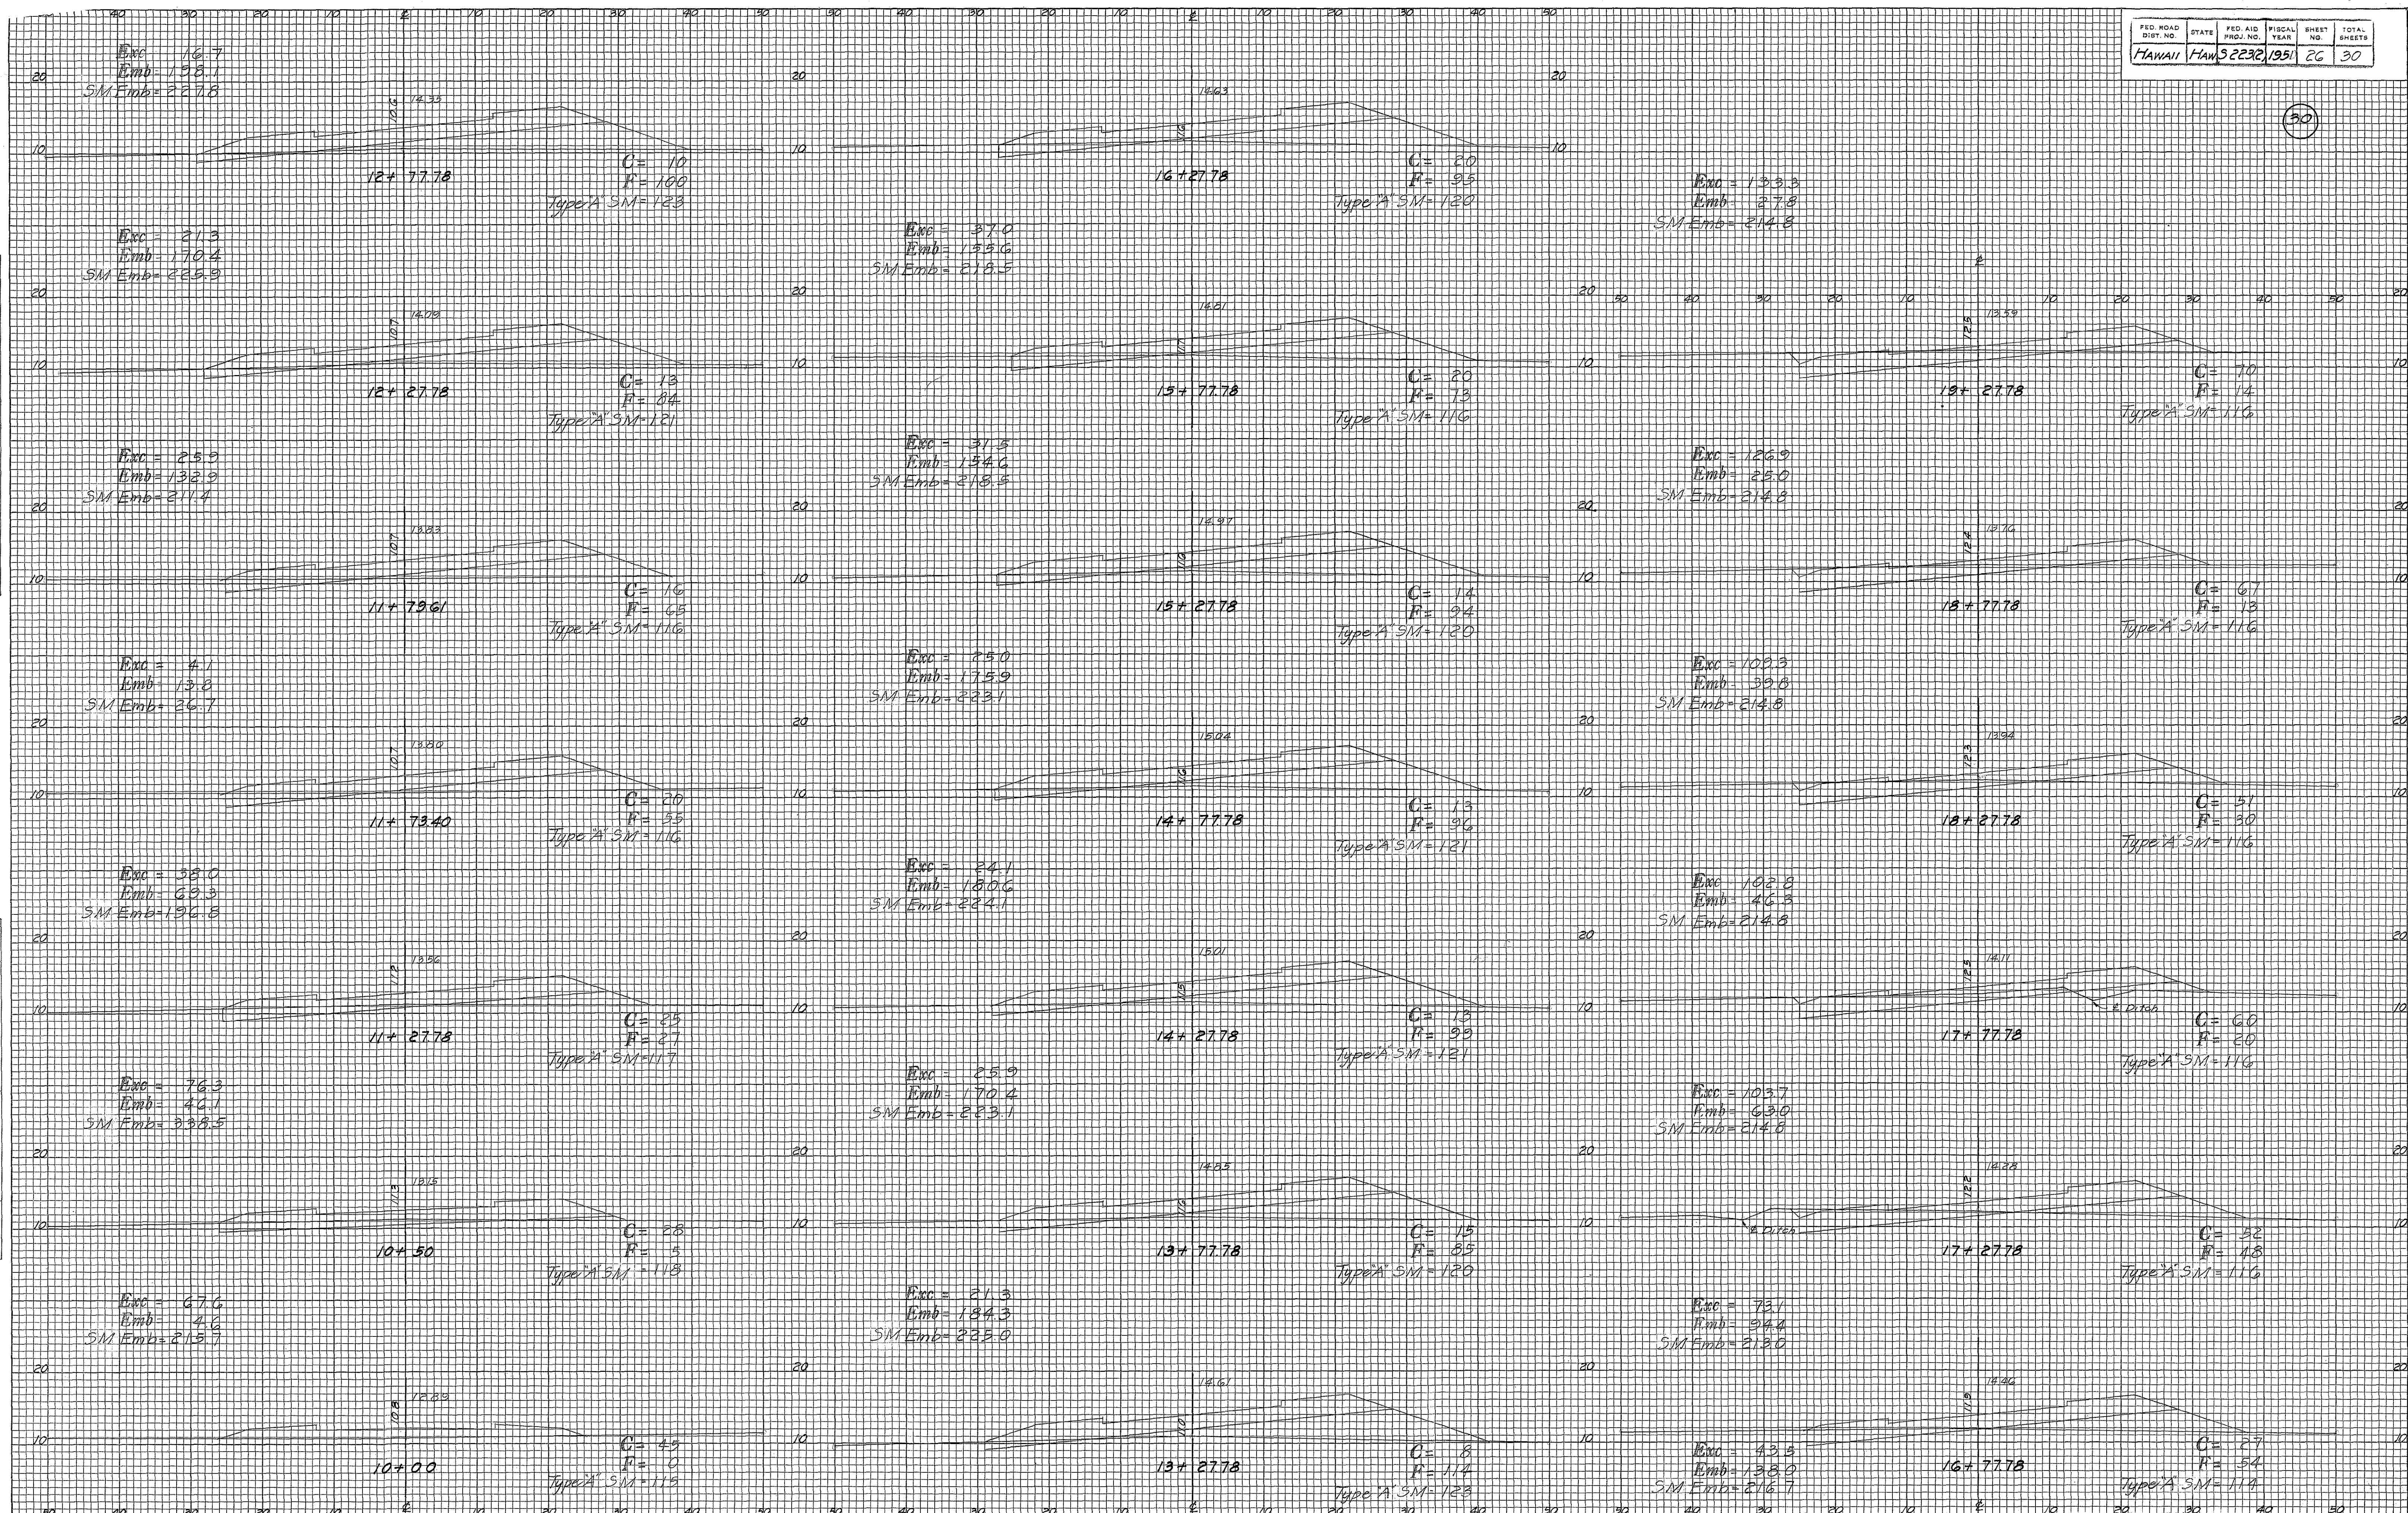


FINAL SURVEY	DATE
SURVEYED PLOTTED	BY
TEMPLATE	
NO. _____	
AREAS CHECKED	

ORIGINAL SURVEY	DATE
SURVEYED PLOTTED	BY
TEMPLATE	
NO. _____	
AREAS CHECKED	

FED. ROAD DIST. NO.	STATE	FED. AID PROJ. NO.	FISCAL YEAR	SHEET NO.	TOTAL SHEETS
Hawaii	Haw.	5223(2)	1951	27	30

31

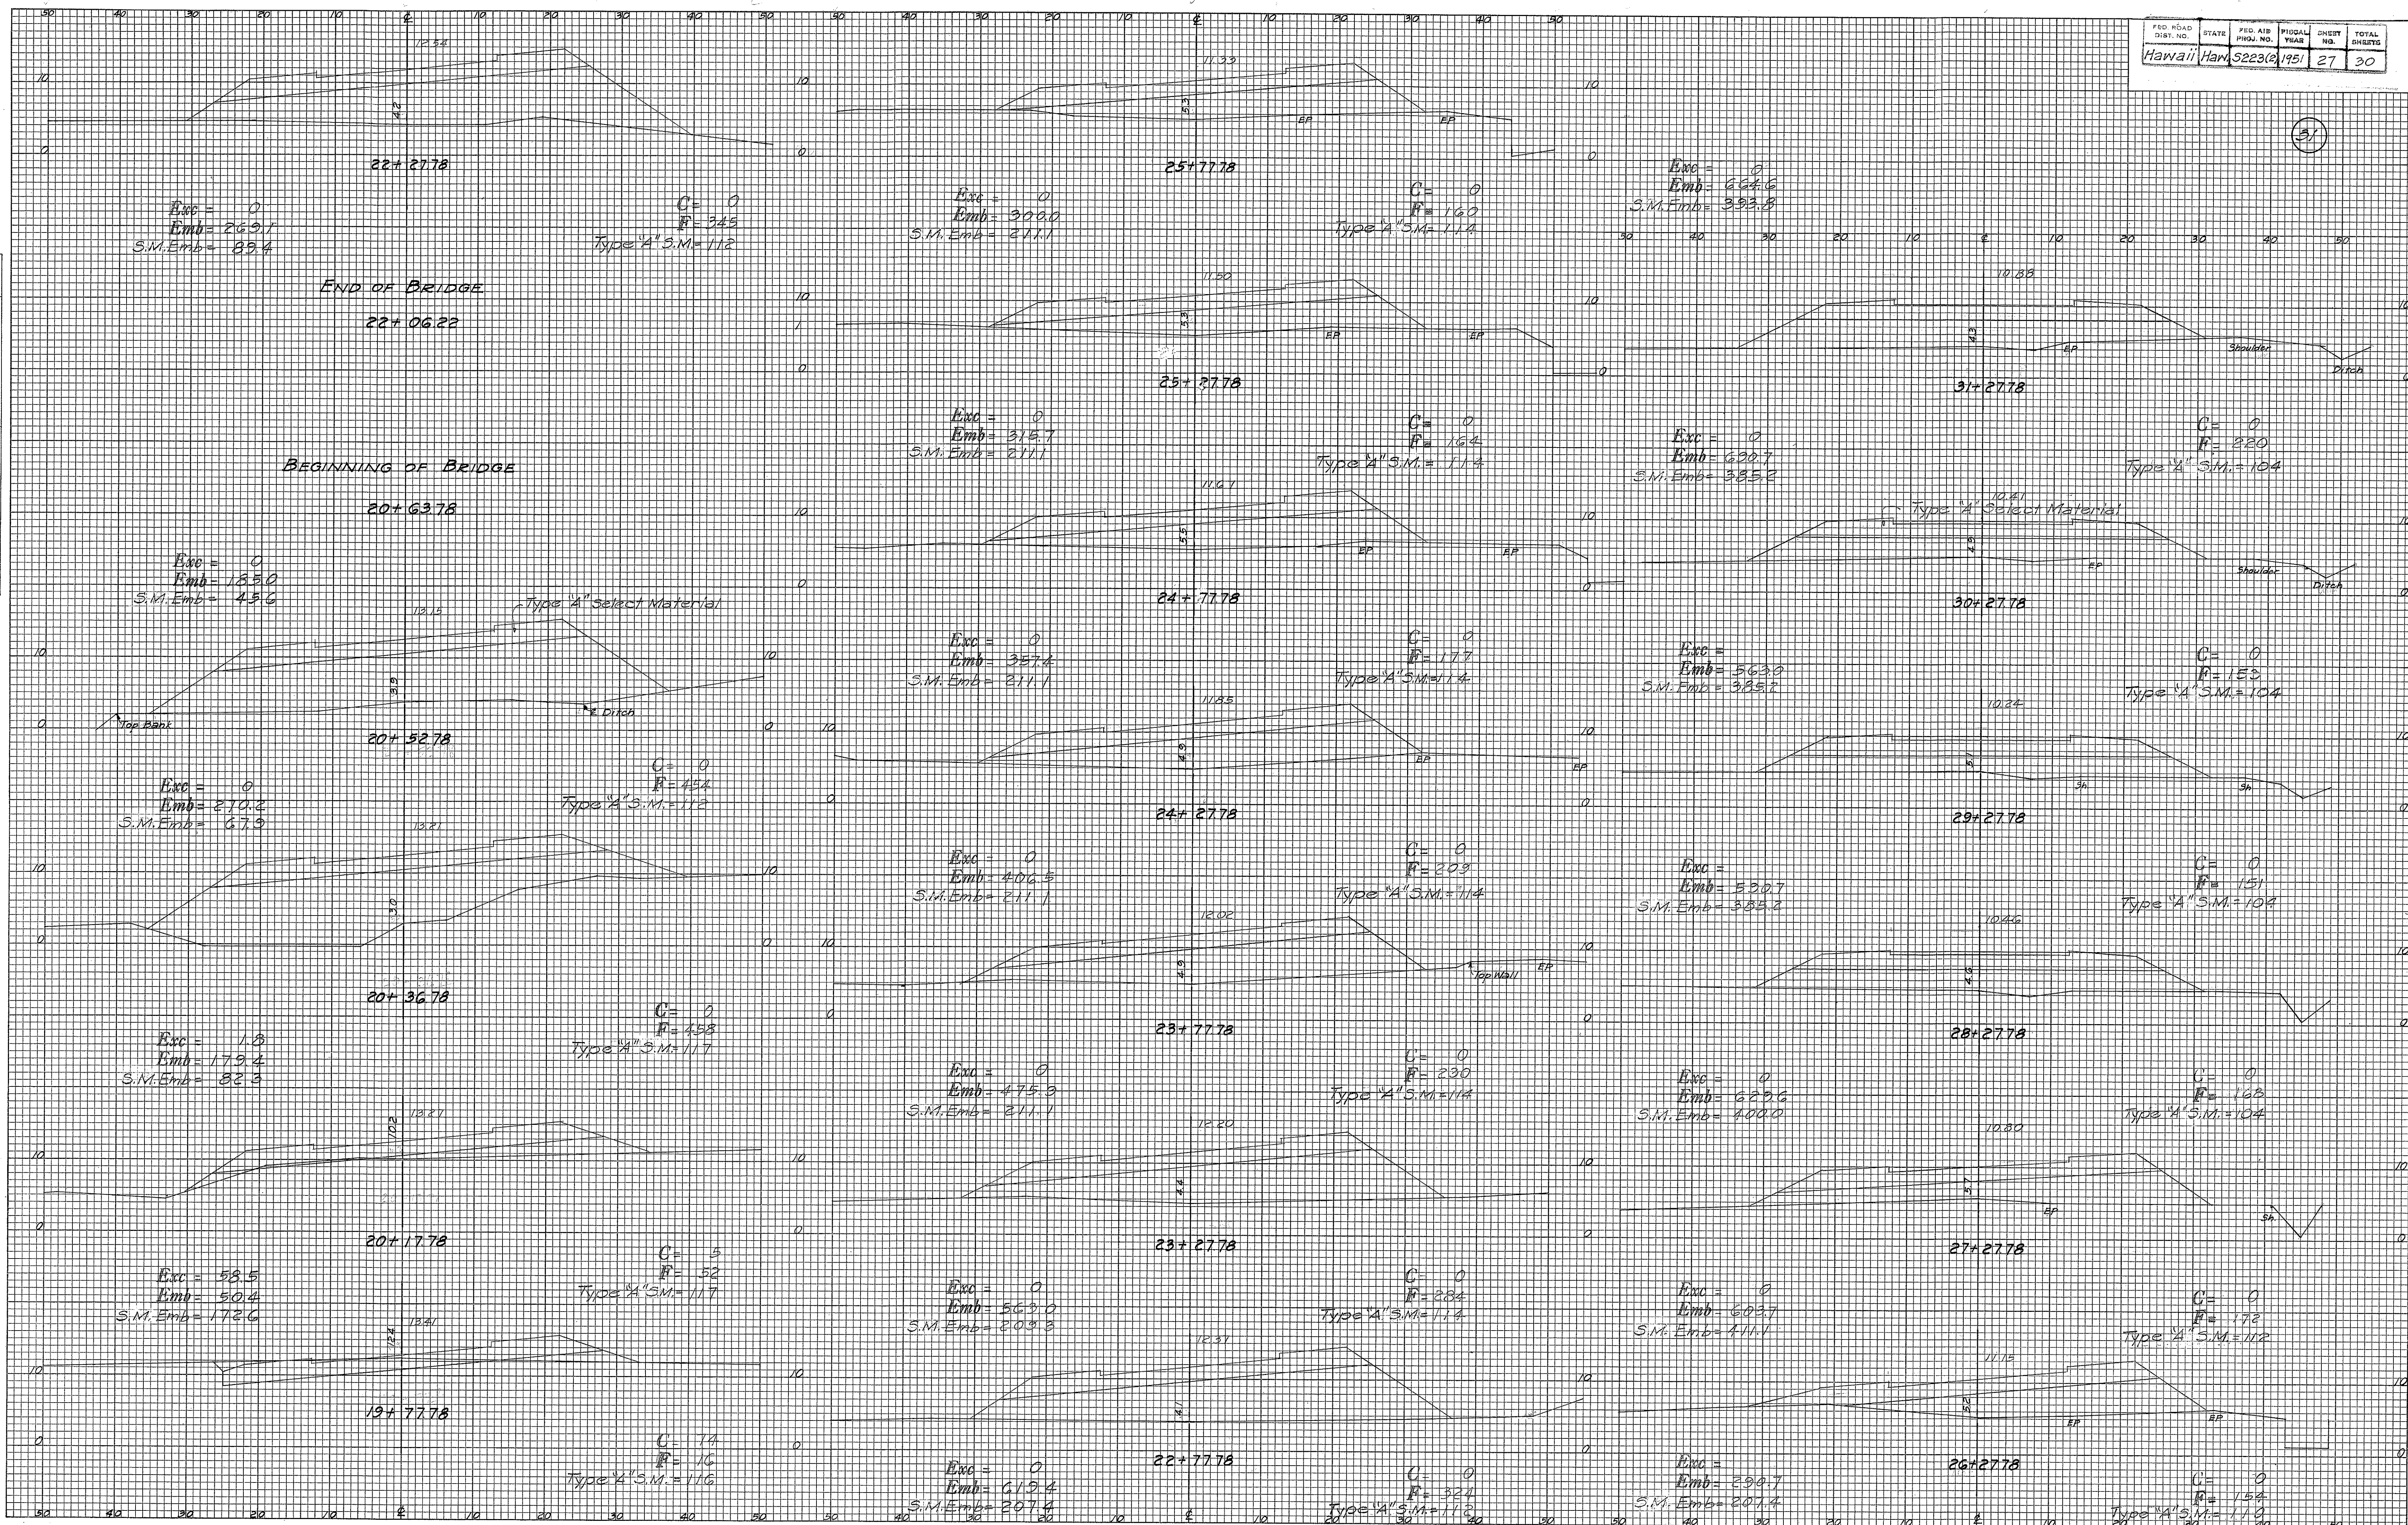


5425.26

DATE	BY	REVIEWED	DATE

NO.	AREAS CHECKED


DATE	BY	REVIEWED	DATE

NO.	AREAS CHECKED

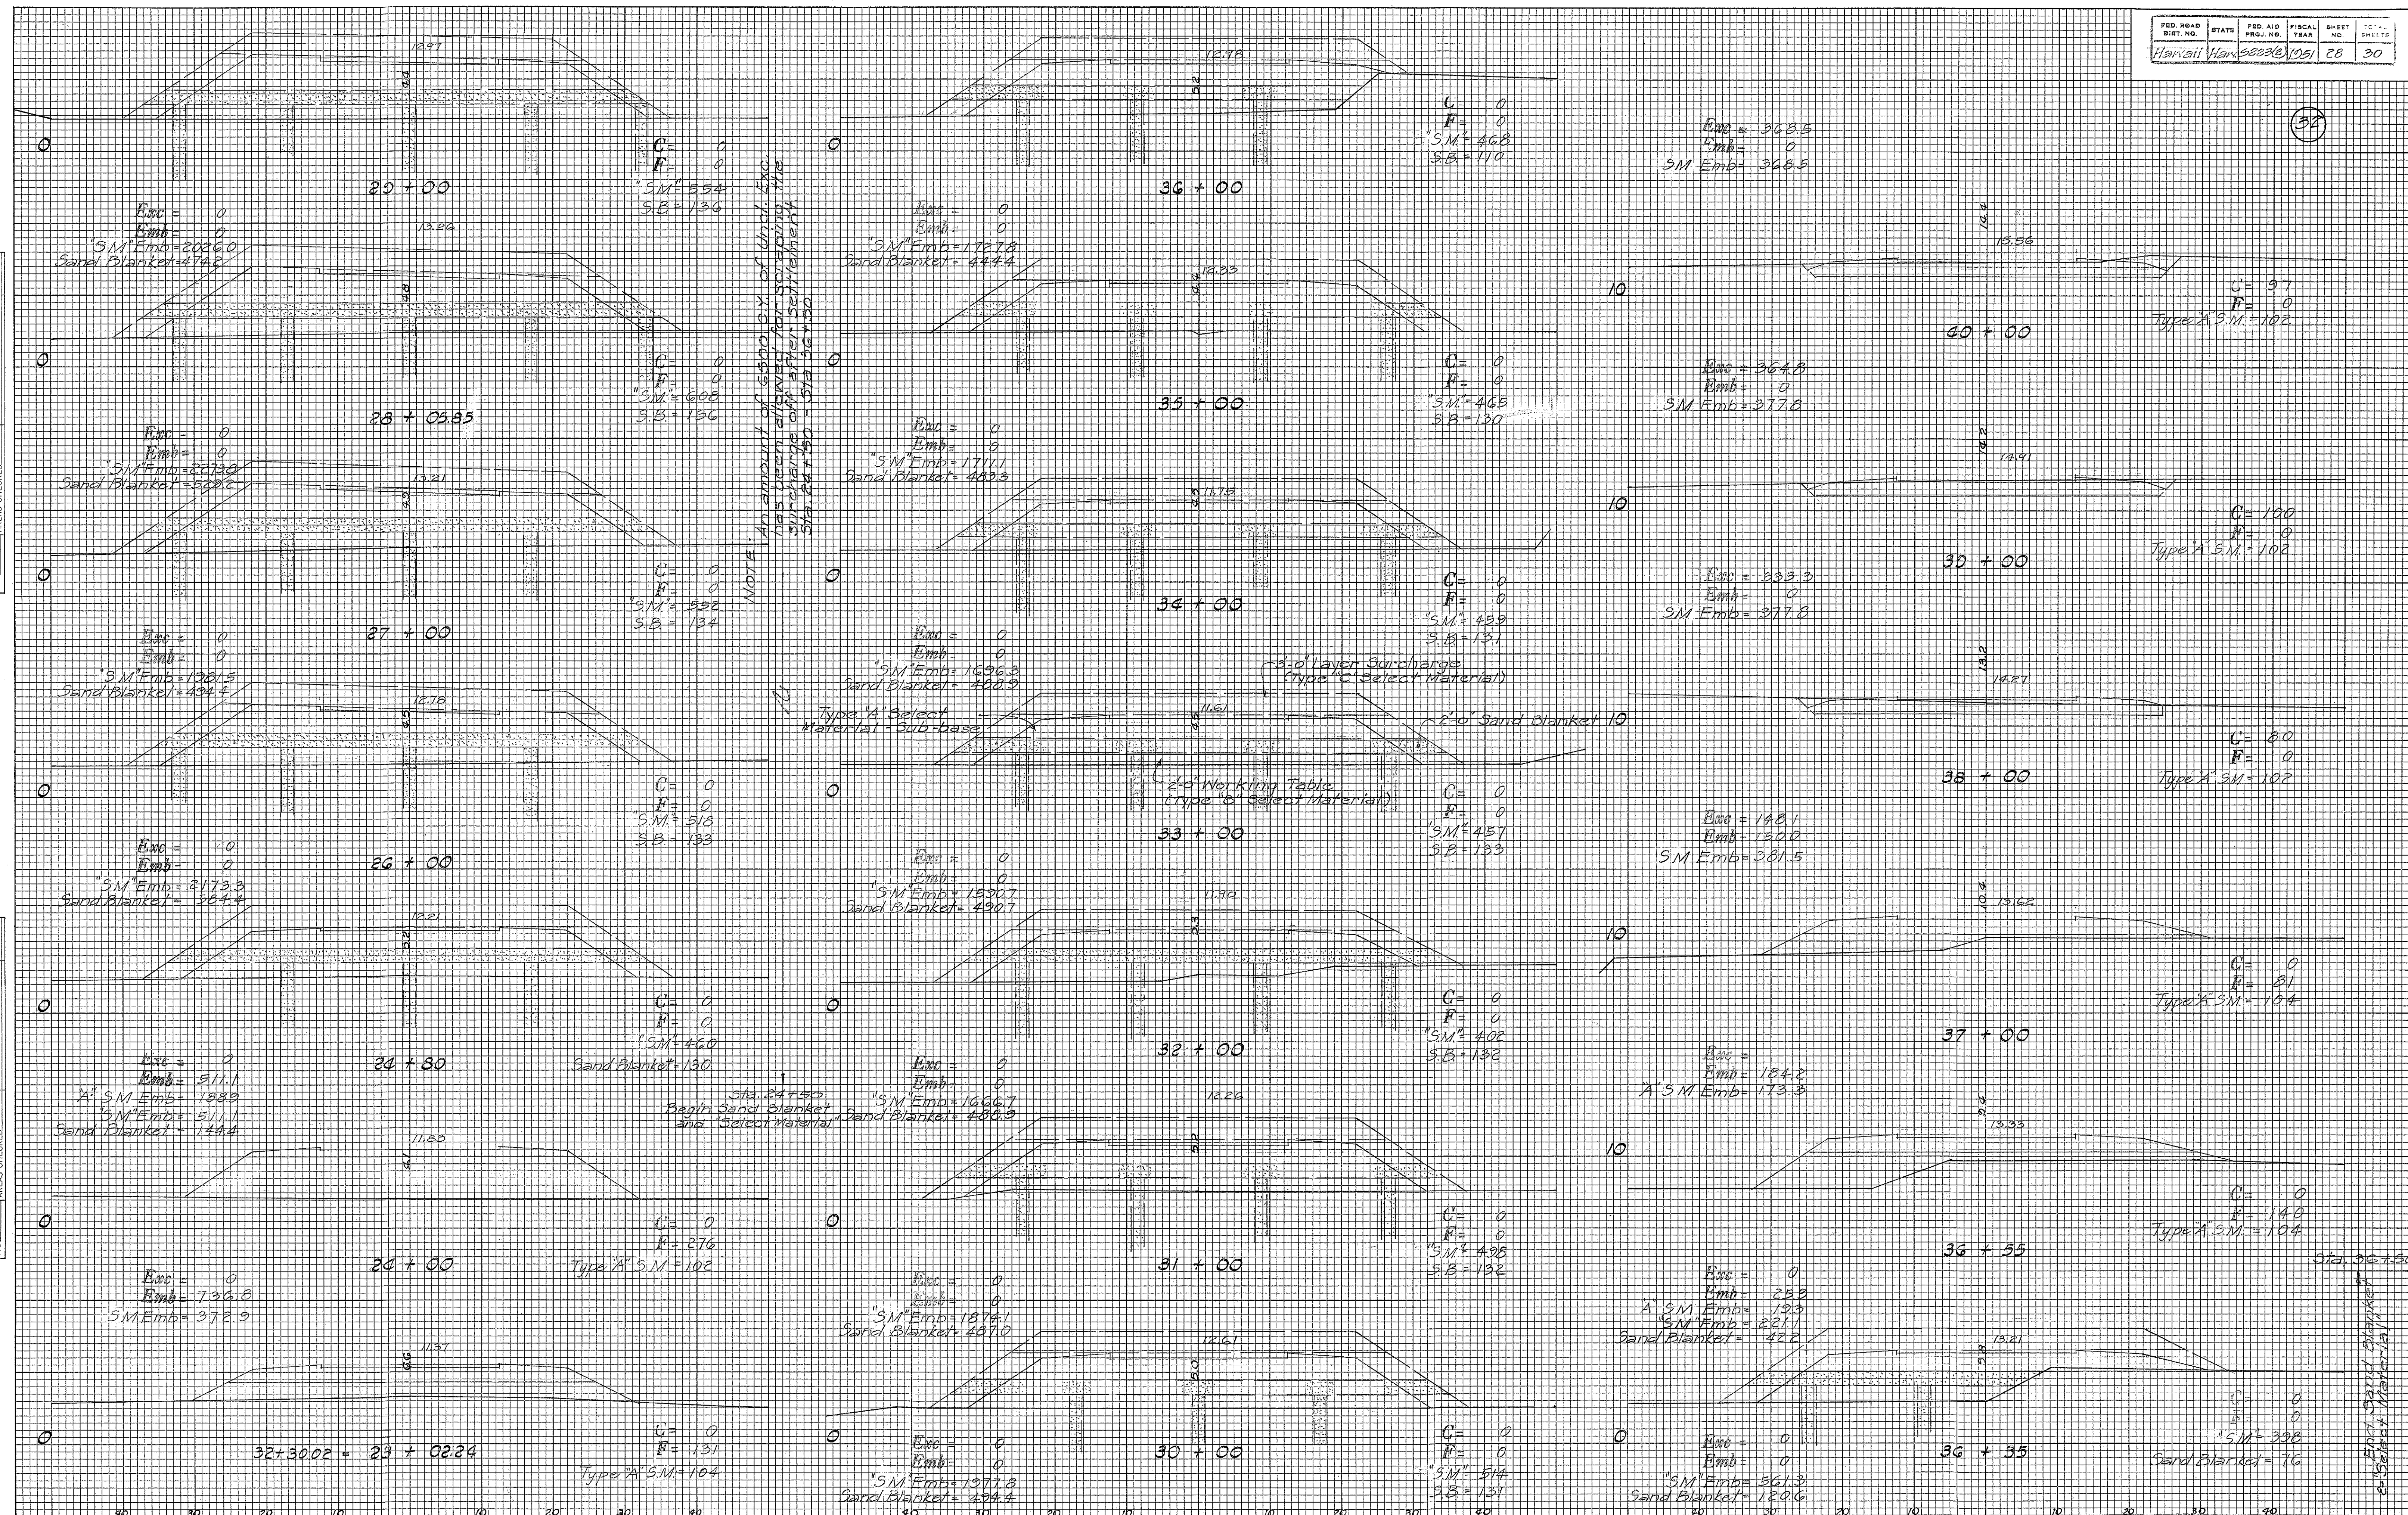

DATE	BY	NO.
FINAL SURVEY		
NOTE BOOK		
NO.		


DATE	BY	NO.
ORIGINAL SURVEY		
NOTE BOOK		
NO.		

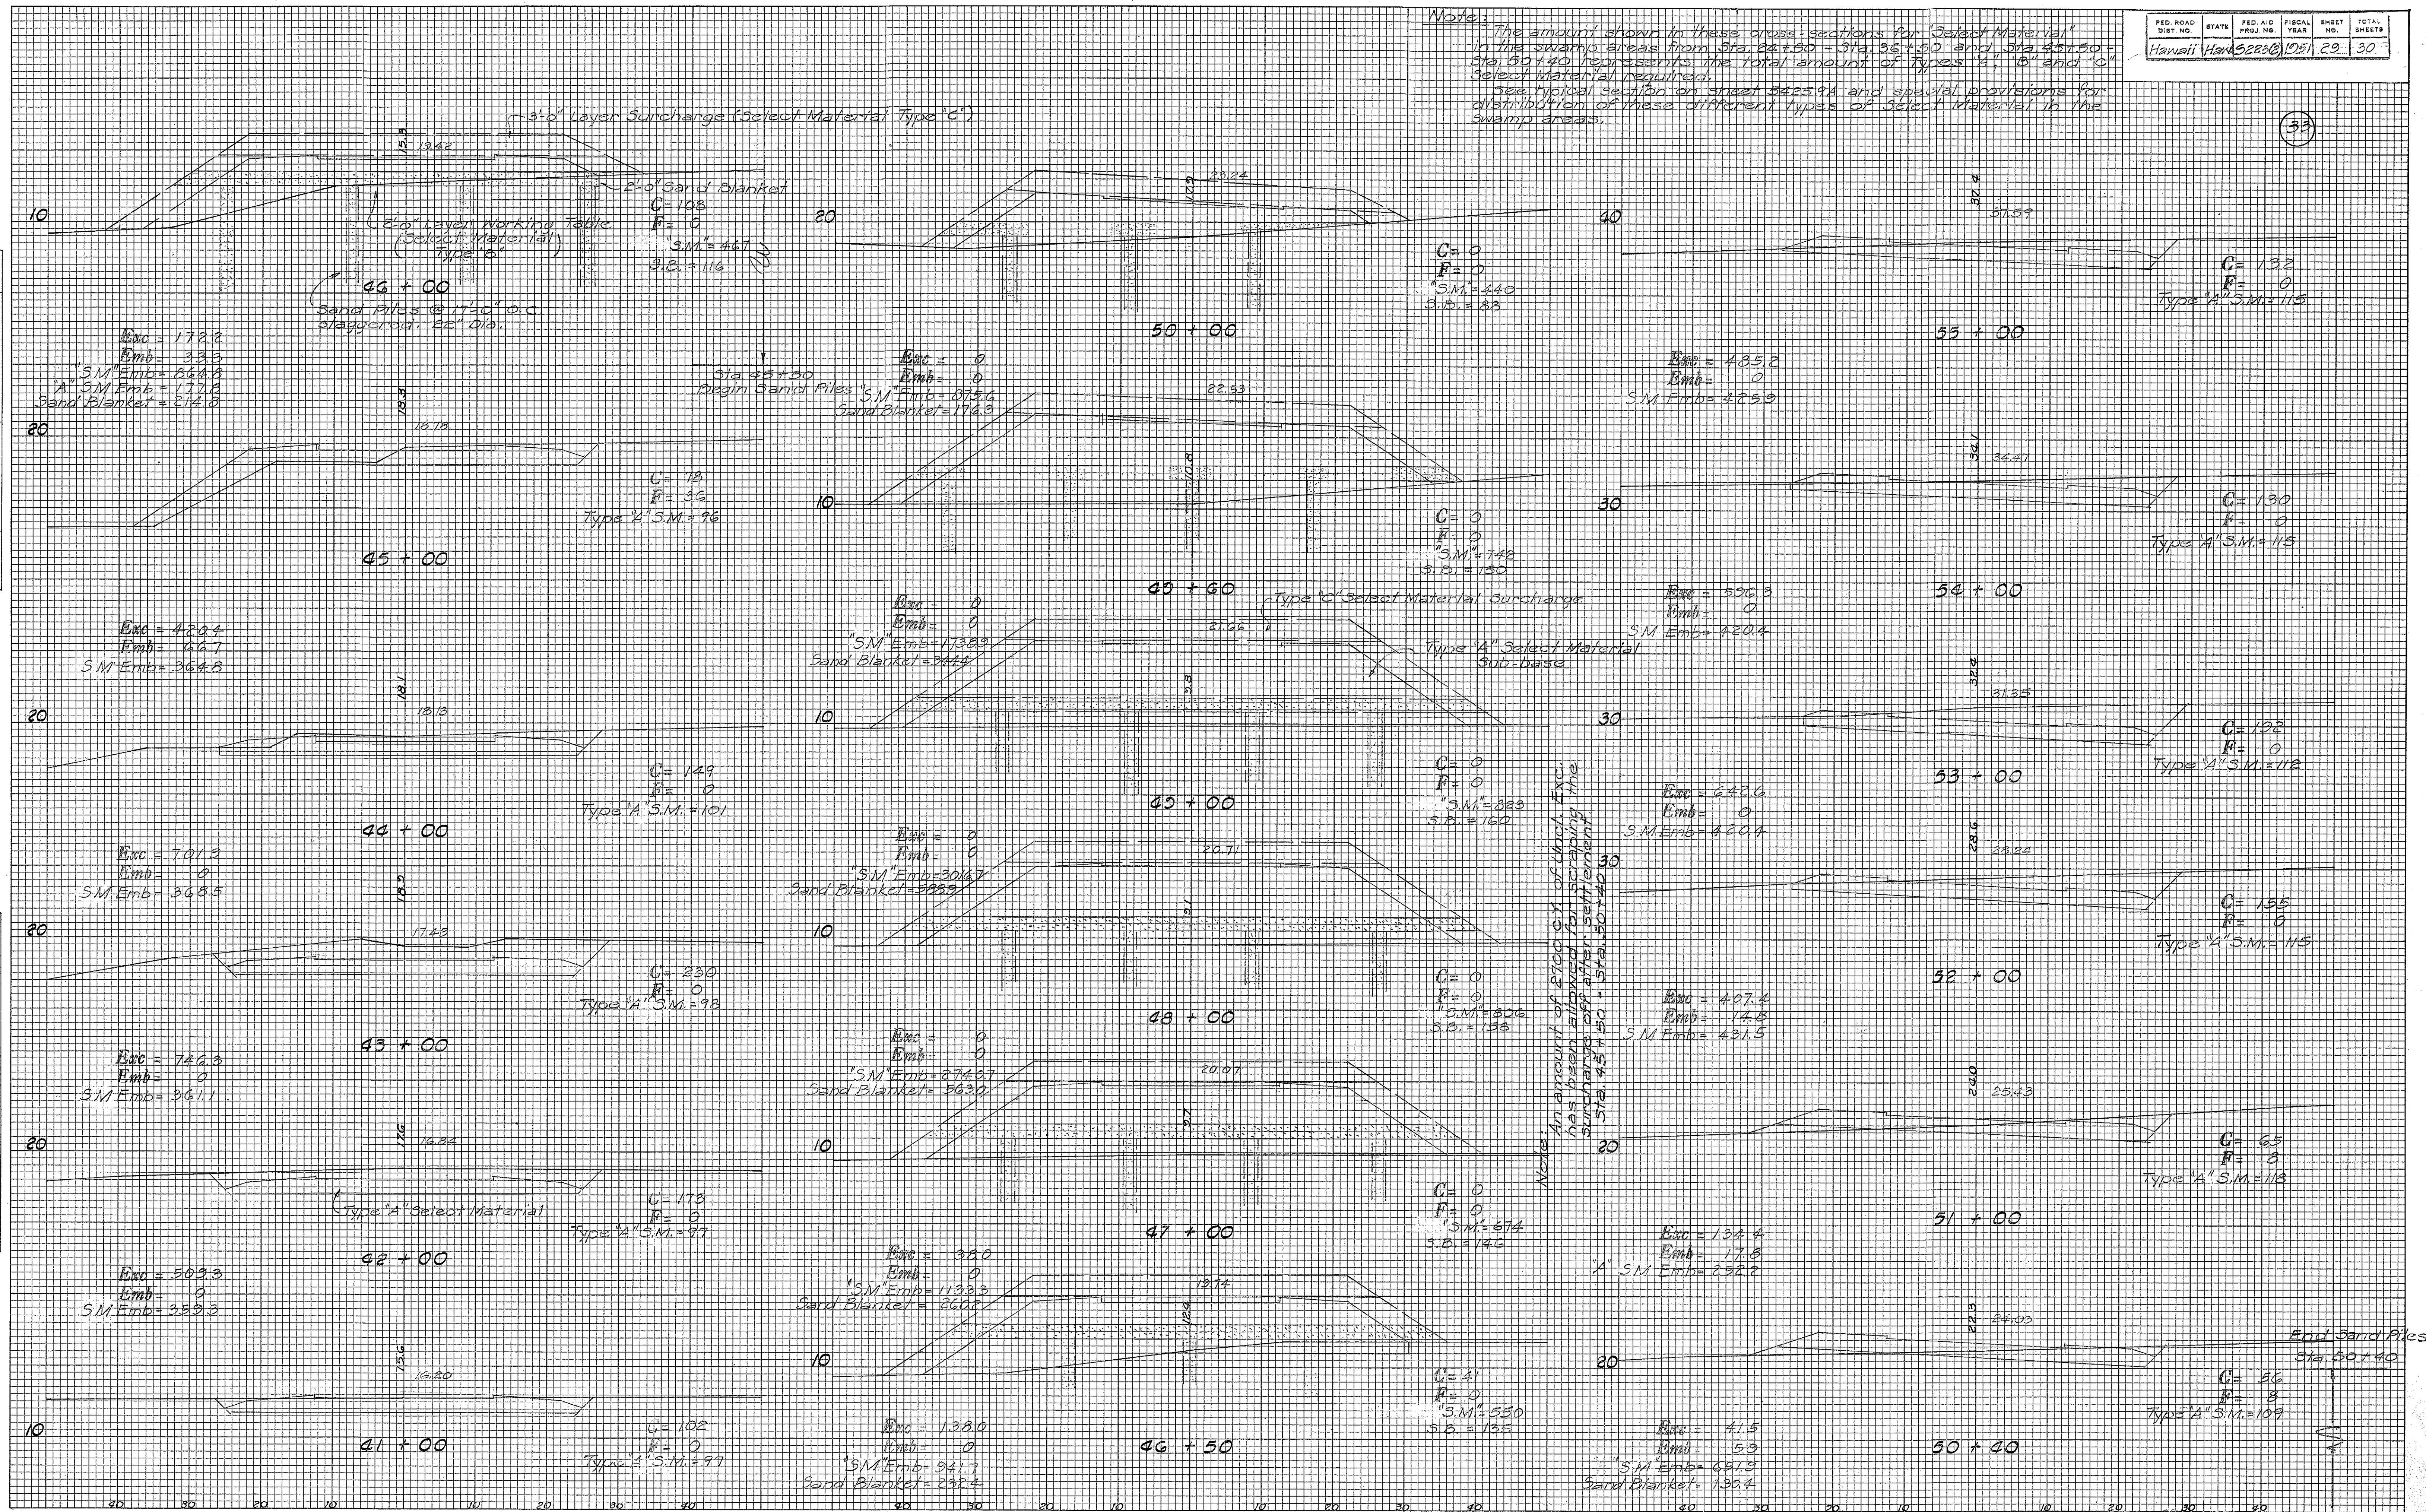

32

FINAL SURVEY	SURVEYED	BY	DATE
NOTE BOOK	PLOTTED		
NO.	TEMP.		
	AREAS CHECKED		

ORIGINAL SURVEY	SURVEYED	BY	DATE
NOTE BOOK	PLOTTED		
NO.	TEMP.		
	AREAS CHECKED		

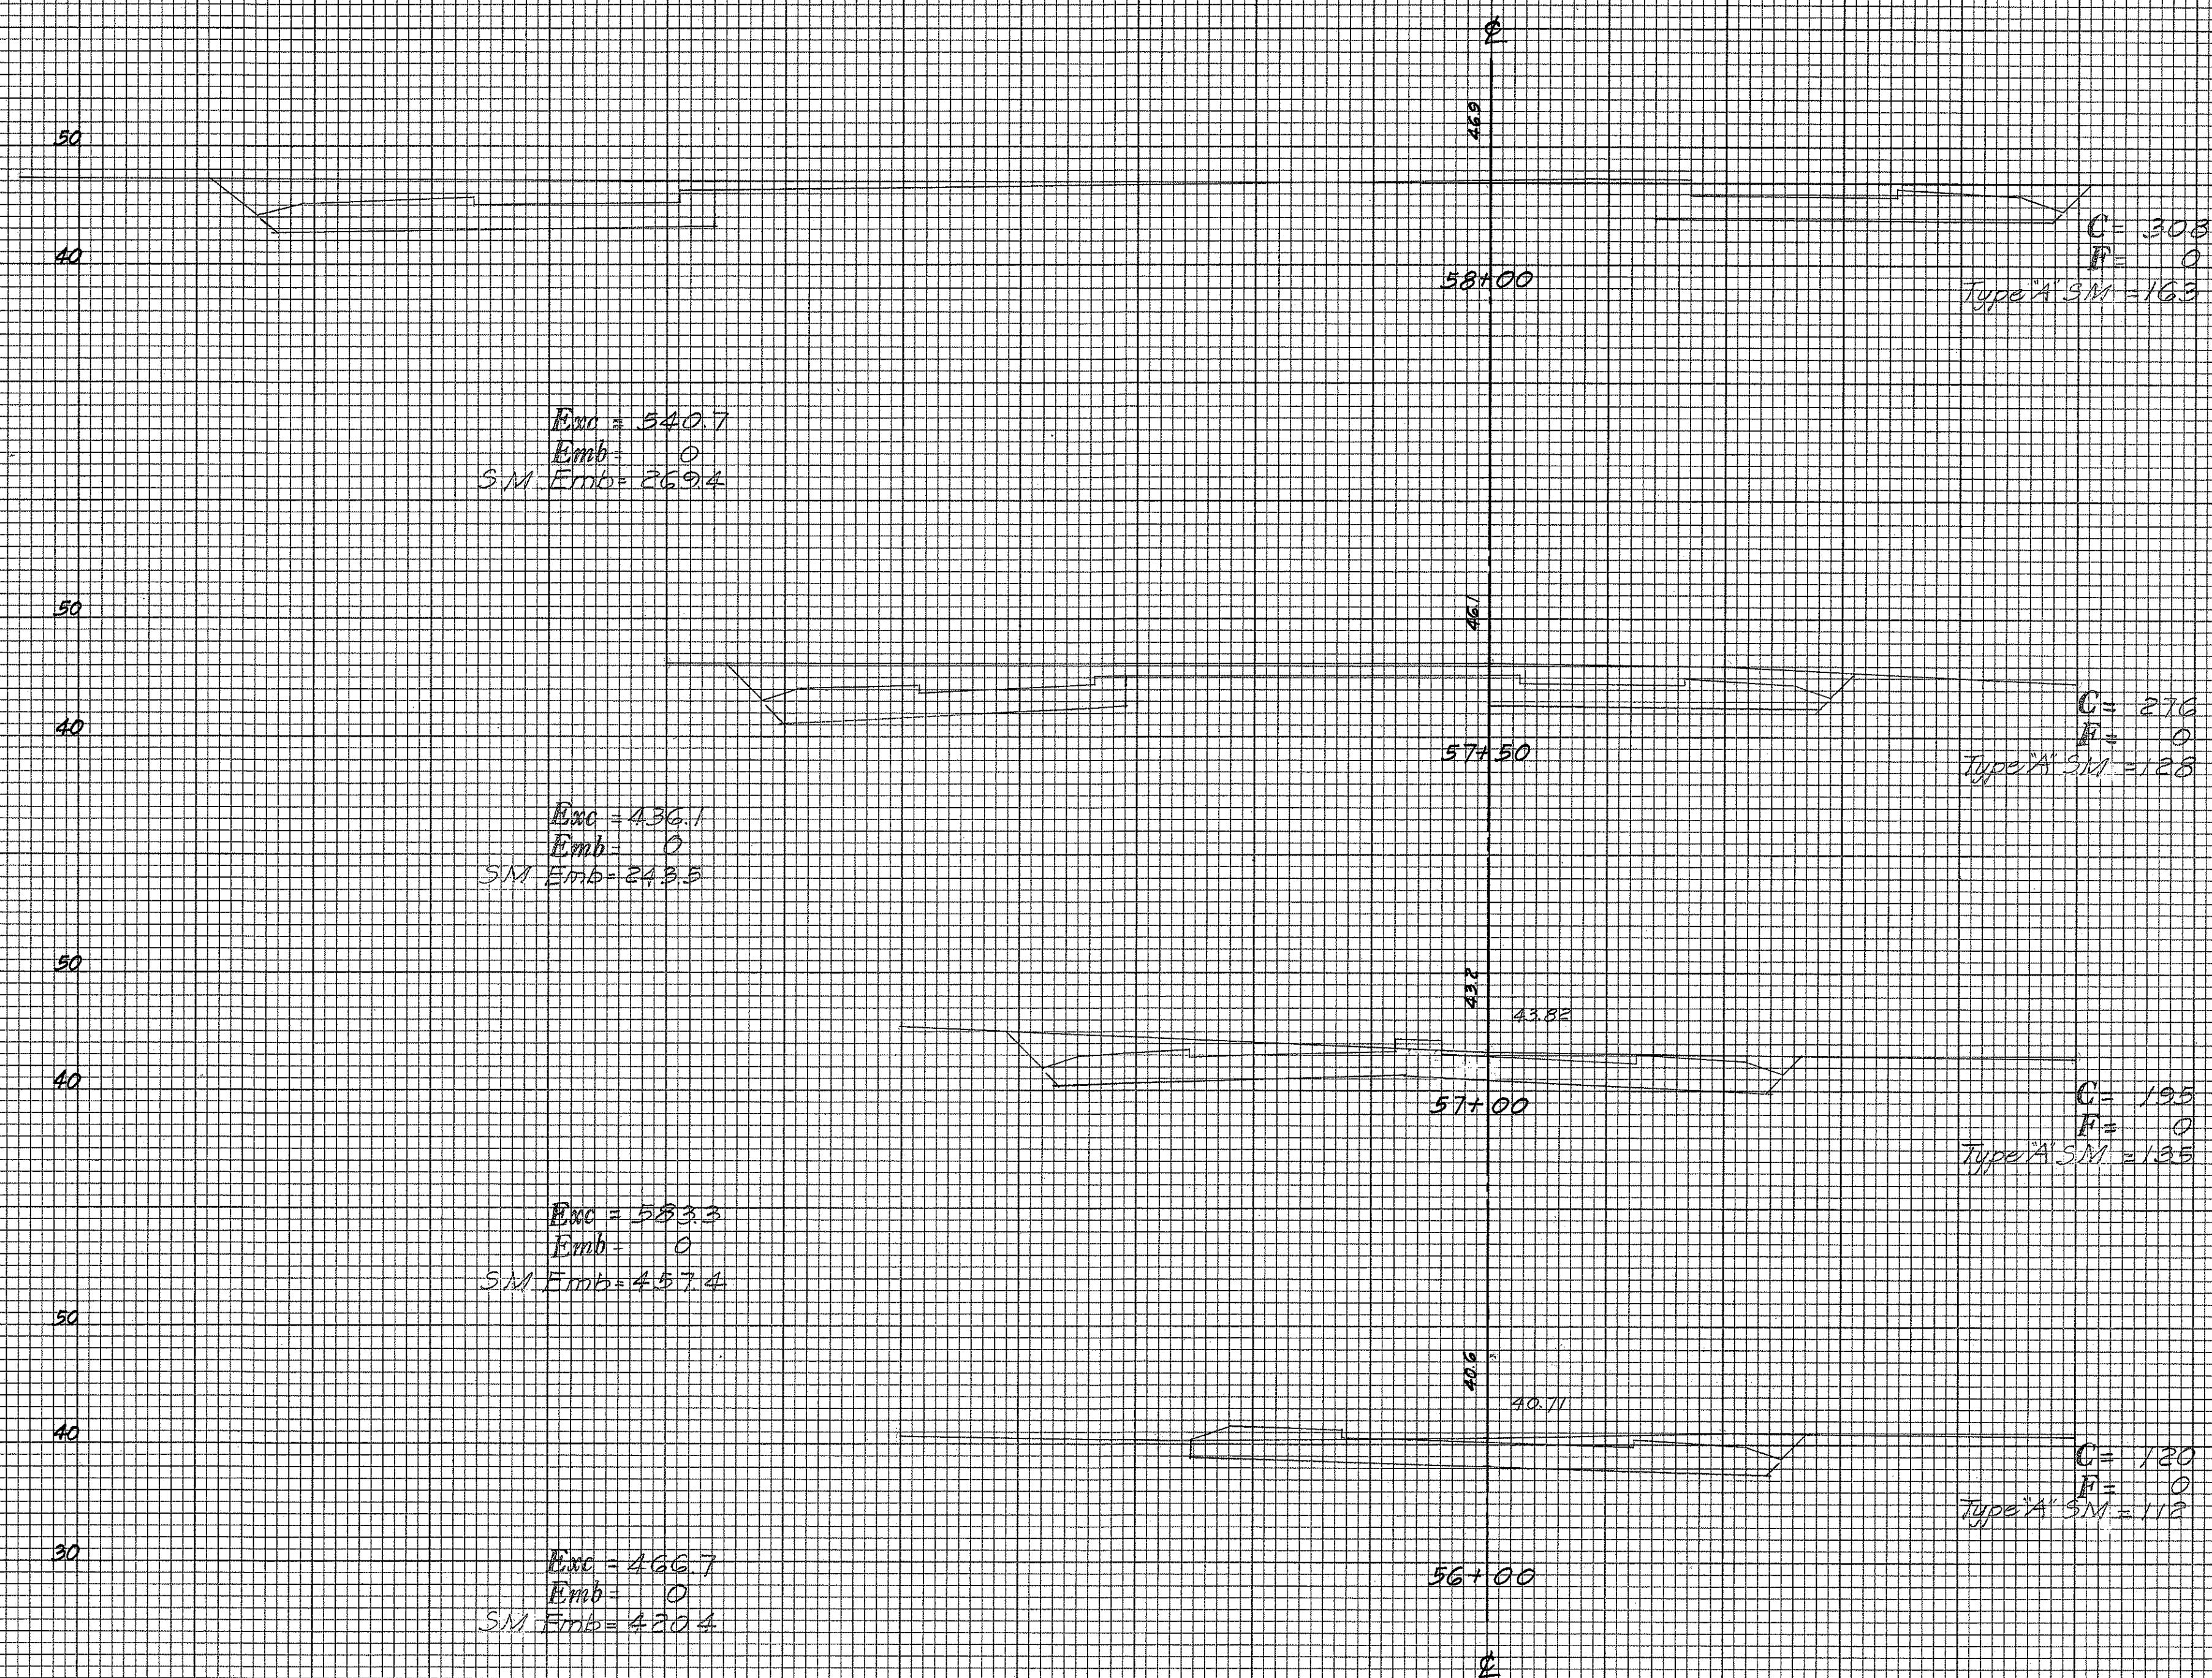

5425.30