



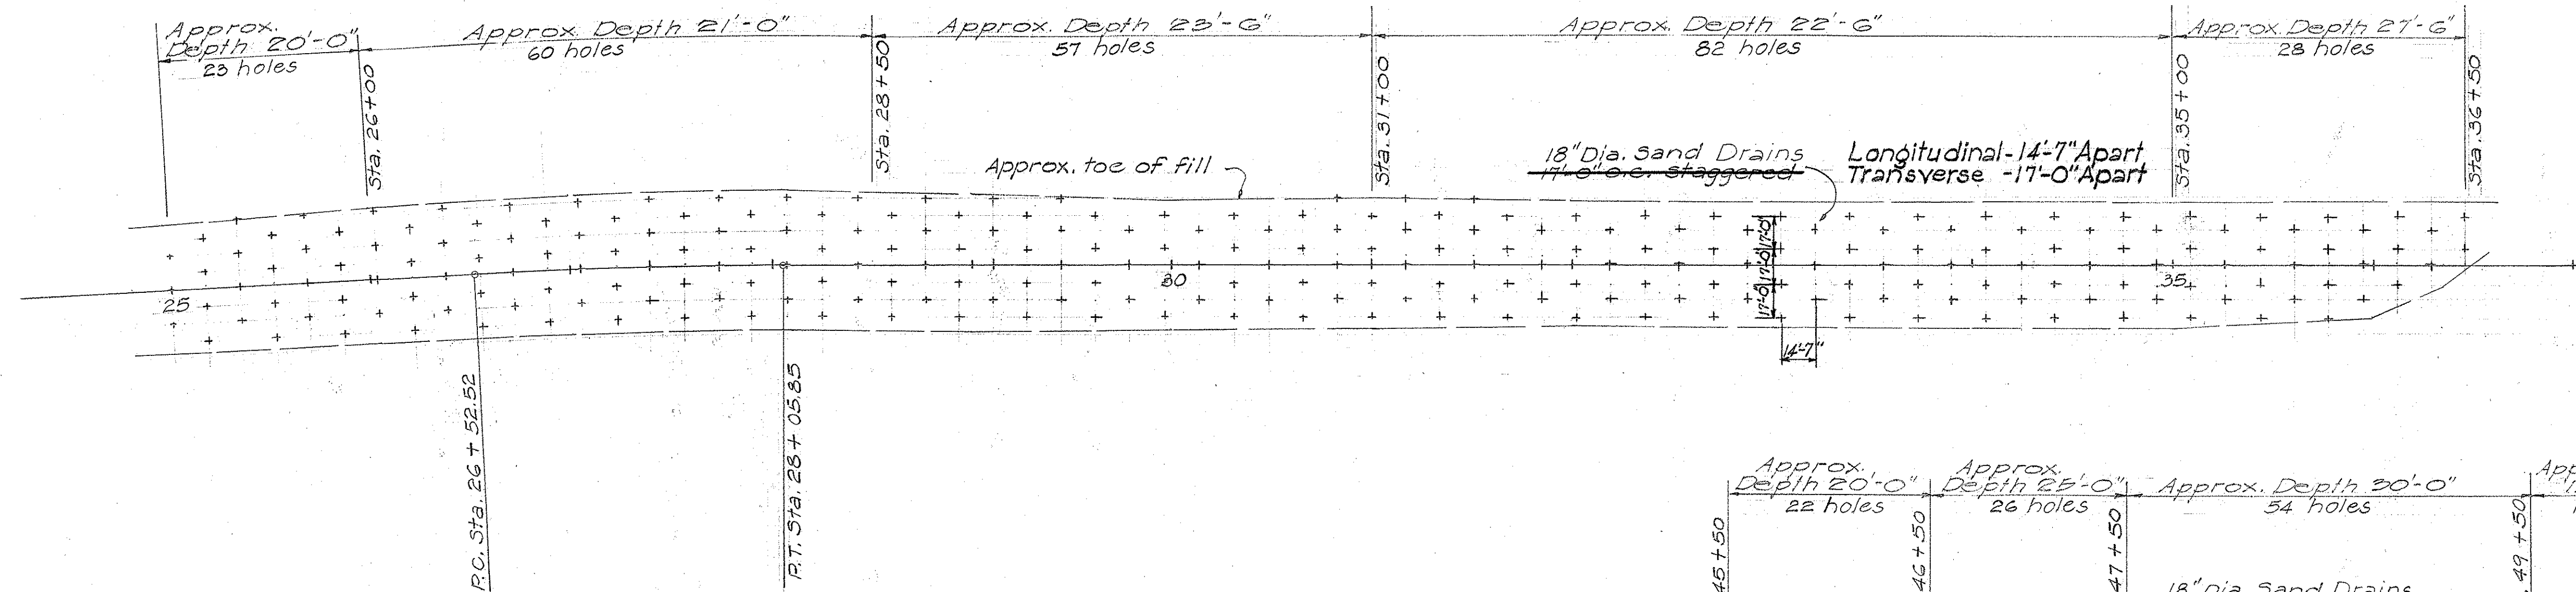


Note:
See Special Provisions and Cross Section sheets for details of Sand Drains and Sand Blanket in Swamp Area.


LAYOUT OF SAND DRAINS IN SWAMP AREA
STA. 24+50 - STA. 36+50
STA. 45+50 - STA. 50+40
1" = 50'-0"

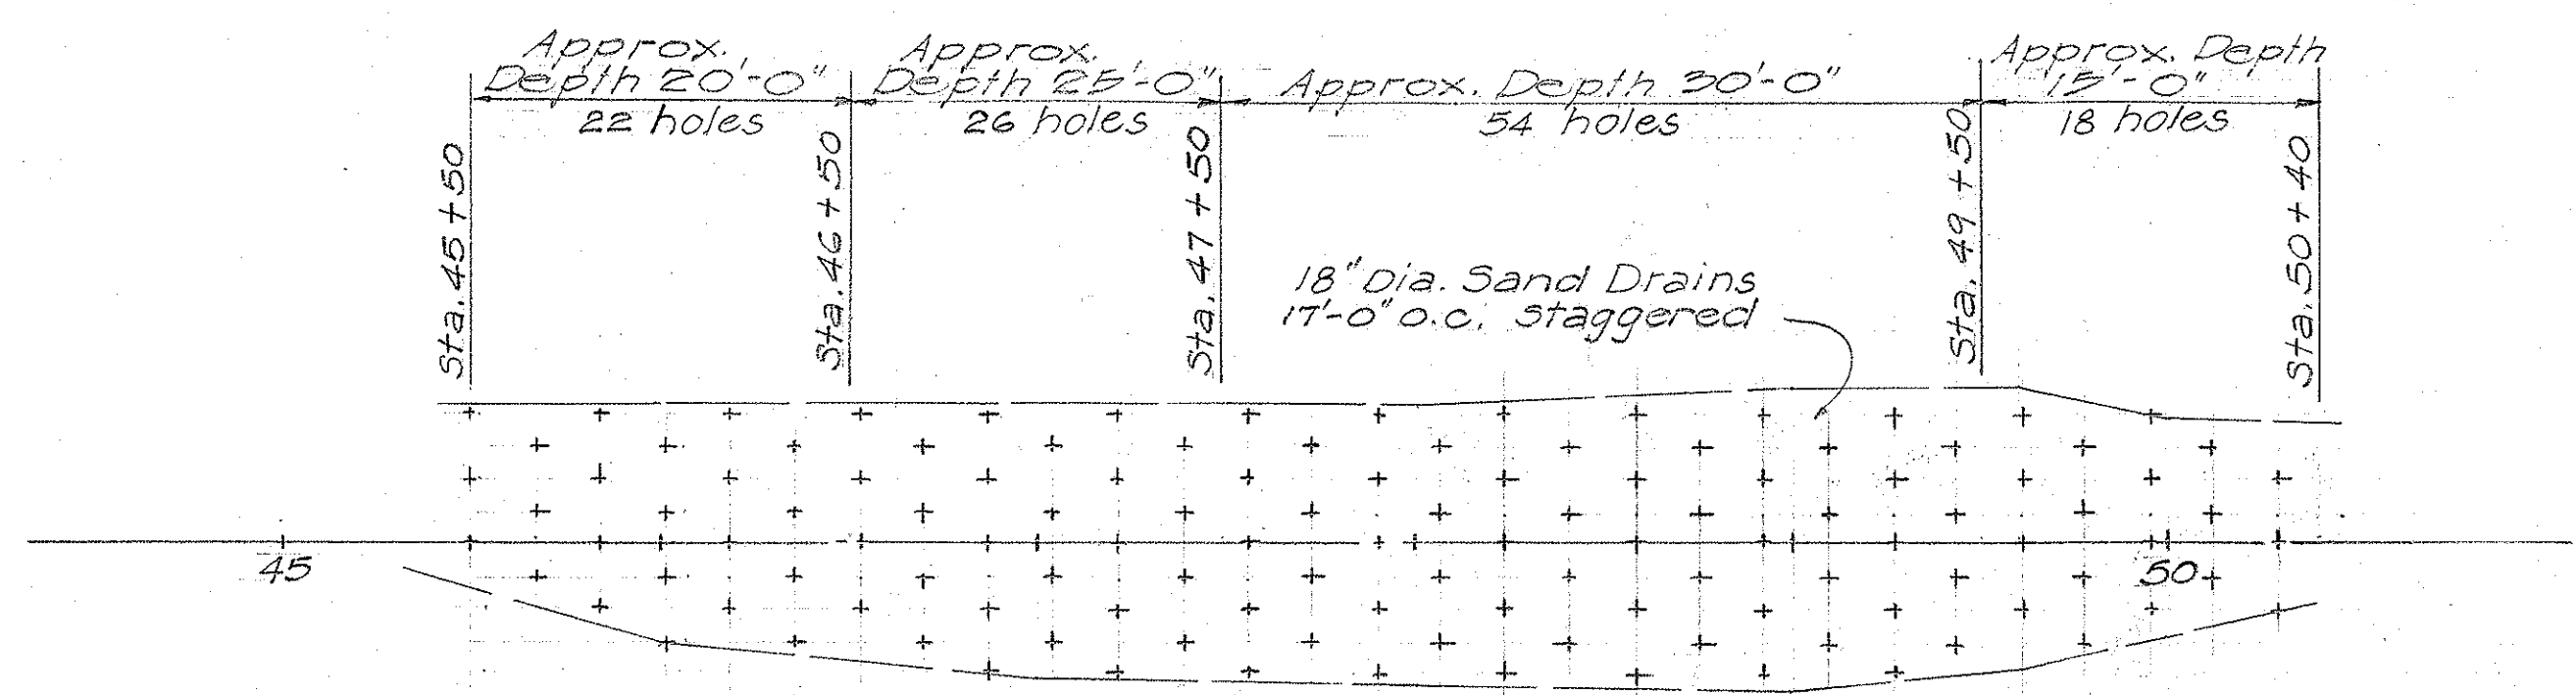

NOTE:
Surcharge to remain in place for period of at least ninety days. Removal and disposal of surcharge material will be measured and paid for as roadway excavation and overhaul.

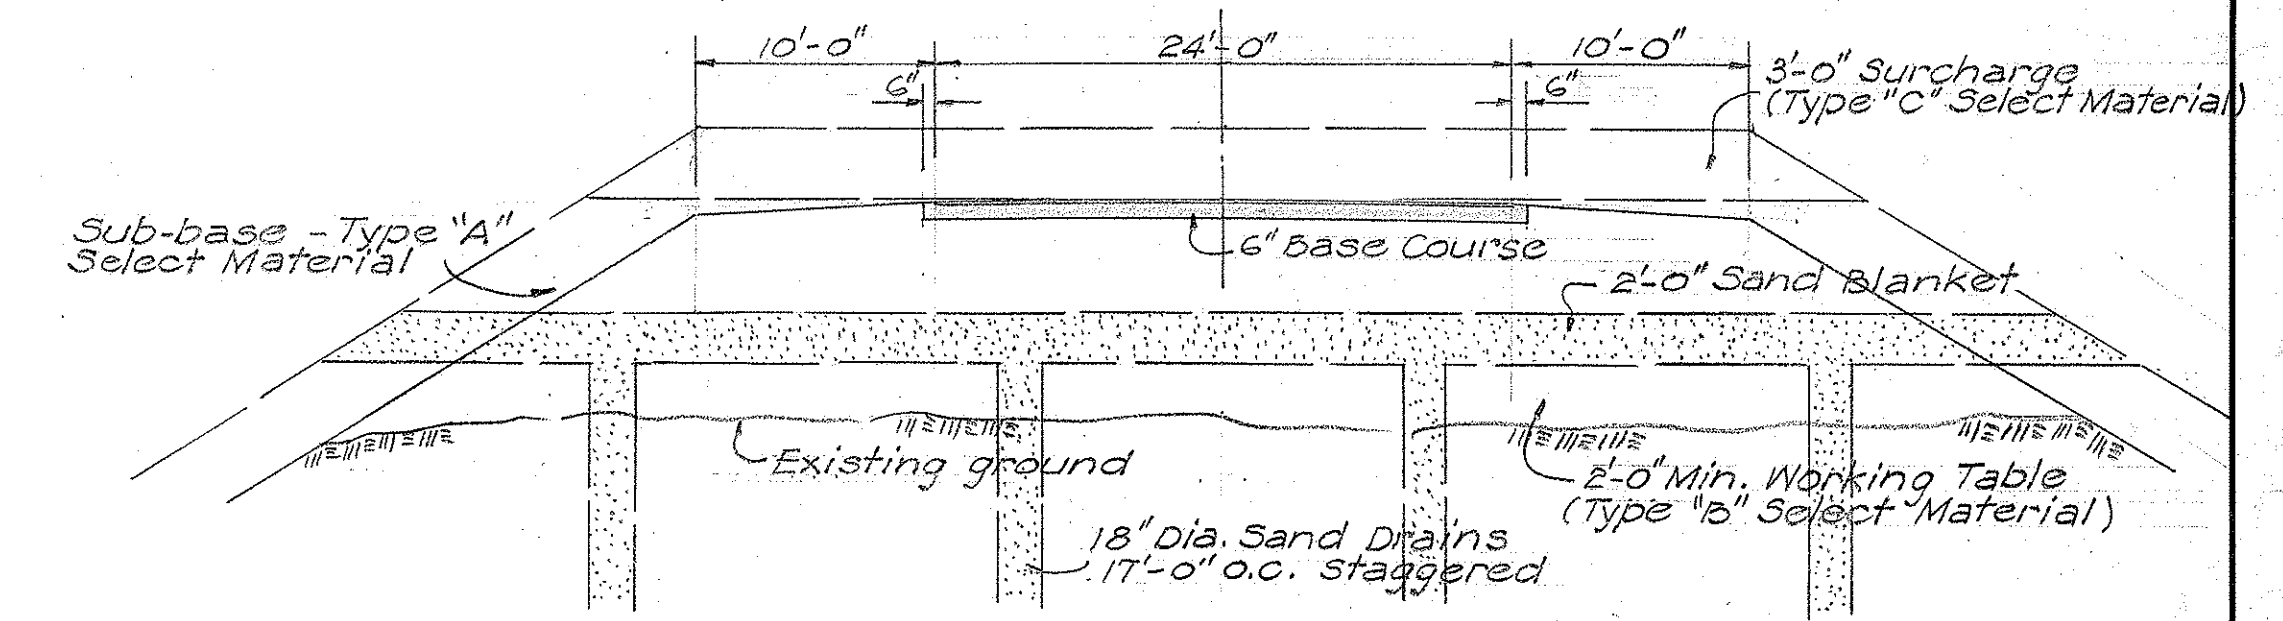

TYPICAL SECTION IN SWAMP AREA SHOWING VERTICAL SAND DRAINS
Scale: 1/8" = 1'-0"

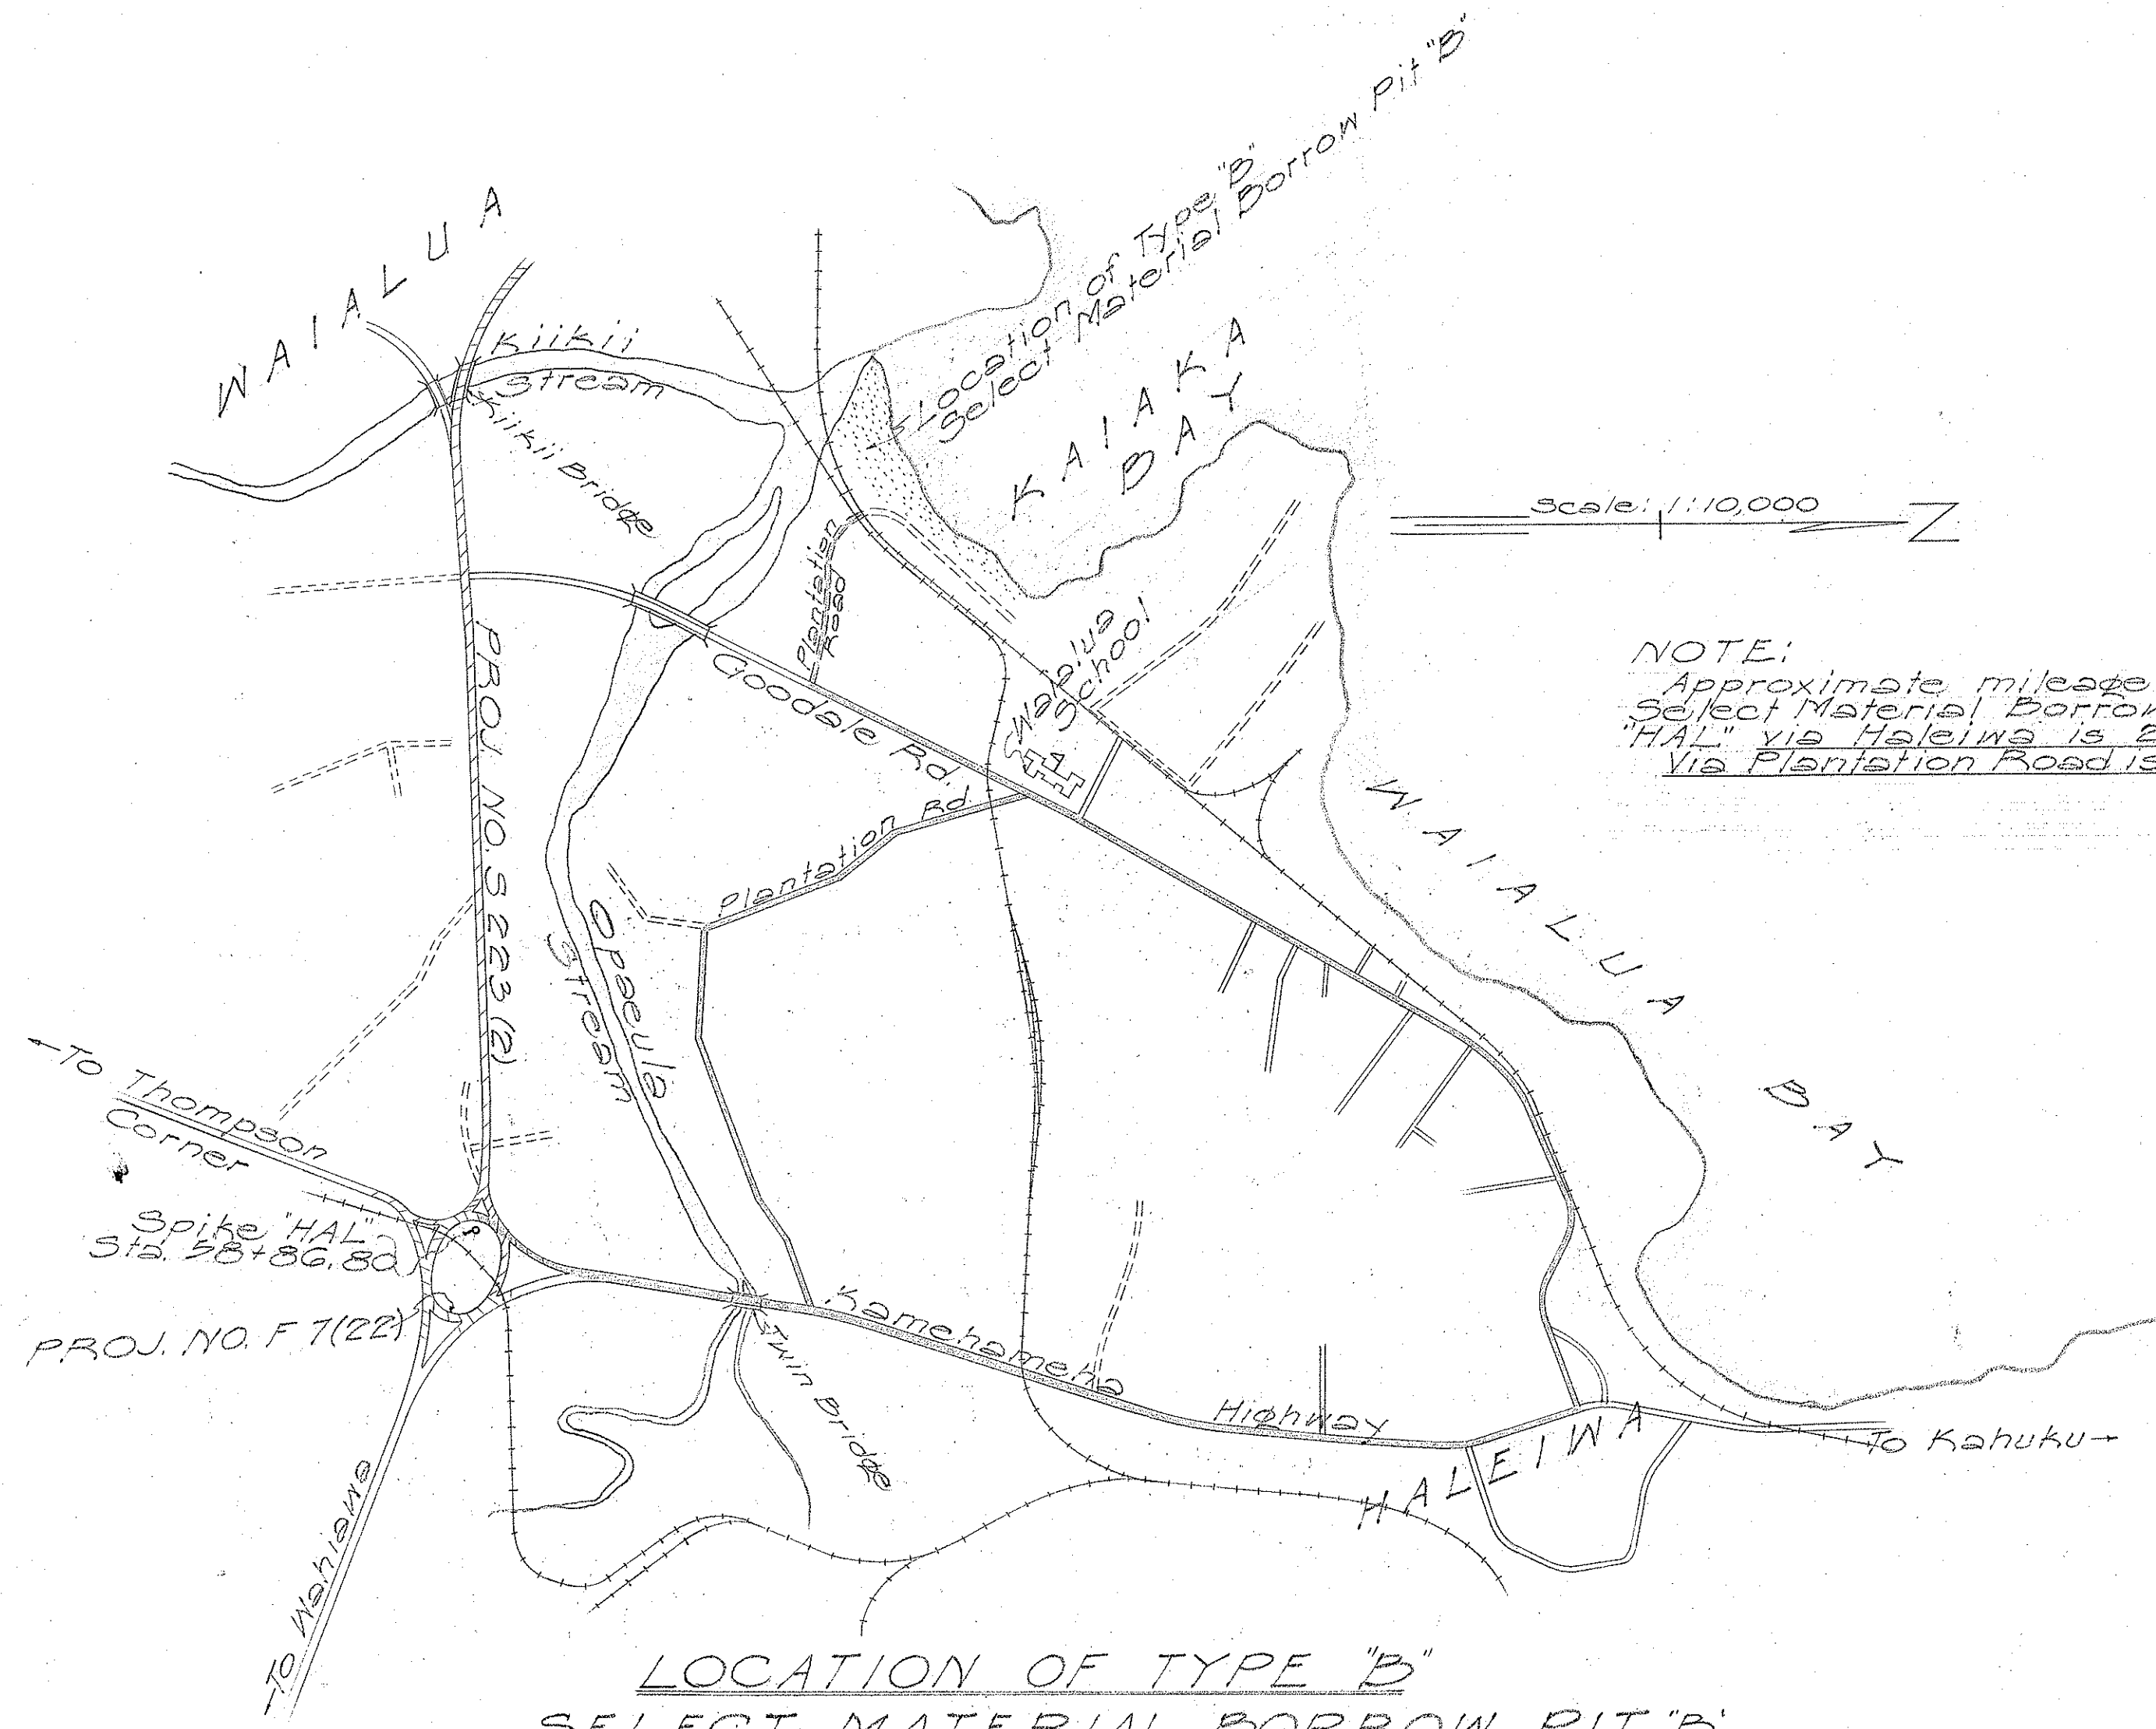

NOTE:
Approximate mileage from Type 'B' Select Material Borrow Pit 'B' to spike 'HAL' via Haleiwa is 2.75 miles.
Via Plantation Road is 1.65 miles.

LOCATION OF TYPE 'B' SELECT MATERIAL BORROW PIT 'B'

TERRITORIAL HIGHWAY DEPARTMENT
TERRITORY OF HAWAII
LAYOUT OF SAND DRAINS
TYPICAL SECTION IN SWAMP AREA SHOWING VERTICAL SAND DRAINS
LOCATION OF TYPE 'B' SELECT MATERIAL BORROW PIT
Scales: As Noted Jan. 1951

ORIGINAL PLAN
DESIGNED BY
NOTED BY
CHECKED BY
DATE