





NOTE:
All Warning, Regulatory and Destination Signs, F.A. Markers and additional Numbers Plates for F.A. Markers will be furnished and installed by the Territorial Highway Department.

DATE	BY	PLAN
		NO. 1
		NO. 2
		NO. 3
		NO. 4
		NO. 5
		NO. 6
		NO. 7
		NO. 8
		NO. 9
		NO. 10
		NO. 11
		NO. 12
		NO. 13
		NO. 14
		NO. 15
		NO. 16
		NO. 17
		NO. 18
		NO. 19
		NO. 20
		NO. 21
		NO. 22
		NO. 23
		NO. 24
		NO. 25
		NO. 26
		NO. 27
		NO. 28
		NO. 29
		NO. 30

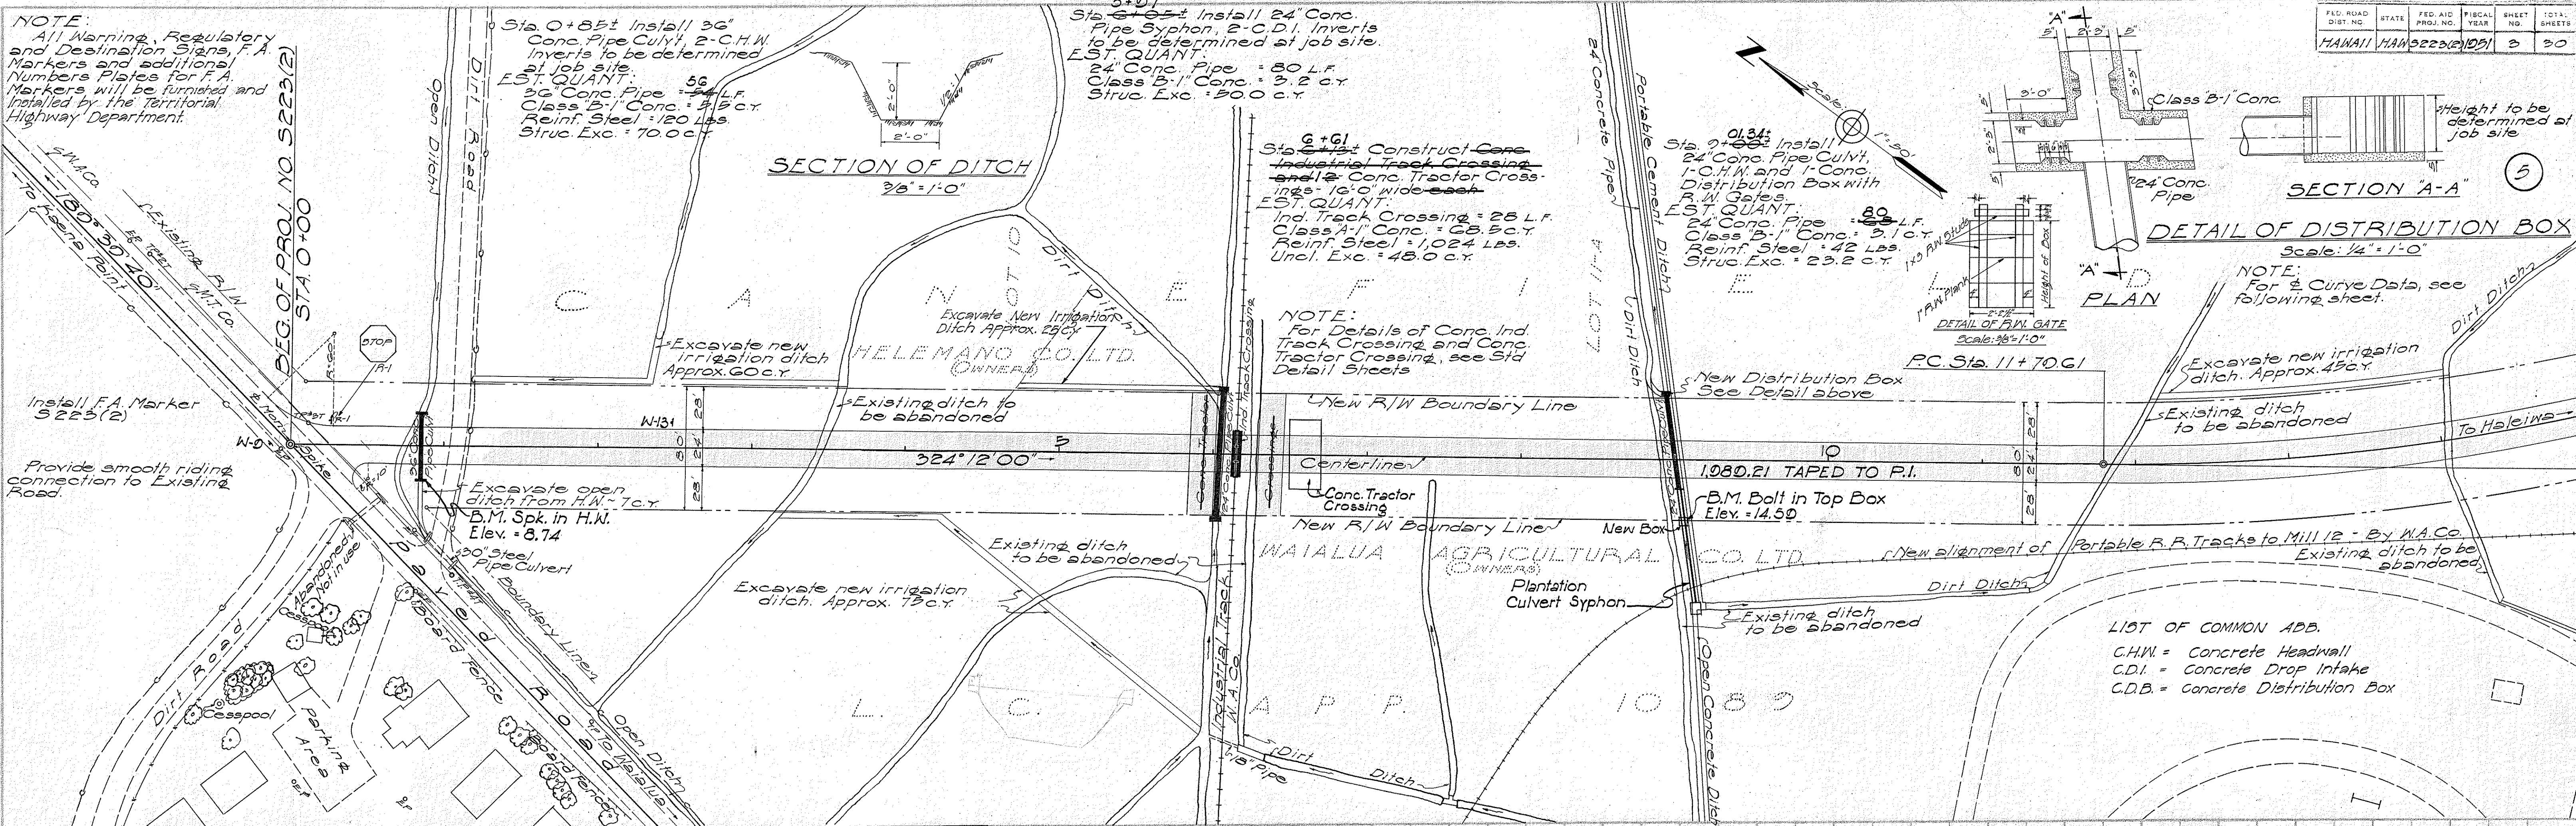



OVERHAUL SUMMARY					
FROM STA.	TO STA.	VOLUME CU. YD.	DISTANCE FEET	STA. YD.	MILE YD.
2+35	22+69	1,790	1,034		398
5+18	20+40	762	522	3,978	
F7(22) 2+77	23+70	830	3,625.13		587
54+70	26+90	4,288	2,707.78		2,144
42+51	32+09	3,380	973.78	220014	

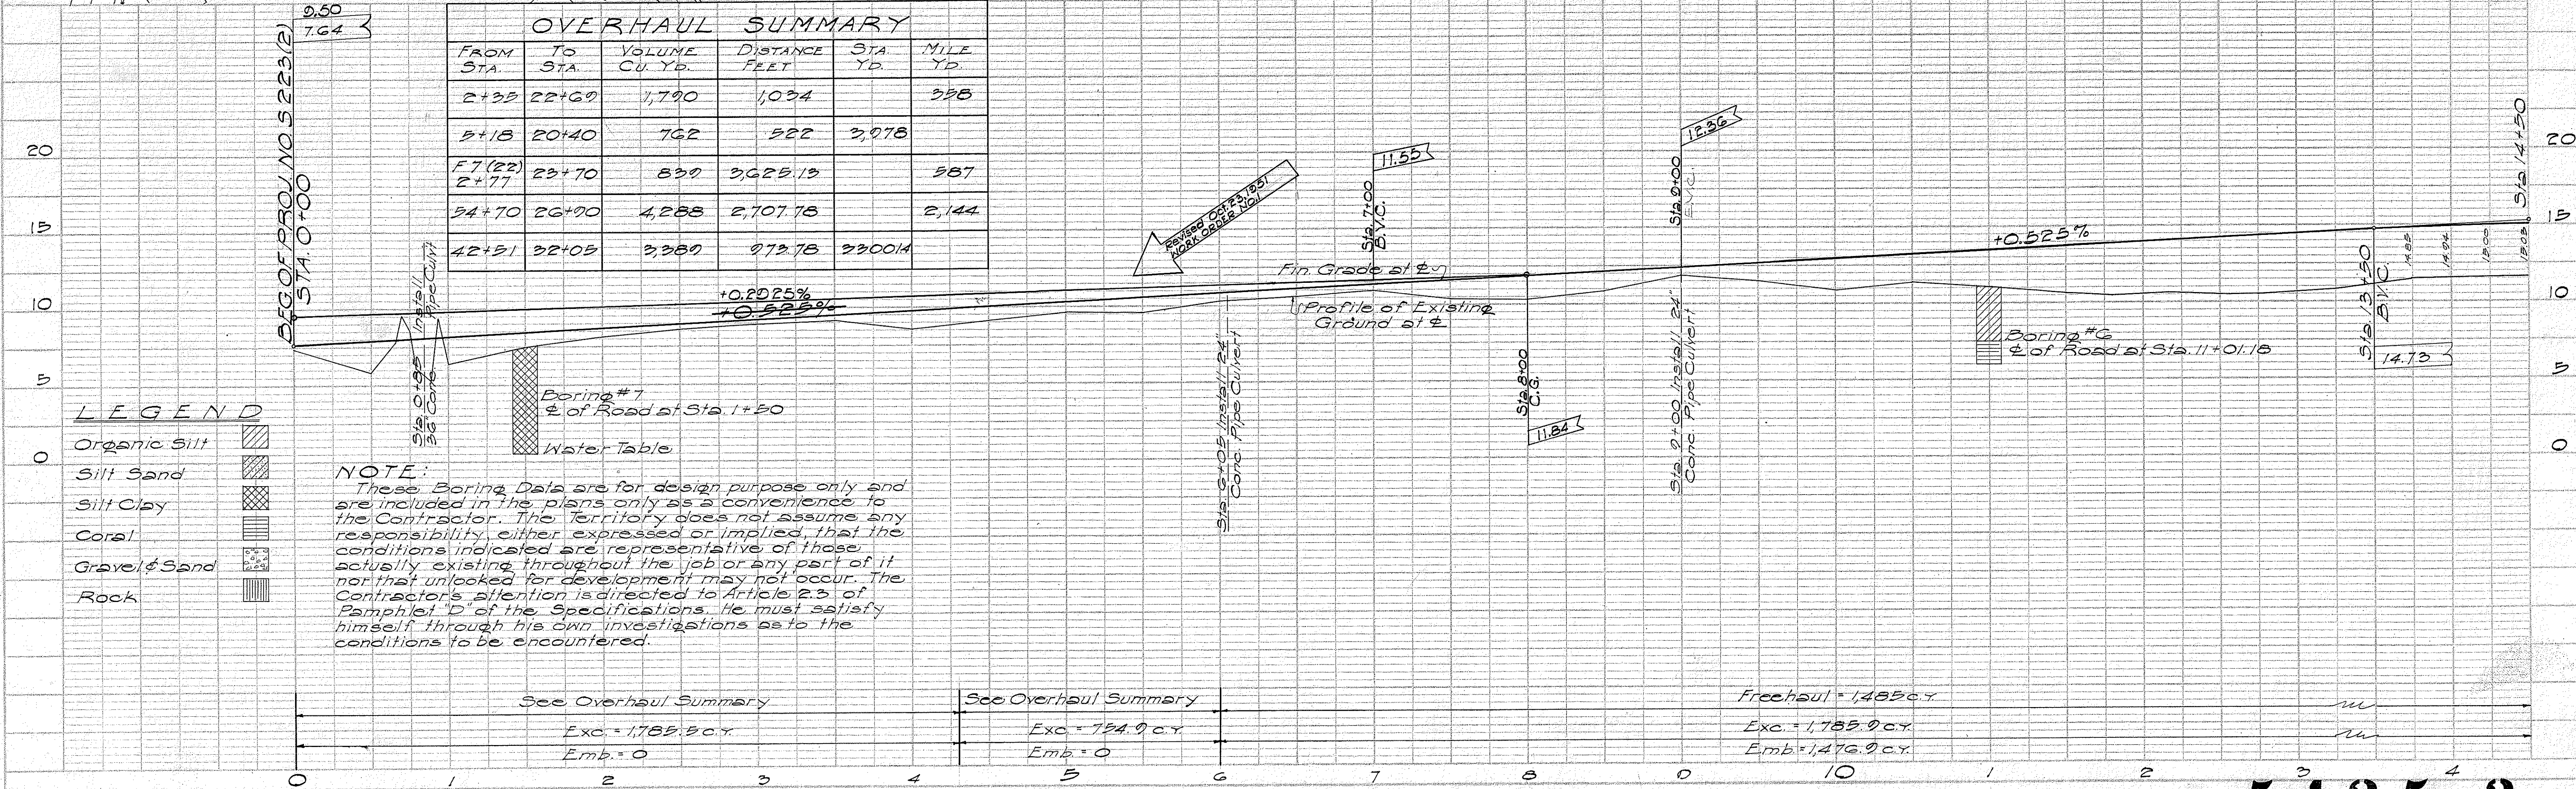


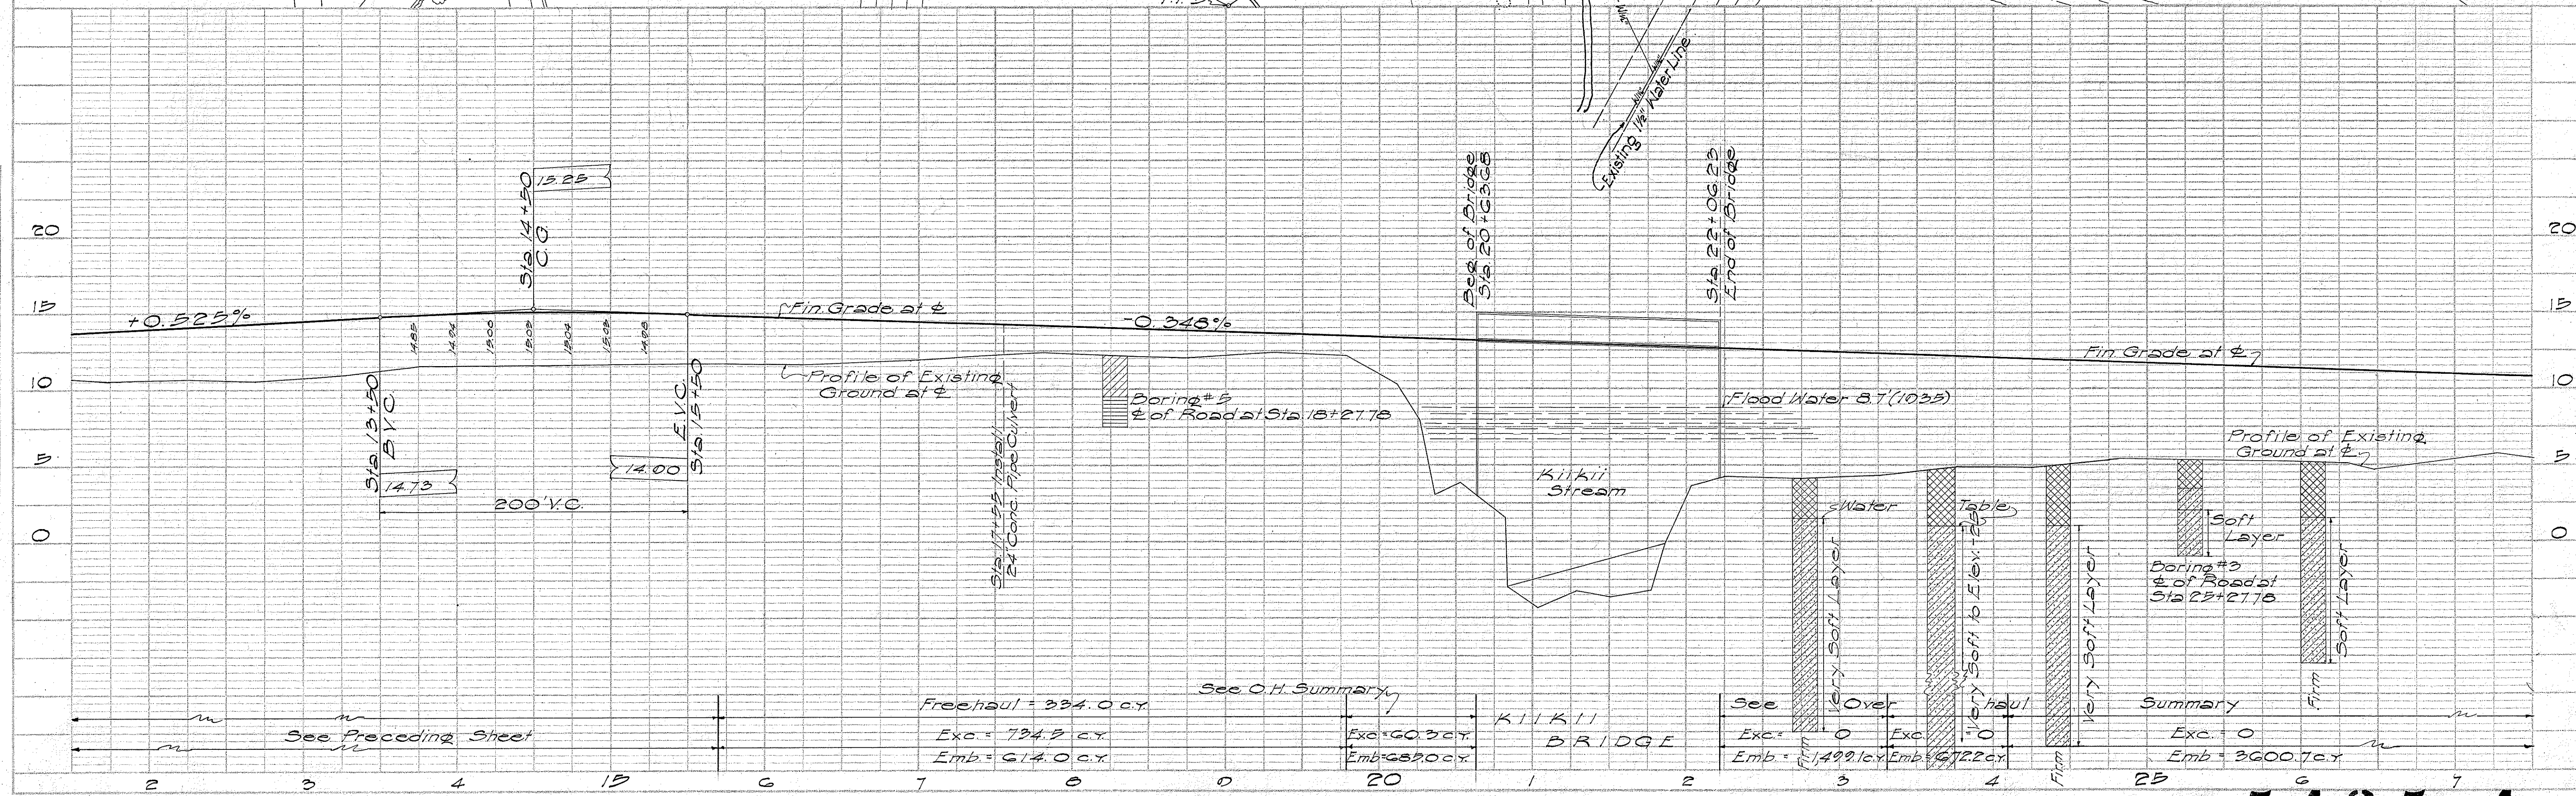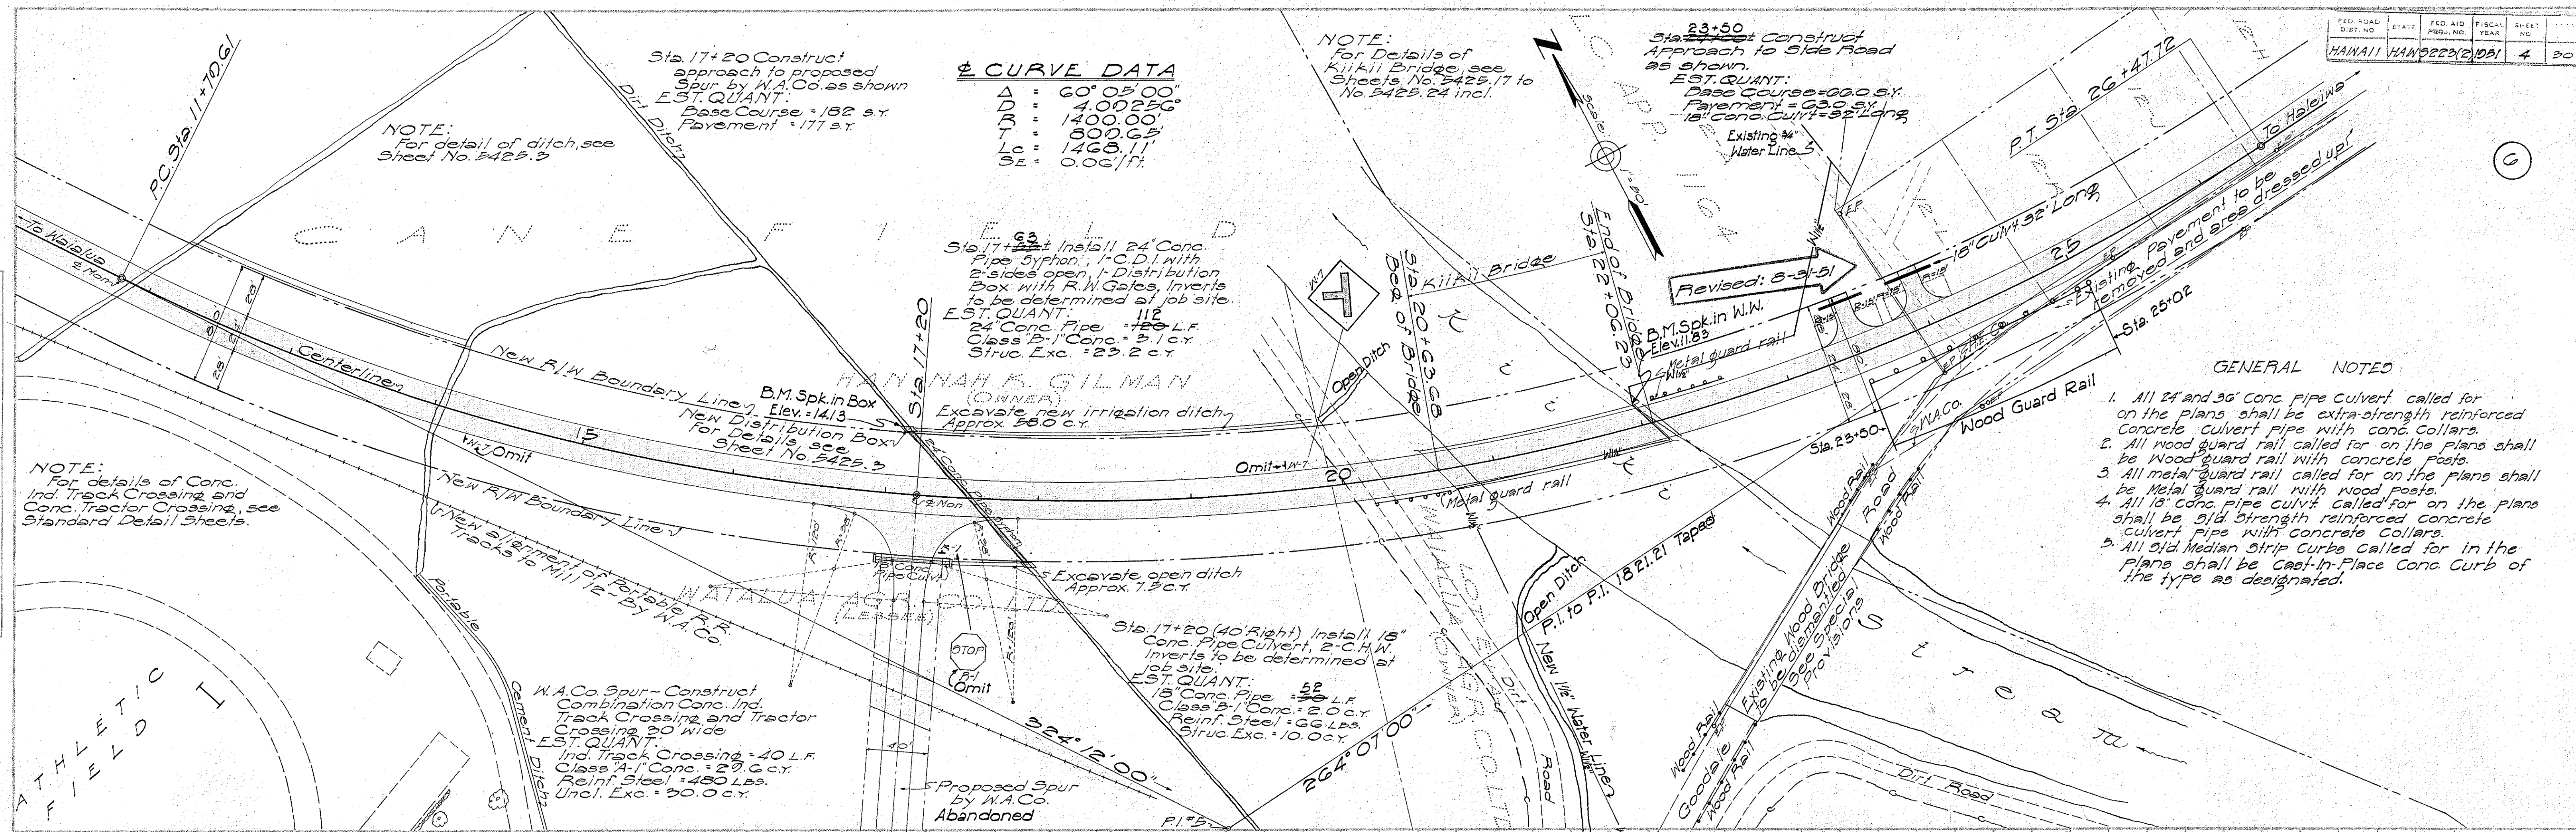

PLAN
DATE
BY
CHECKED
NOTED
NO.

PROFILE
DATE
BY
CHECKED
NOTED
NO.

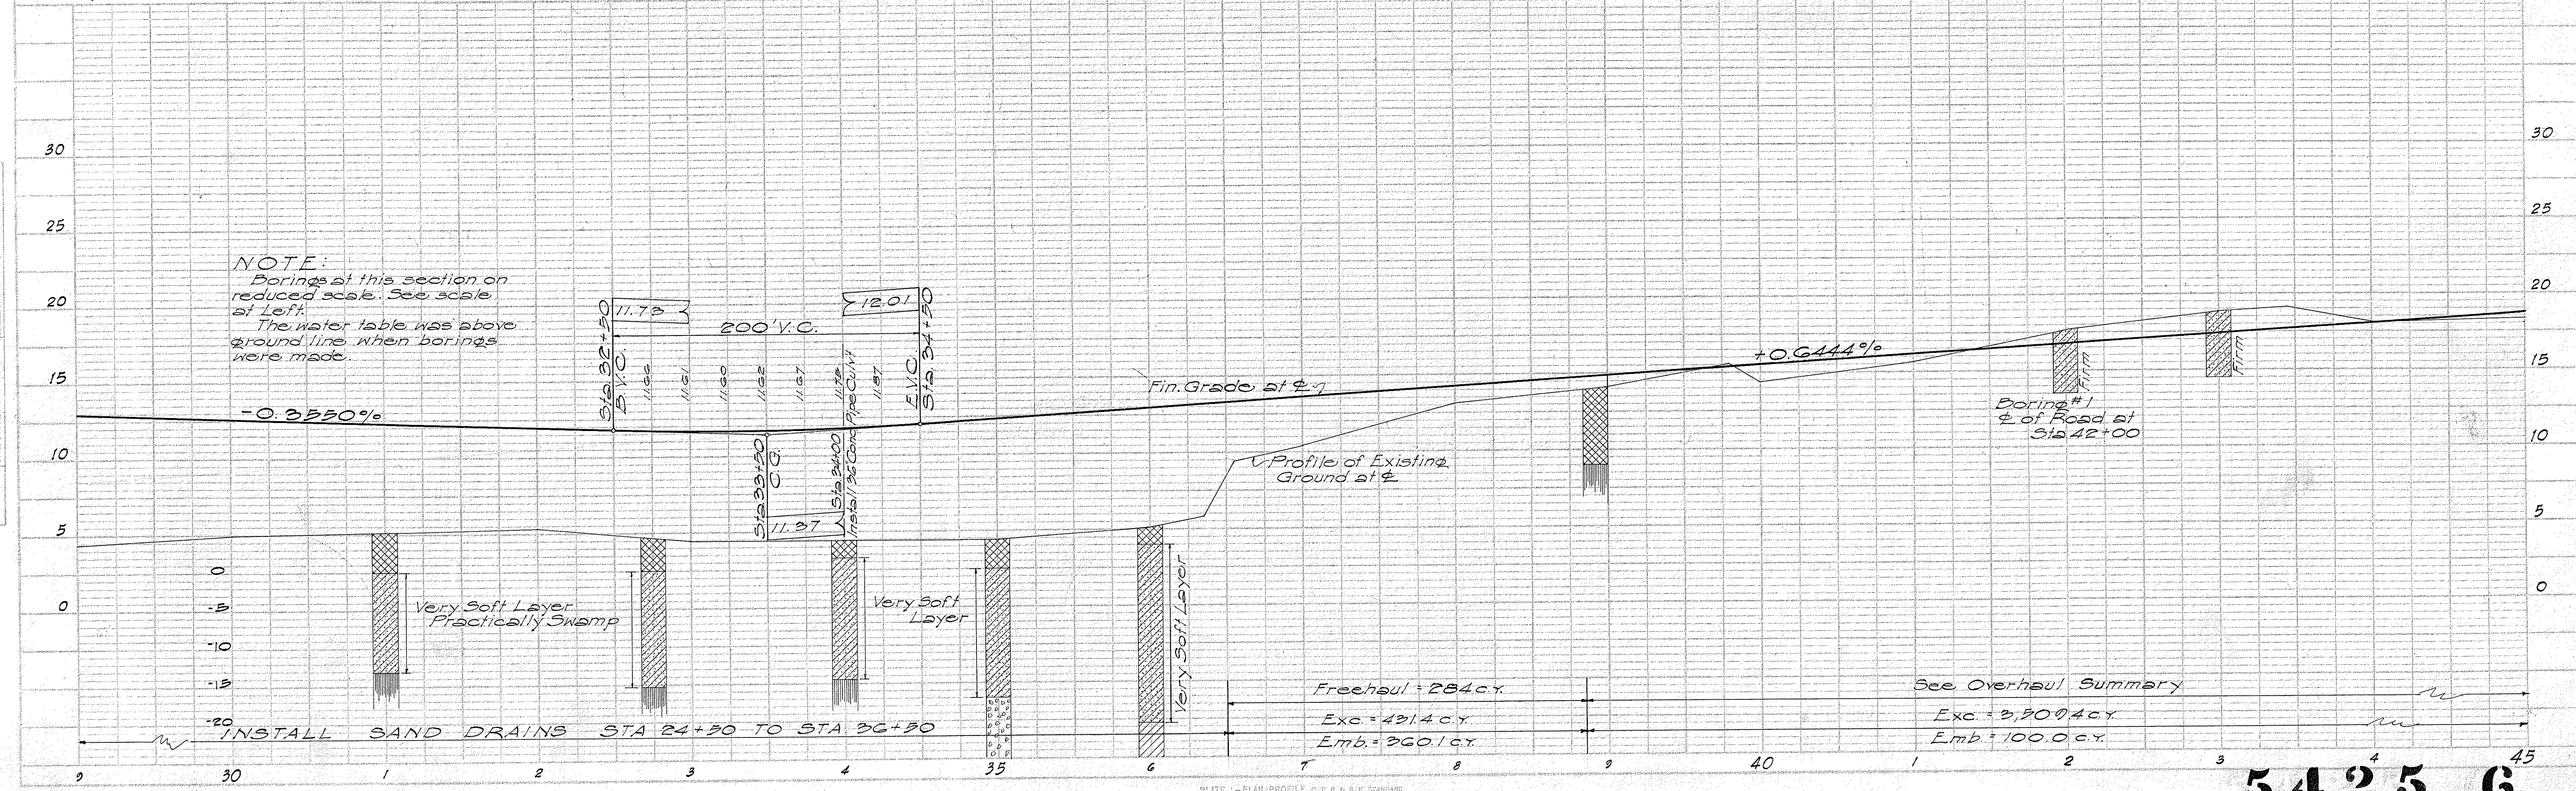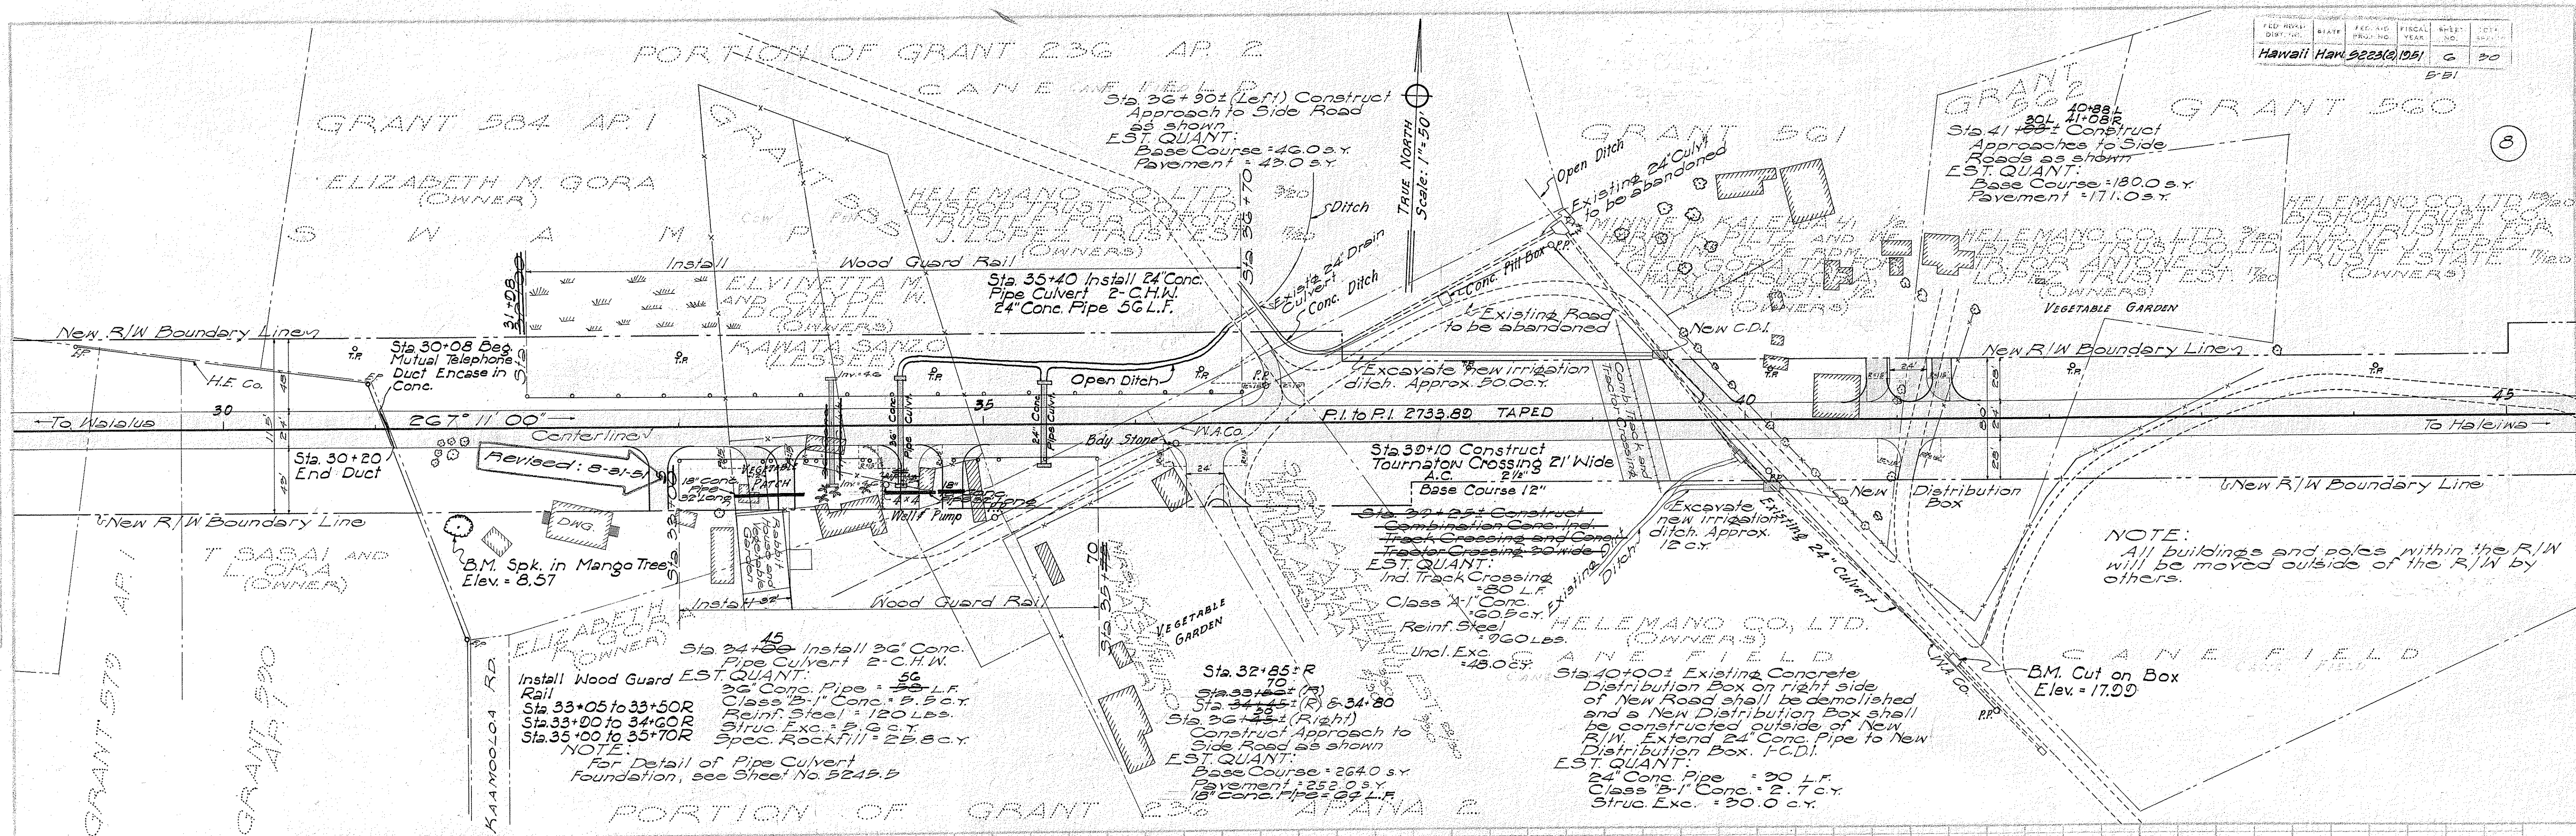

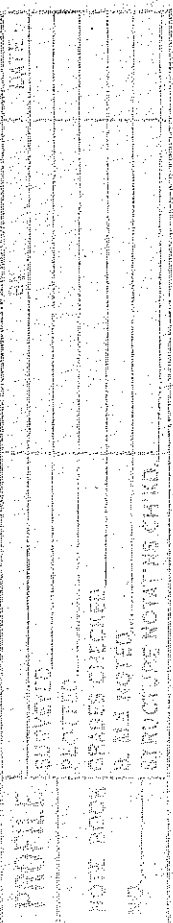

CURVE DATA

A = 82° 50' 30"
 R = 18° 30' 32"
 L = 200.00'
 Lc = 447.31'

NOTE:
 All Warning, Regulatory and Destination Signs, F.A. Markers and additional Number Plates for F.A. Markers will be done by the Territorial Highway Department.

FED. ROAD DIST. NO.	STATE	FED. AID PROJ. NO.	FISCAL YEAR	SCALE	DATE	FED. ROAD DIST. NO.	STATE	FED. AID PROJ. NO.	FISCAL YEAR	SCALE	DATE
HAWAII	HAWAII	F7(22)	1971	1/2"	1/2"	HAWAII	HAWAII	F7(22)	1971	1/2"	1/2"

DATE	BY	REVISION

DATE	BY	REVISION

