
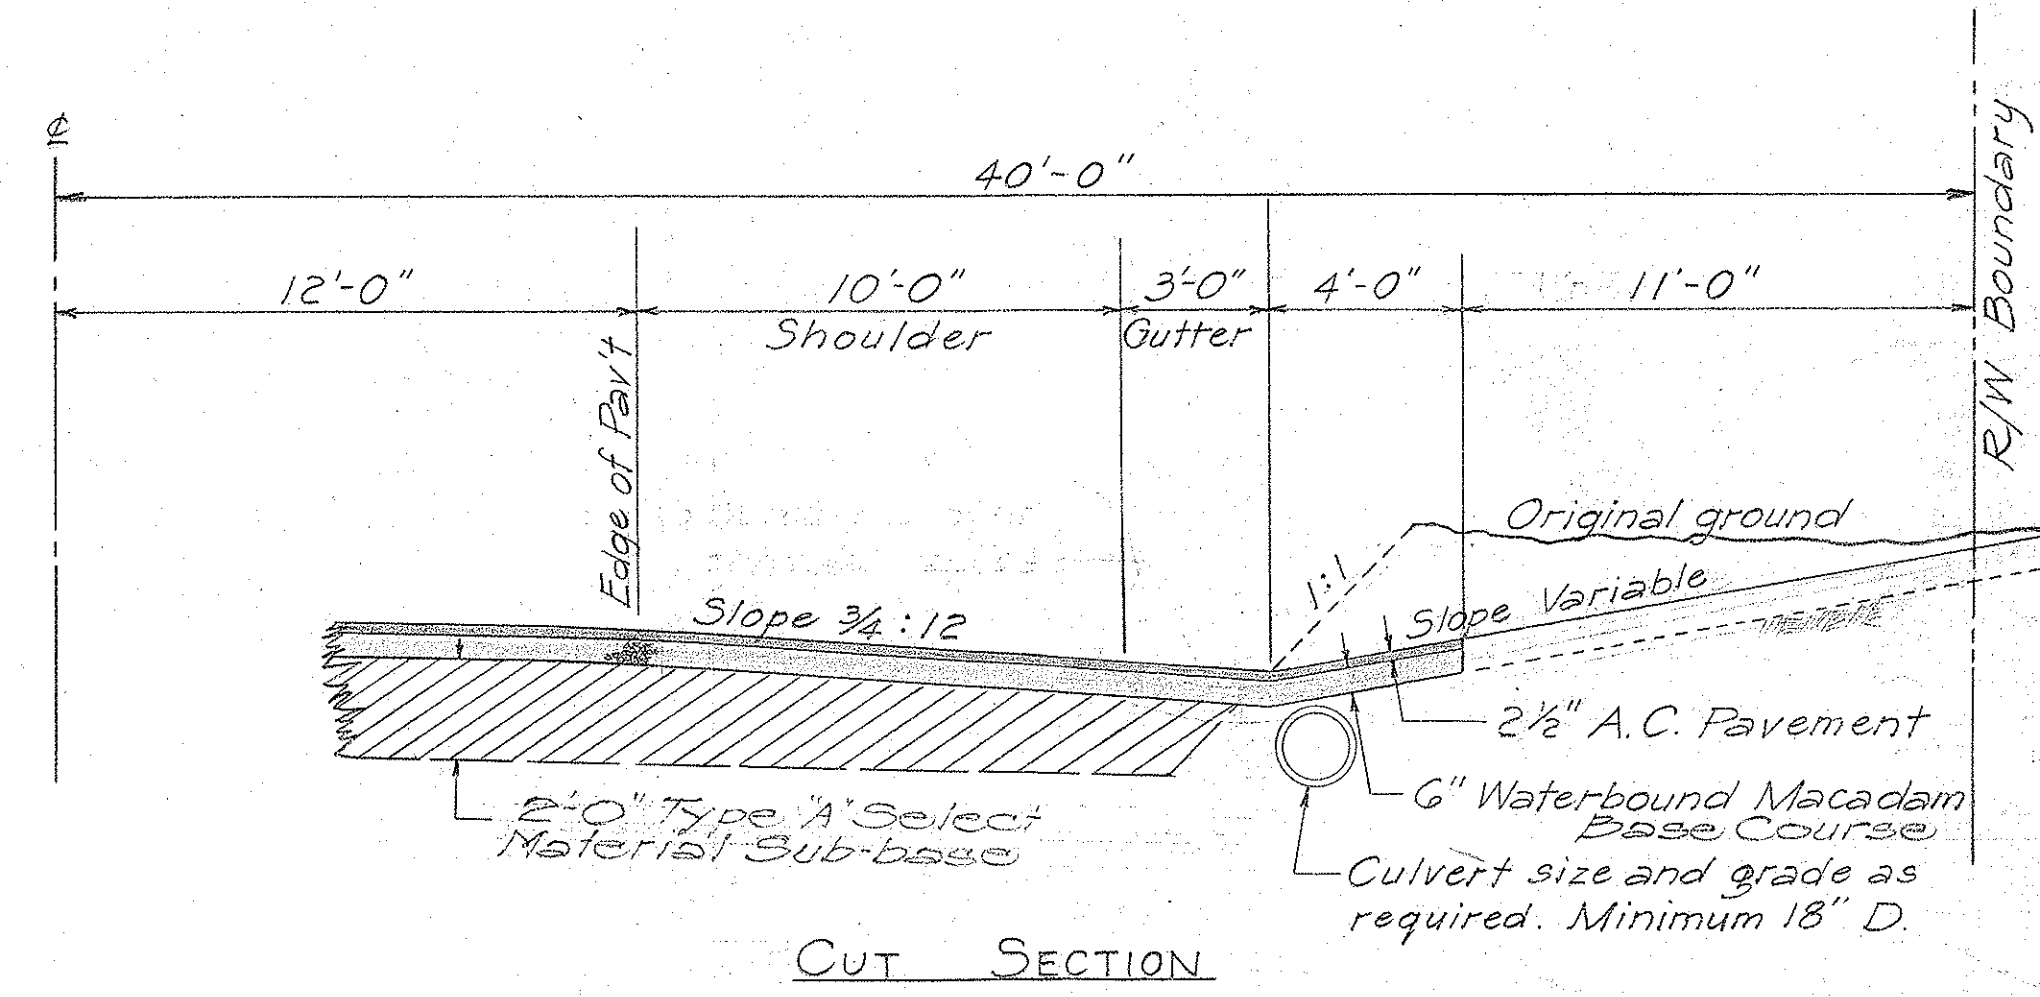
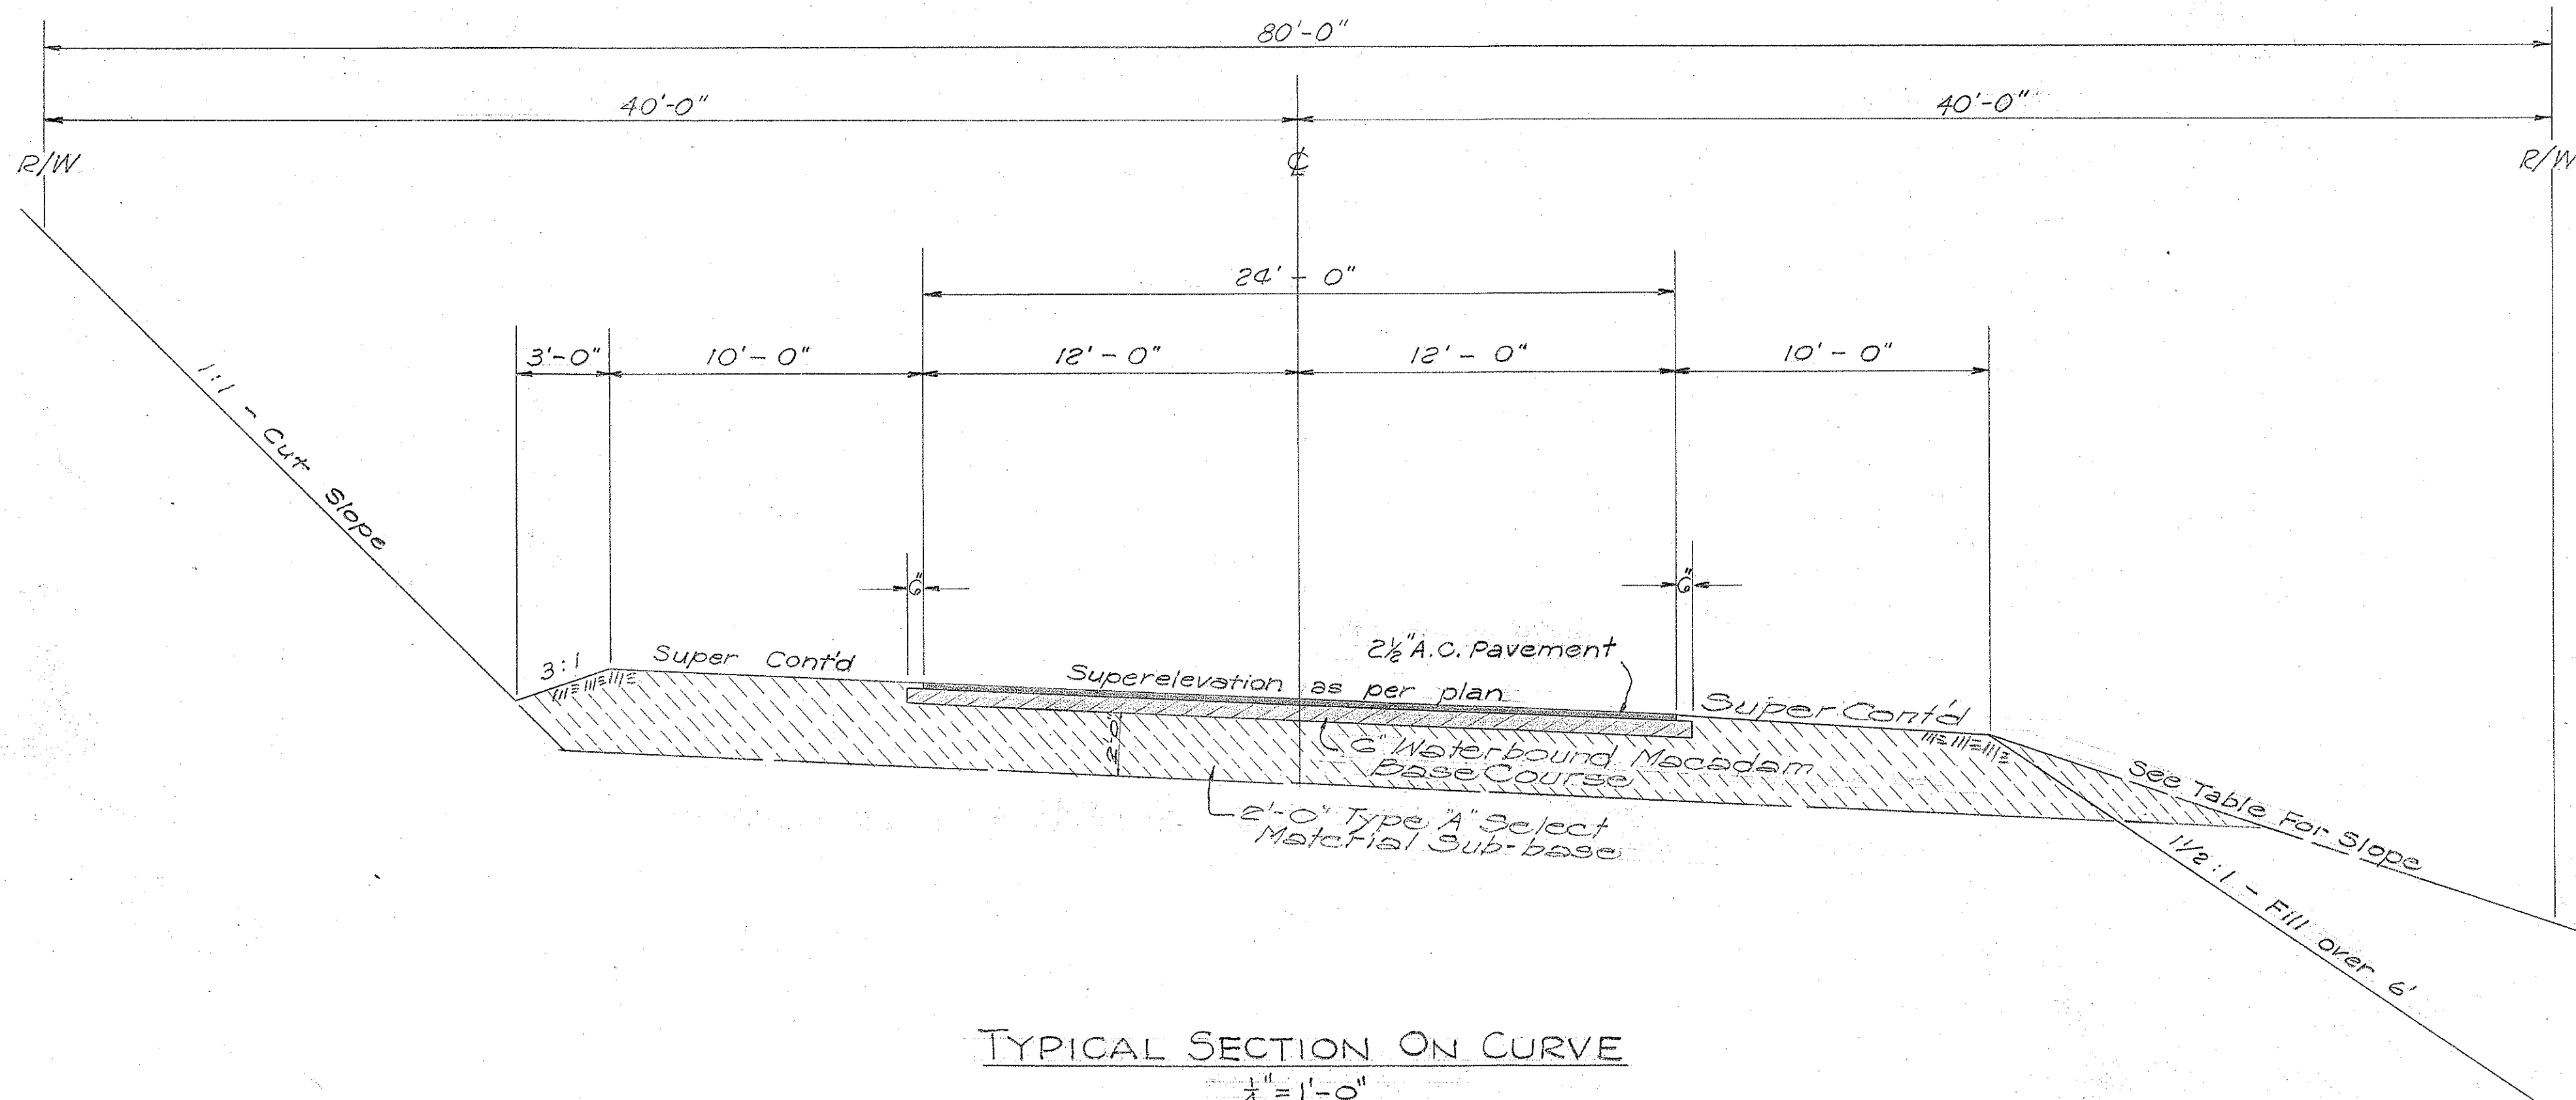
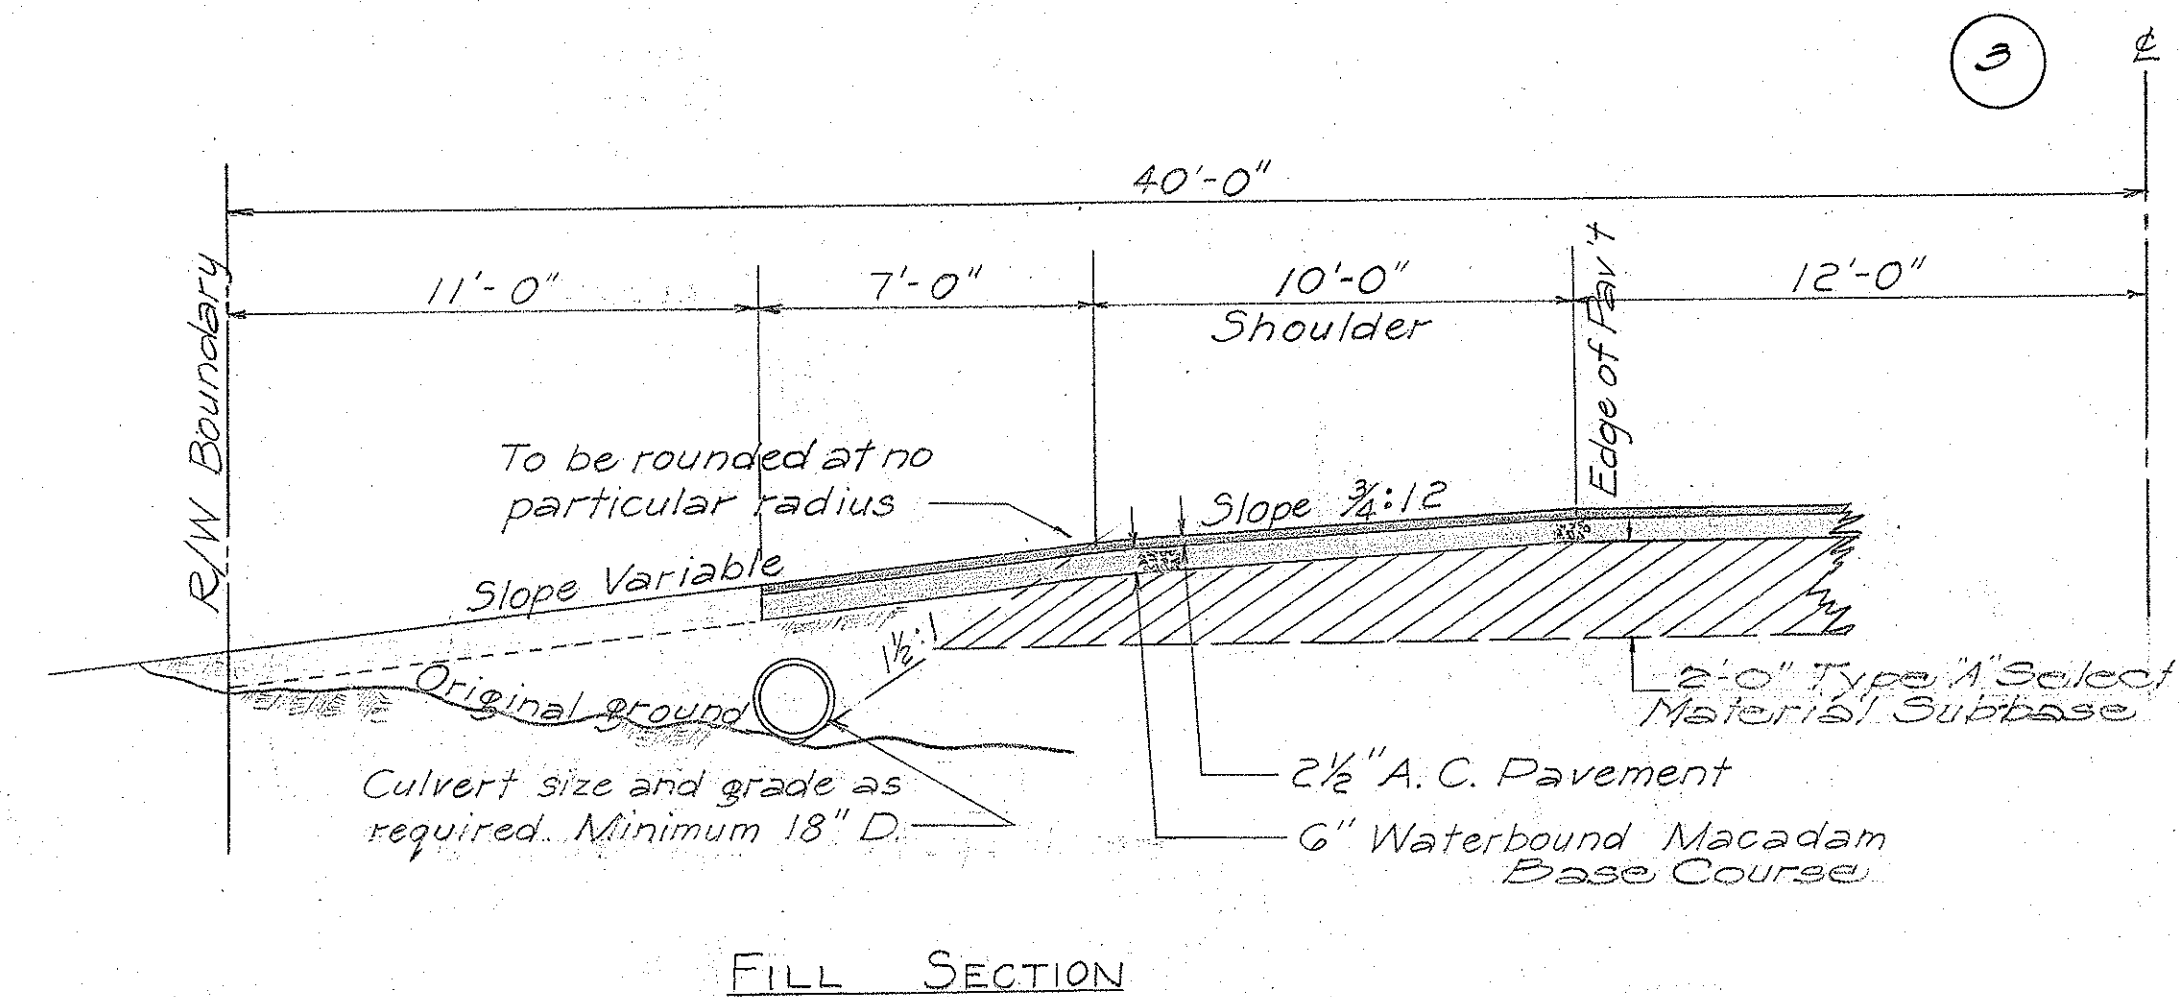


FED. ROAD DIST. NO.	STATE	FED. AID PROJ. NO.	FISCAL YEAR	SHEET NO.	TOTAL SHEETS
Hawaii	Haw.	3223(2)	1951	2	30

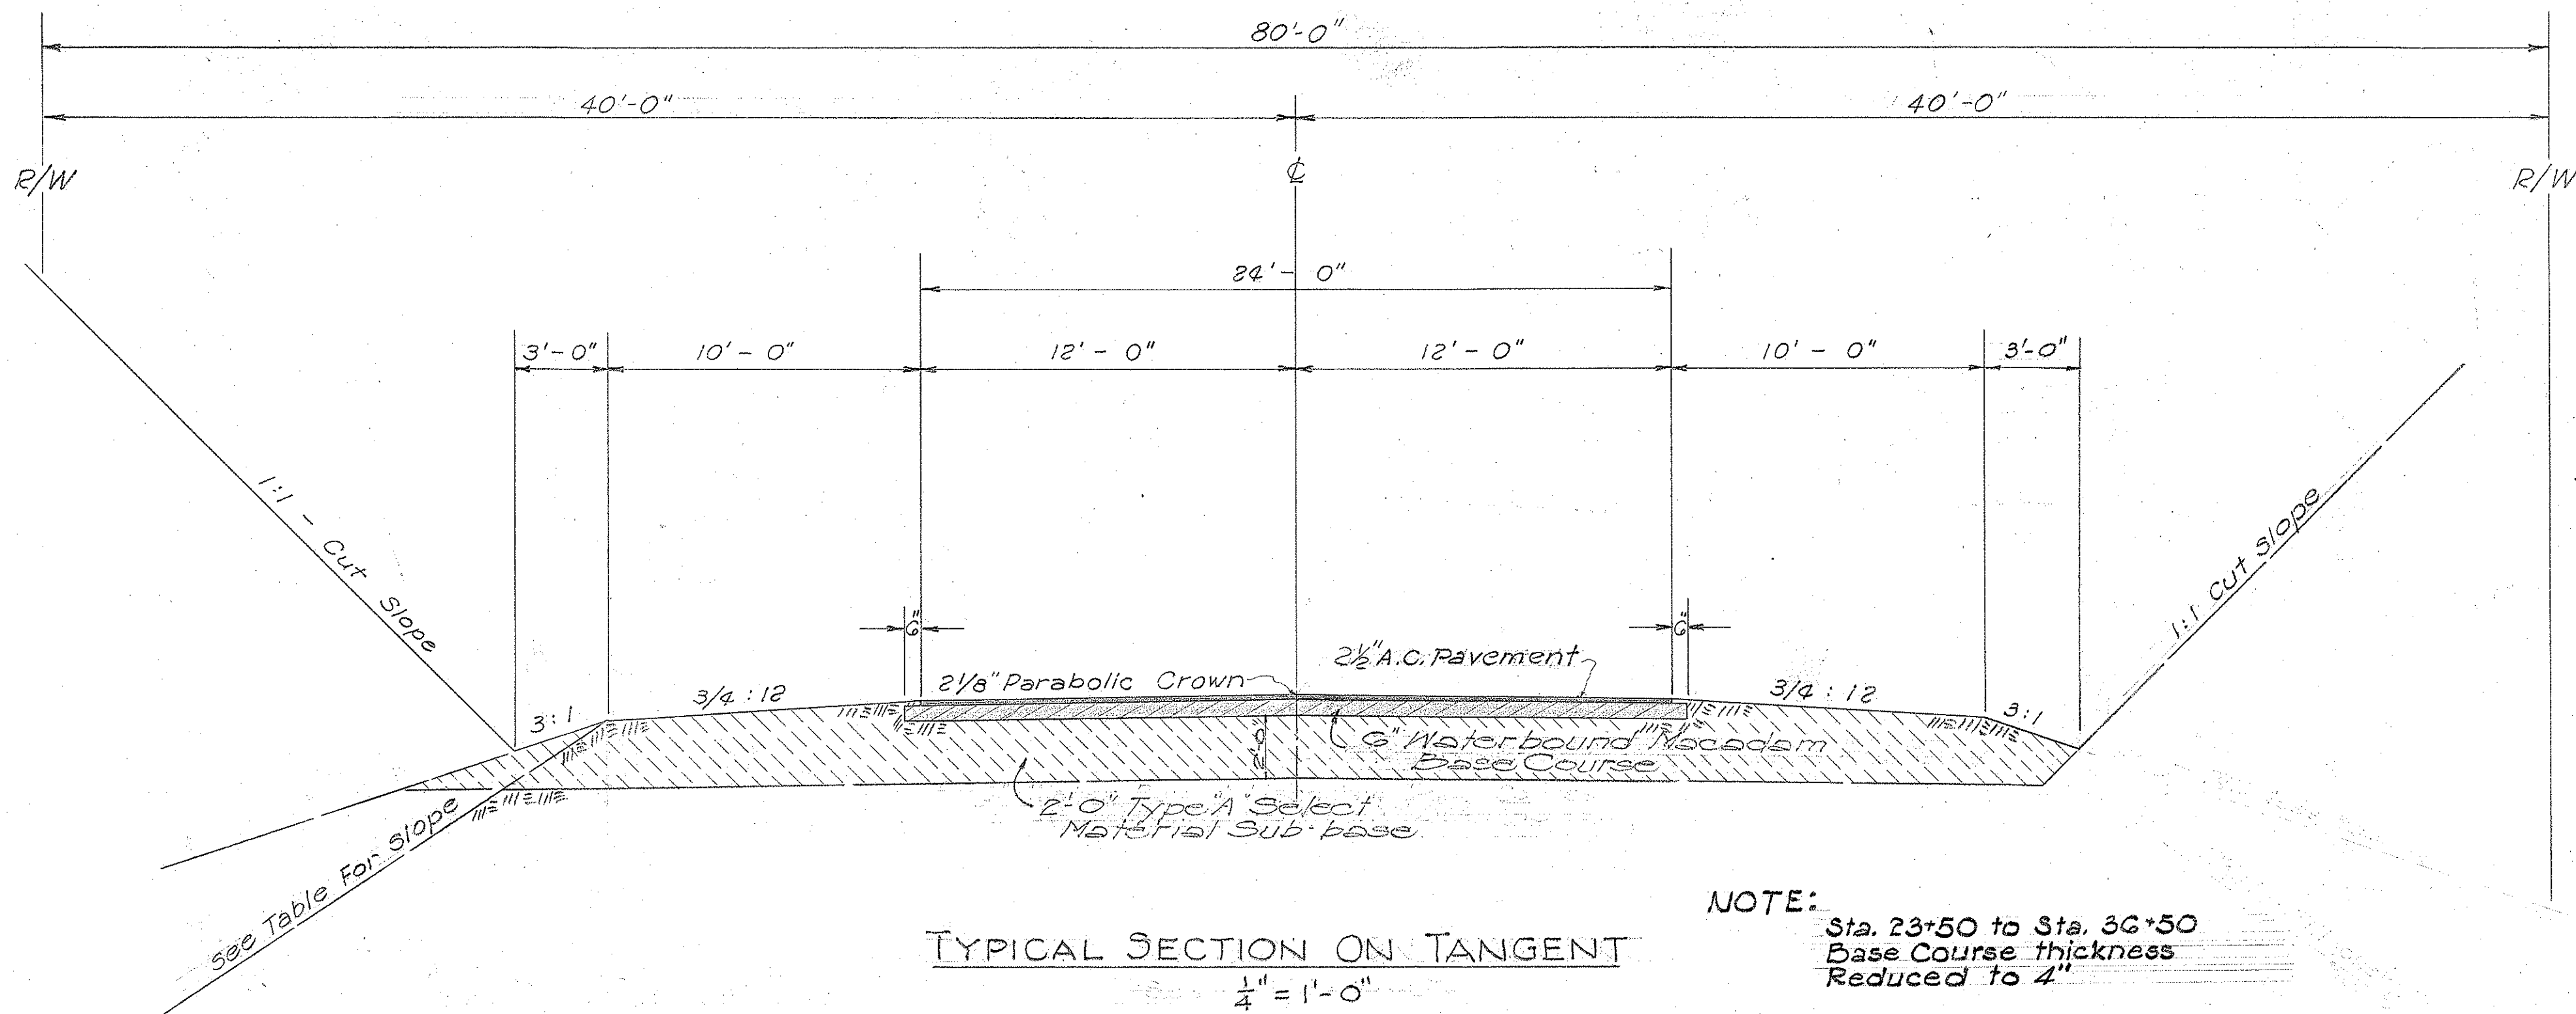

DETAIL OF SIDE ROAD APPROACHES
 Scale: $\frac{1}{4}'' = 1' - 0''$

GENERAL NOTES ON PAVEMENT AND BASE COURSE

Pavement shall be Asphalt Concrete 2 1/2" thick when fully compacted. It shall be laid in two courses: a 1 1/2" Leveling Course using Mix II and a 1" Surface Course using Mix X.

Base Course shall be Waterbound Macadam Base Course of 6" compacted thickness placed in two layers of 3" compacted thickness each and consisting of Coarse Rock and Filler (1/2" to 100).

Slow Curing Liquid Asphalt for Prime Coat shall be applied to the surface of the Base Course at the rate of 0.25 gal. per sq. yd. before placing the Leveling Course.

Both above courses subject to Specifications and Special Provisions.

Height of Fill	Fill Slope
0' - 3'	4:1
3' - 6'	2:1
Over 6'	1 1/2:1

TERRITORIAL HIGHWAY DEPARTMENT
 TERRITORY OF HAWAII

TYPICAL SECTIONS
 HALEIWA ROAD CUTOFF
 PROJECT No. 3223(2)

Scales: as noted June, 1950

SHEET NO. OF SHEETS