



DATE: _____ BY: _____
 SURVEYED: _____ PLOTTED: _____
 FINAL SURVEY NOTE BOOK NO. _____
 AREAS CHECKED: _____

DATE: _____ BY: _____
 SURVEYED: _____ PLOTTED: _____
 ORIGINAL SURVEY NOTE BOOK NO. _____
 AREAS CHECKED: _____

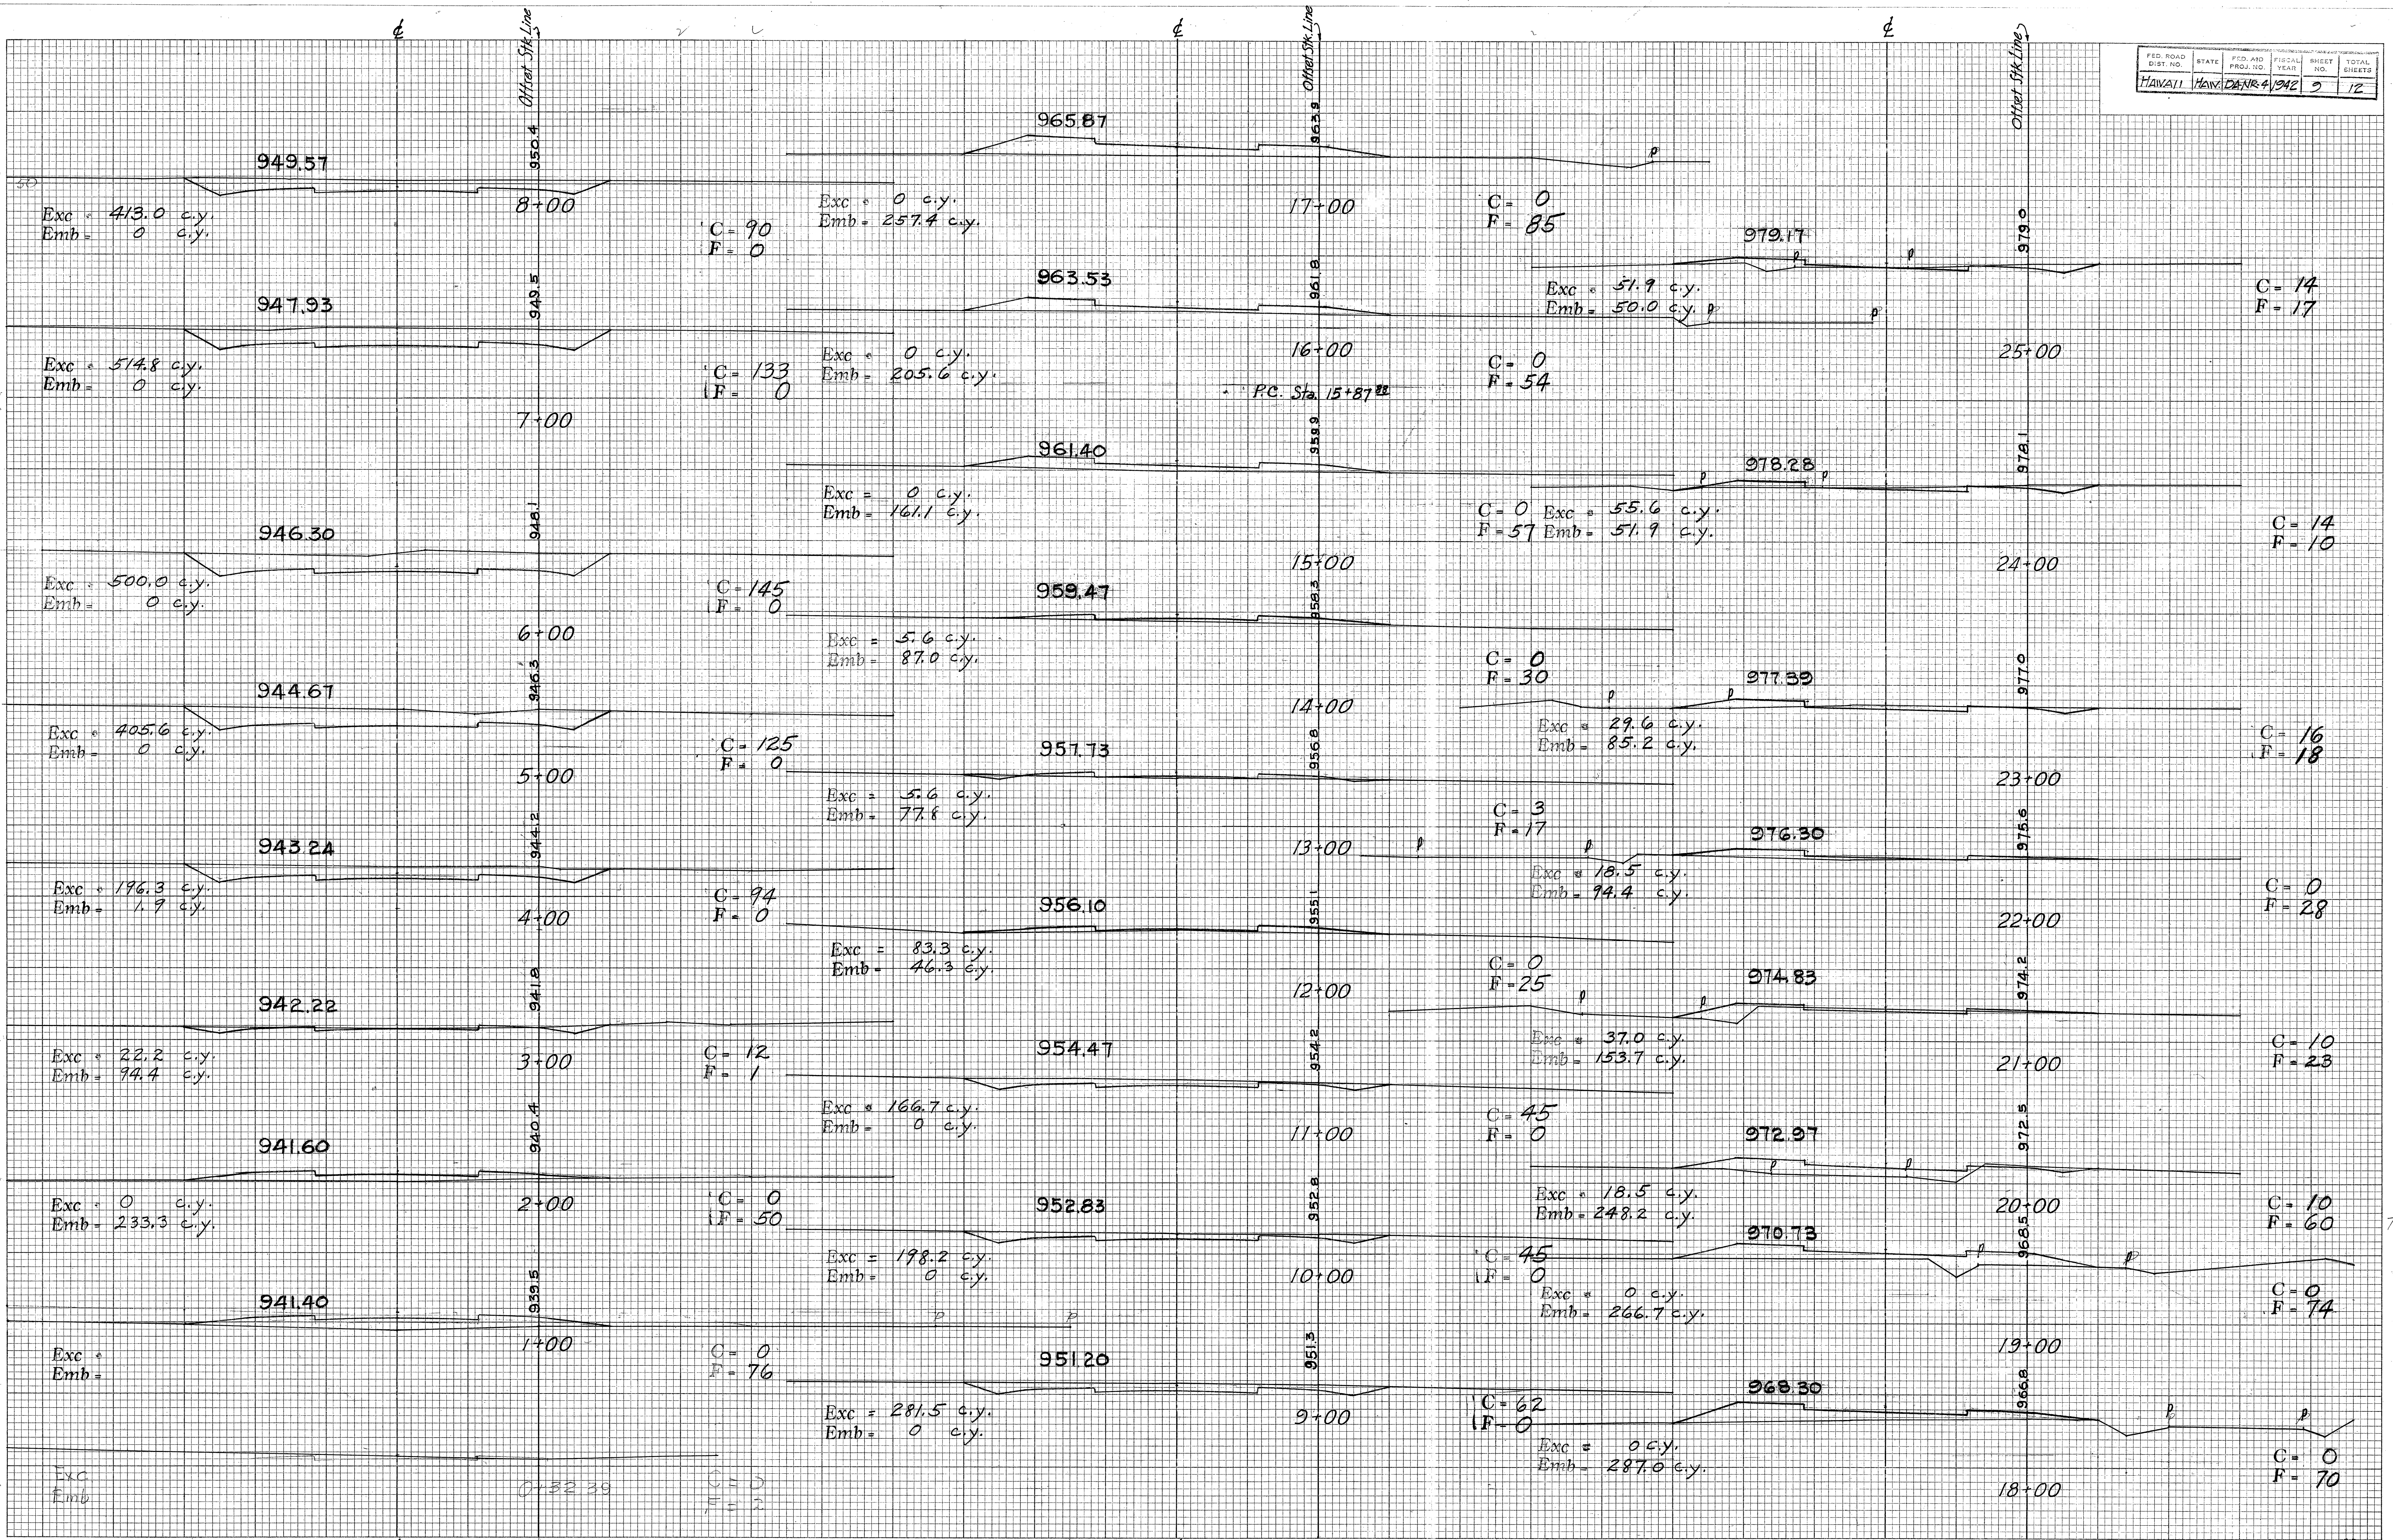


FINAL SURVEY
 SURVEYED
 PLOTTED
 NOTE BOOK
 AREAS CHECKED

ORIGINAL SURVEY
 SURVEYED
 PLOTTED
 NOTE BOOK
 AREAS CHECKED

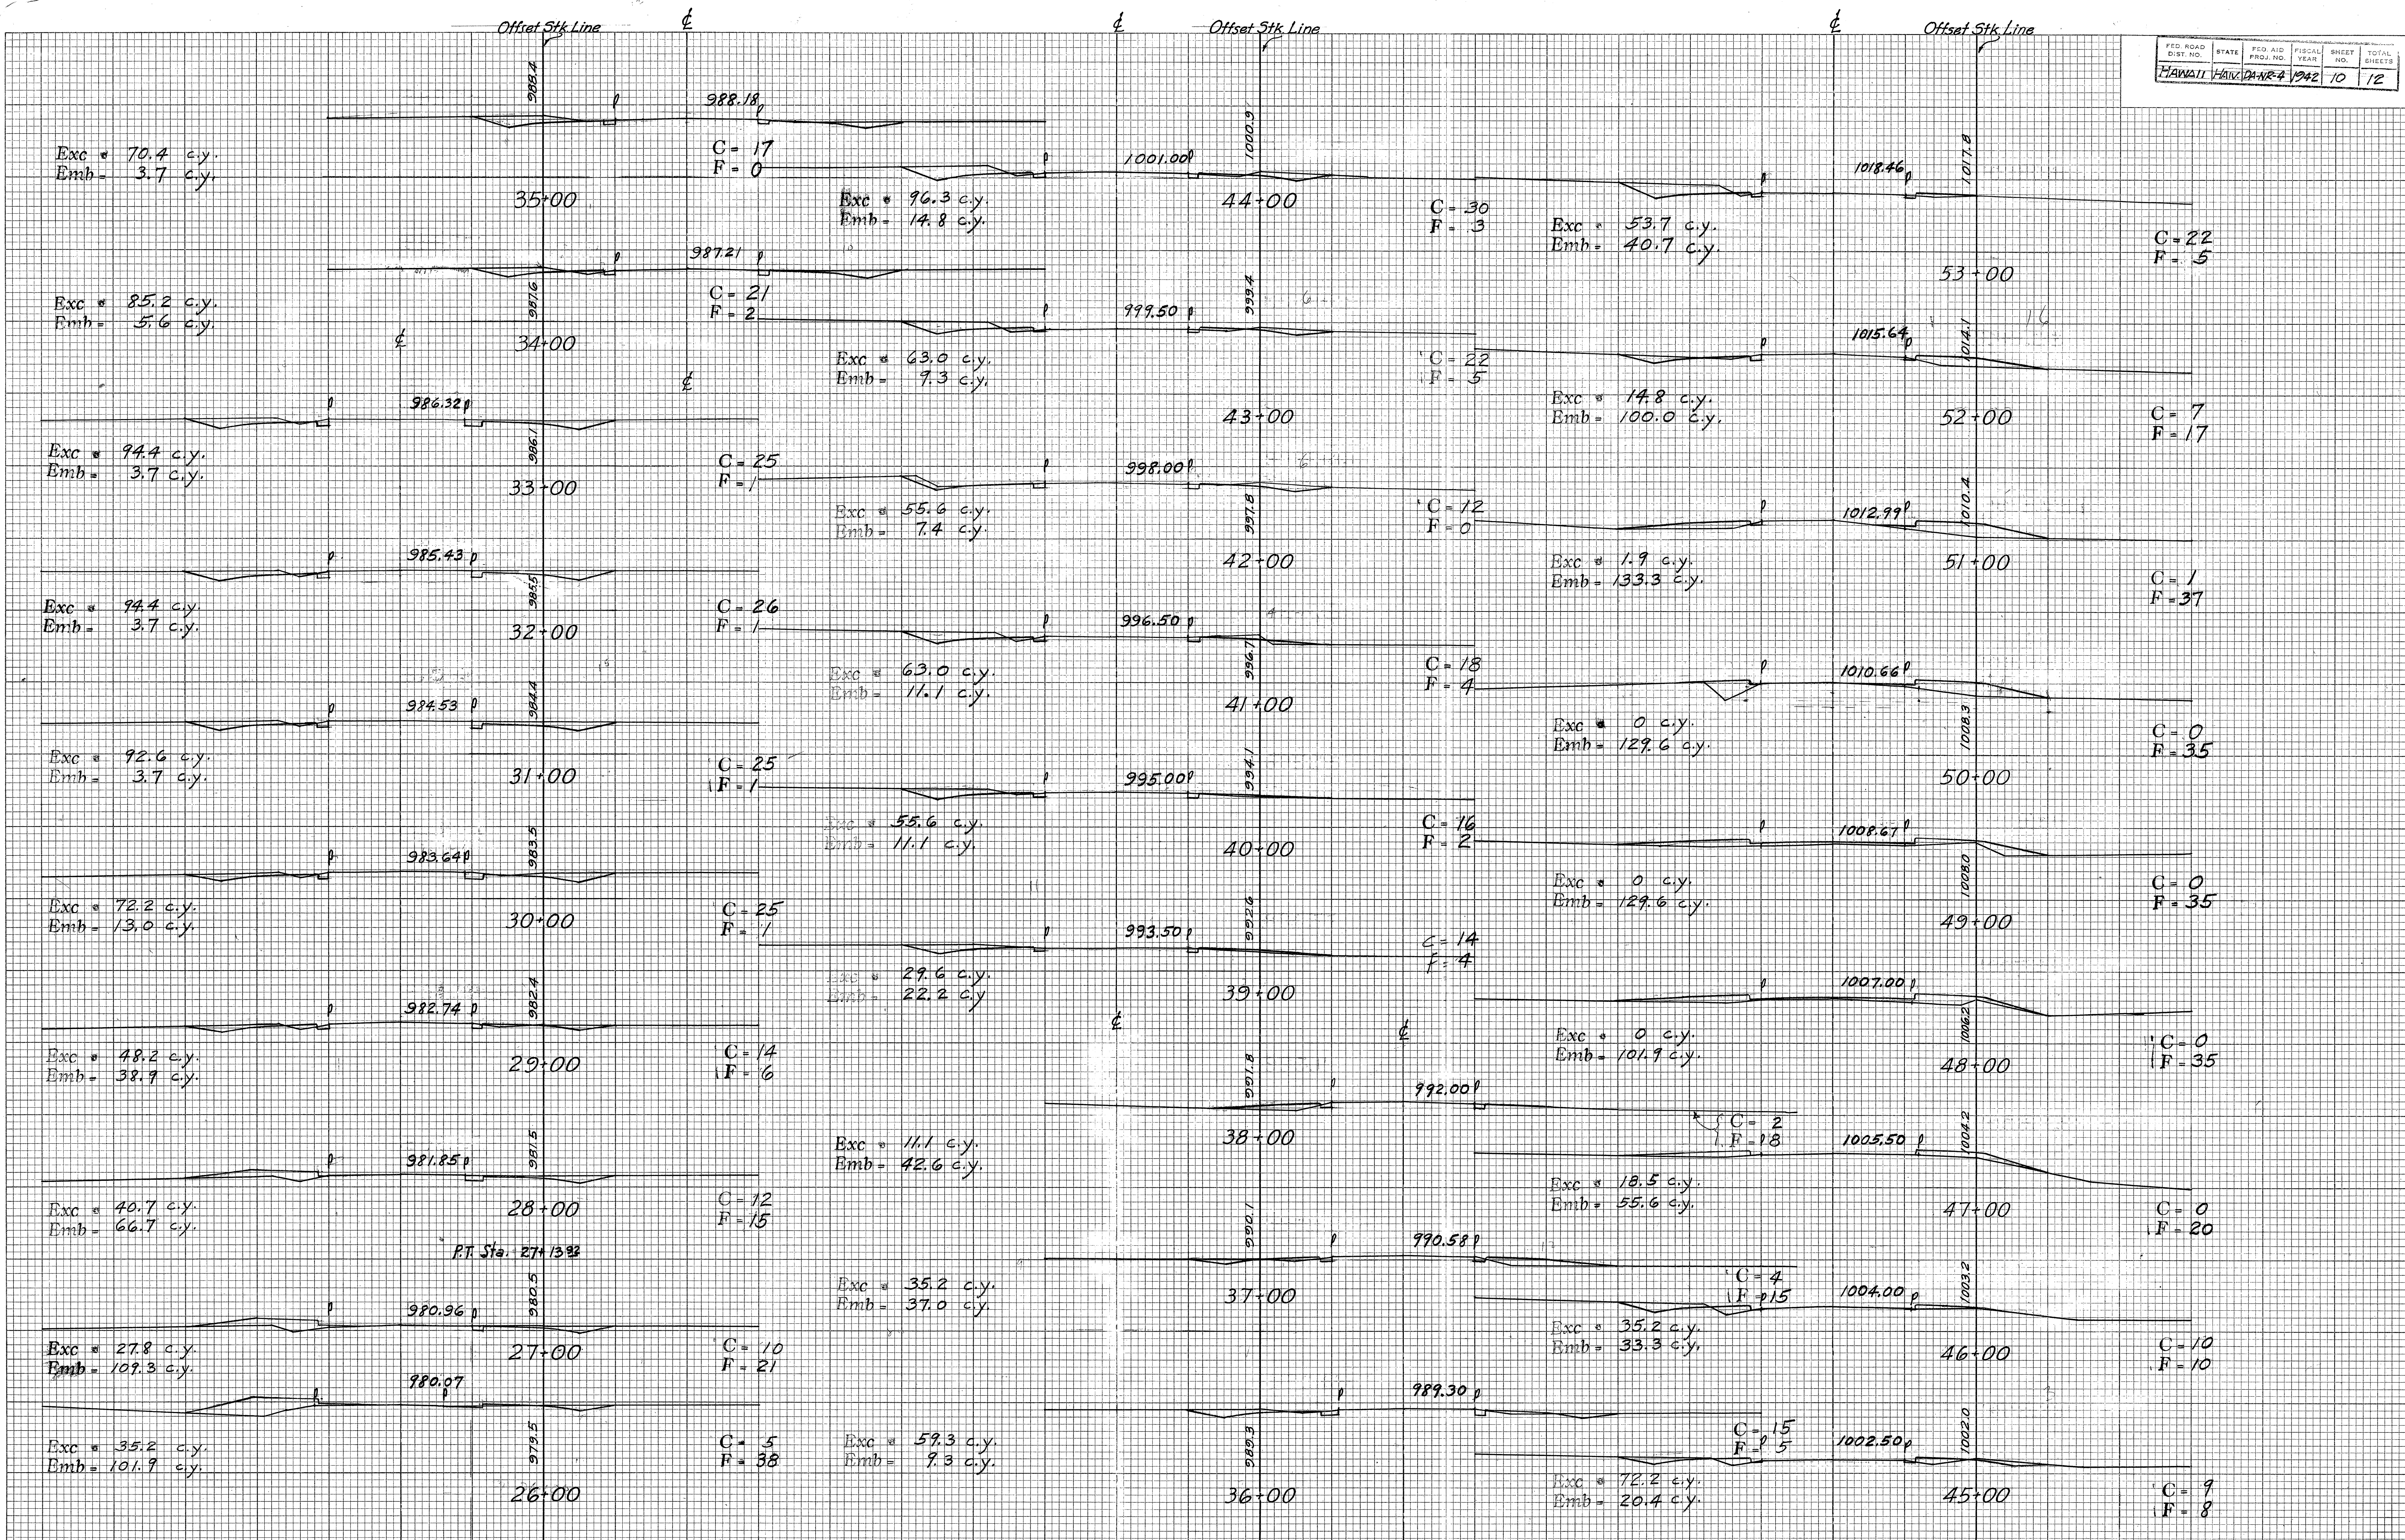

FINAL SURVEY
DATE
BY
SURVEYED
FLIPPED
NOTE BOOK
AREAS CHECKED
NO.

ORIGINAL SURVEY
DATE
BY
SURVEYED
FLIPPED
NOTE BOOK
AREAS CHECKED
NO.

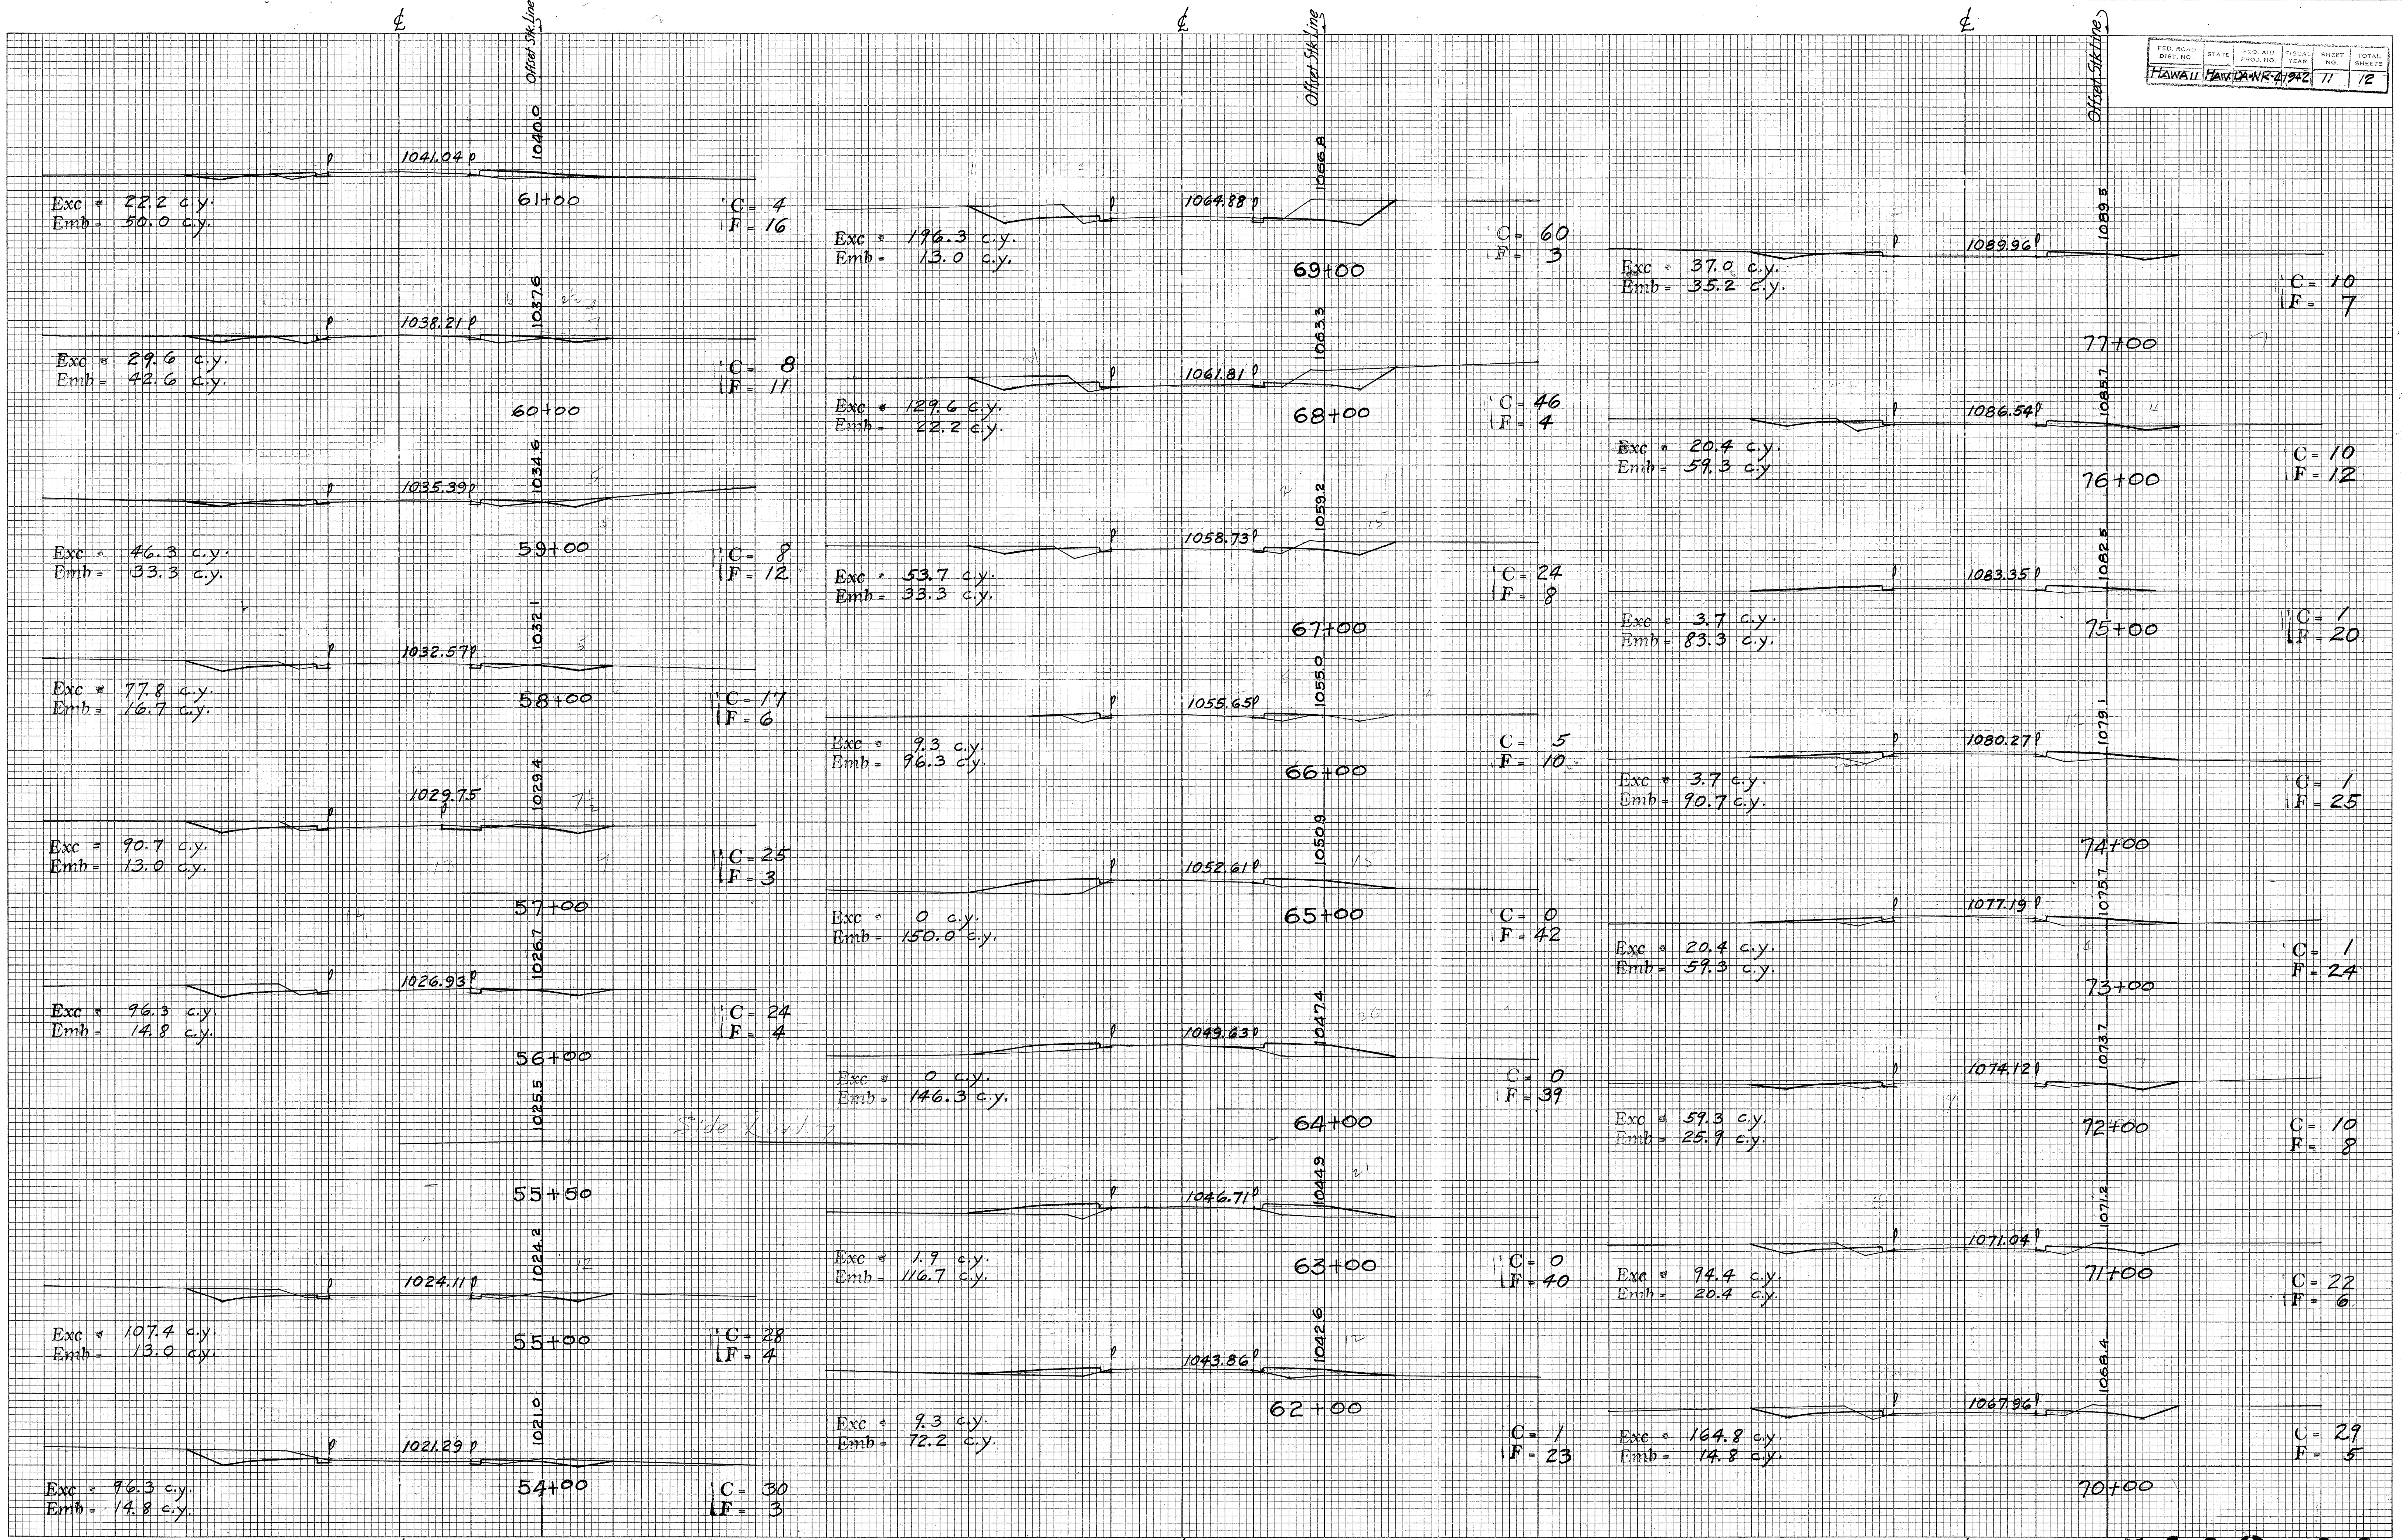

FINAL SURVEY
BY
DATE
NO.

ORIGINAL SURVEY
BY
DATE
NO.

