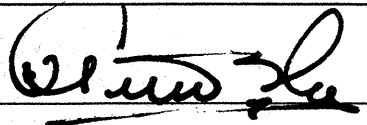


	INDEX
SHEET NO.	DESCRIPTION
1	TITLE SHEET
2	LOCATIONS OF DESTINATION SIGNS
3	STANDARD DETAILS
4 - 8	DESTINATION SIGNS

STATE OF HAWAII  
DEPARTMENT OF TRANSPORTATION  
DIVISION OF HIGHWAYS  
HONOLULU, HAWAII

PLANS FOR  
THE INSTALLATION OF DESTINATION SIGNS  
ON THE ISLAND OF OAHU  
JOB NO.- A - 0001 - 04 - 60

APPROVED:DATE: 5/13/60

  
DIRECTOR OF TRANSPORTATION