




FED. ROAD DIST. NO.	STATE	PROJ. NO.	FISCAL YEAR	SHEET NO.	TOTAL SHEETS
HAWAII	HAW.	7012A-01-98M	1999	10	32

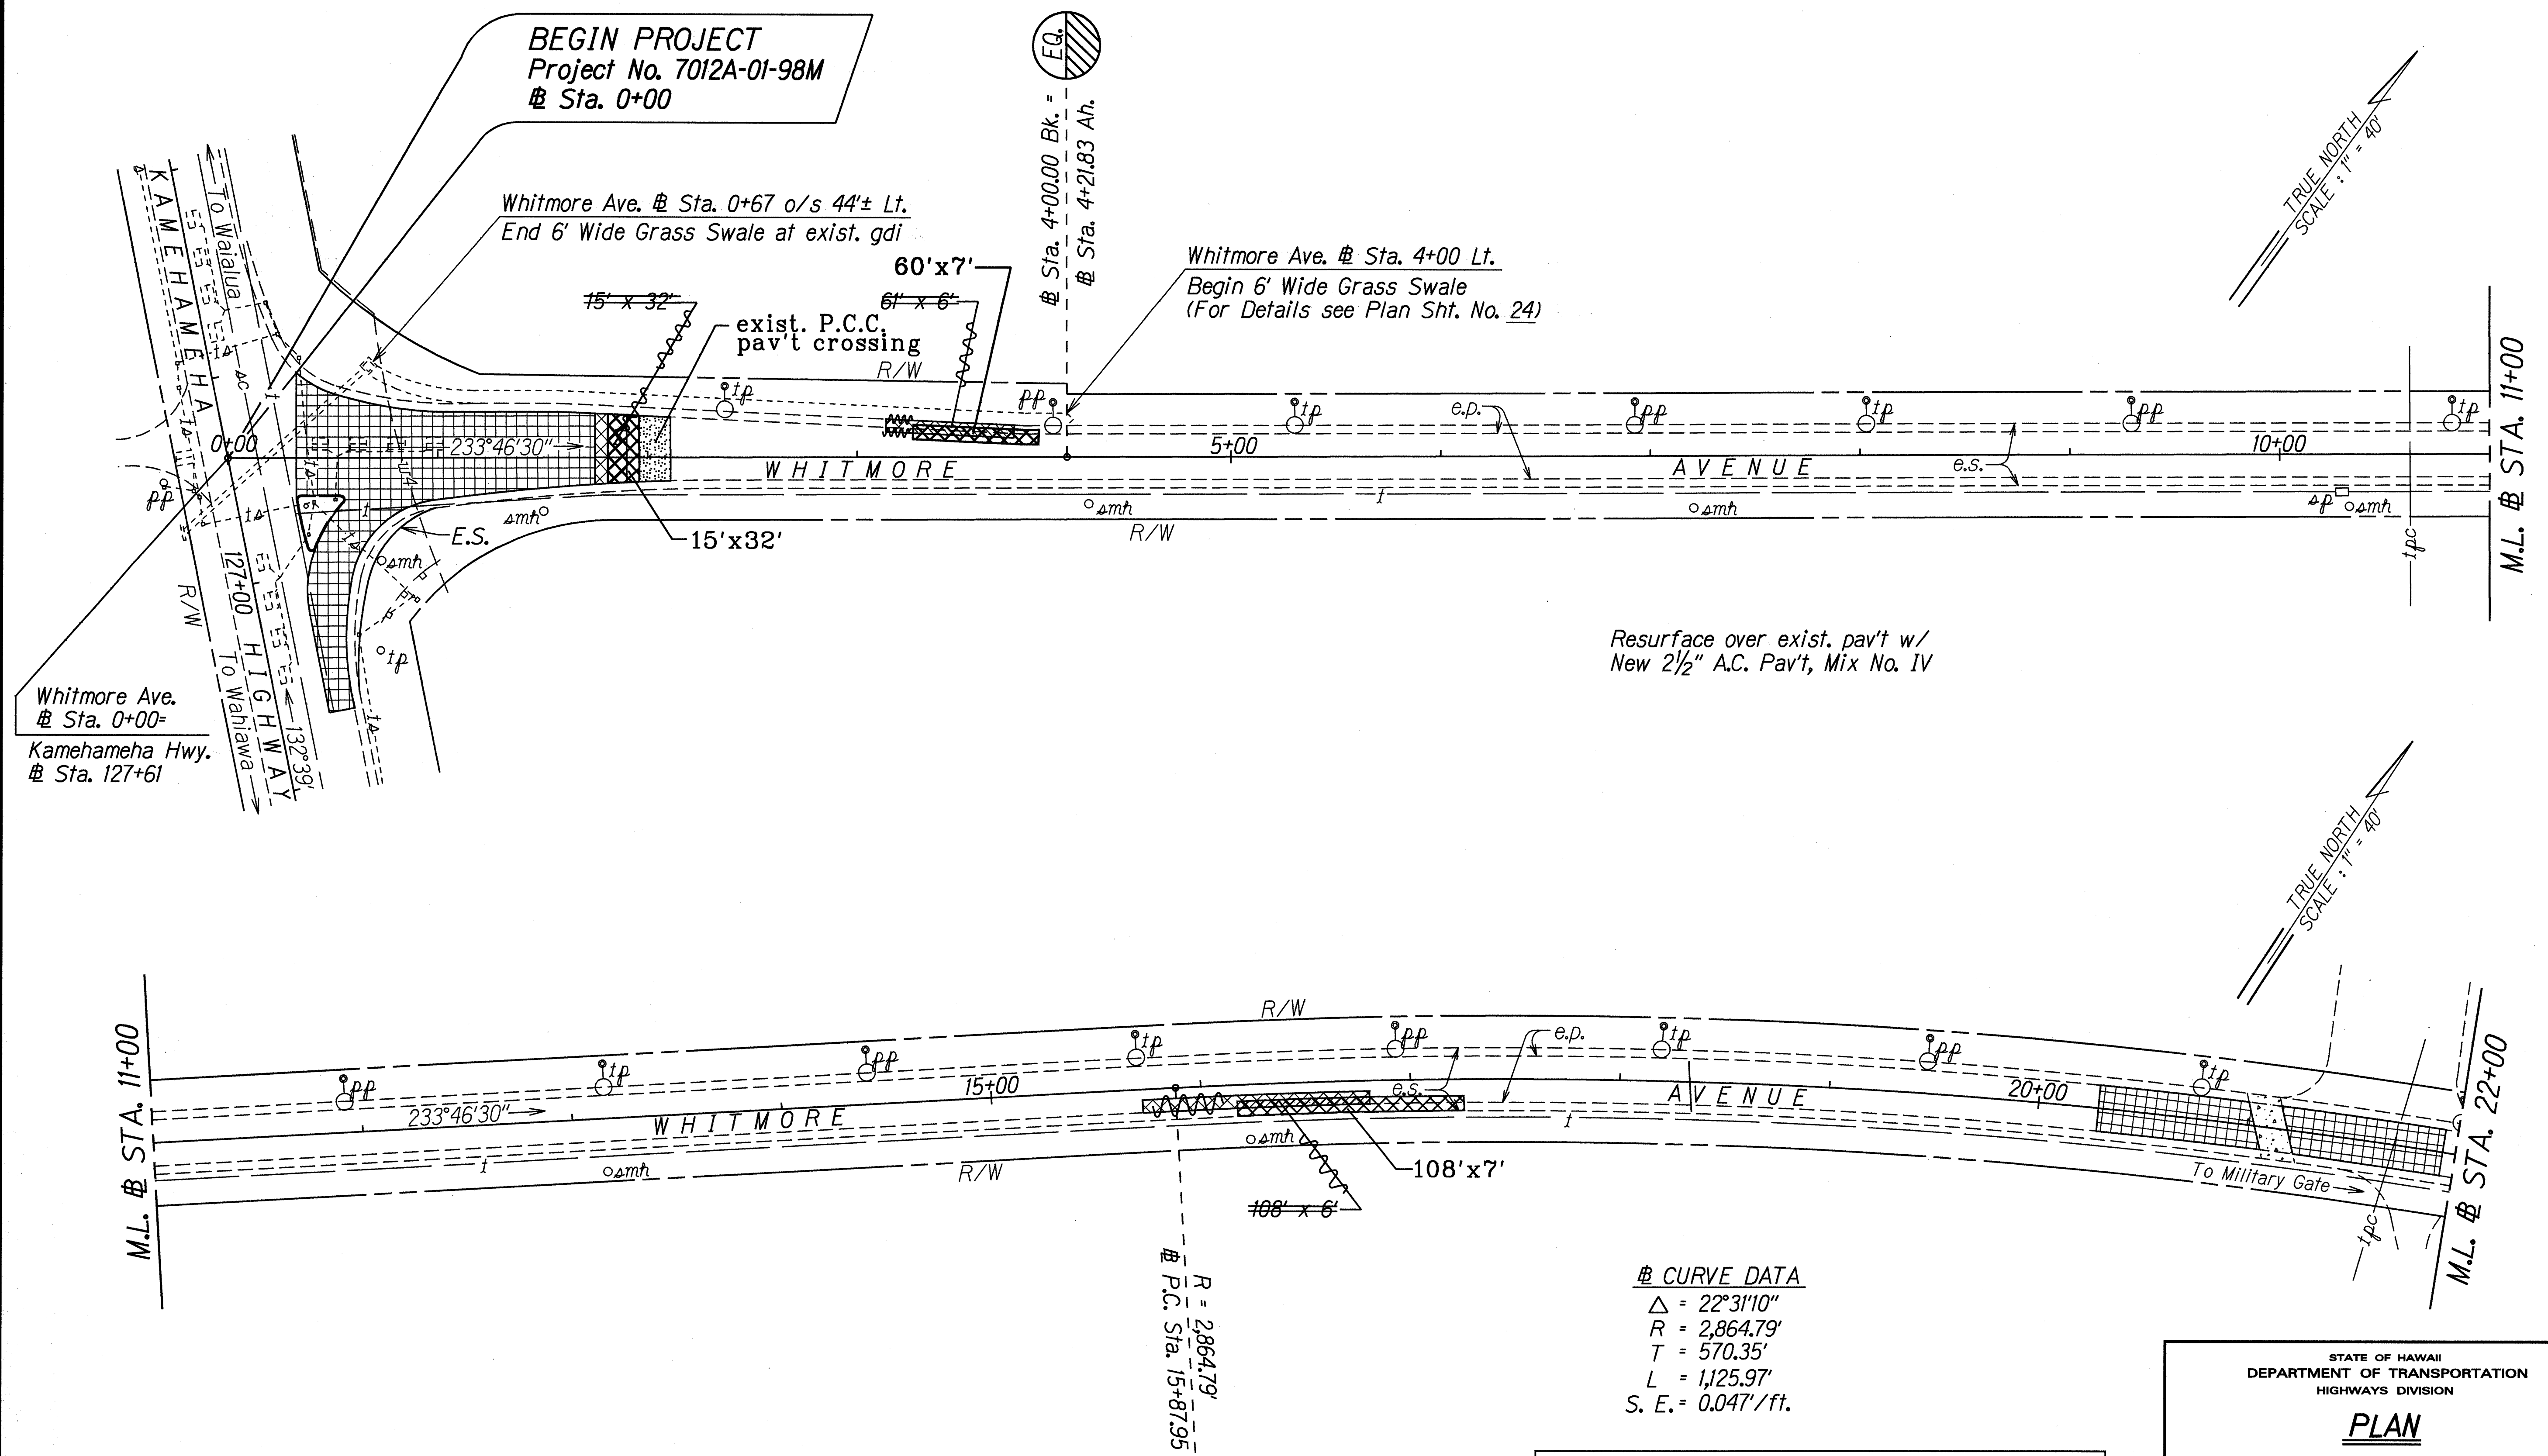

SURVEY PLOTTED BY	DATE
DRAWN BY	
NOTED BY	
CHECKED BY	

"AS-BUILT"

FED. ROAD DIST. NO.	STATE	PROJ. NO.	FISCAL YEAR	SHEET NO.	TOTAL SHEETS
HAWAII	HAW.	7012A-01-98M	1999	11	32

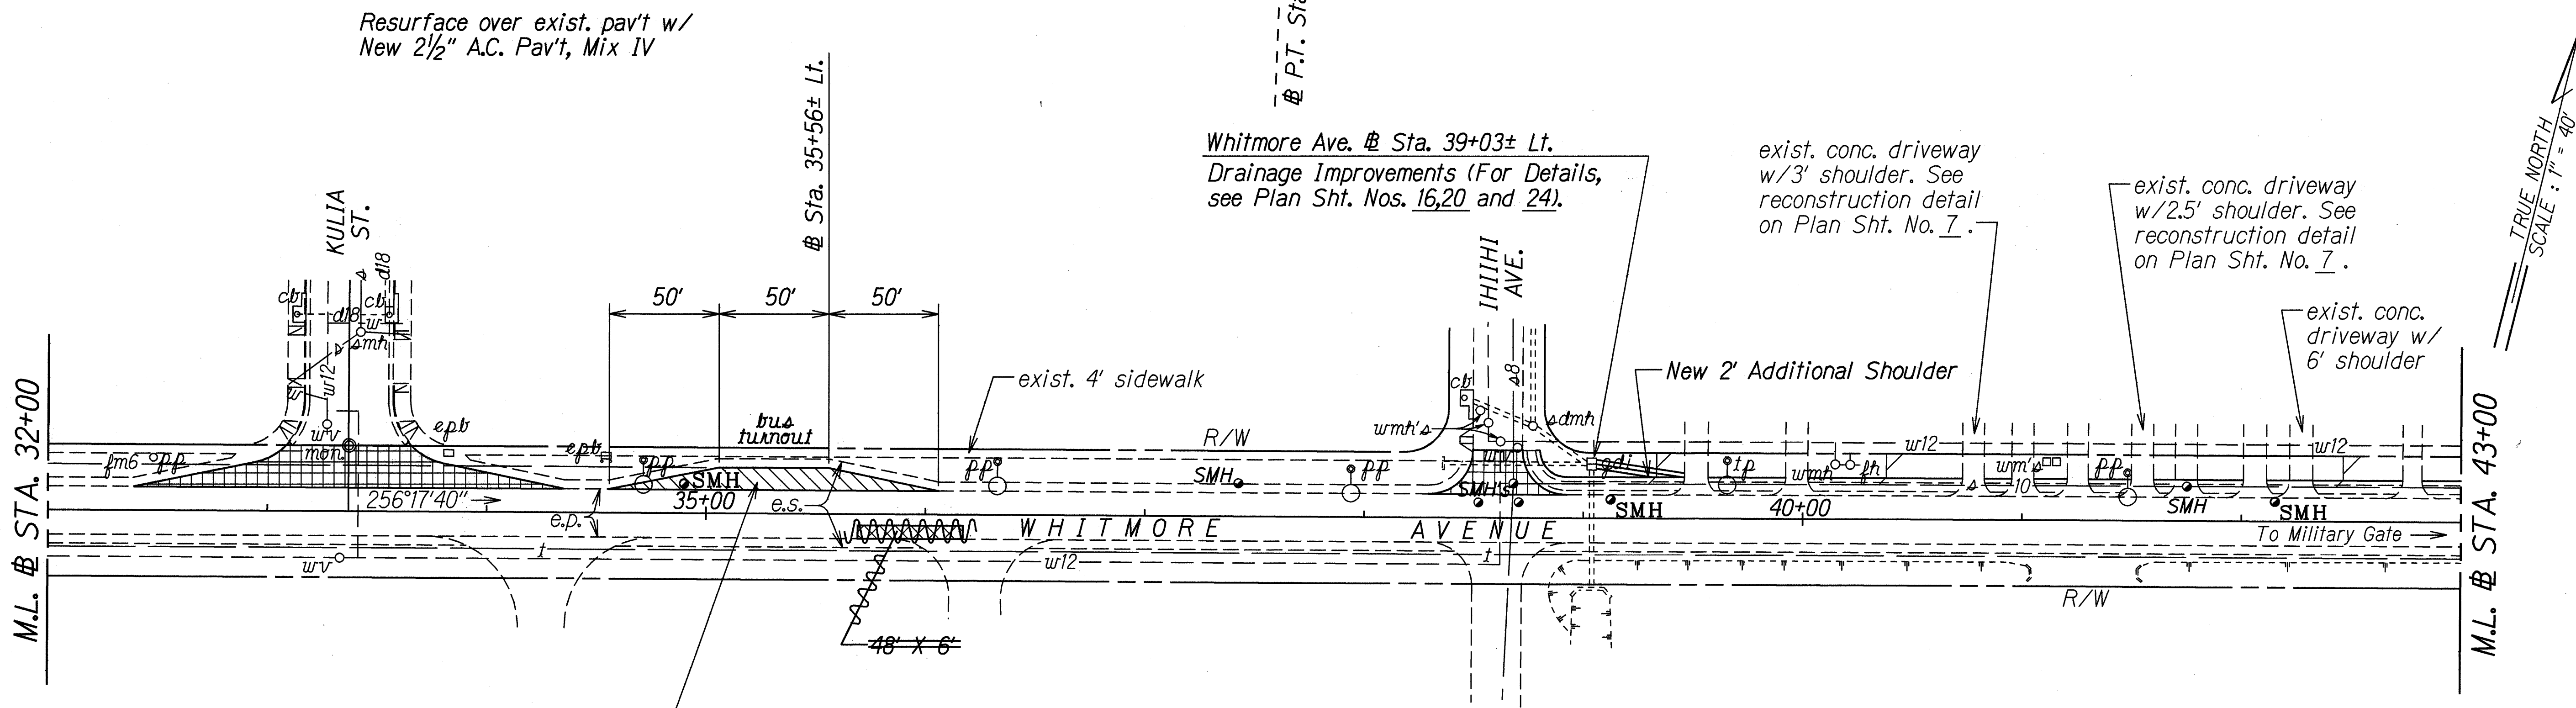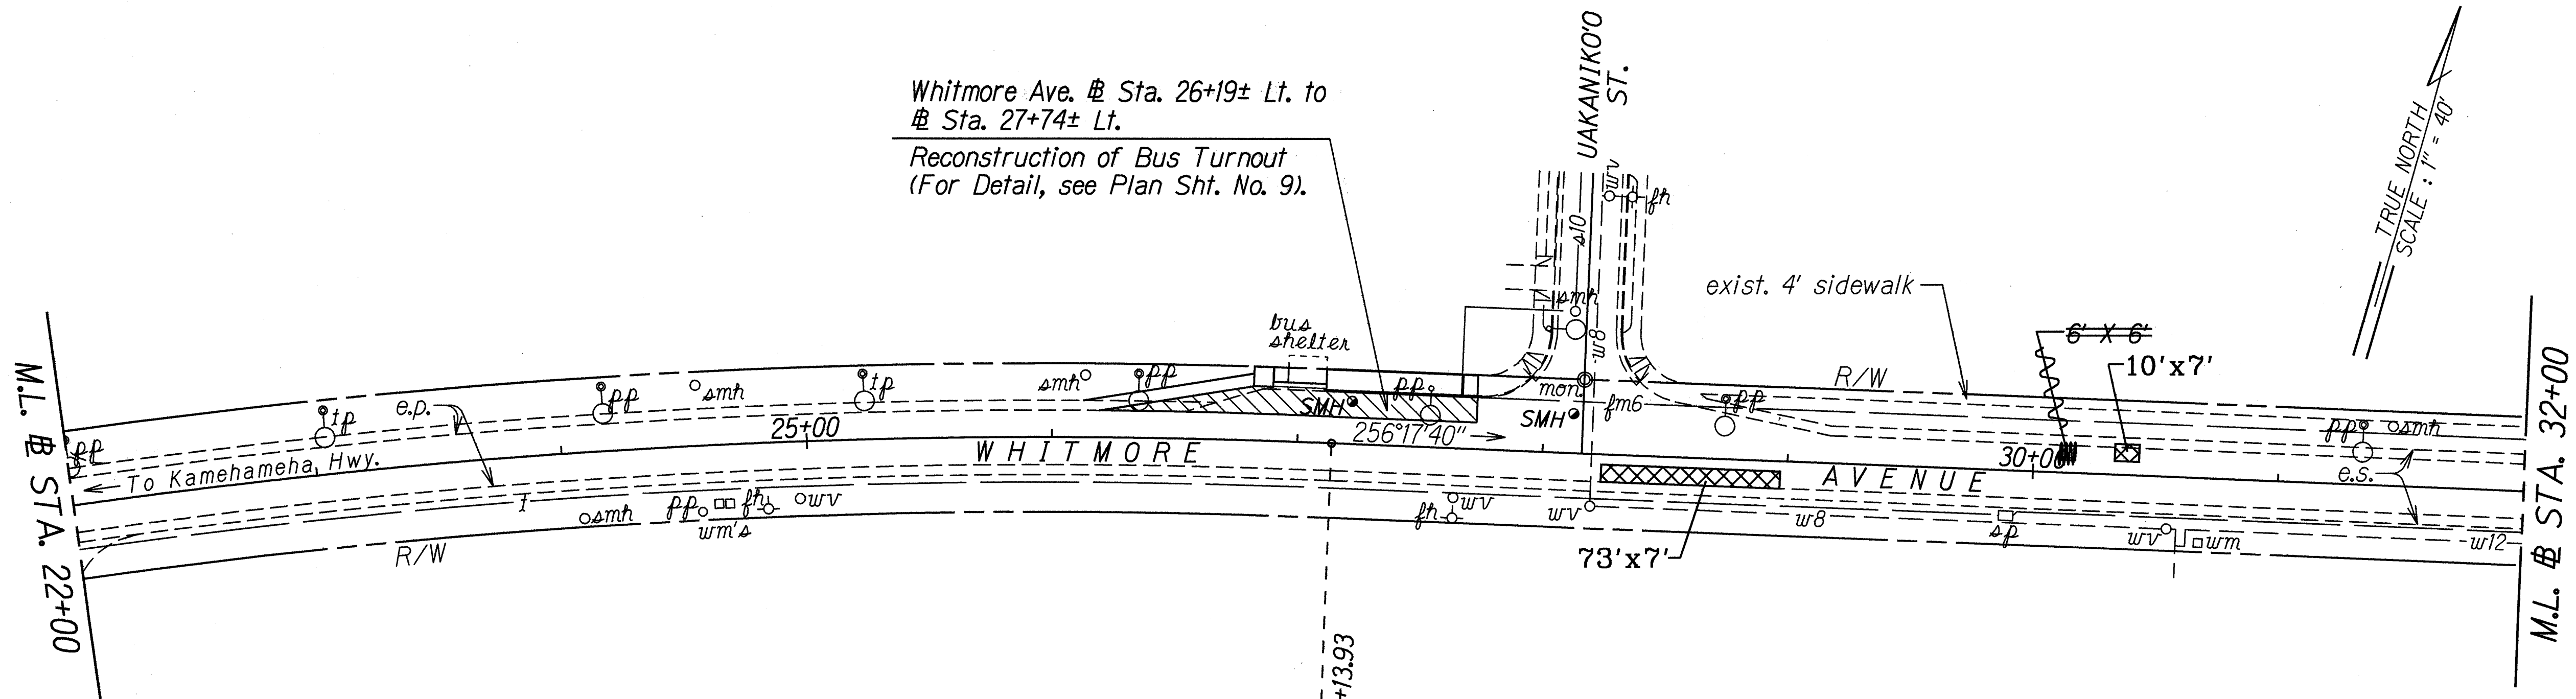

ORIGINAL PLAN	DATE
4-20-99	
TRACED BY	
NOTES BOOK	
REVISIONS	
CHECKED BY	
DATE	

Reconstruct exist. bus turnout w/New 11" Plant Mix Glassphalt Concrete Base Course and New 2 1/2" A.C. Pav't, Mix No. IV

LEGEND FOR AS-BUILT POSTINGS	
	Squiggly line for as-built deletion
	Double line for as-built deletion
Roadway	Text for as-built posting


4-20-99	Added Bus Turnout Reconstruction @ Sta. 35+56± Lt.
DATE	REVISION
SHEET No. 2 OF 5 SHEETS	

STATE OF HAWAII
DEPARTMENT OF TRANSPORTATION
HIGHWAYS DIVISION

PLAN
WHITMORE AVENUE RESURFACING
Kamehameha Highway to Military Gate
Proj. No. 7012A-01-98M
Scale: 1" = 40'

Date: Jan. 1998

FED. ROAD DIST. NO.	STATE	PROJ. NO.	FISCAL YEAR	SHEET NO.	TOTAL SHEETS
HAWAII	HAW.	7012A-01-98M	1999	12	32

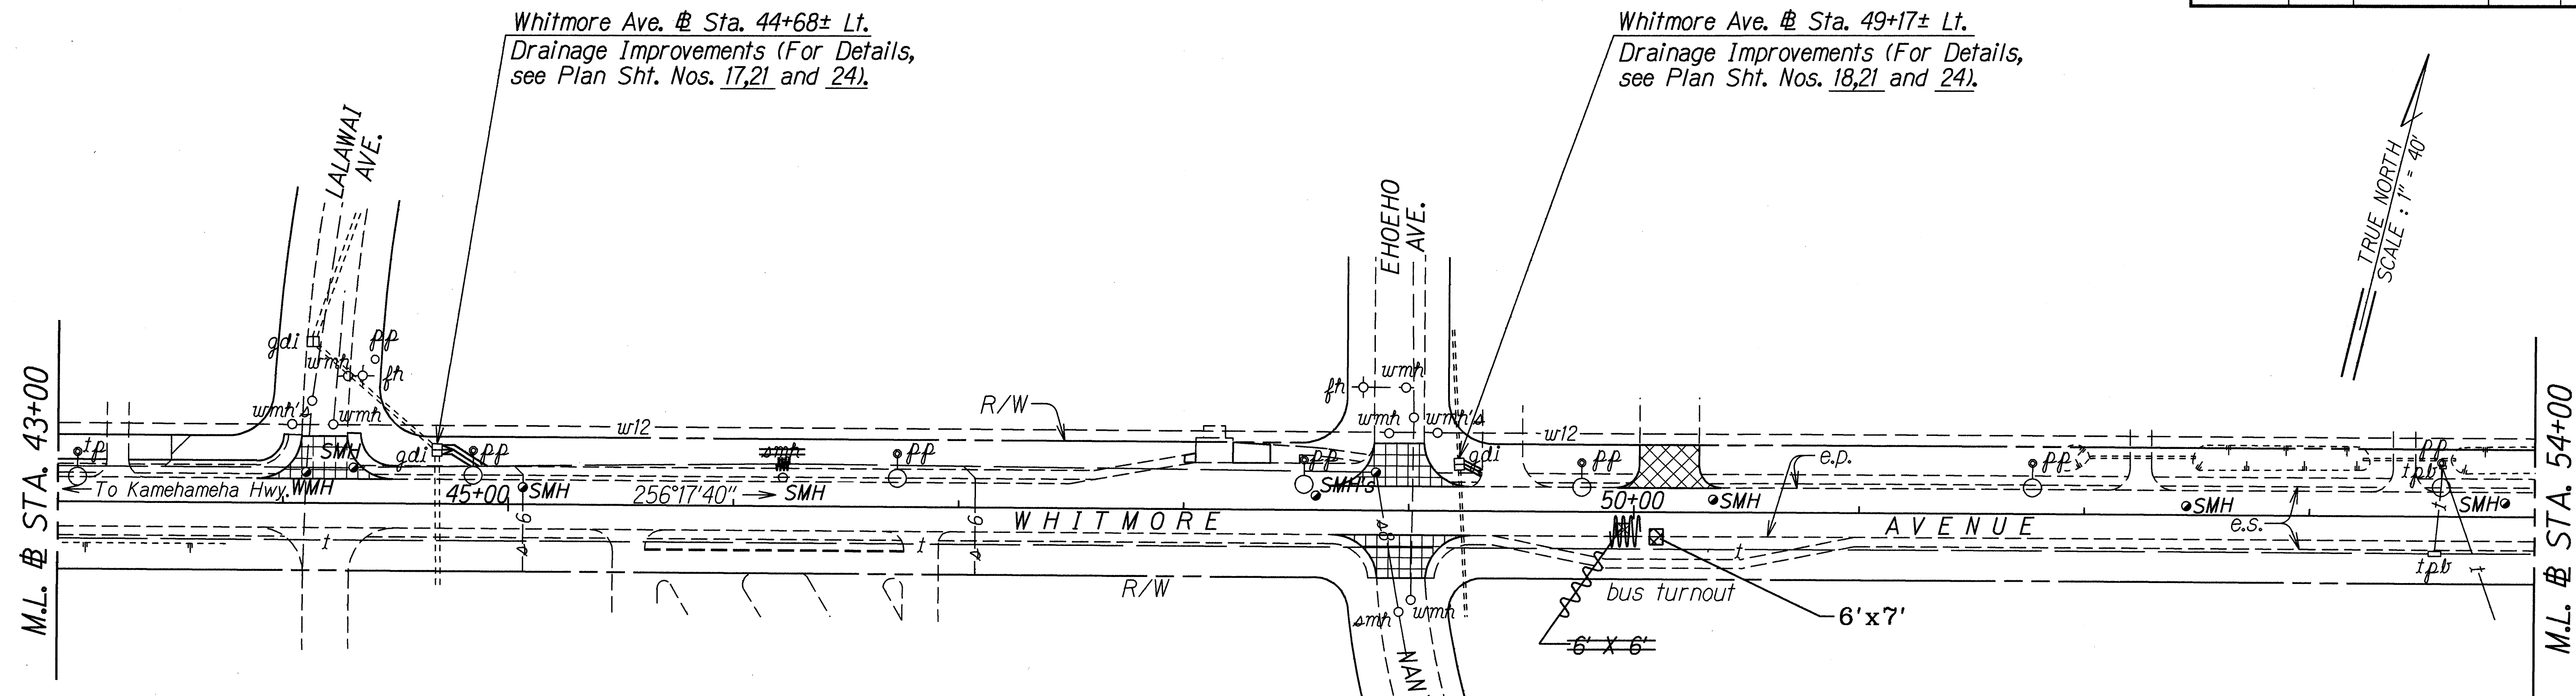

Whitmore Ave. @ Sta. 54+74± Lt.
Drainage Improvements (For Details, see Plan Sht. Nos. 19 and 22).

Whitmore Ave. @ Sta. 55+27± Lt.
Type 61614P Grates
(For Details see Plan Sht. No. 23)

CURVE DATA

$\Delta = 4^\circ 24' 40''$
 $R = 5,729.58'$
 $T = 220.66'$
 $L = 441.11'$
 $S.E. = 0.024'/ft.$

Remove existing
Type 61614 grates.

exist. conc. driveway
w/3' shoulder. See
reconstruction detail
on Plan Sht. No. 7.

exist. conc.
driveway w/
6' shoulder


exist. conc. drwy.
w/no shoulder

Reconstruct exist Driveway.
See Details below.

4' Wide
AC Swale

LEGEND FOR AS-BUILT POSTINGS

~~~~~ Squiggly line for as-built deletion  
 === Double line for as-built deletion  
 Roadway Text for as-built posting

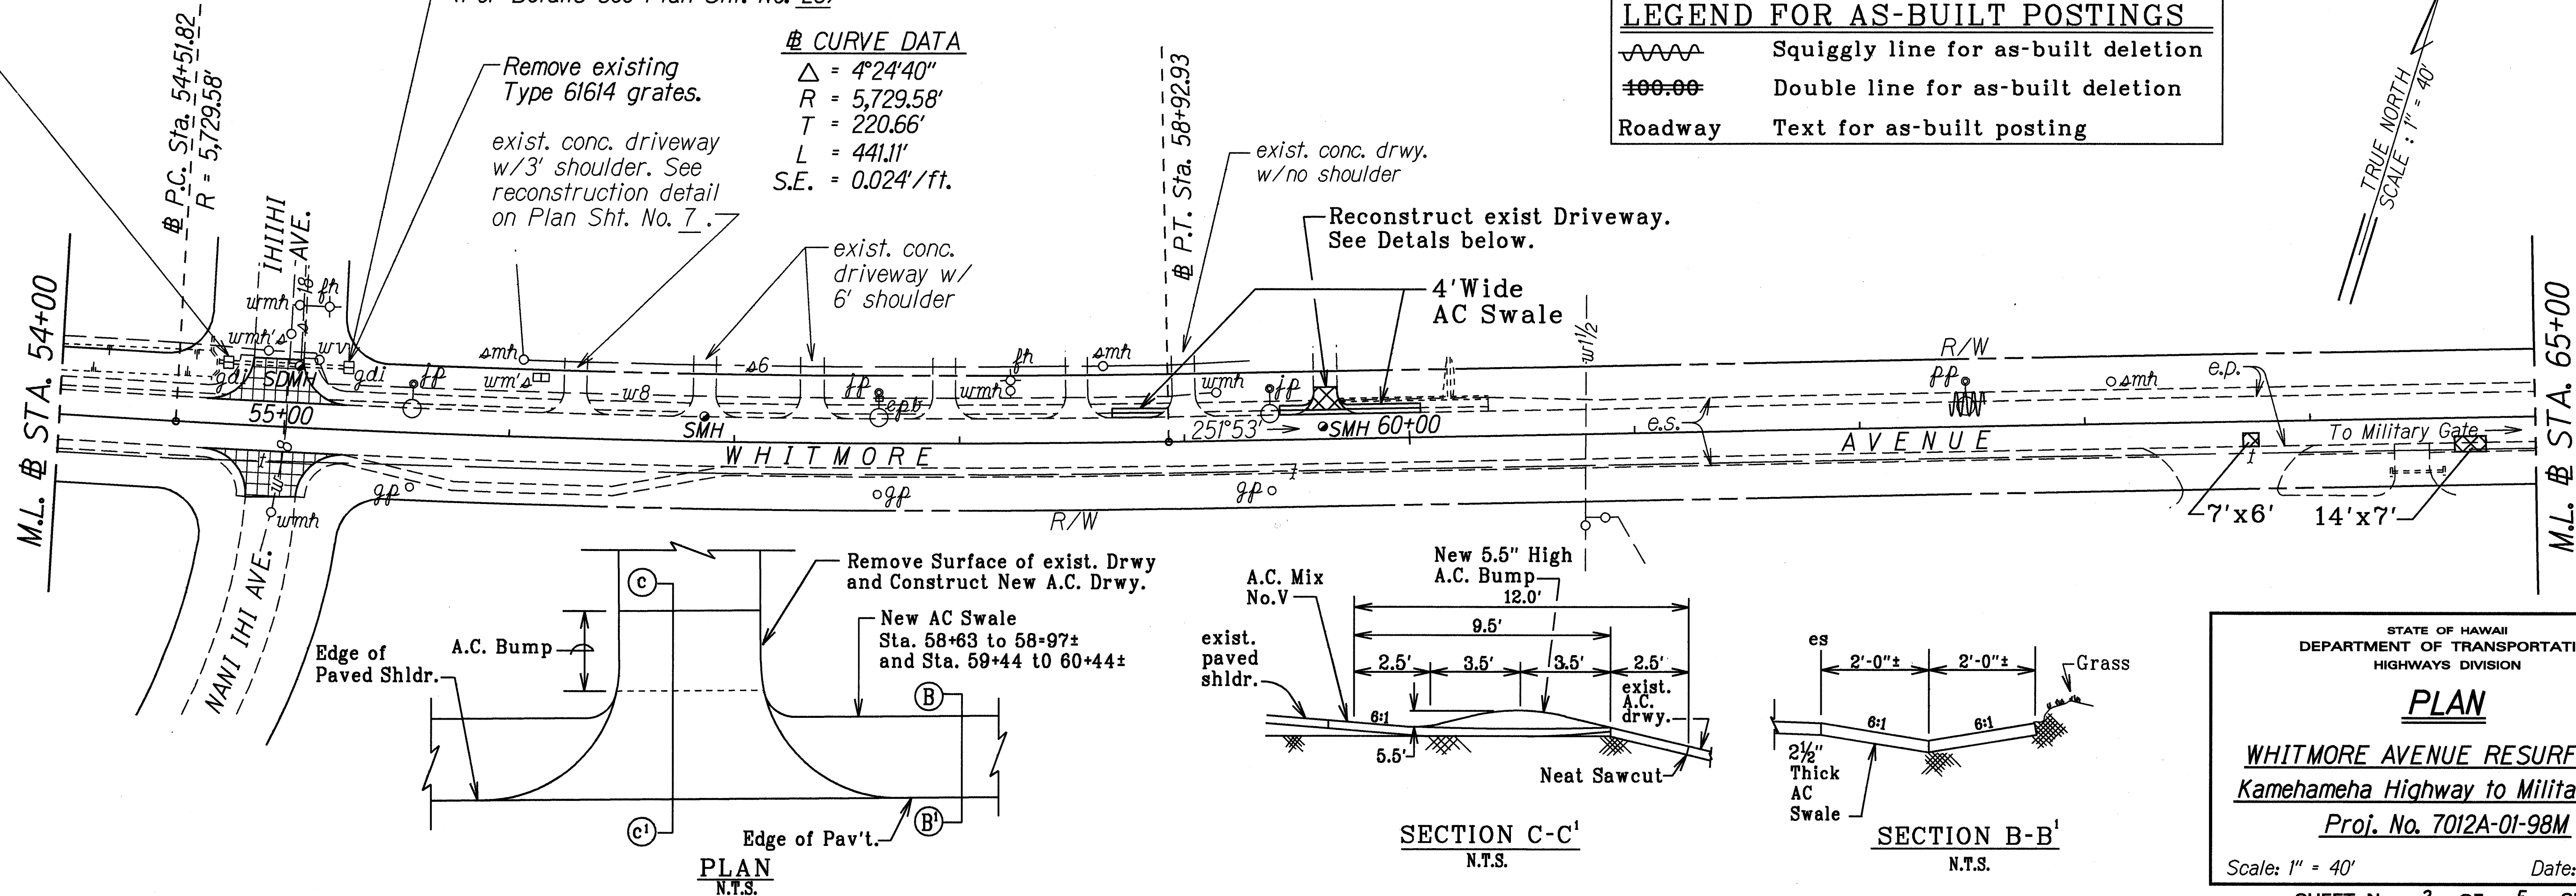

|               |        |
|---------------|--------|
| ORIGINAL PLAN | DATE   |
| NOV 1998      | 7-7-98 |
| DESIGNED BY   |        |
| CHECKED BY    |        |
| APPROVED BY   |        |

STATE OF HAWAII  
DEPARTMENT OF TRANSPORTATION  
HIGHWAYS DIVISION

**PLAN**


**WHITMORE AVENUE RESURFACING**  
Kamehameha Highway to Military Gate  
Proj. No. 7012A-01-98M

Scale: 1" = 40' Date: Jan. 1998


SHEET No. 3 OF 5 SHEETS

"AS-BUILT"

| FED. ROAD DIST. NO. | STATE | PROJ. NO.    | FISCAL YEAR | SHEET NO. | TOTAL SHEETS |
|---------------------|-------|--------------|-------------|-----------|--------------|
| HAWAII              | HAW.  | 7012A-01-98M | 1999        | 13        | 32           |

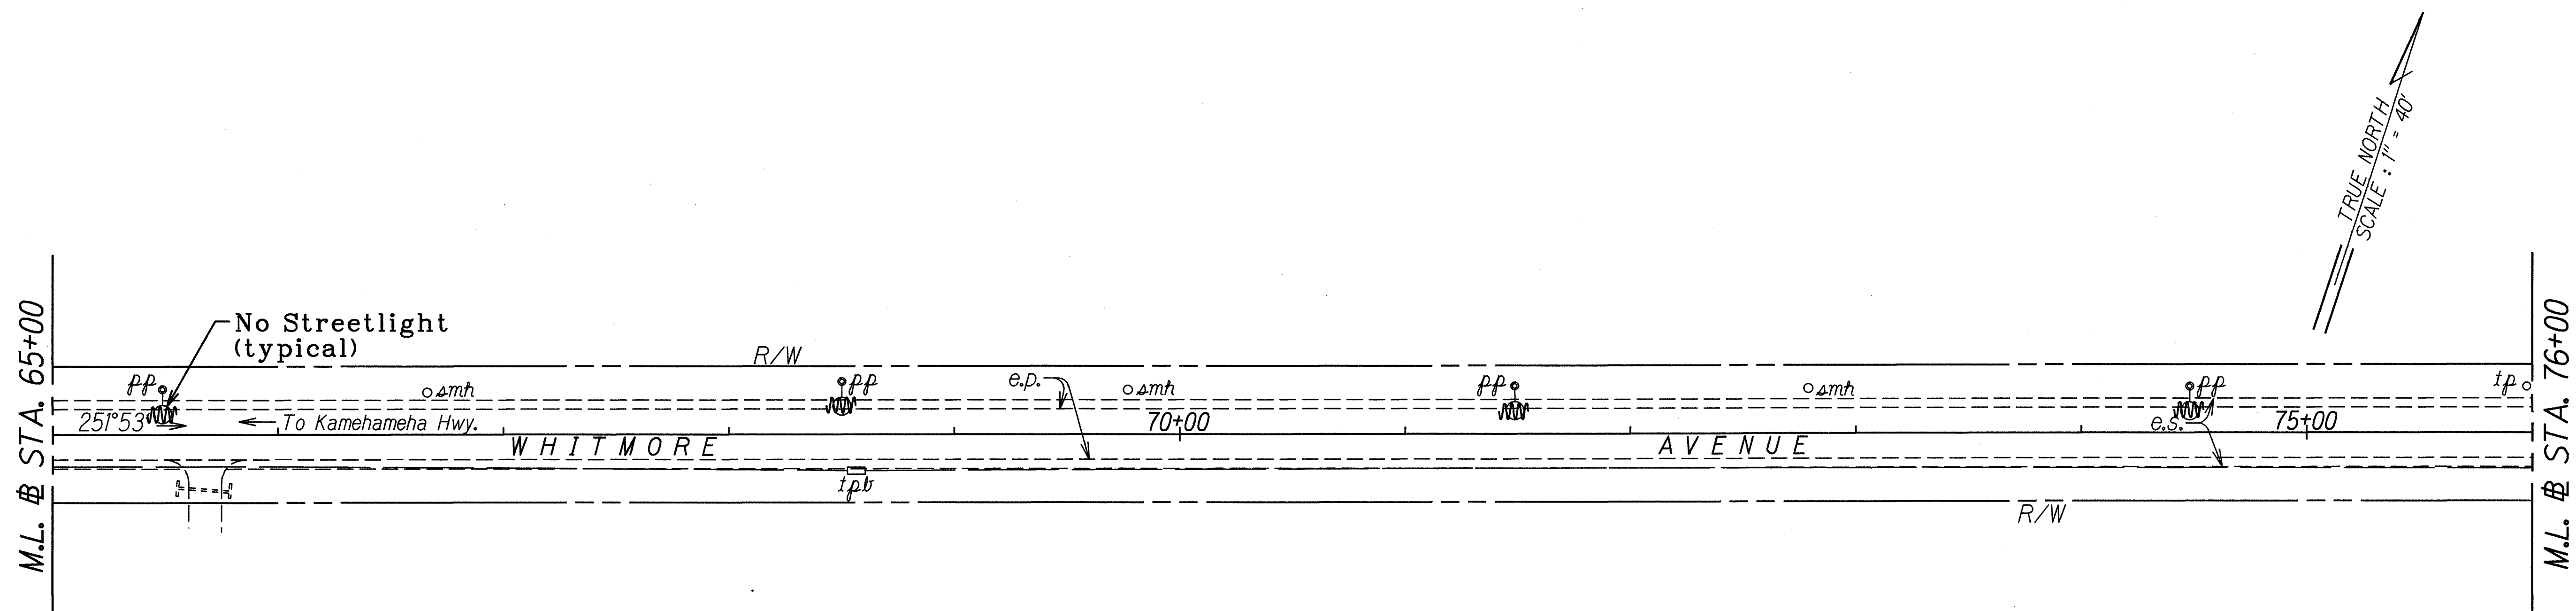

Resurface over exist. pav't w/  
New 2 1/2" A.C. Pav't, Mix No. IV

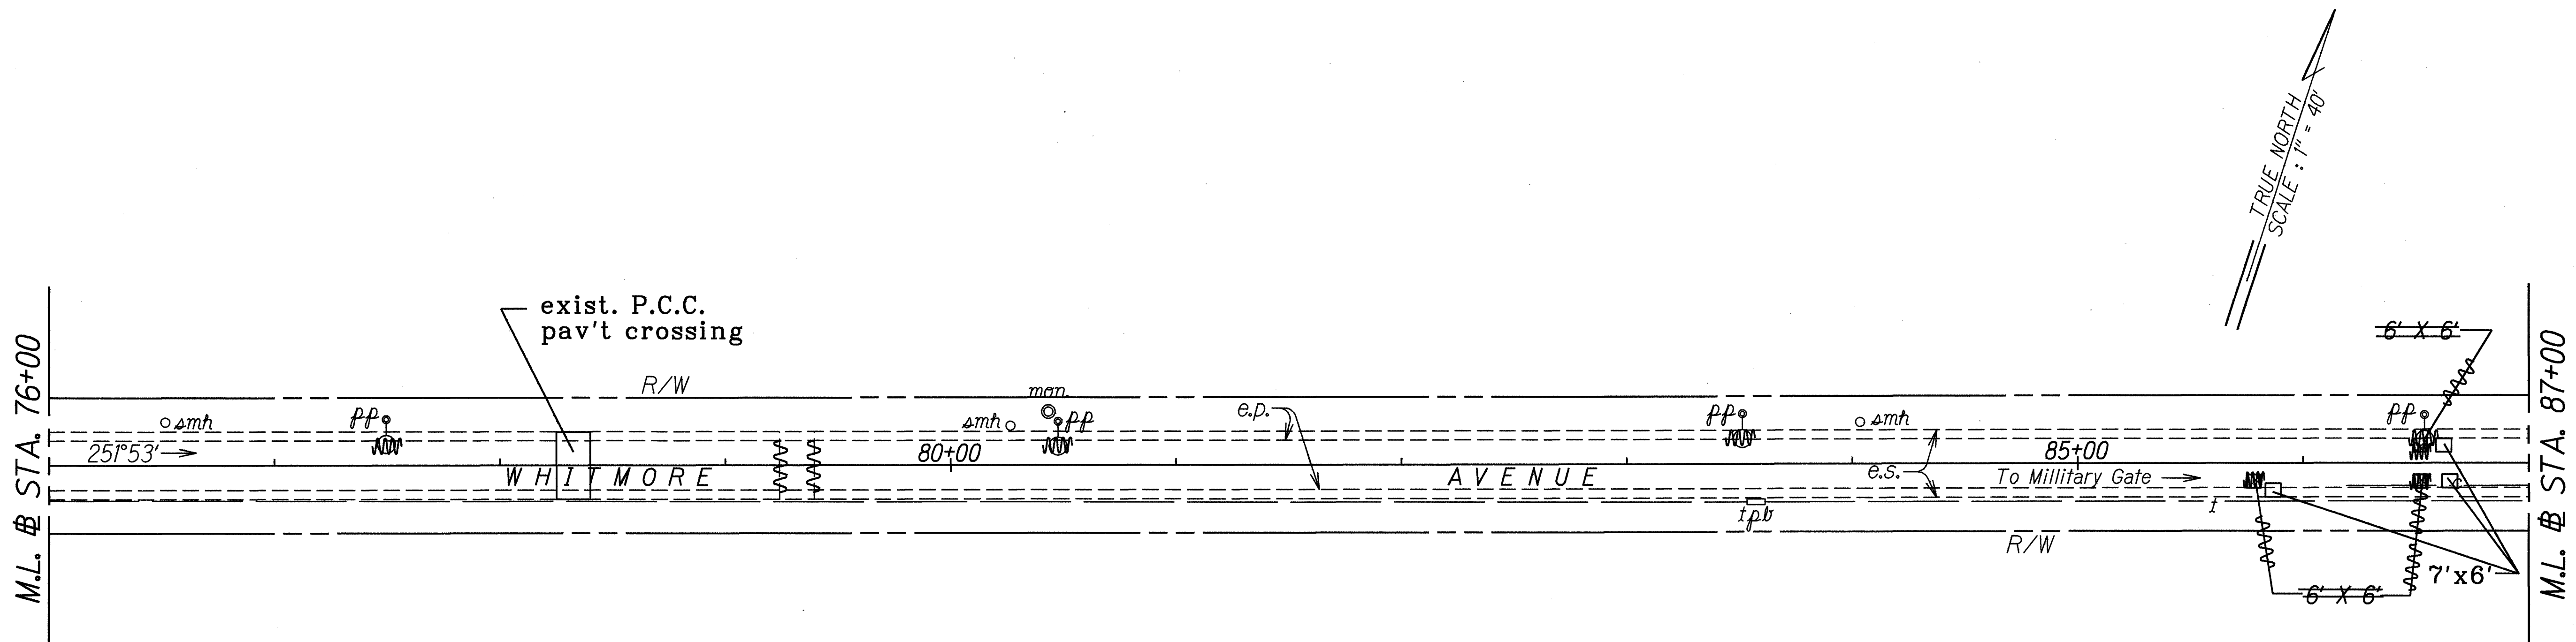

|               |                   |        |
|---------------|-------------------|--------|
| ORIGINAL PLAN | SURVEY PLOTTED BY | DATE   |
| NOTES BOOK    | DRAWN BY          | 6-9-98 |
| 6/11/98       | CHECKED BY        |        |
| 6/11/98       | DESIGNED BY       |        |
| 6/11/98       | CHECKED BY        |        |

#### LEGEND FOR AS-BUILT POSTINGS

|         |                                     |
|---------|-------------------------------------|
|         | Squiggly line for as-built deletion |
|         | Double line for as-built deletion   |
| Roadway | Text for as-built posting           |

STATE OF HAWAII  
DEPARTMENT OF TRANSPORTATION  
HIGHWAYS DIVISION

**PLAN**


**WHITMORE AVENUE RESURFACING**  
**Kamehameha Highway to Military Gate**  
**Proj. No. 7012A-01-98M**

Scale: 1" = 40' Date: Jan. 1998


SHEET No. 4 OF 5 SHEETS

"AS-BUILT"

| FED. ROAD DIST. NO. | STATE | PROJ. NO.    | FISCAL YEAR | SHEET NO. | TOTAL SHEETS |
|---------------------|-------|--------------|-------------|-----------|--------------|
| HAWAII              | HAW.  | 7012A-01-98M | 1999        | 14        | 32           |

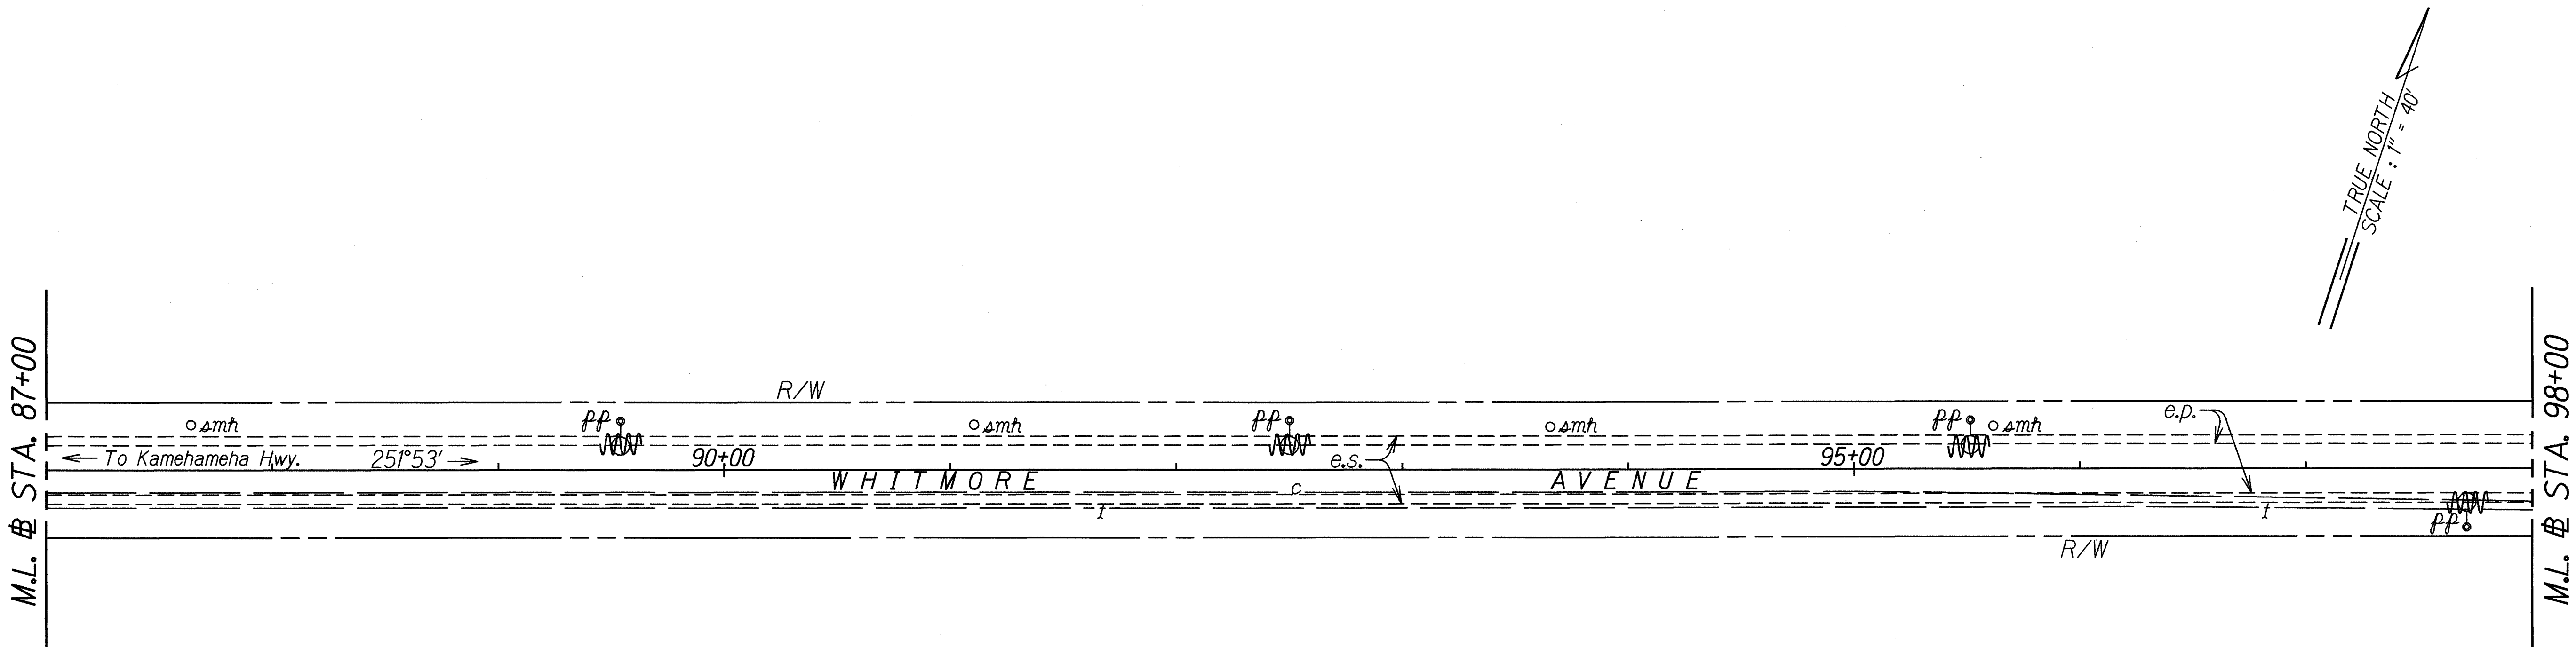

Resurface over exist. pav't w/  
New 2½" A.C. Pav't, Mix No. IV.

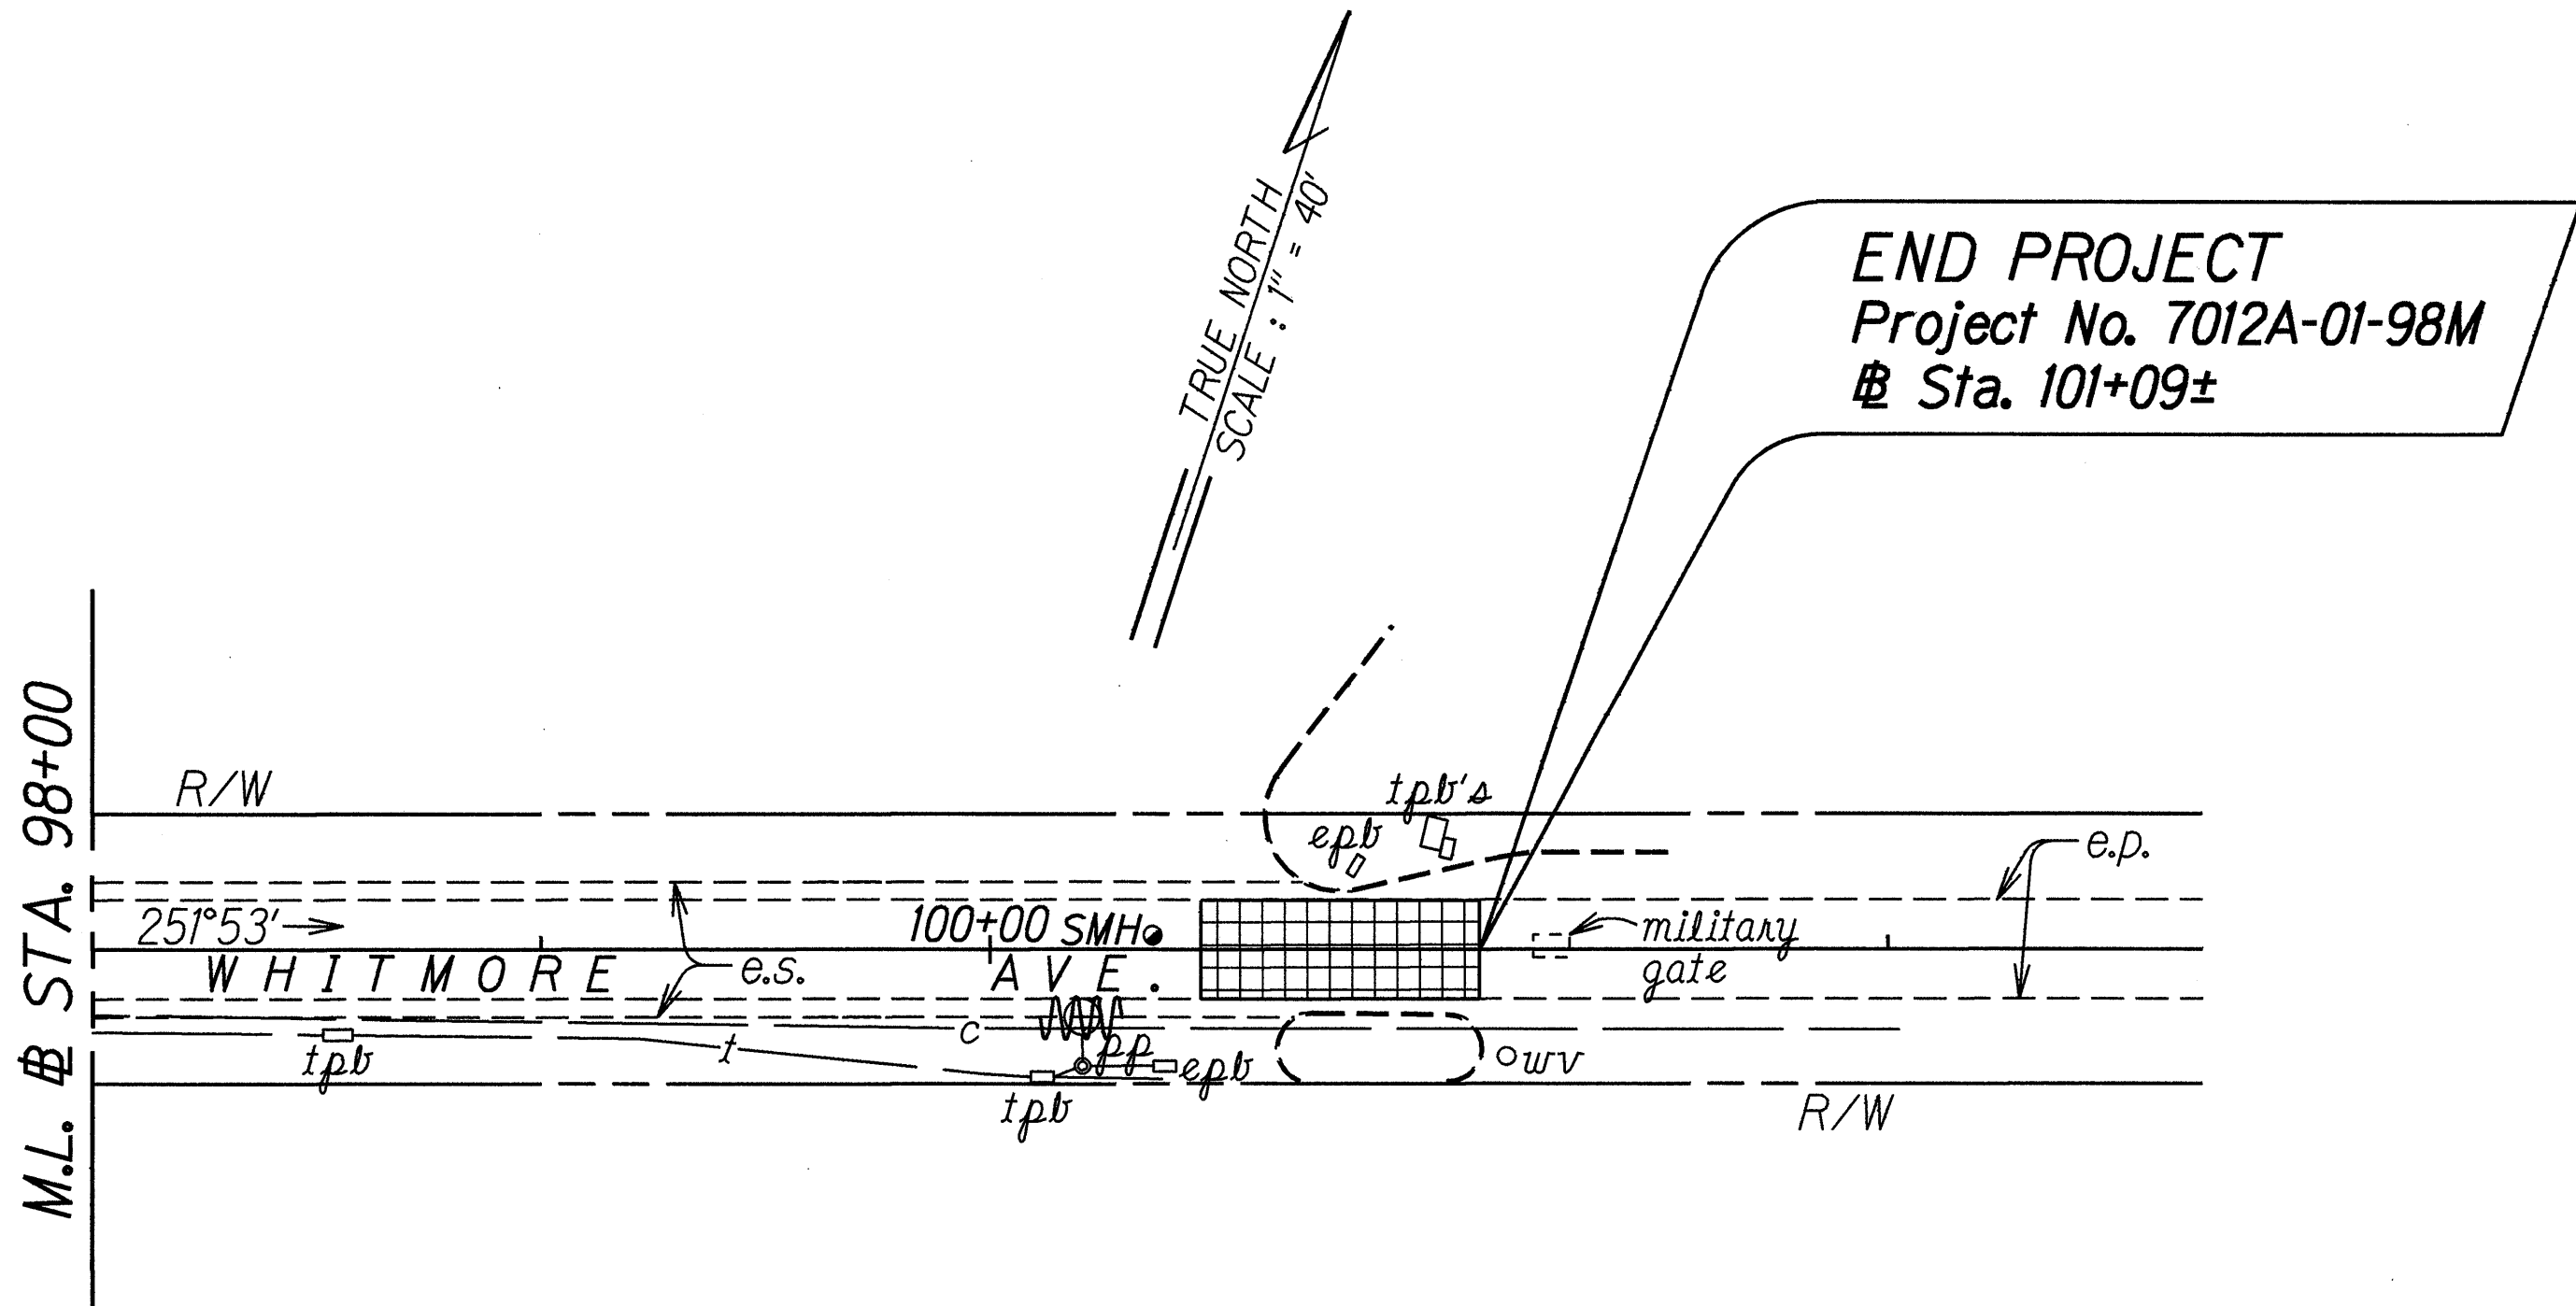

|               |                   |         |
|---------------|-------------------|---------|
| ORIGINAL PLAN | SURVEY PLOTTED BY | DATE    |
| NOTED         | DRAWN BY          | 6-19-98 |
| ddm           | TRACED BY         |         |
| ddm           | DESIGNED BY       |         |
| ddm           | CHECKED BY        |         |

| LEGEND FOR<br>AS-BUILT POSTINGS |                                     |
|---------------------------------|-------------------------------------|
|                                 | Squiggly line for as-built deletion |
|                                 | Double line for as-built deletion   |
| Roadway                         | Text for as-built posting           |

STATE OF HAWAII  
DEPARTMENT OF TRANSPORTATION  
HIGHWAYS DIVISION

### PLAN

**WHITMORE AVENUE RESURFACING**  
Kamehameha Highway to Military Gate  
Proj. No. 7012A-01-98M

Scale: 1" = 40'      Date: Jan. 1998

SHEET No. 5 OF 5 SHEETS