

STATE OF HAWAII

DEPARTMENT OF TRANSPORTATION

HIGHWAYS DIVISION HONOLULU, HAWAII


"AS-BUILT"

PLANS FOR

WHITMORE AVENUE RESURFACING

KAMEHAMEHA HIGHWAY TO MILITARY GATE PROJECT NO. 7012A-01-98M

DISTRICT OF WAHIAWA ISLAND OF OAHU

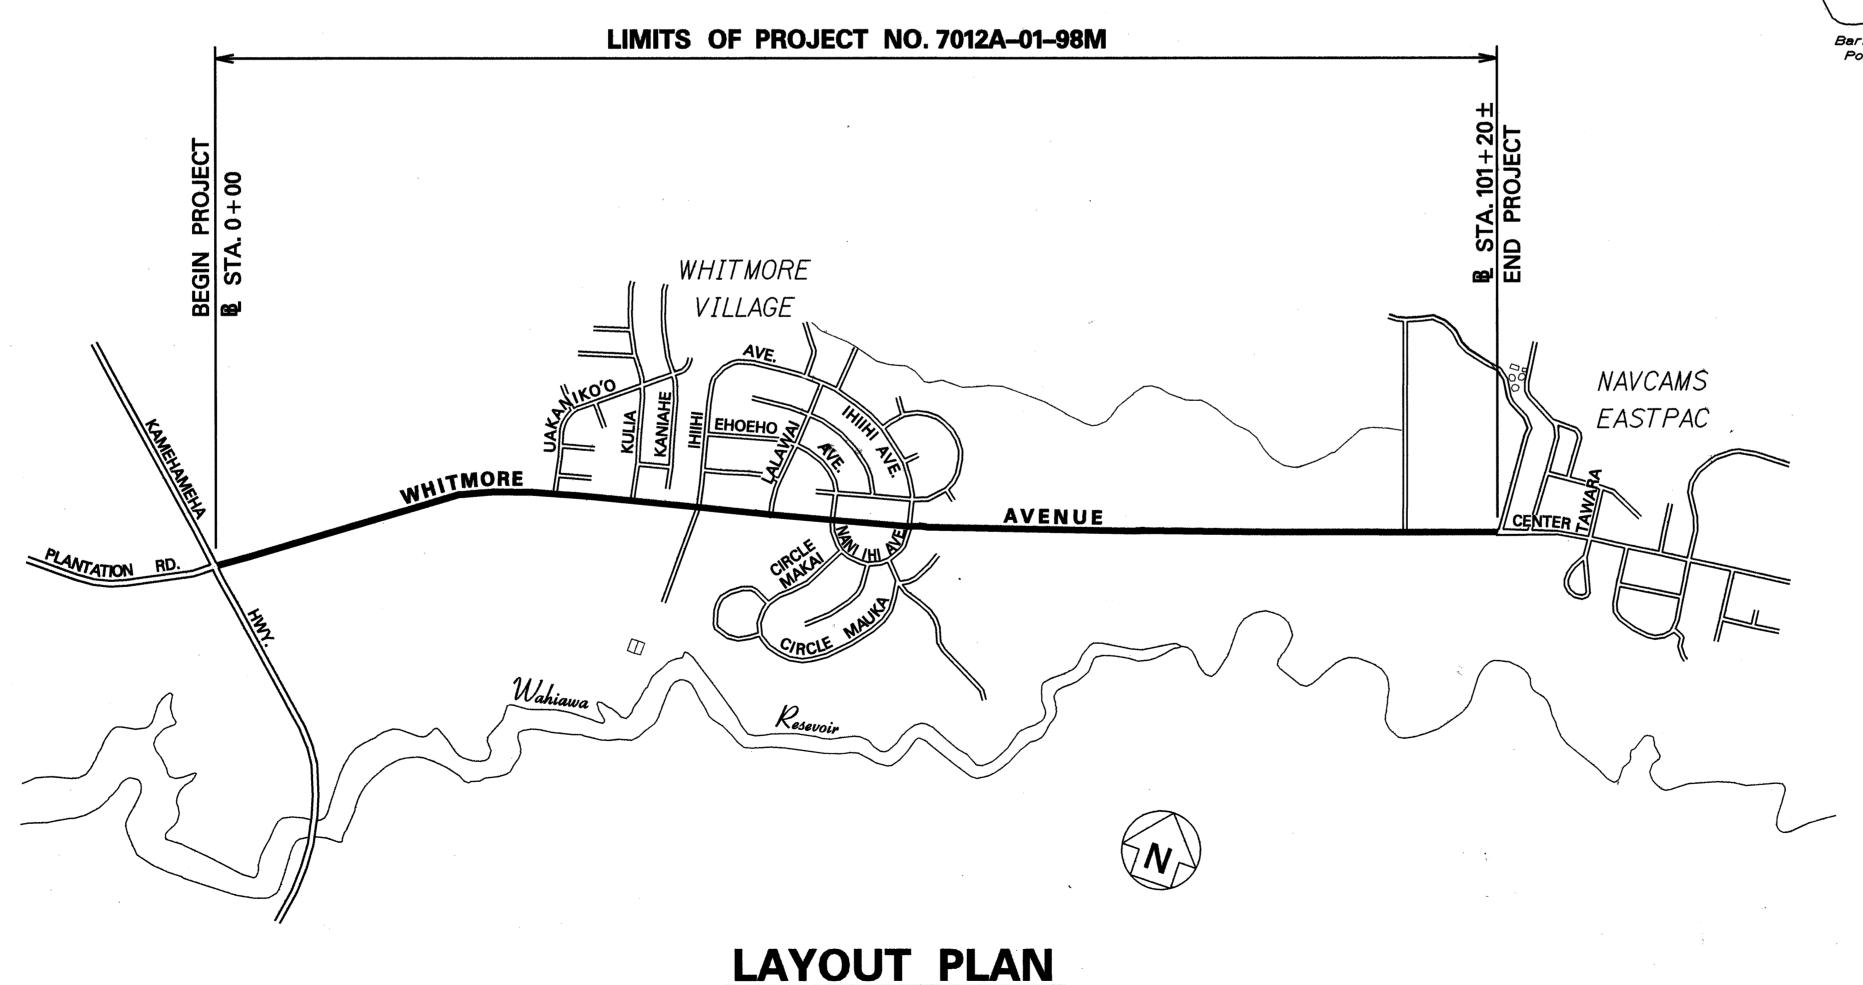

GROSS LENGTH OF PROJECT.....1.913 MILES

NET LENGTH OF PROJECT..... 1.913 MILES

SCALE IN HUNDRED FEET

Walanse Walans

FED. ROAD DIST. NO.

STATE

PROJ. NO.

HAW. 7012A-01-98M 1999

MILE POST 0.00 TO MILE POST 1.913

SCALE IN MILES

CHANGES MADE DURING CONSTRUCTION HAVE BEEN INCORPORATED ON THESE PLANS EXCEPT CHANGES IN THE ORIGINAL THEORETICAL QUANTITIES. FOR ACTUAL QUANTITIES, REFER TO PROJECT LEDGER AND/OR COMPUTATION BOOK.

RESIDENT ENGINEER DATE

DEPARTMENT OF TRANSPORTATION STATE OF HAWAII

APPROVED:

Kazn begalich

DIR. OF TRANSPORTATION

DATE

g

Eng.: L Dra.:

ddl.mh Iwtmdtsht

1