




FED. ROAD DIST. NO.	STATE	PROJ. NO.	FISCAL YEAR	SHEET NO.	TOTAL SHEETS
HAWAII	HAW.	7012A-01-98M	1999	4	32

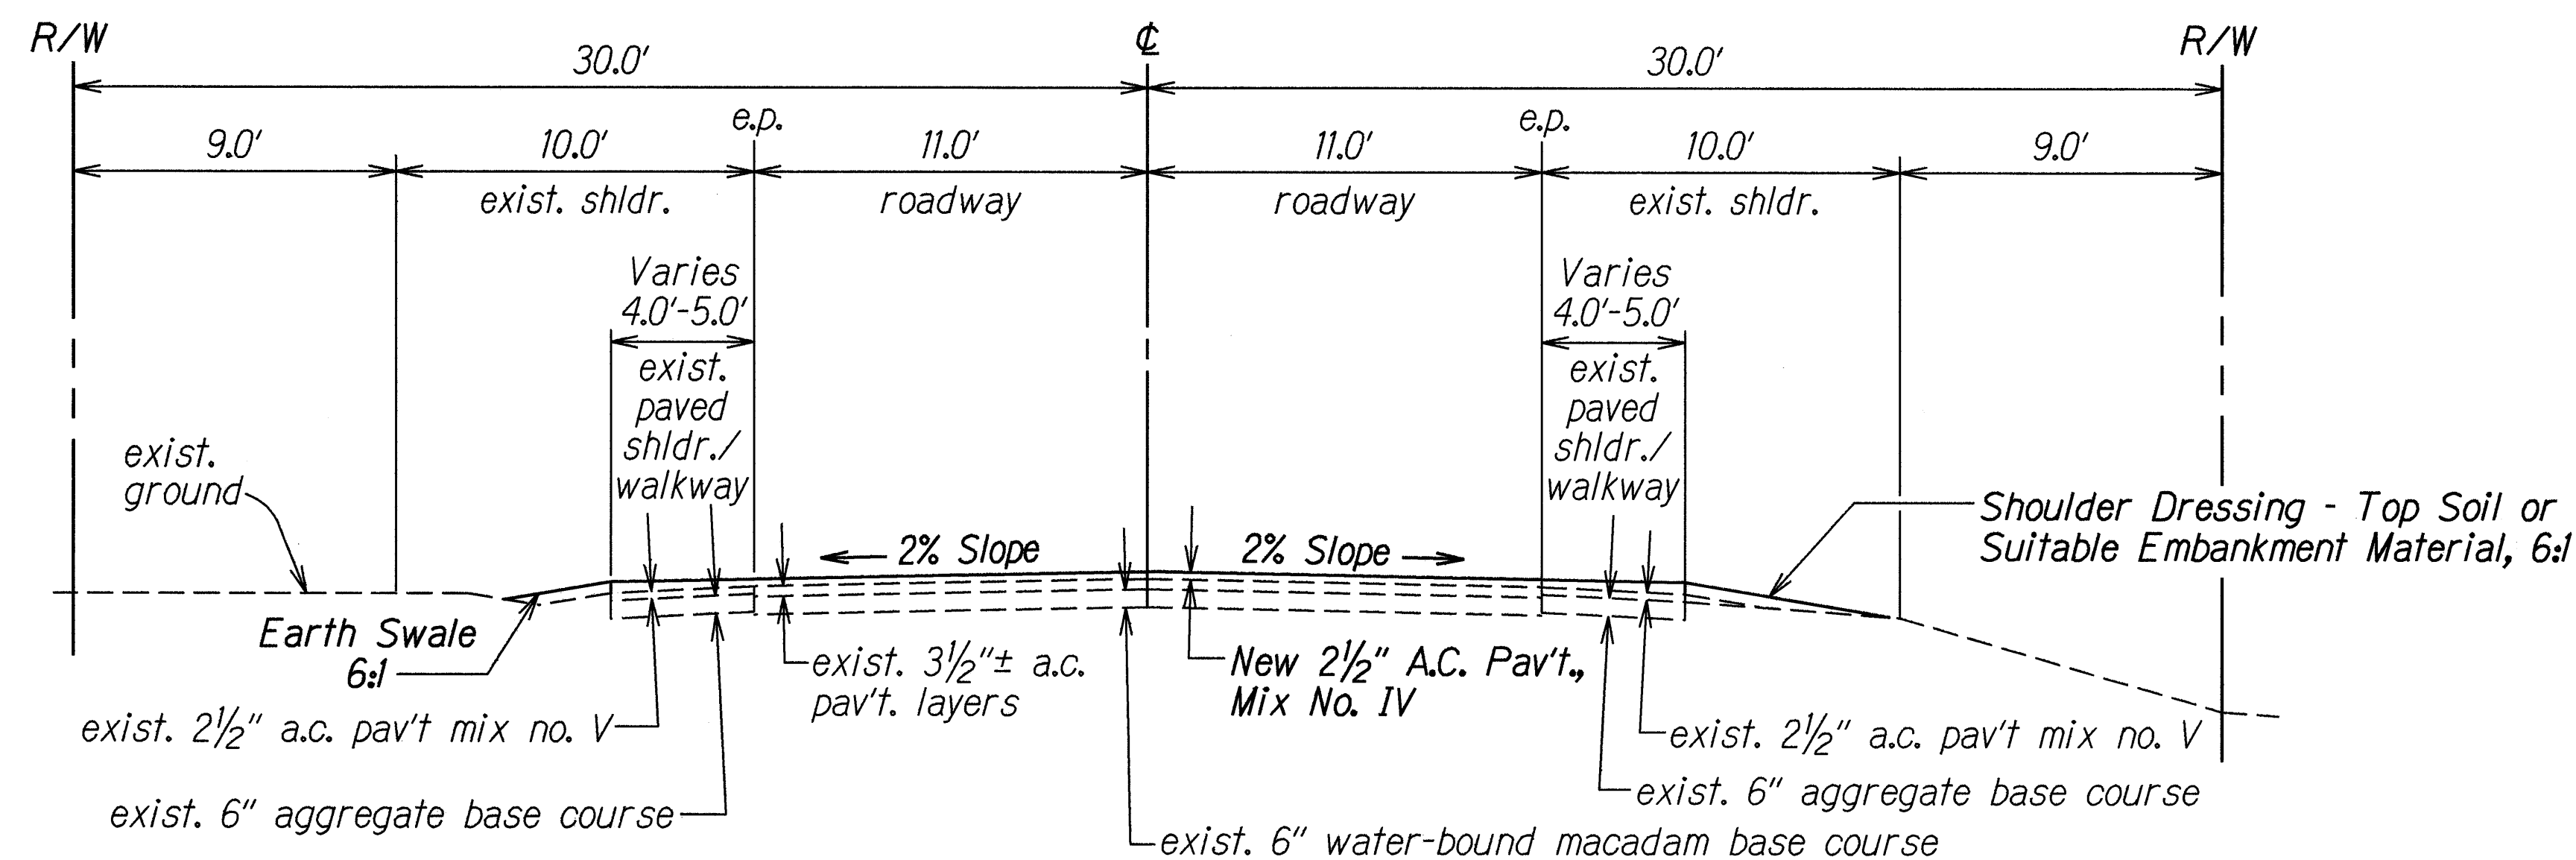

TYPICAL TANGENT SECTION
Scale: 1/4"=1.0'

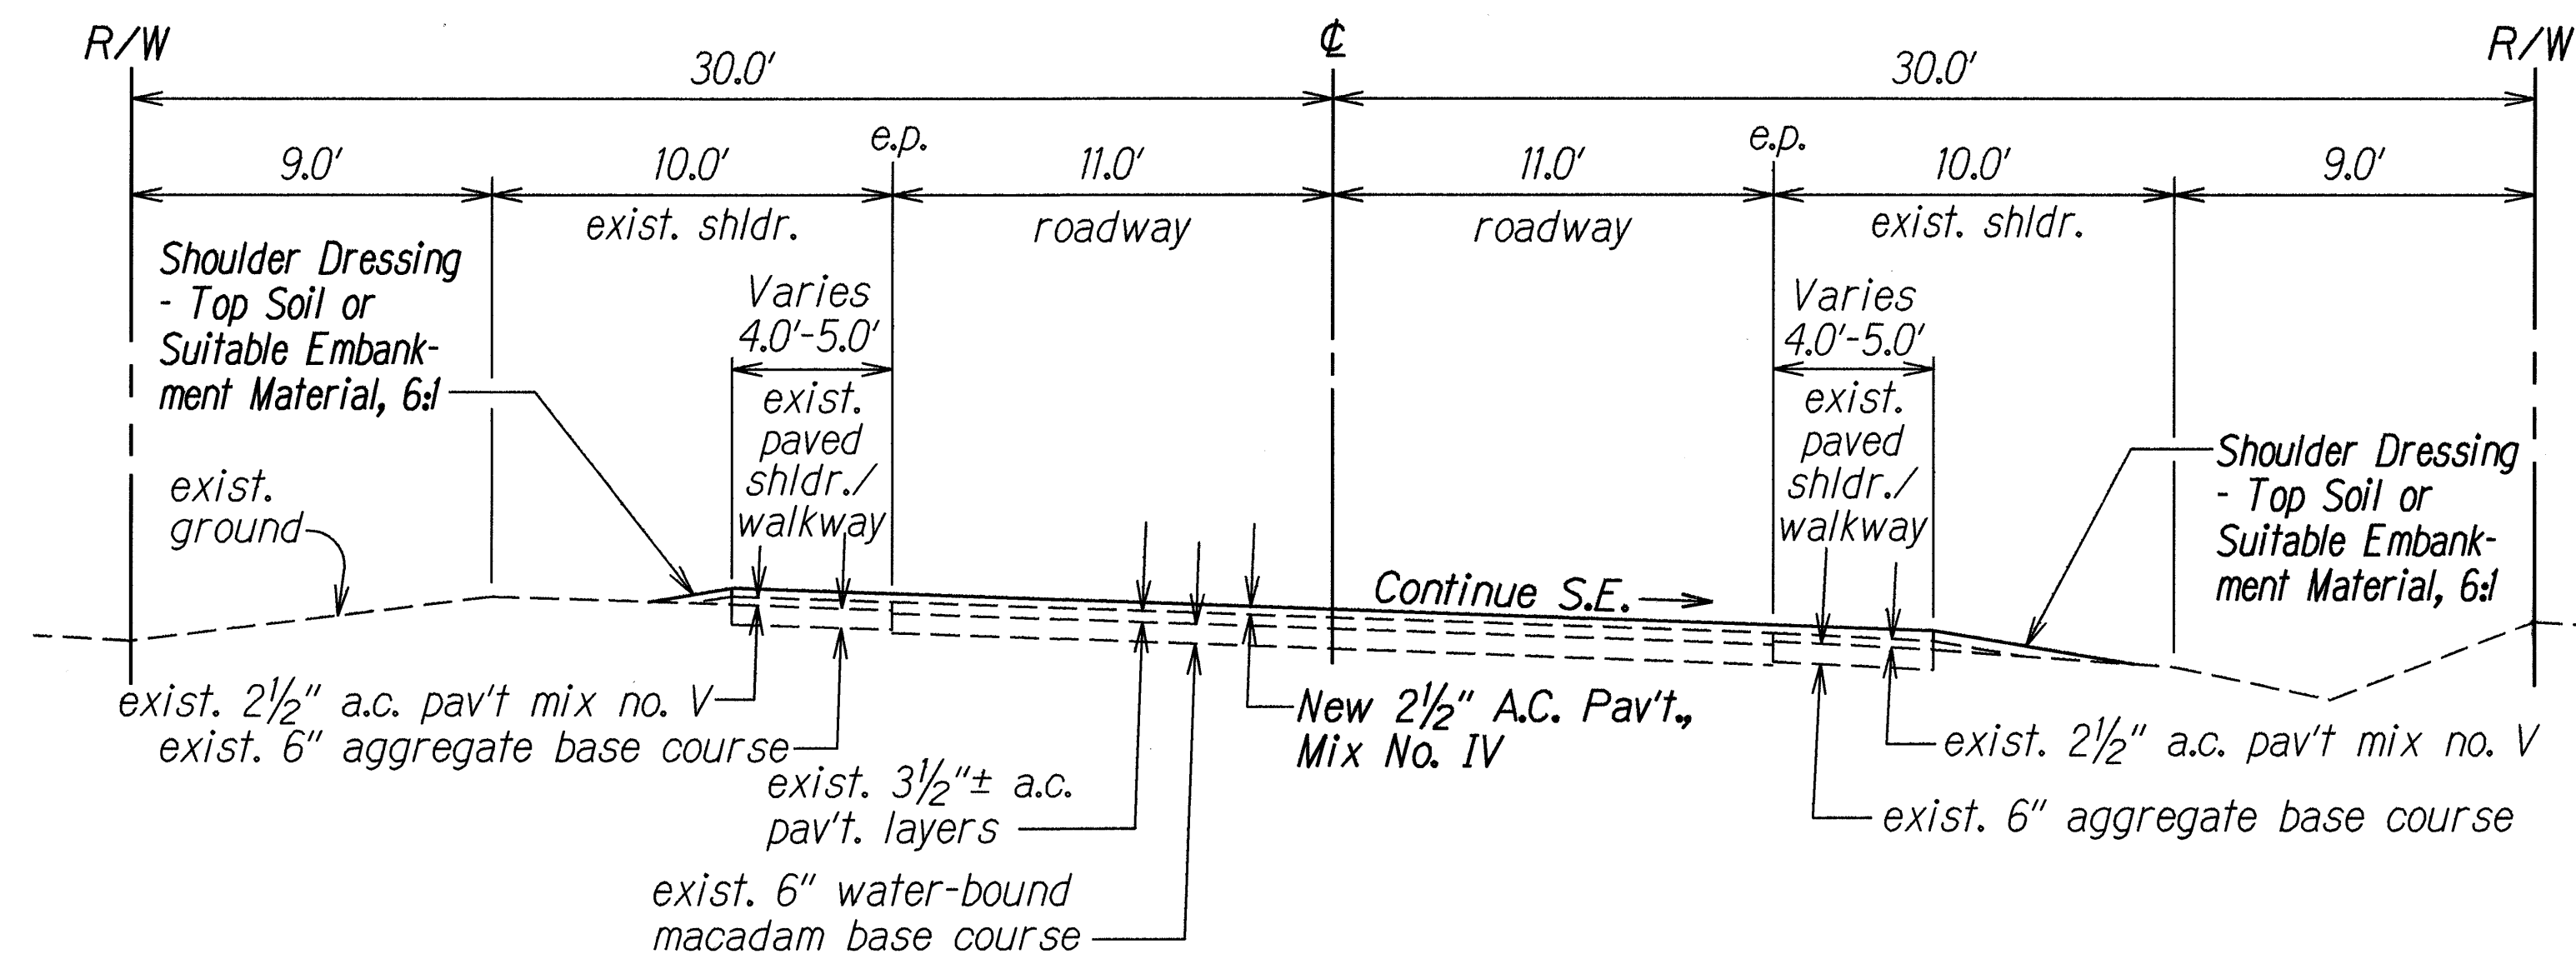

TYPICAL CURVE SECTION
Scale: 1/4"=1.0'

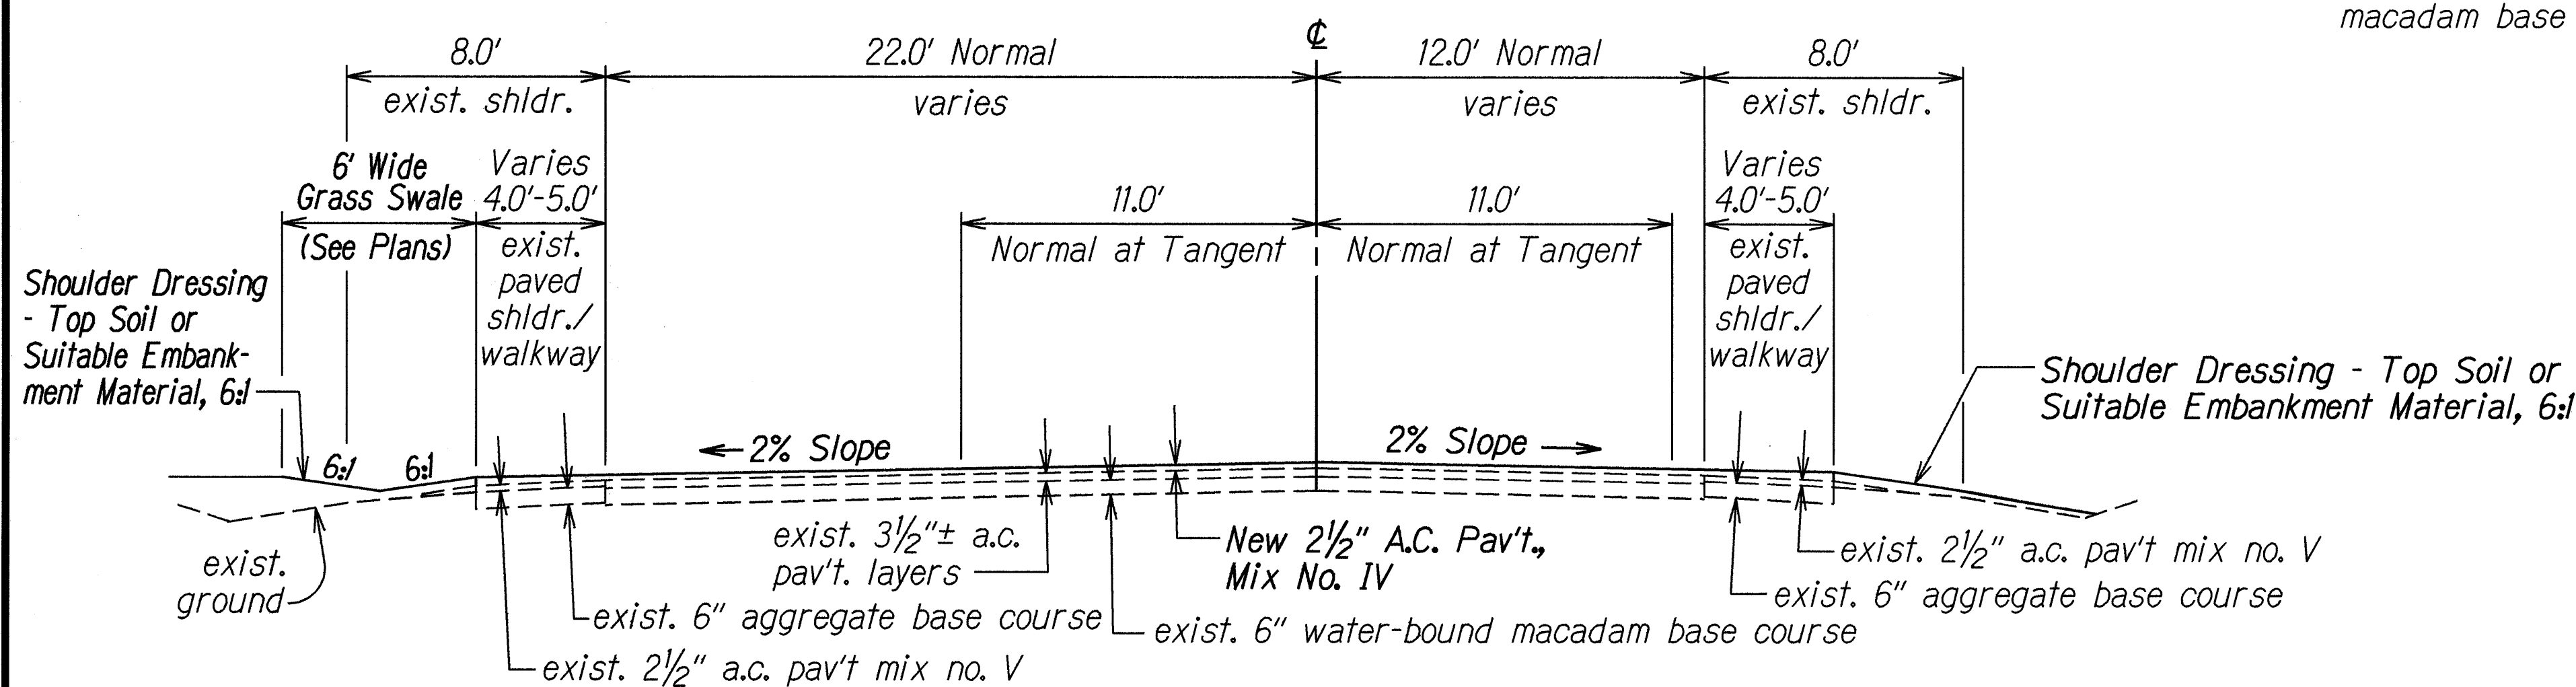

TYPICAL SECTION
CL STA. 0+67± TO CL STA. 4+00±
Scale: 1/4"=1.0'

DATE	7-28-99
SURVEY PLOTTED BY	L. Mitsuhashi, M.H.T.S.
DRAWN BY	L. Mitsuhashi, M.H.T.S.
DESIGNED BY	L. Suzuki
CHECKED BY	L. Suzuki
ORIGINAL PLAN	NO. 1
NOTE BOOK	NO. 1
REVISIONS	NO. 1

STATE OF HAWAII
DEPARTMENT OF TRANSPORTATION
HIGHWAYS DIVISION


TYPICAL SECTIONS

WHITMORE AVENUE RESURFACING
Kamehameha Highway to Military Gate
Proj. No. 7012A-01-98M

Scale: As Noted Date: Jan. 1999


SHEET No. 1 OF 6 SHEETS

FED. ROAD DIST. NO.	STATE	PROJ. NO.	FISCAL YEAR	SHEET NO.	TOTAL SHEETS
HAWAII	HAW.	7012A-01-98M	1999	5	32

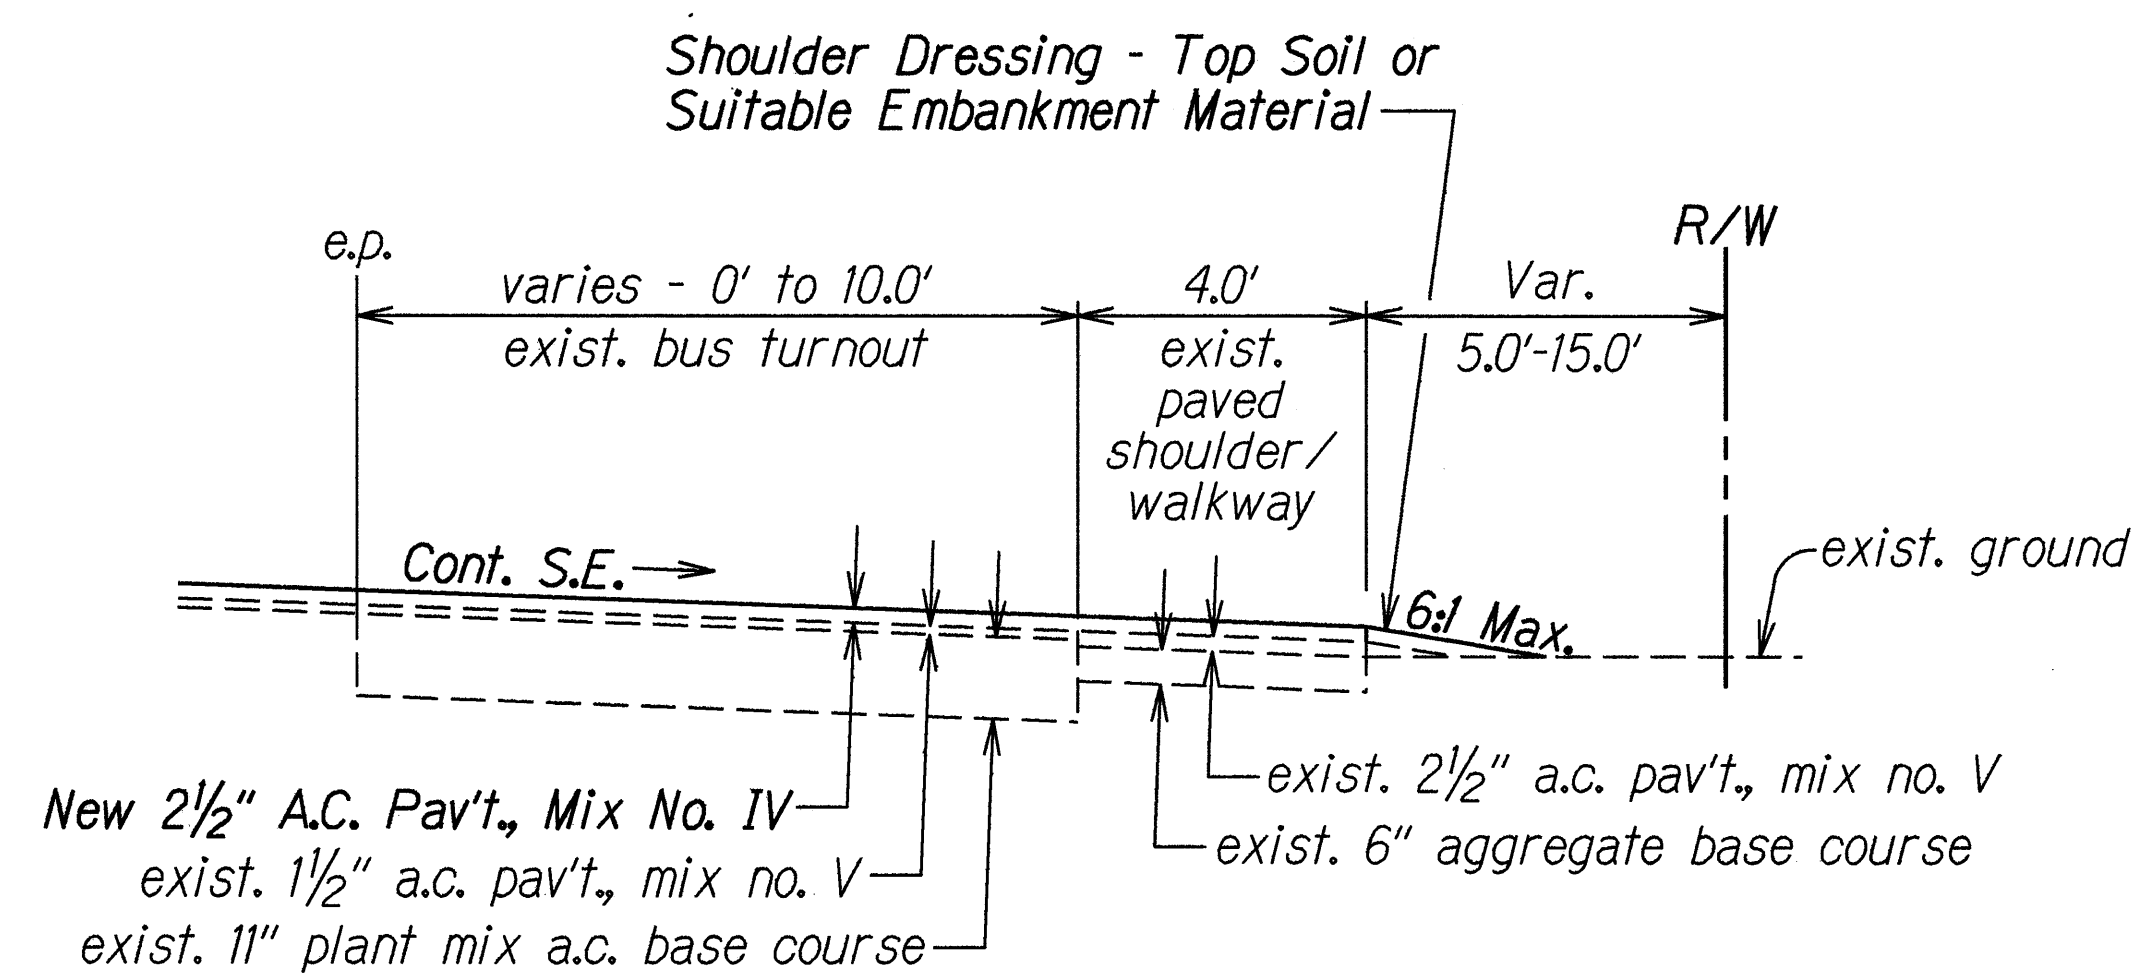


**TYPICAL SECTION
AT BUS TURNOUT**

Scale: 3/8"=1.0'

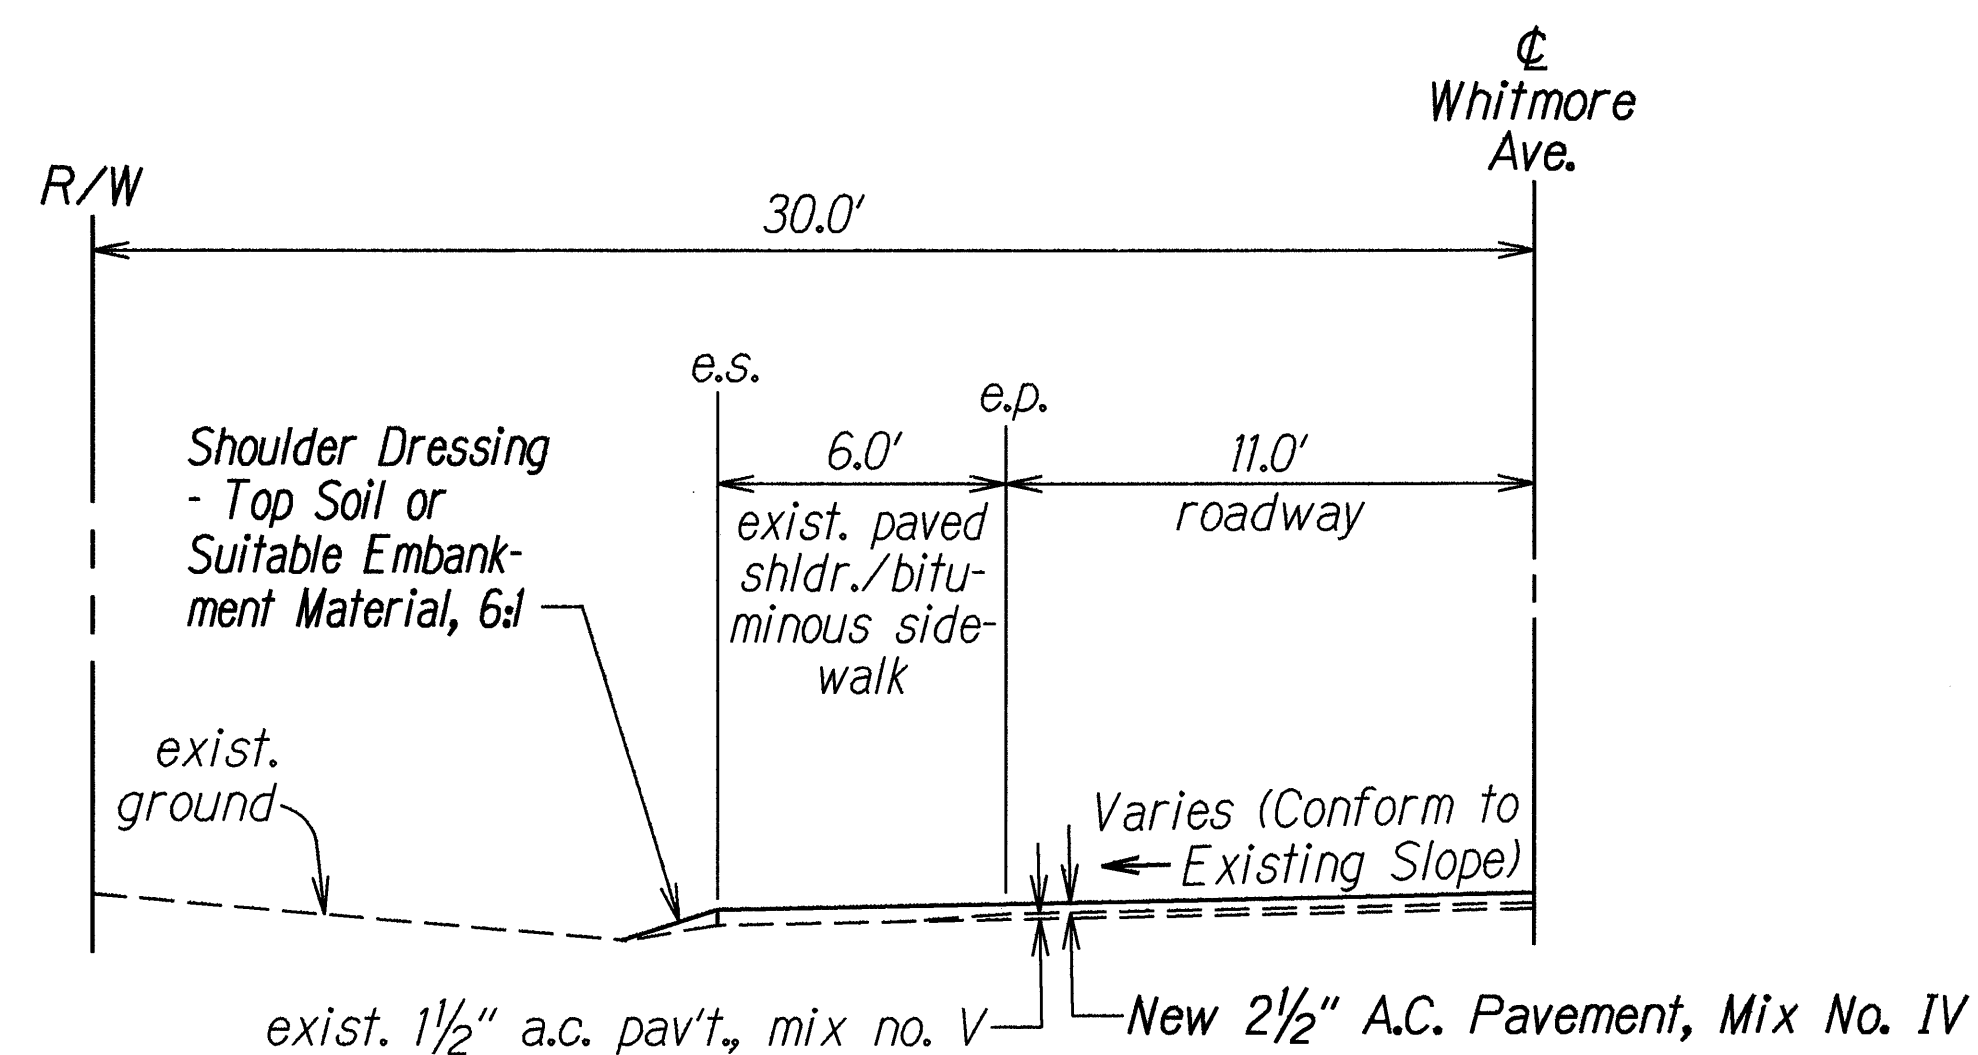

**TYPICAL SECTION
STA. 44+30± LT. TO STA. 60+35± LT.**

Scale: 1/4"=1.0'

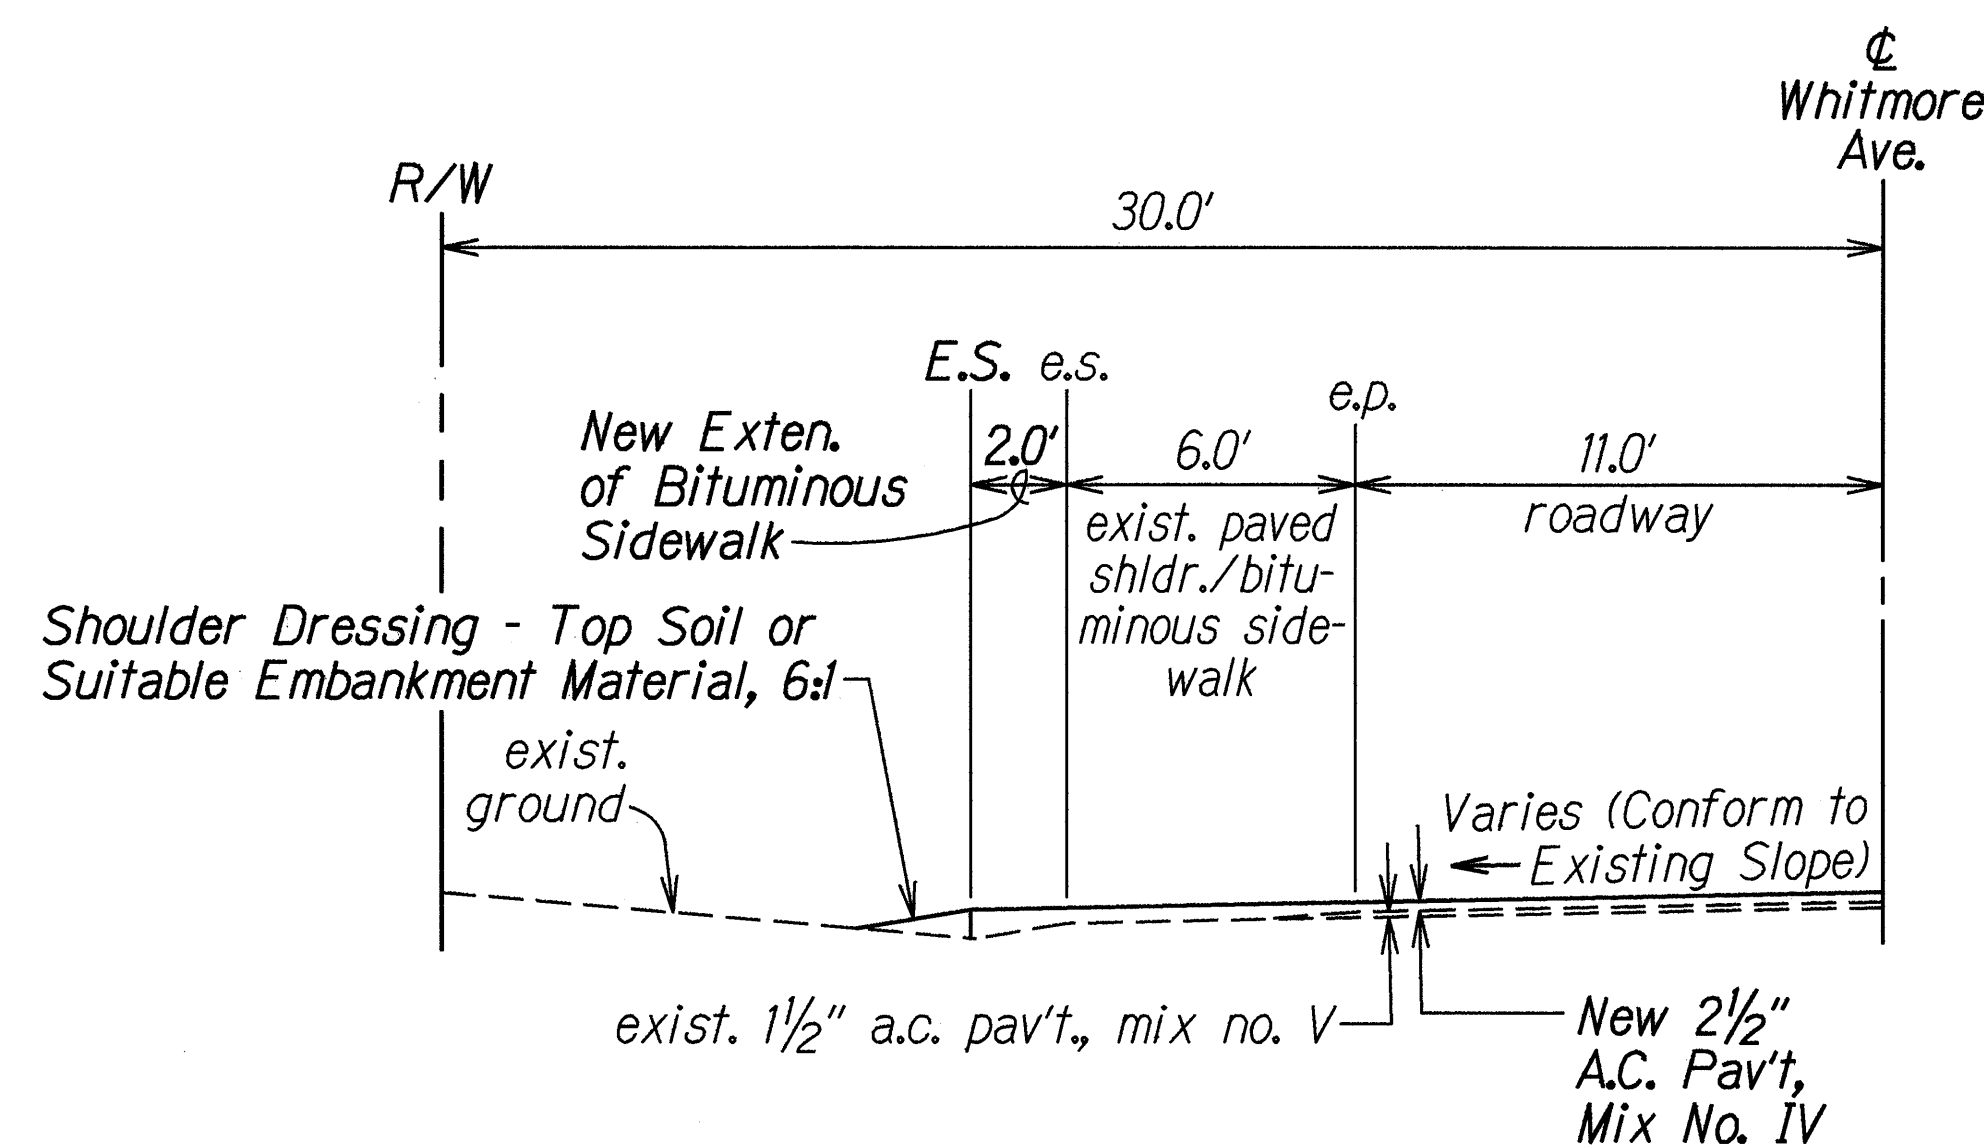

**TYPICAL SECTION
STA. 38+70± LT. TO STA. 44+10± LT.**

Scale: 1/4"=1.0'

ORIGINAL PLAN	DATE
SURVEY PLOTTED BY	1-22-98
DRAWN BY	L. Mitsuhashi, M.H.
DESIGNED BY	L. Suzuki
CHECKED BY	
IN CHARGE	

STATE OF HAWAII
DEPARTMENT OF TRANSPORTATION
HIGHWAYS DIVISION


TYPICAL SECTIONS

WHITMORE AVENUE RESURFACING
Kamehameha Highway to Military Gate
Proj. No. 7012A-01-98M


Scale: As Noted Date: Jan. 1998

SHEET No. 2 OF 6 SHEETS


FED. ROAD DIST. NO.	STATE	PROJ. NO.	FISCAL YEAR	SHEET NO.	TOTAL SHEETS
HAWAII	HAW.	7012A-01-98M	1999	6	32

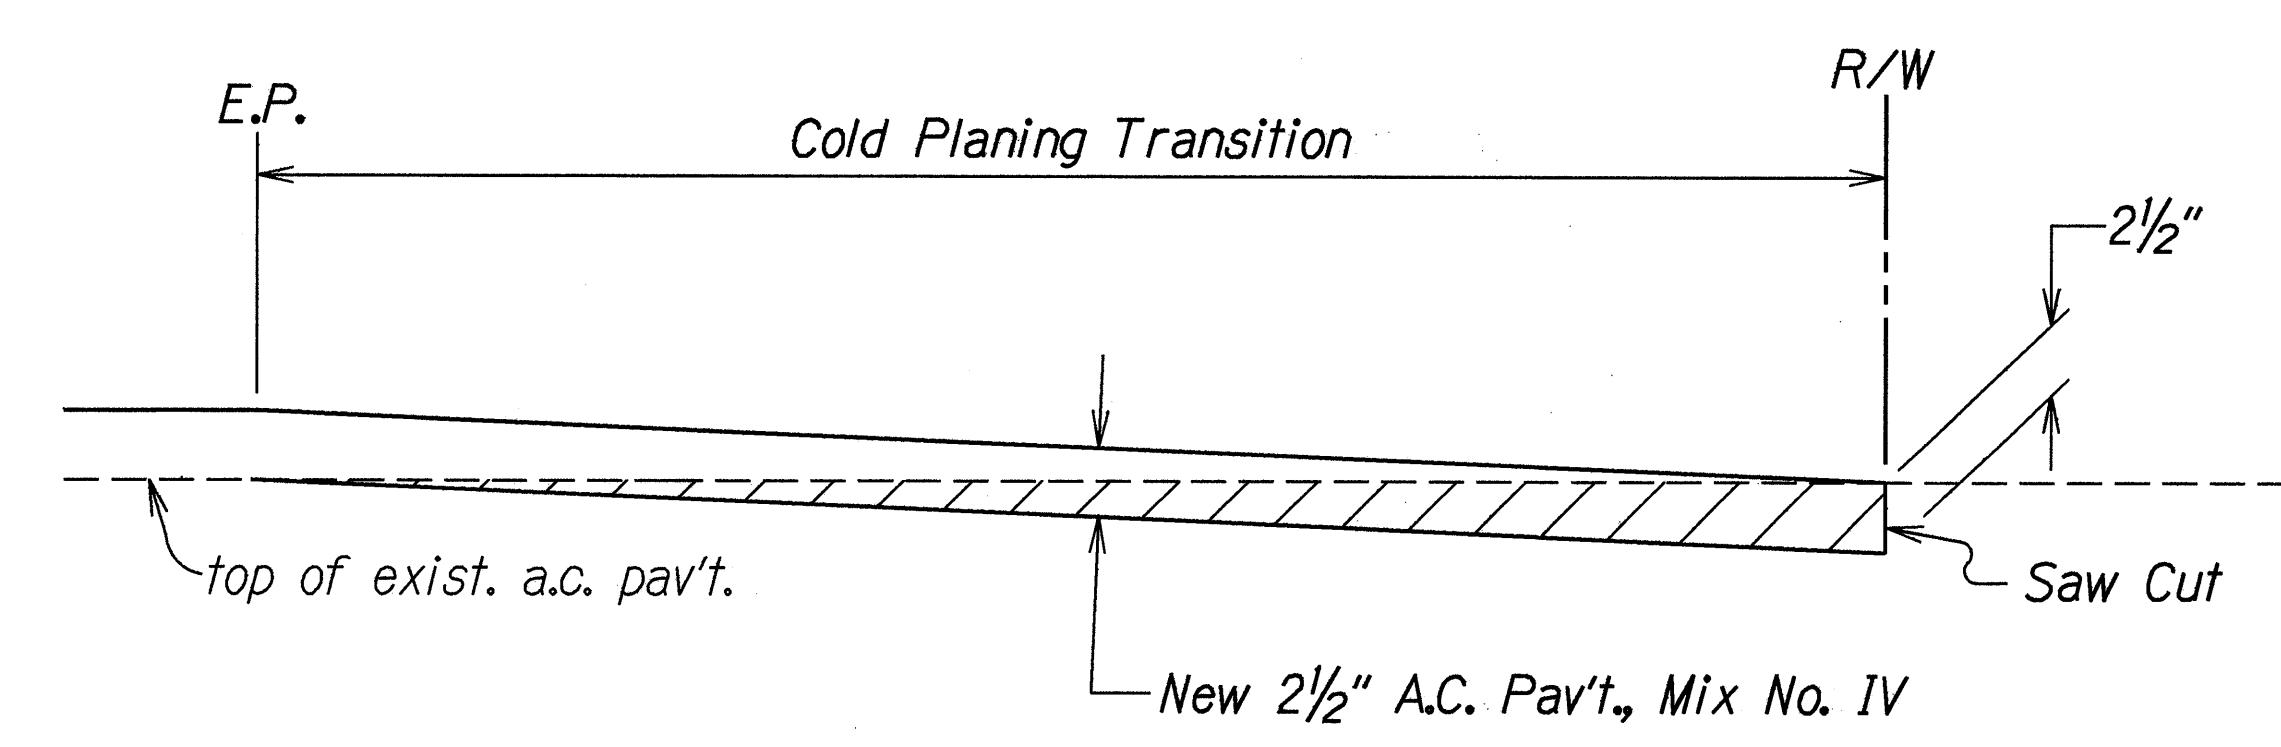


**COLD PLANING AND RESURFACING
AT SIDE STREETS**
Not To Scale

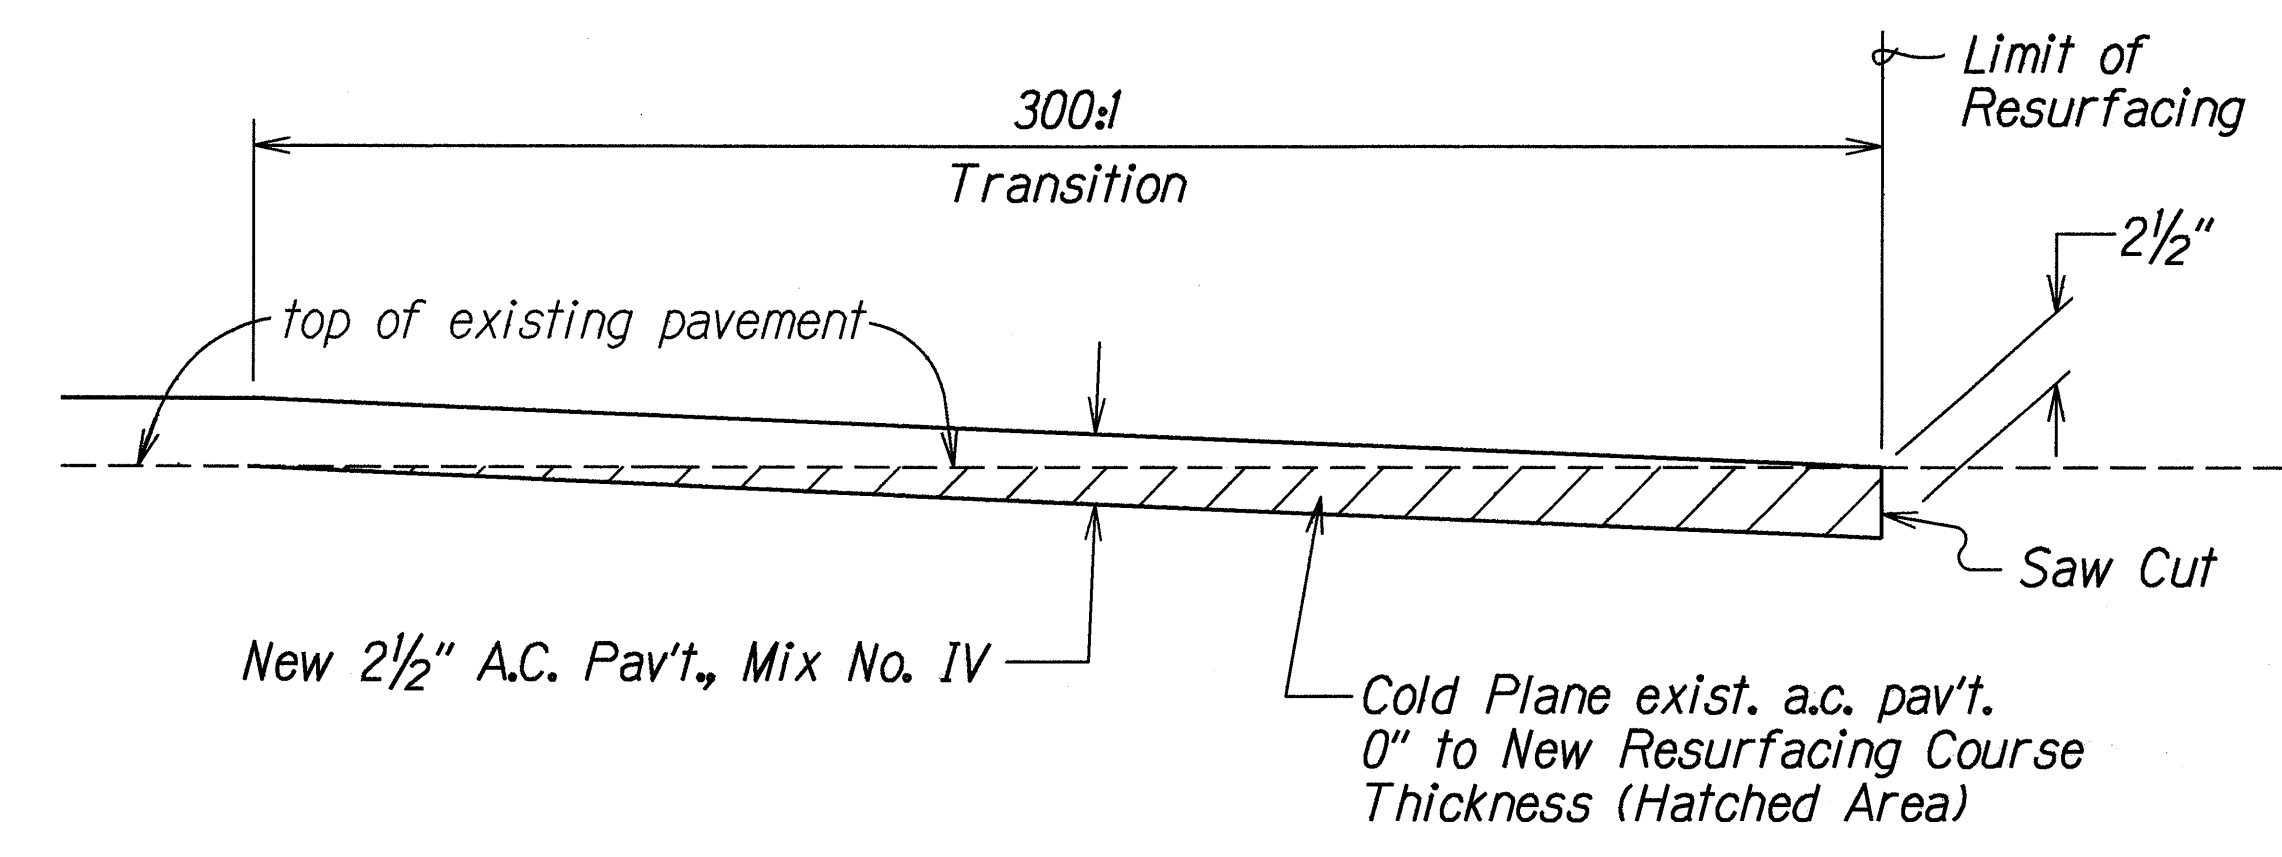


**COLD PLANED TRANSITION
AT BEGINNING AND END OF PROJECT**
Not To Scale

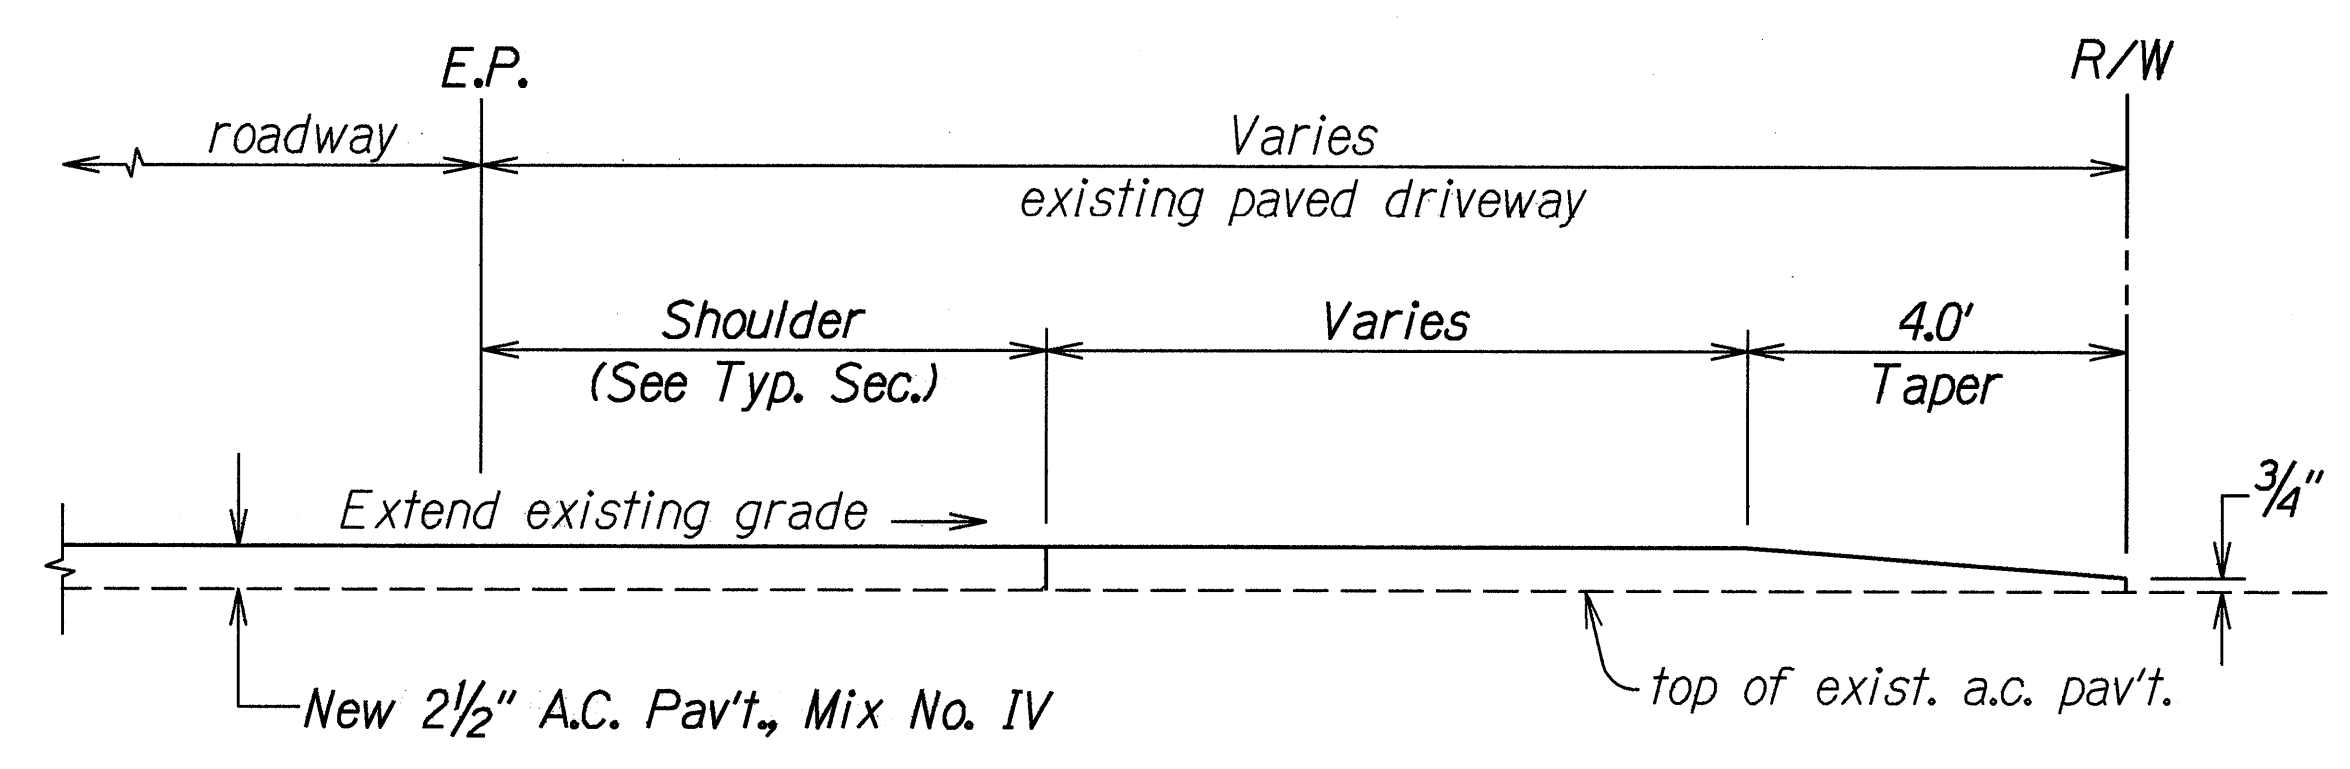


A. C. RESURFACING AT PAVED DRIVEWAY
Not To Scale

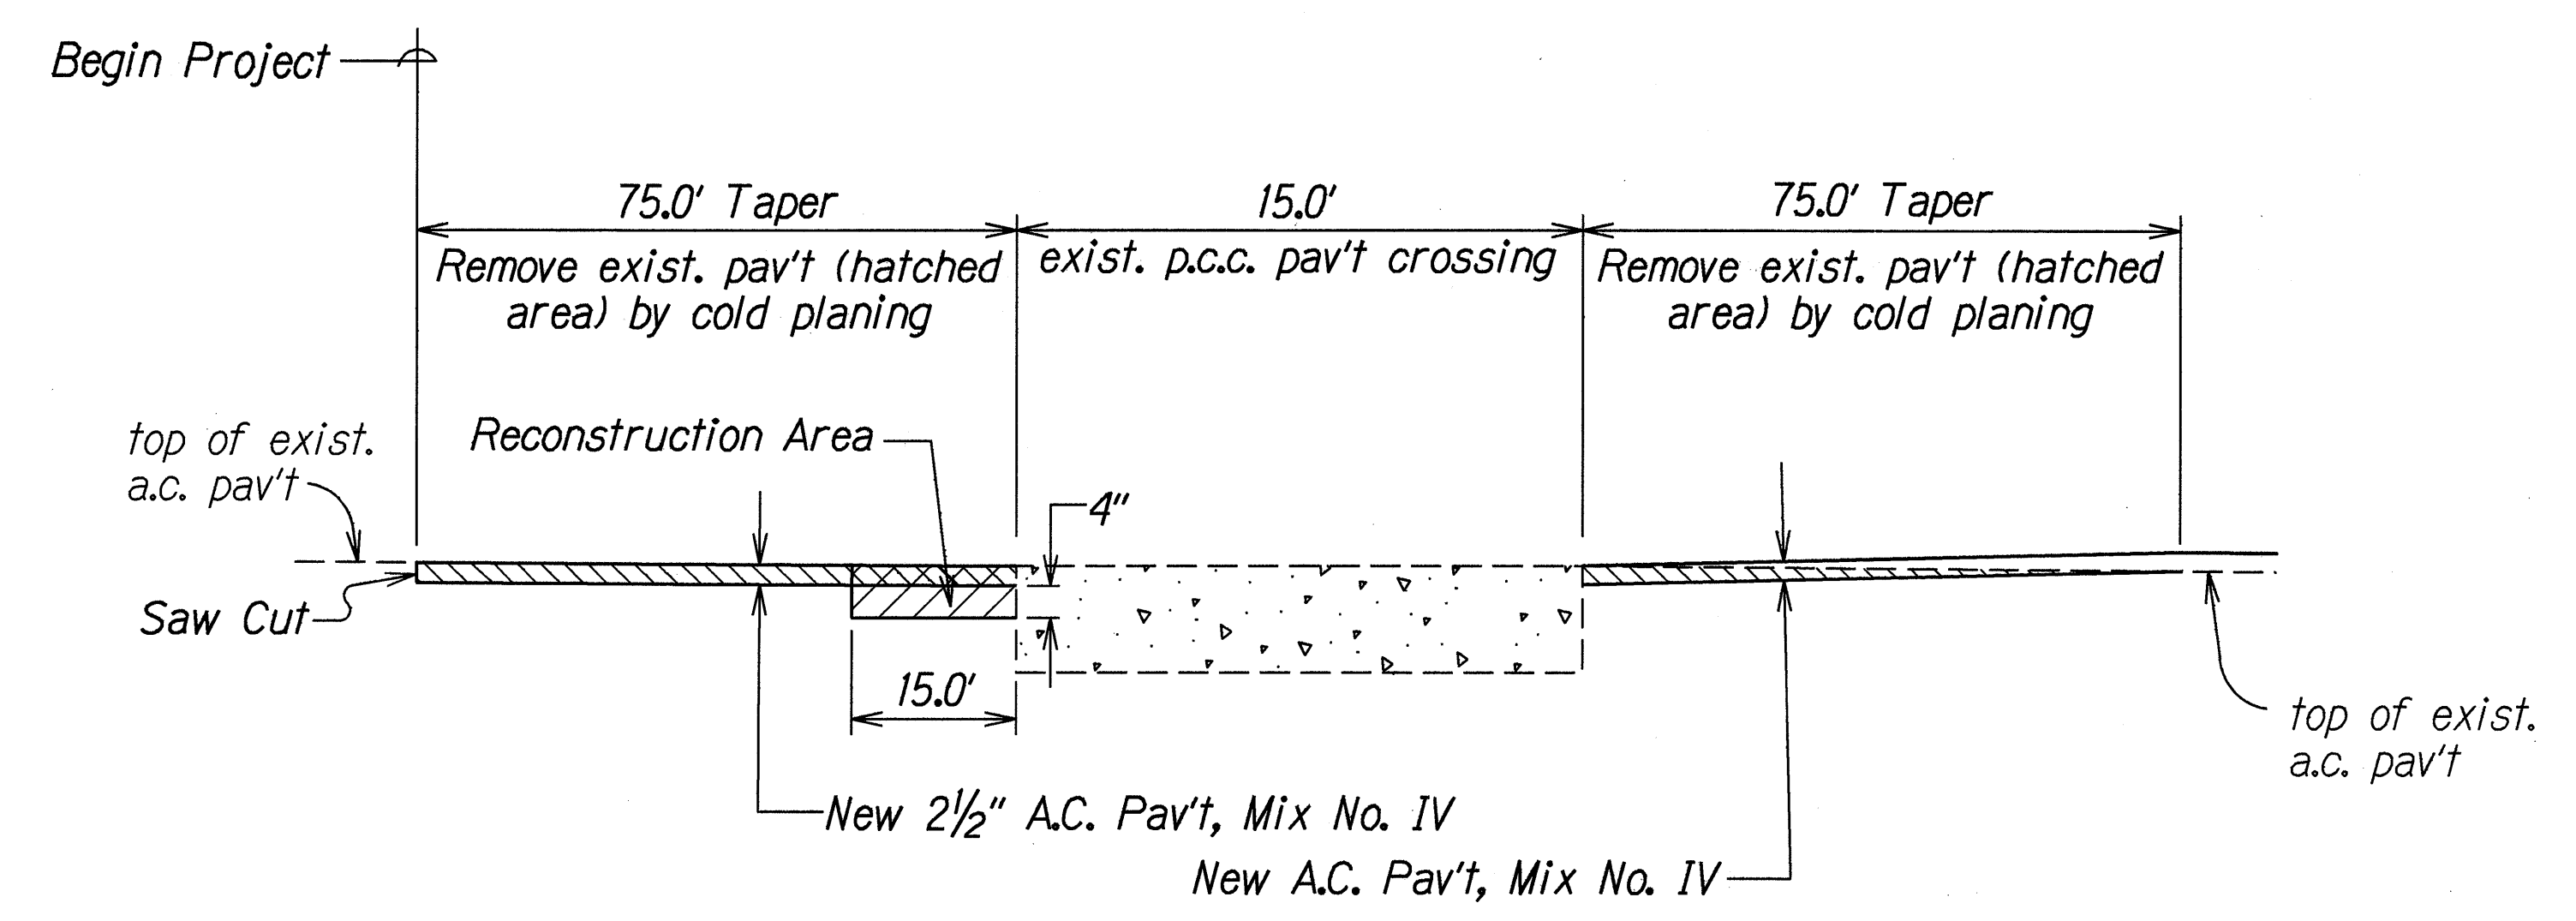

**RESURFACING AT
P.C.C. PAVEMENT CROSSING DETAIL
STA. 0+32 TO # STA. 2+05**
Not To Scale

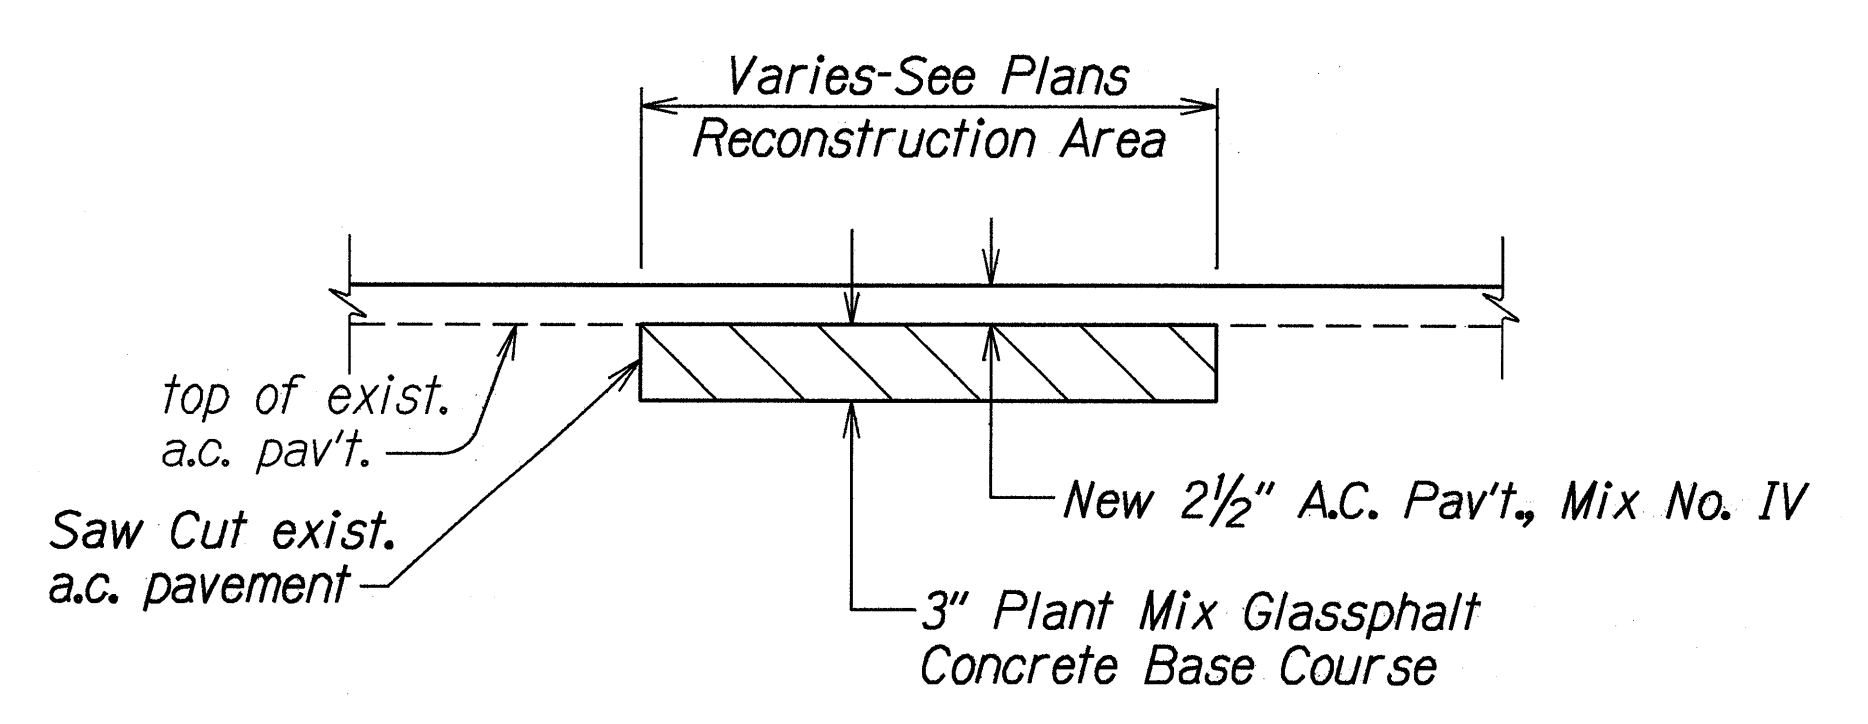

TYPICAL RECONSTRUCTION DETAIL
Not To Scale

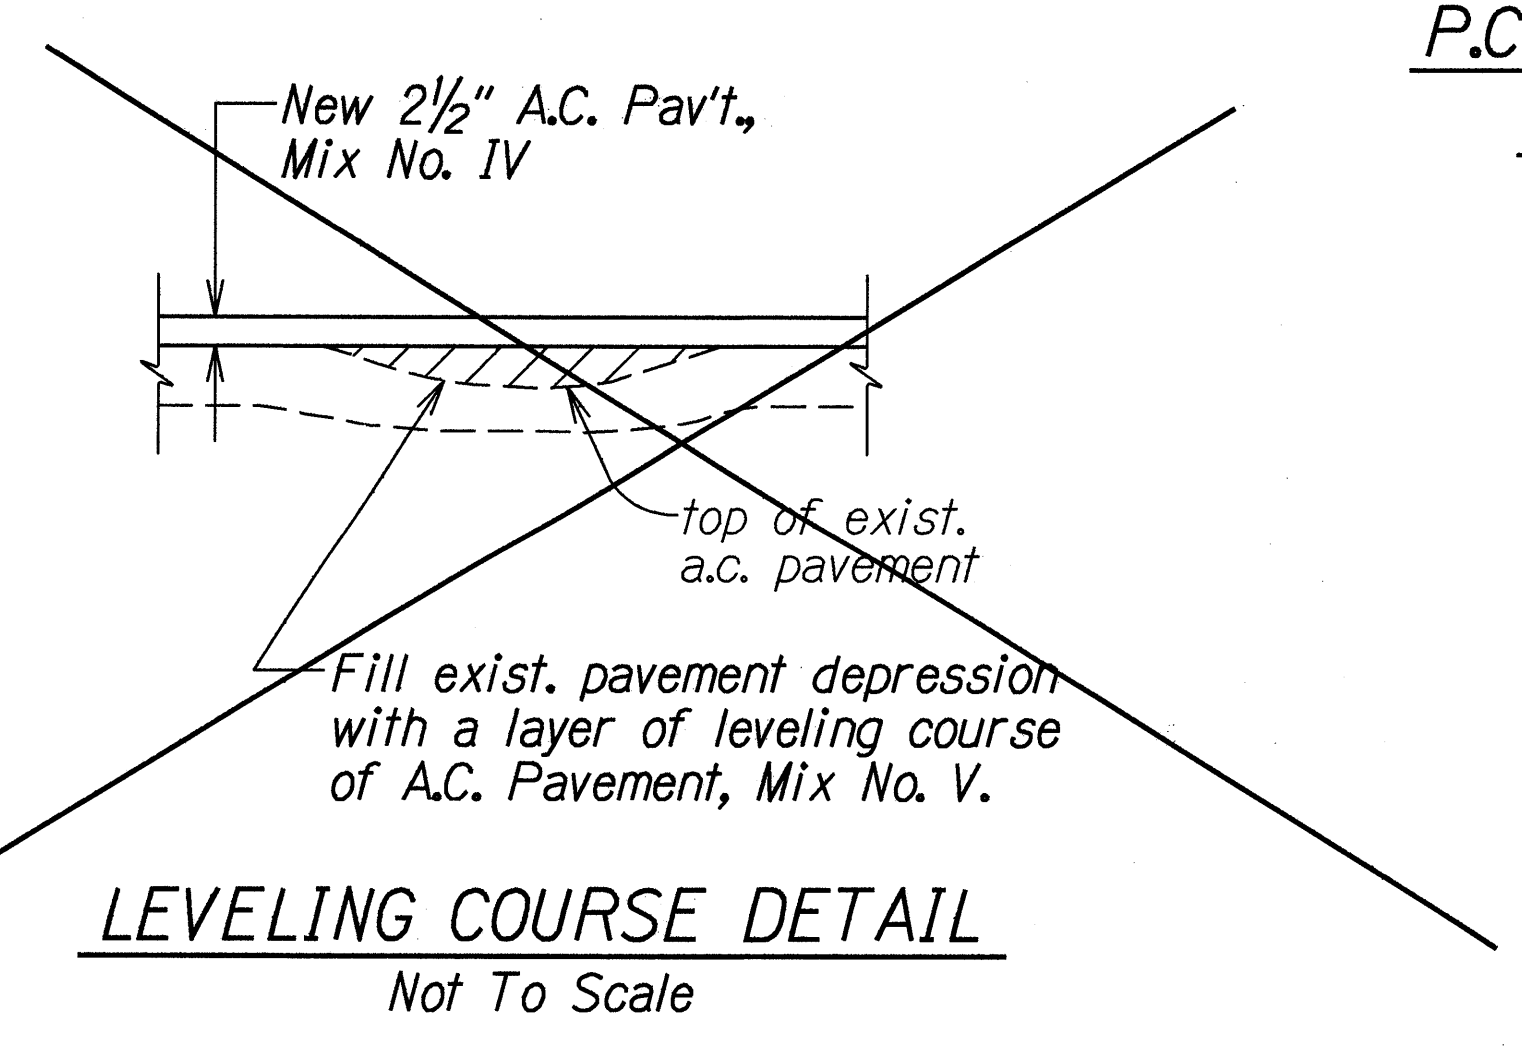

LEVELING COURSE DETAIL
Not To Scale

LEGEND FOR AS-BUILT POSTINGS	
	Squiggly line for as-built deletion
	Double line for as-built deletion
Roadway	Text for as-built posting

2/11/99	Revised "Resurfacing at P.C.C. Pavement Crossing Detail".
DATE	REVISION

STATE OF HAWAII
DEPARTMENT OF TRANSPORTATION
HIGHWAYS DIVISION

TYPICAL DETAILS

WHITMORE AVENUE RESURFACING
Kamehameha Highway to Military Gate
Proj. No. 7012A-01-98M


Scale: As Noted Date: Jan. 1998

SHEET No. 3 OF 6 SHEETS


SURVEY PLOTTED BY: DATE: 6-22-99
DRAWN BY: L. Mitsuyoshi, MH
TRACED BY: L. Mitsuyoshi, MH
DESIGNED BY: L. Mitsuyoshi, MH
CHECKED BY: L. Mitsuyoshi, MH

ORIGINAL PLAN
NOTE: WORK
BY: L. Mitsuyoshi, MH
DATE: 6-22-99


FED. ROAD DIST. NO.	STATE	PROJ. NO.	FISCAL YEAR	SHEET NO.	TOTAL SHEETS
HAWAII	HAW.	7012A-01-98M	1999	7	32

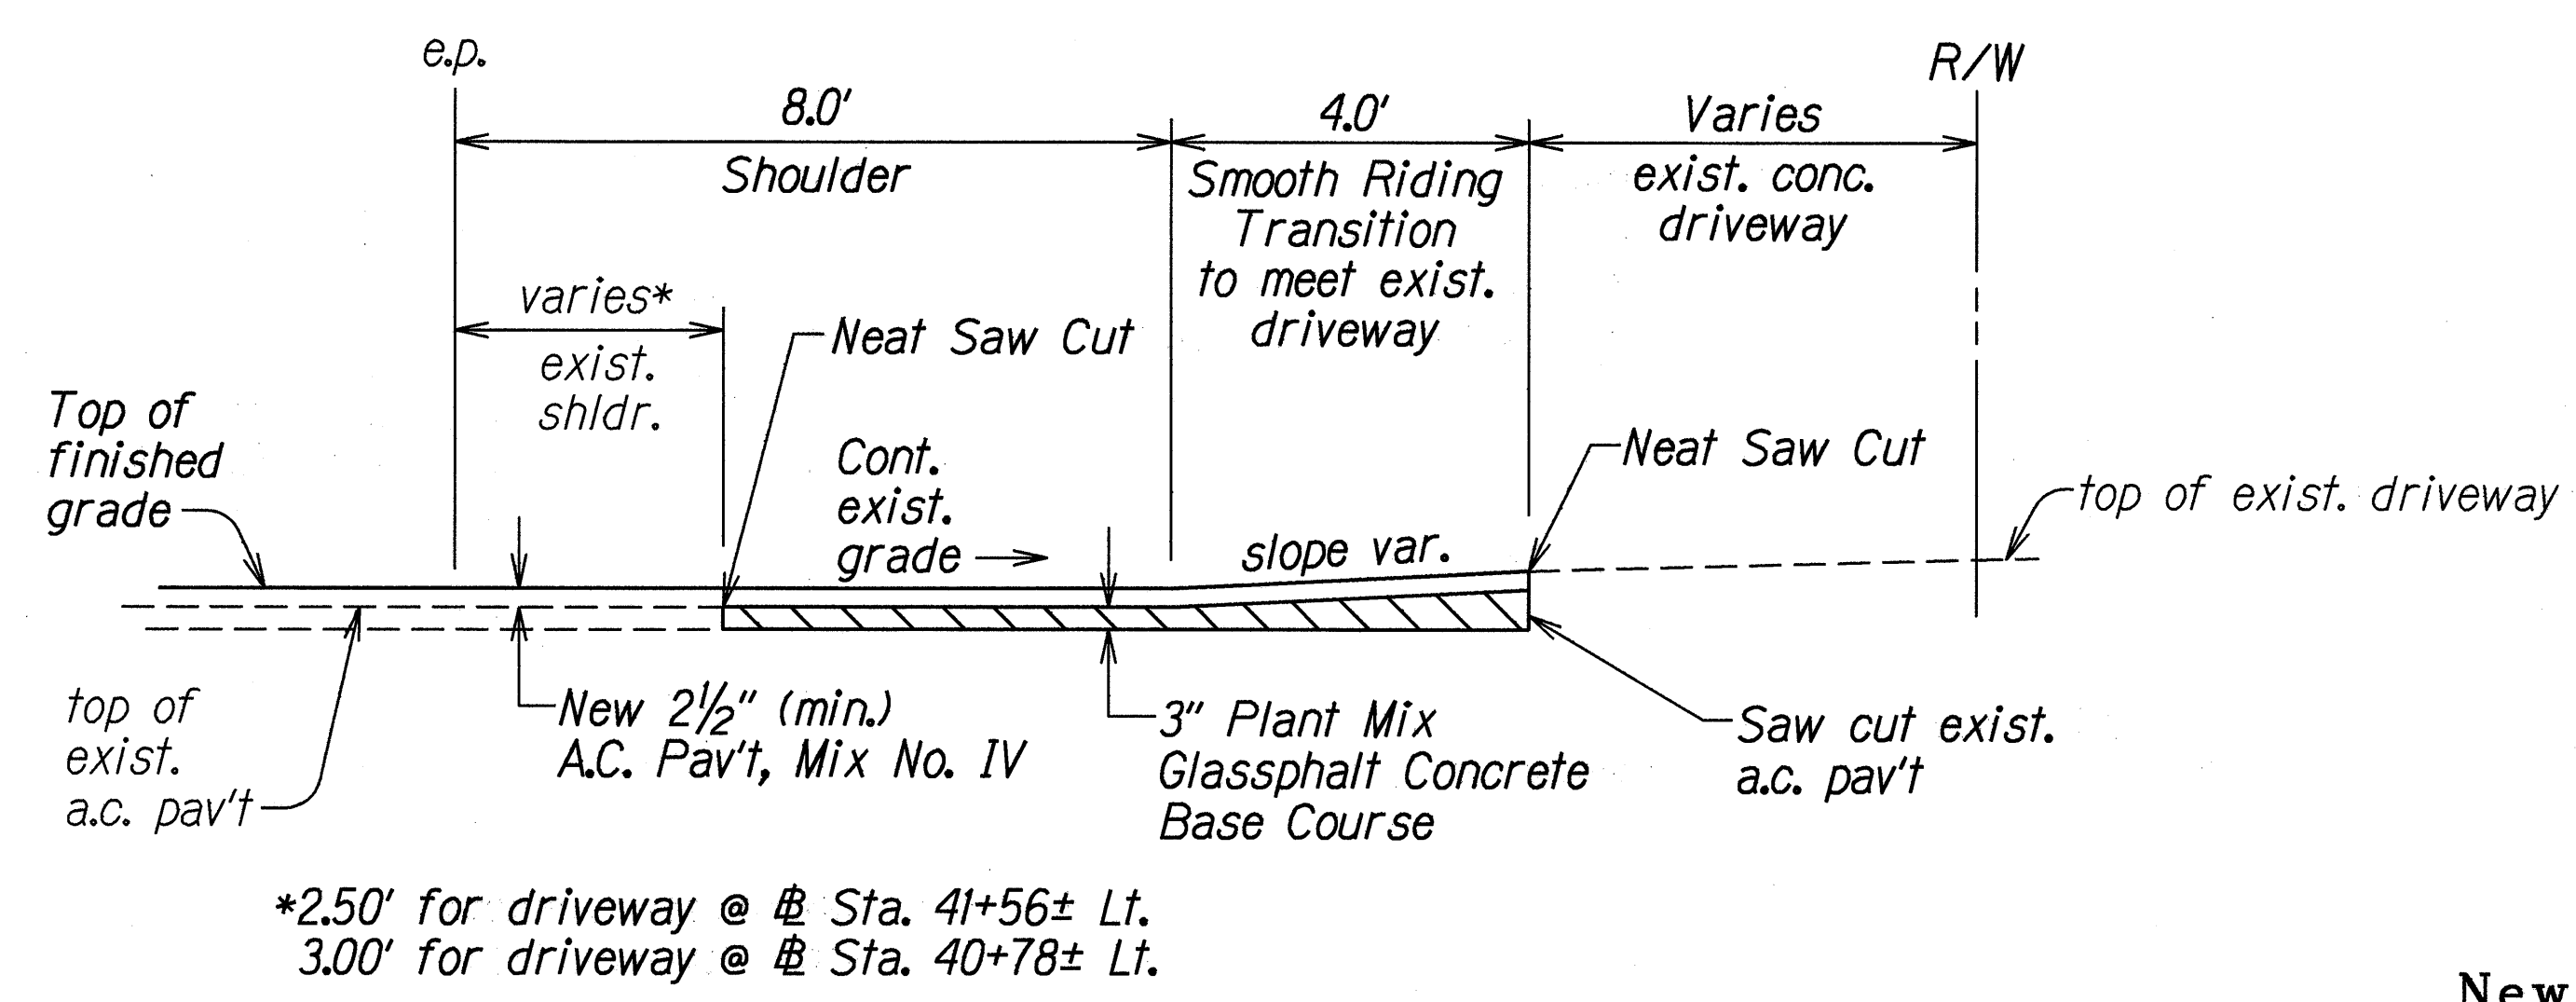

RECONSTRUCTION DETAIL FOR
CONCRETE DRIVEWAYS/SHOULDERS
Sta. 38+82± to Sta. 43+96±
Scale: 1/2" = 1.0'

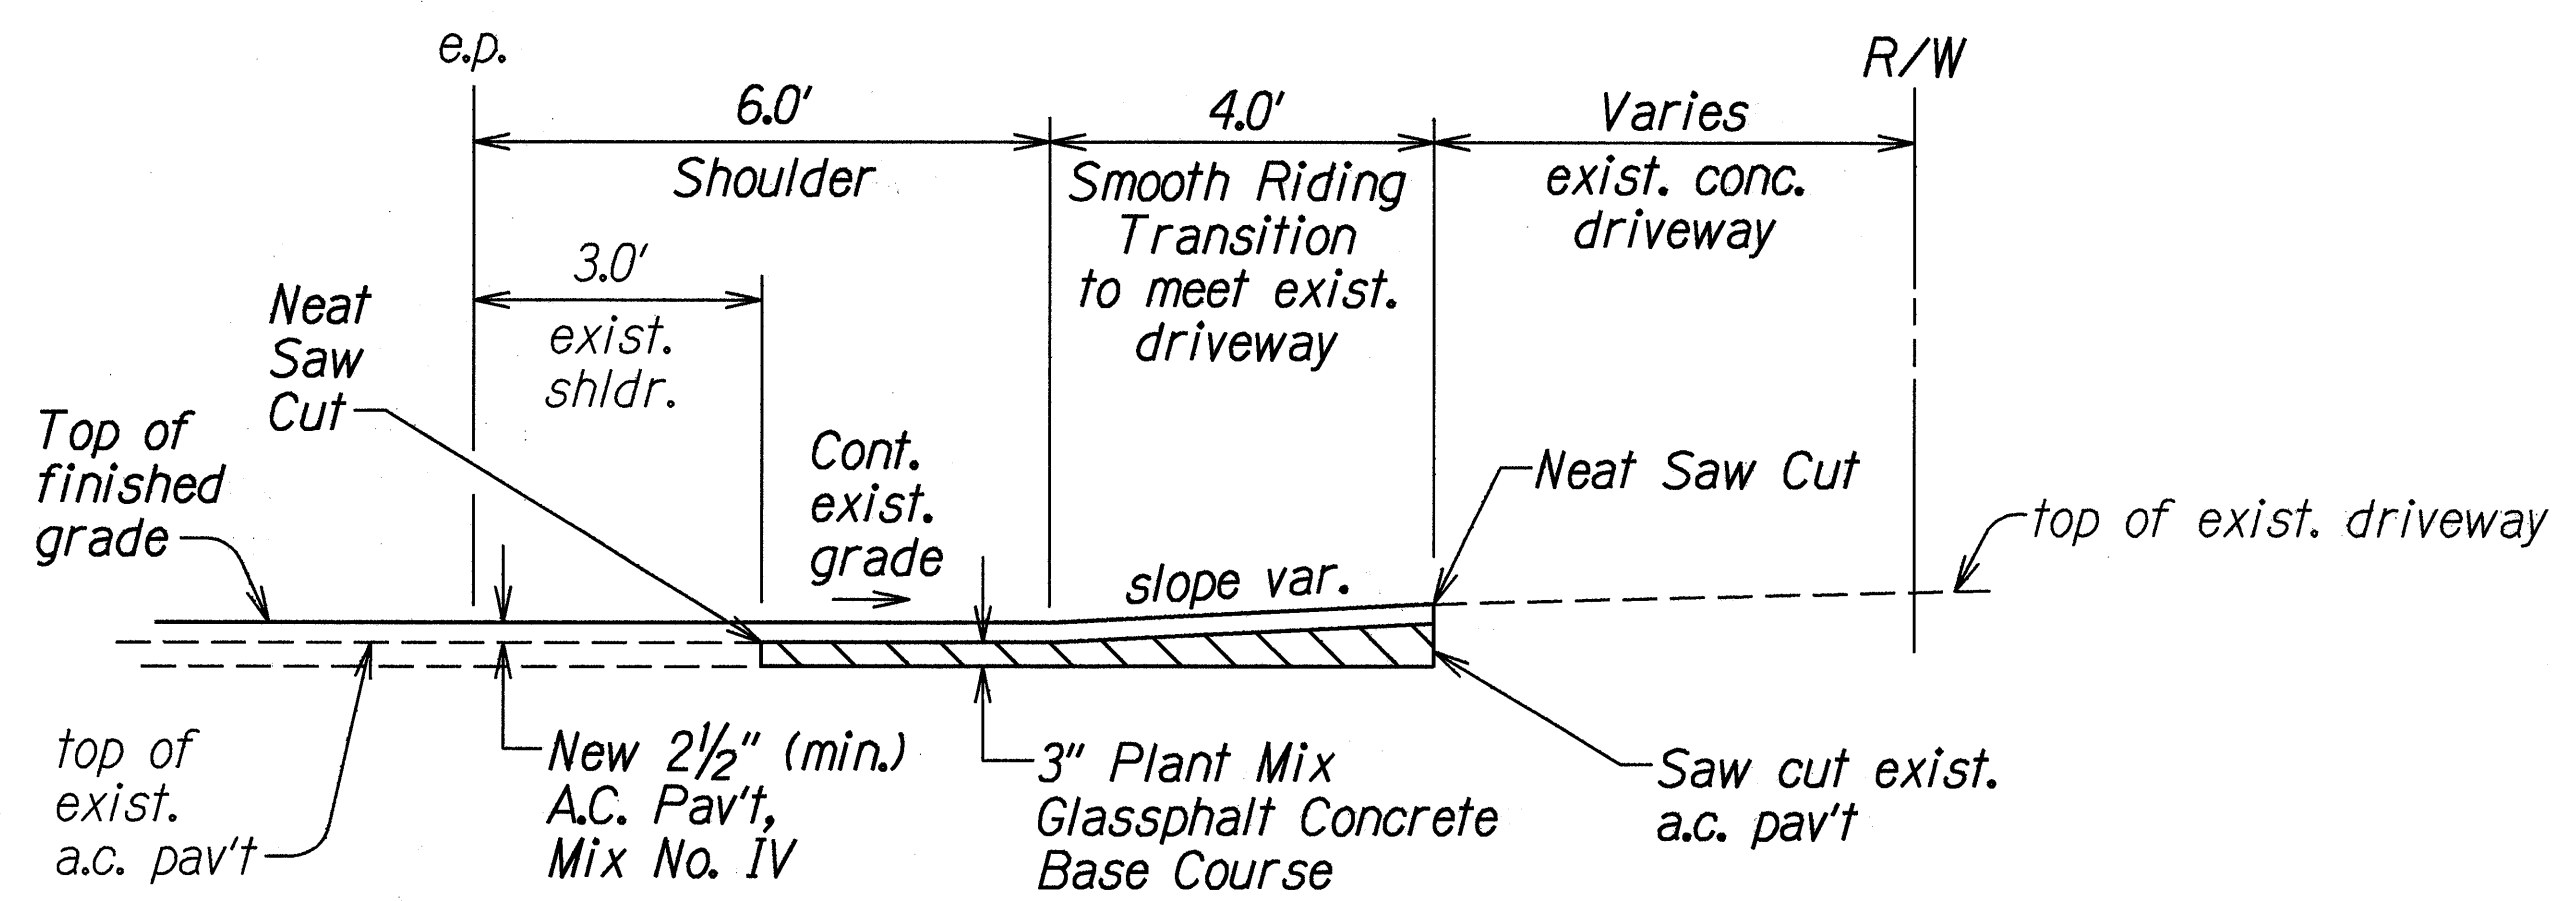

RECONSTRUCTION DETAIL FOR
CONCRETE DRIVEWAYS/SHOULDERS
Sta. 56+30±
Scale: 1/2" = 1.0'

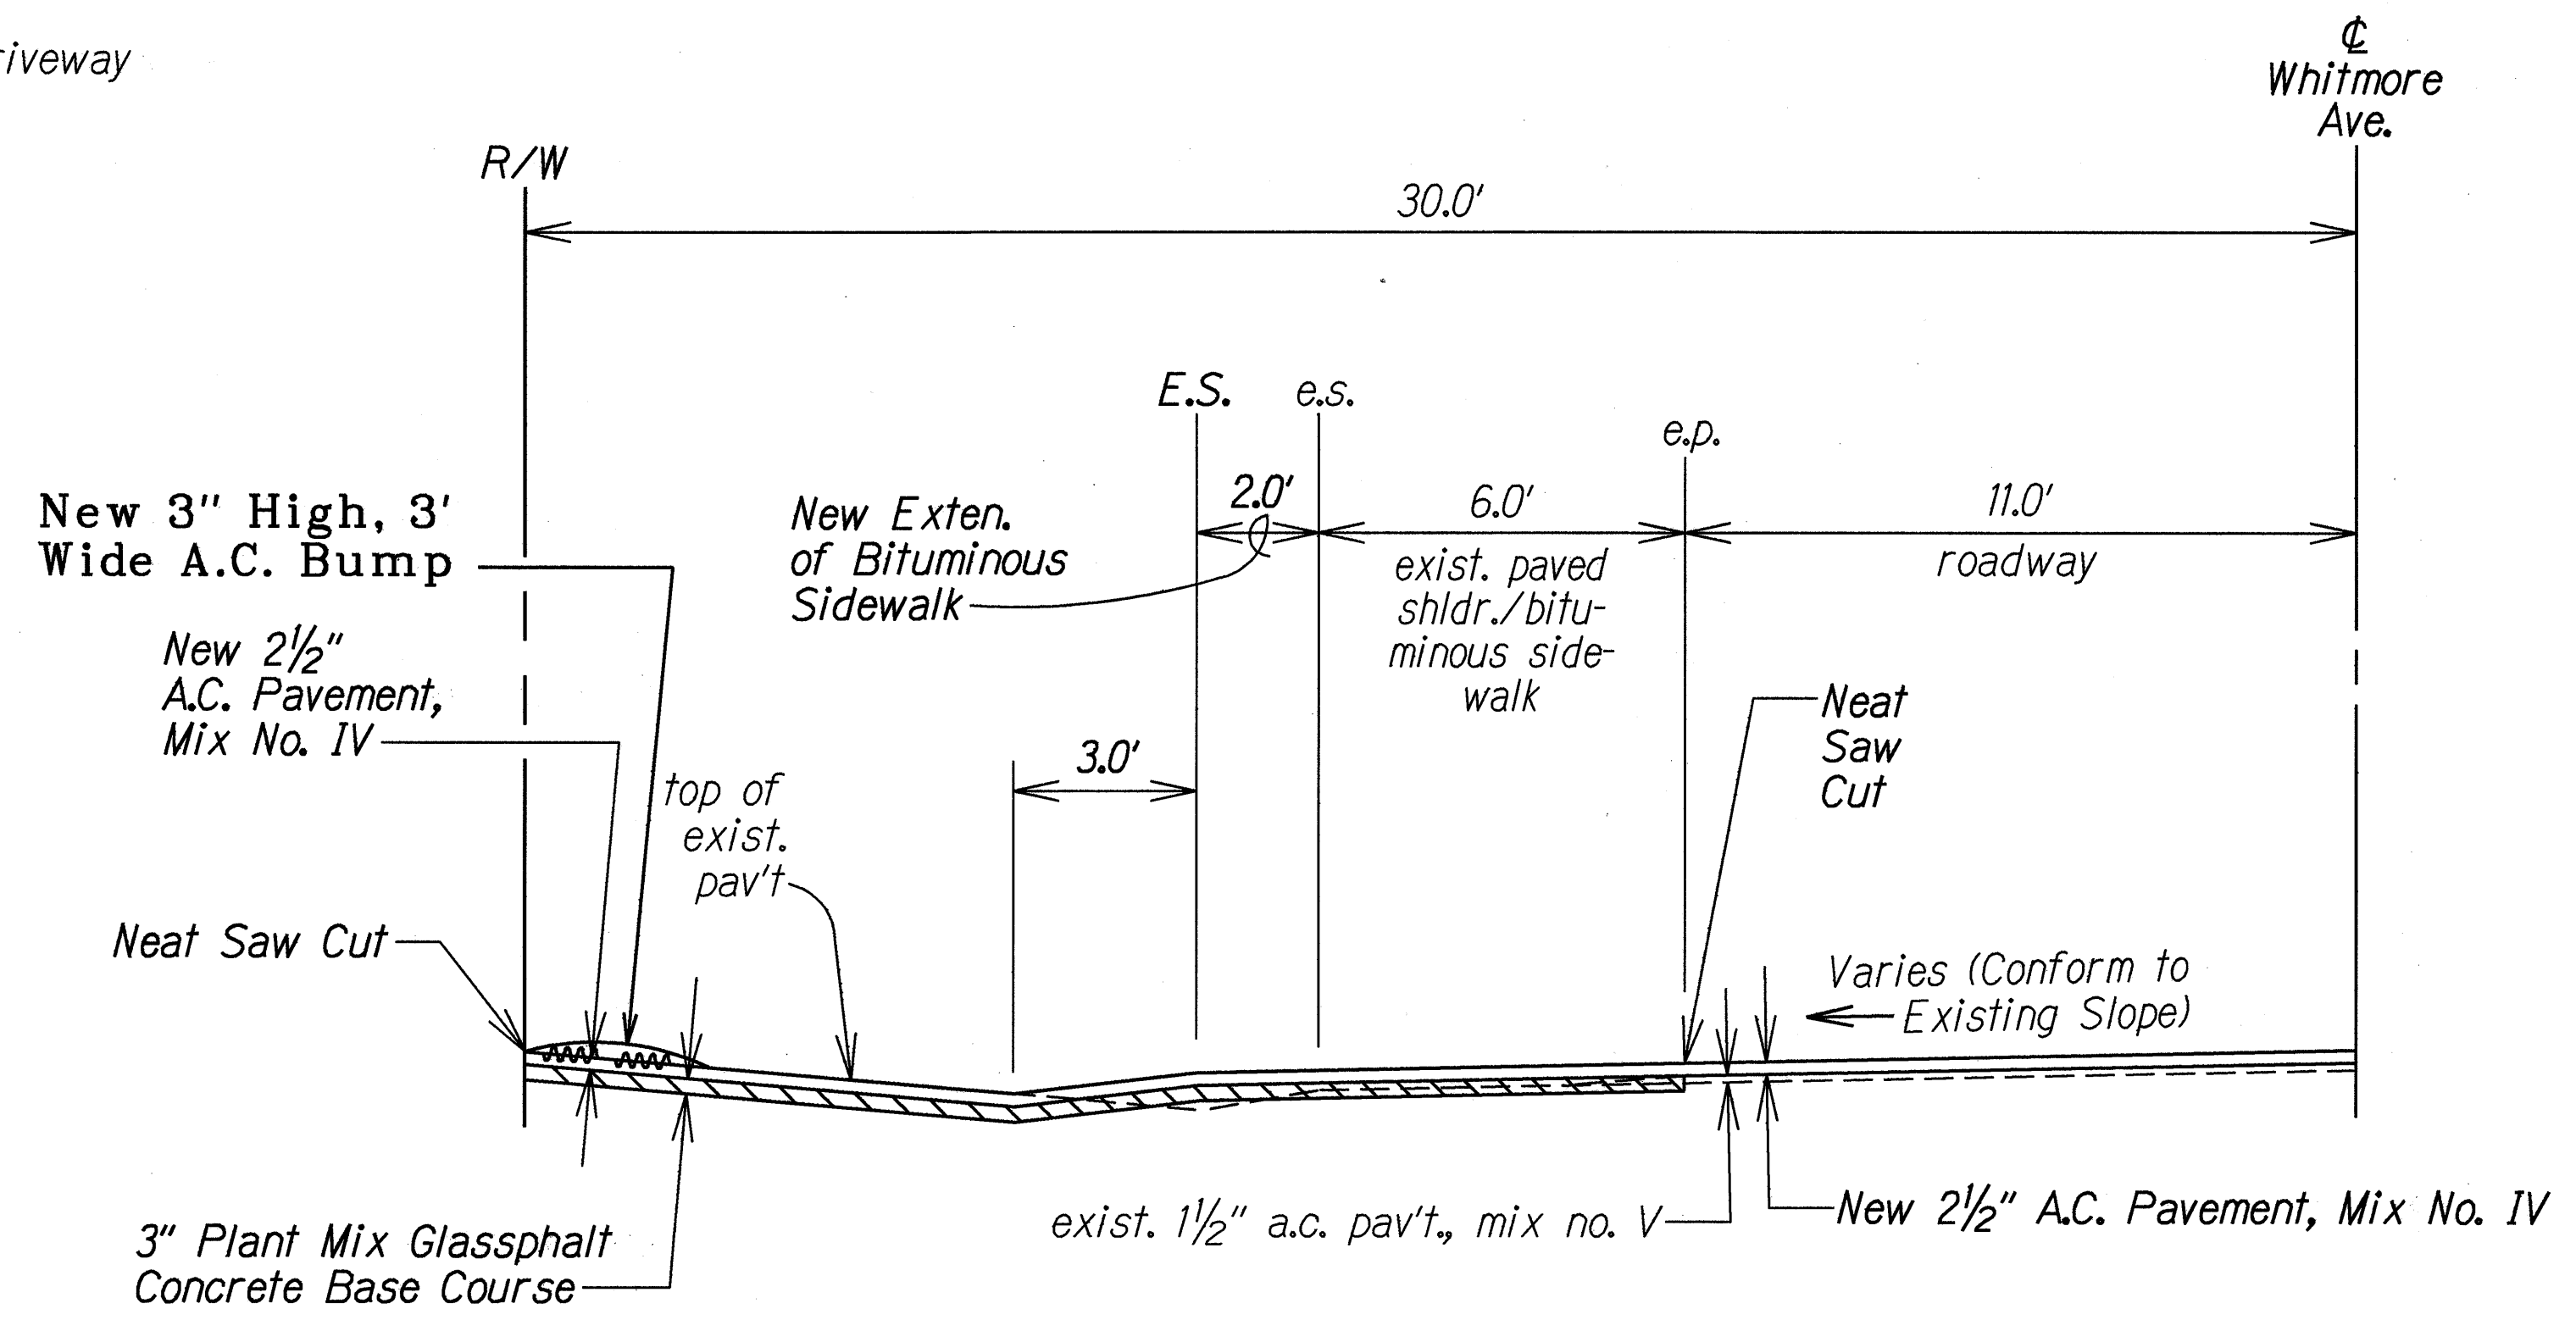

A.C. DRIVEWAY RECONSTRUCTION
Sta. 50+16± LT.
Scale: 3/8" = 1.0'

SURVEY PLOTTED BY	DATE
DRAWN BY	6-28-98
DESIGNED BY	
CHECKED BY	
ORIGINAL PLAN	
NOTE BOOK	
DATE	
BY	
CHECKED BY	

LEGEND FOR AS-BUILT POSTINGS	
	Squiggly line for as-built deletion
	Double line for as-built deletion
Roadway	Text for as-built posting

STATE OF HAWAII
DEPARTMENT OF TRANSPORTATION
HIGHWAYS DIVISION


MISC. SECTIONS & DETAILS

WHITMORE AVENUE RESURFACING
Kamehameha Highway to Military Gate
Proj. No. 7012A-01-98M

Scale: As Noted Date: Jan. 1998



SHEET No. 4 OF 6 SHEETS

FED. ROAD DIST. NO.	STATE	PROJ. NO.	FISCAL YEAR	SHEET NO.	TOTAL SHEETS
HAWAII	HAW.	7012A-01-98M	1999	8	32

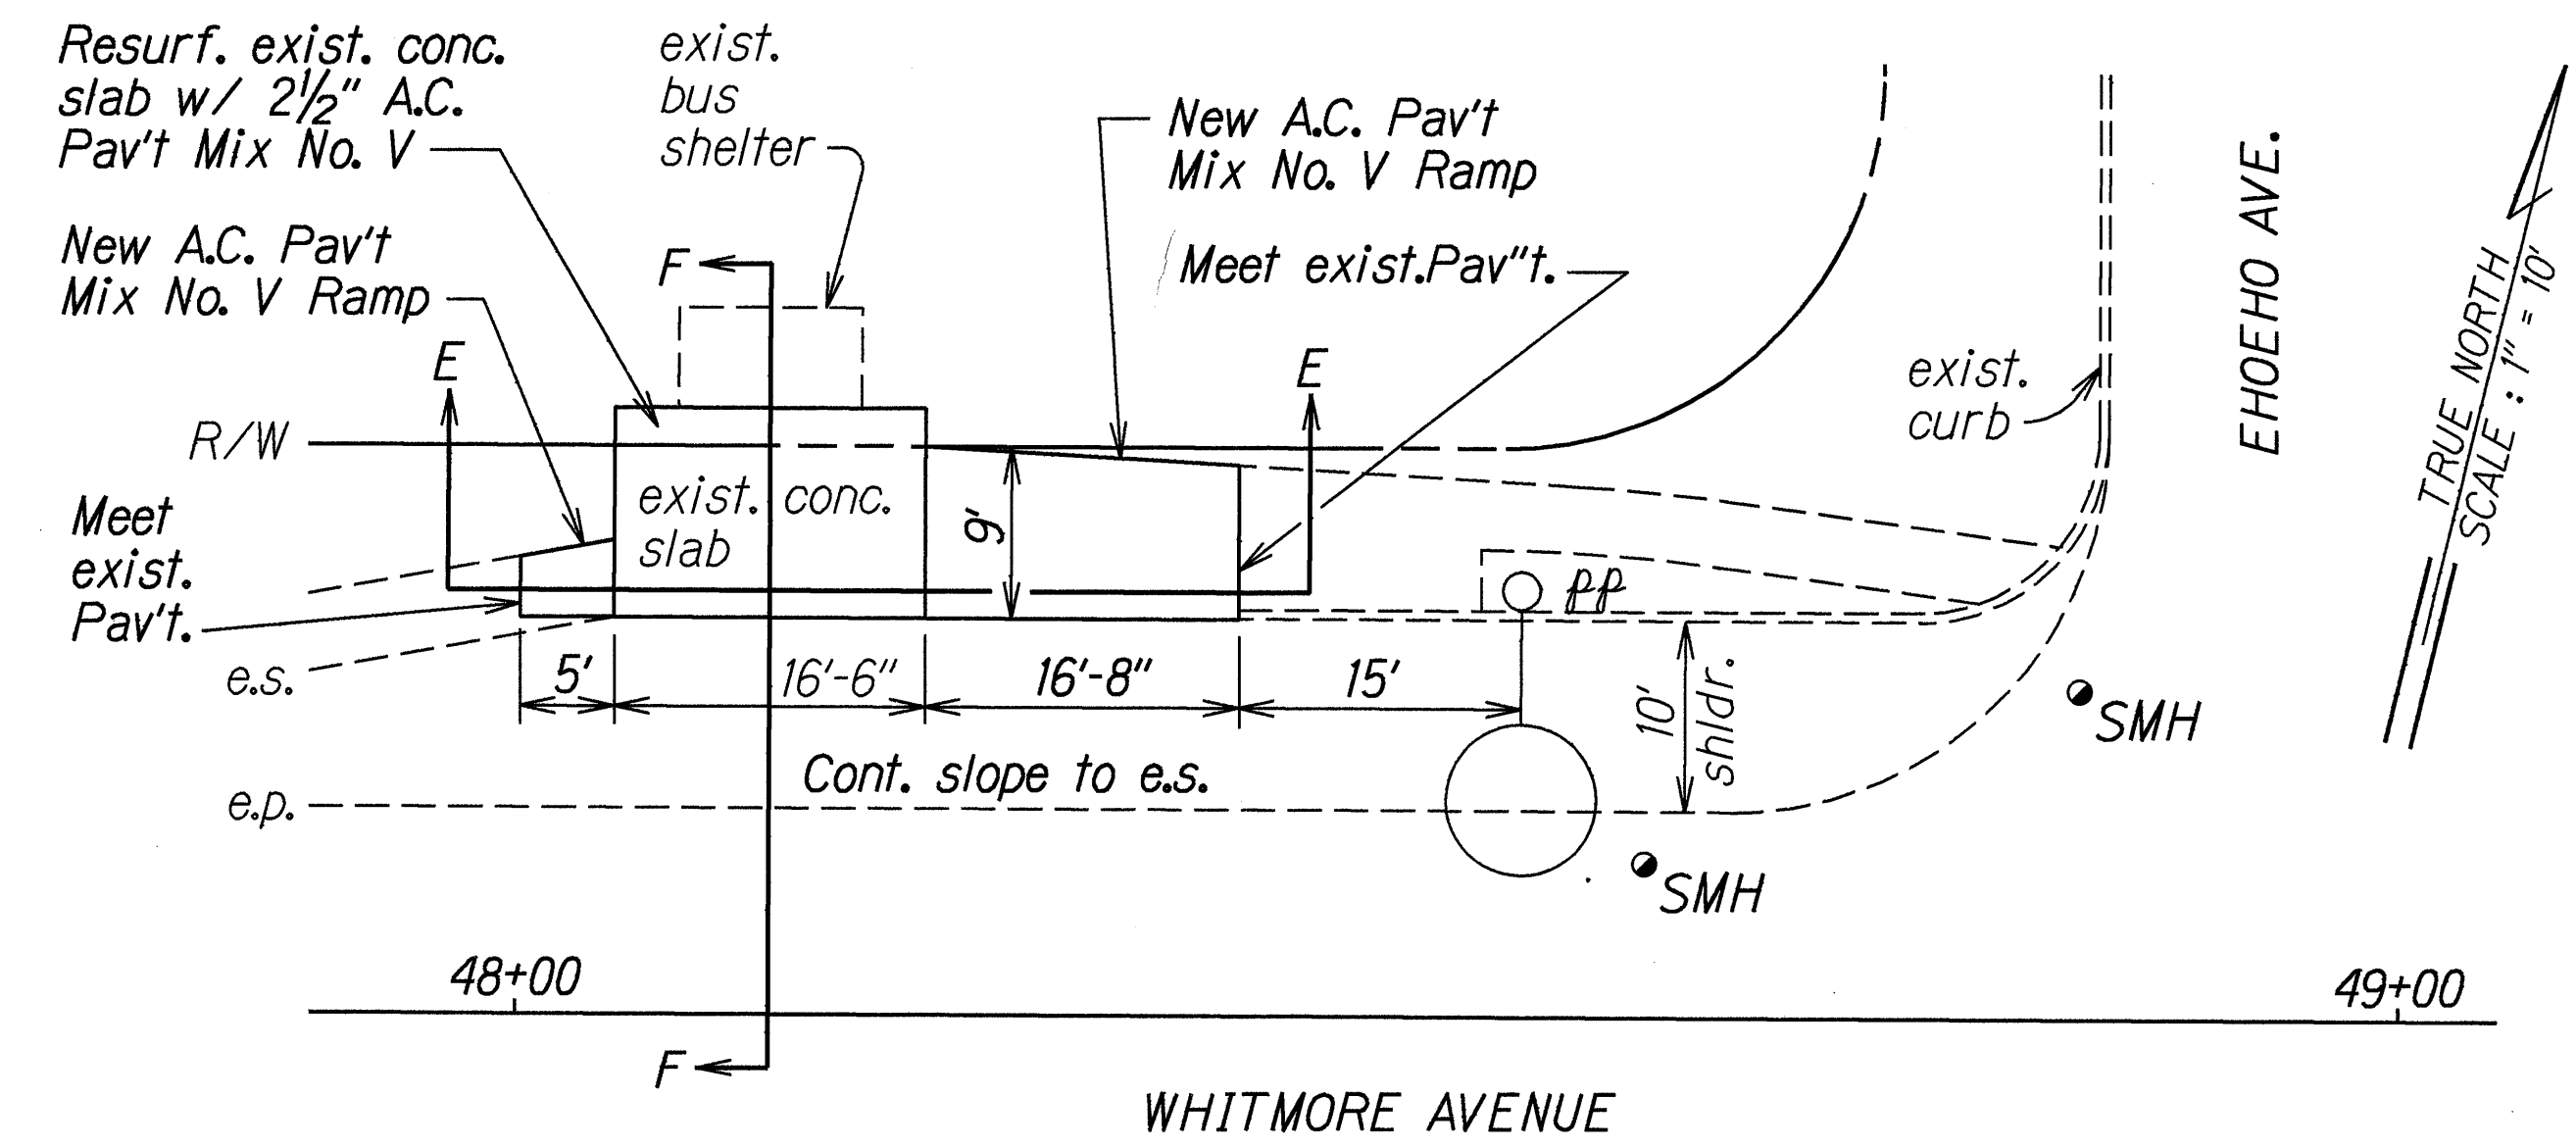

BUS TURNOUT AT EHOEHO AVE.

Scale: 1" = 10'

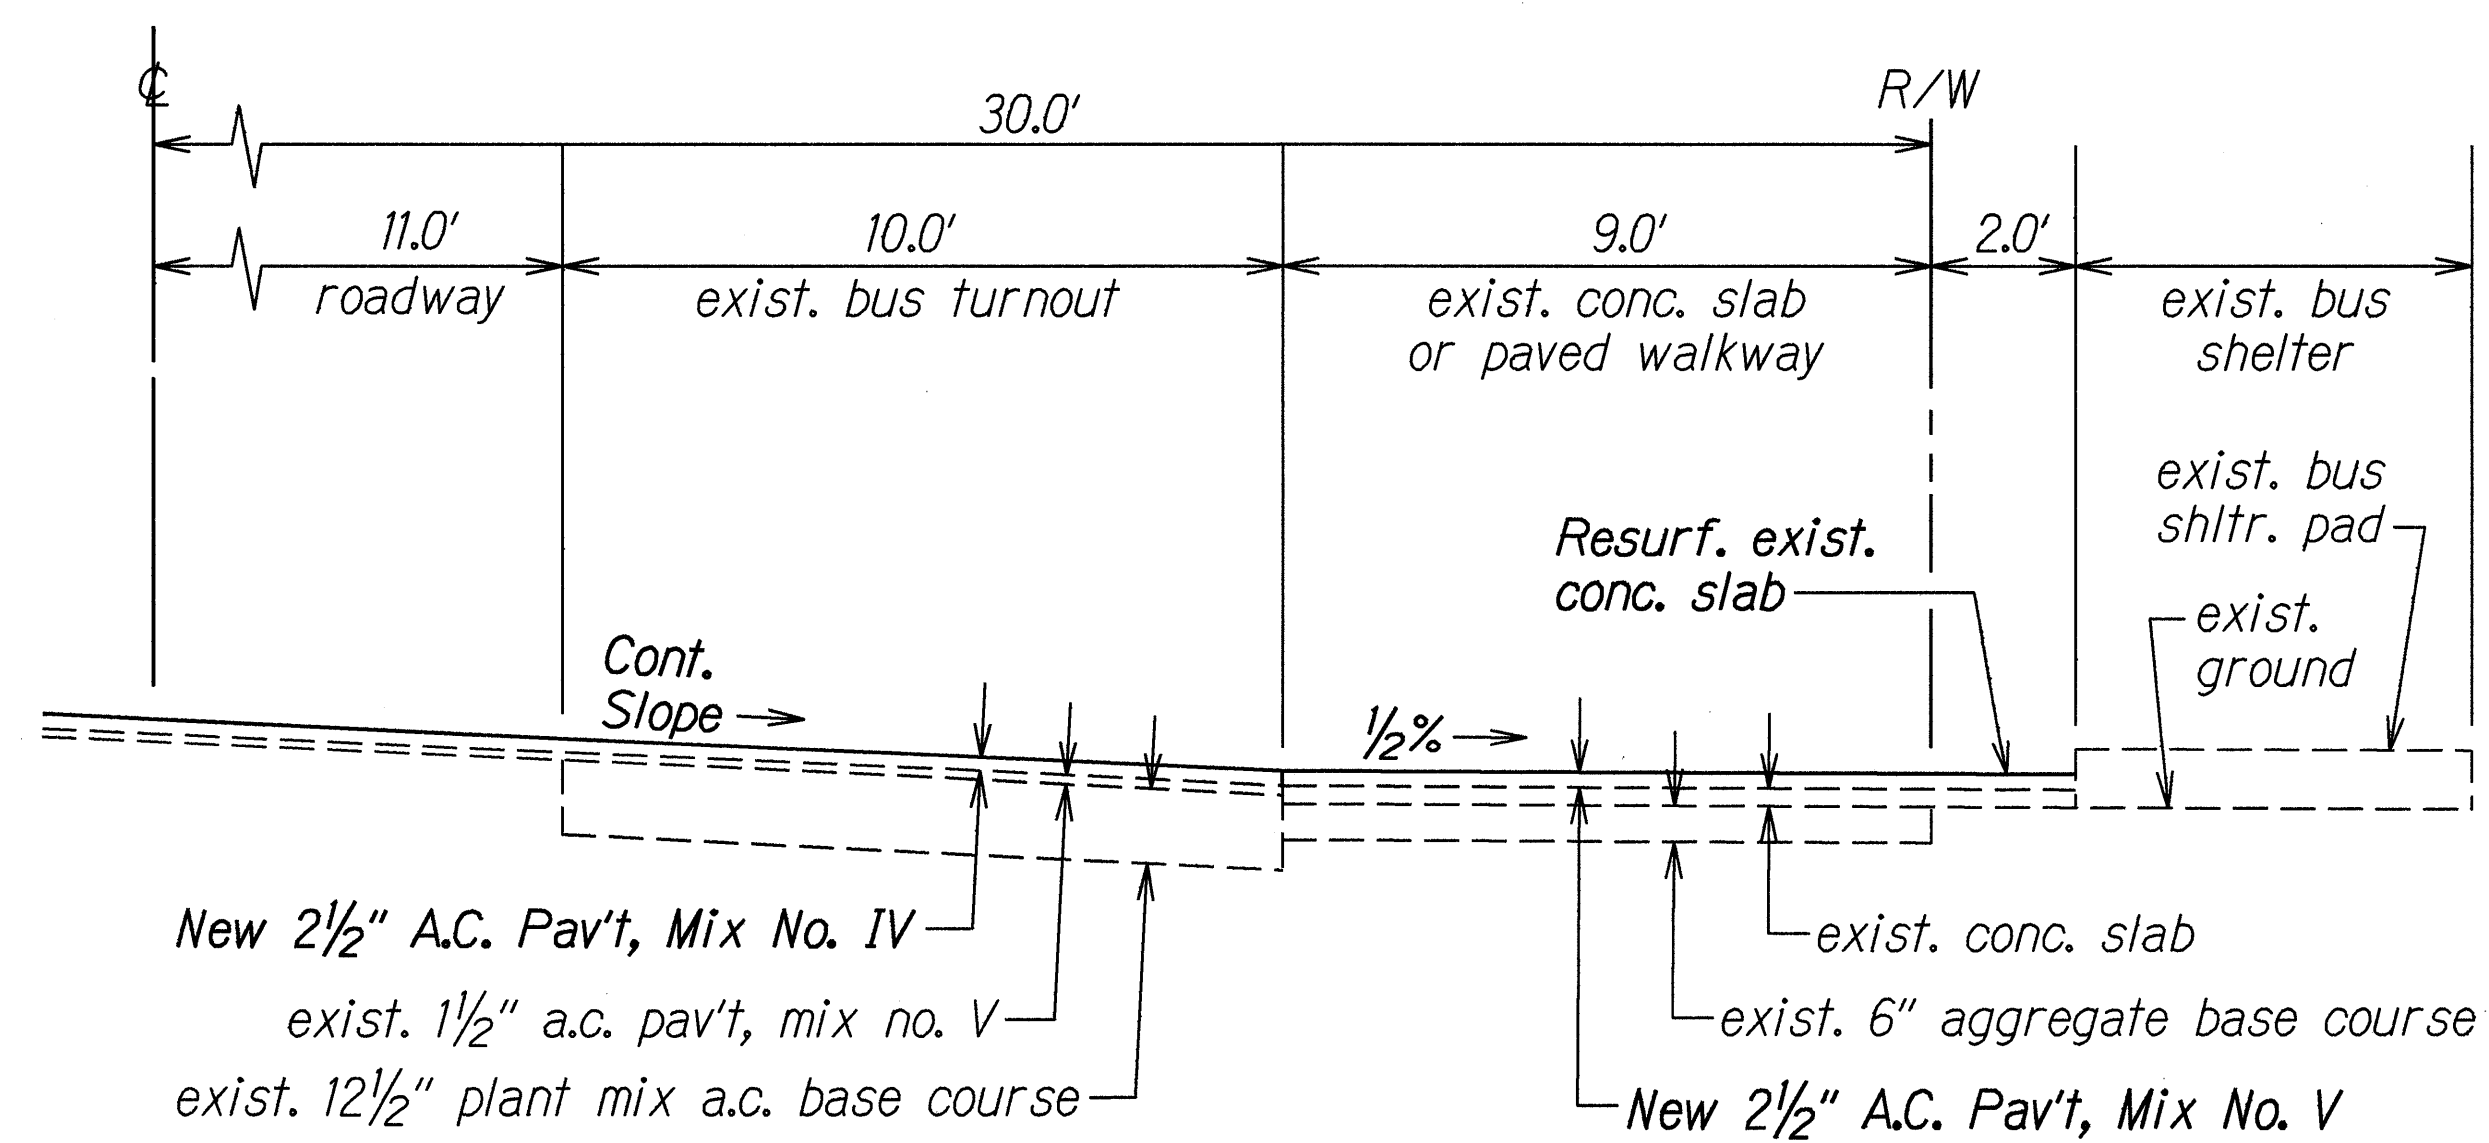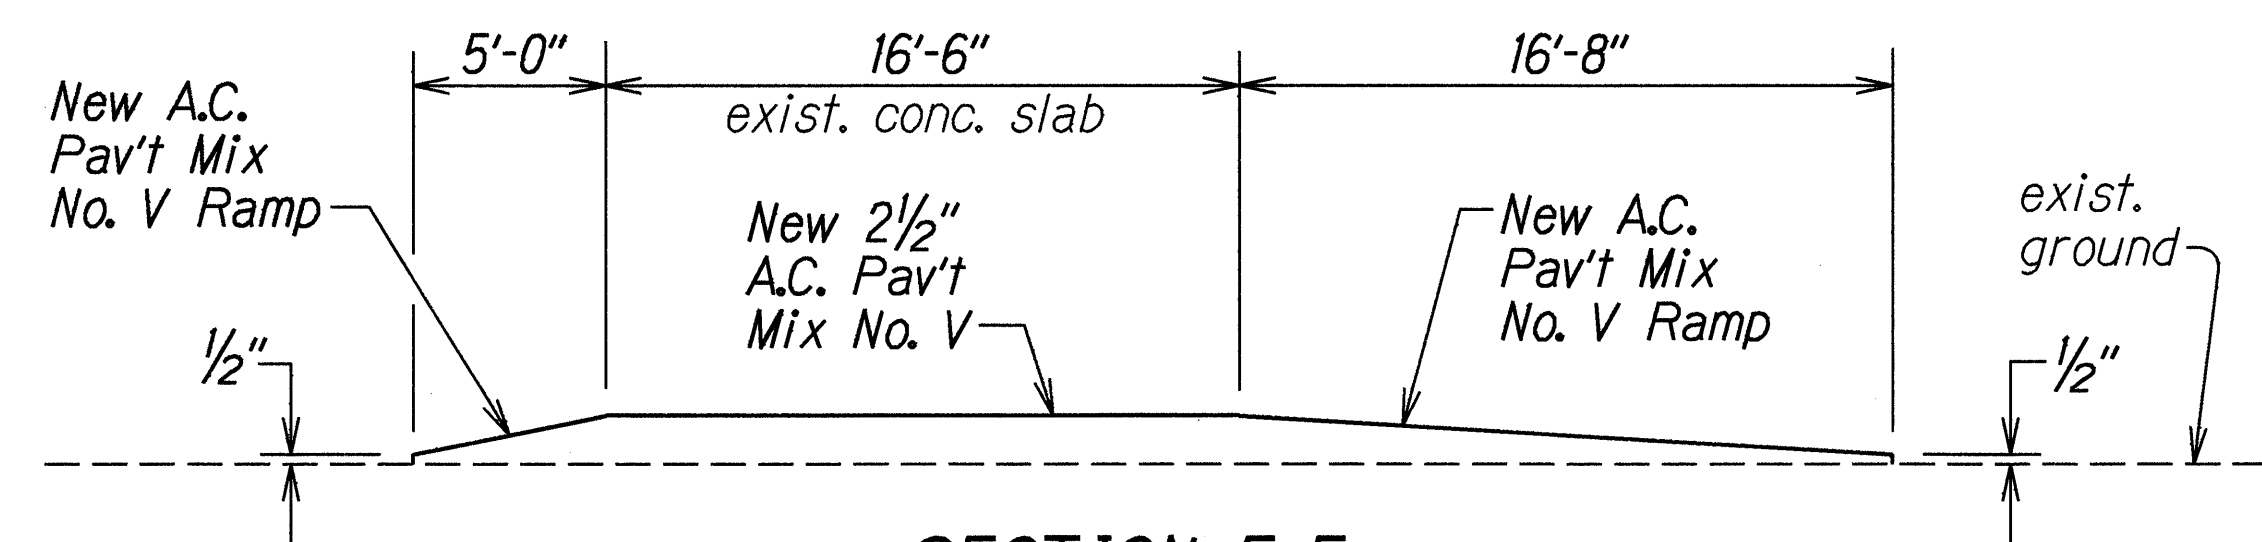

PLAN

N.T.S.

SECTION A-A

N.T.S.

SECTION B-B

N.T.S.

INTERSECTION ISLAND DETAIL

Scale: 1" = 10'

LEGEND FOR AS-BUILT POSTINGS

	Squiggly line for as-built deletion
	Double line for as-built deletion
Roadway	Text for as-built posting

STATE OF HAWAII
DEPARTMENT OF TRANSPORTATION
HIGHWAYS DIVISION

MISCELLANEOUS DETAILS

WHITMORE AVENUE RESURFACING
Kamehameha Highway to Military Gate
Proj. No. 7012A-01-98M


Scale: As Noted Date: Jan. 1998

SHEET No. 5 OF 6 SHEETS


ORIGINAL PLAN	DATE
SURVEY PLOTTED BY	7-22-98
DRAWN BY	
DESIGNED BY	
CHECKED BY	
IN CHARGE	

"AS-BUILT"


FED. ROAD DIST. NO.	STATE	PROJ. NO.	FISCAL YEAR	SHEET NO.	TOTAL SHEETS
HAWAII	HAW.	7012A-01-98M	1999	9	32

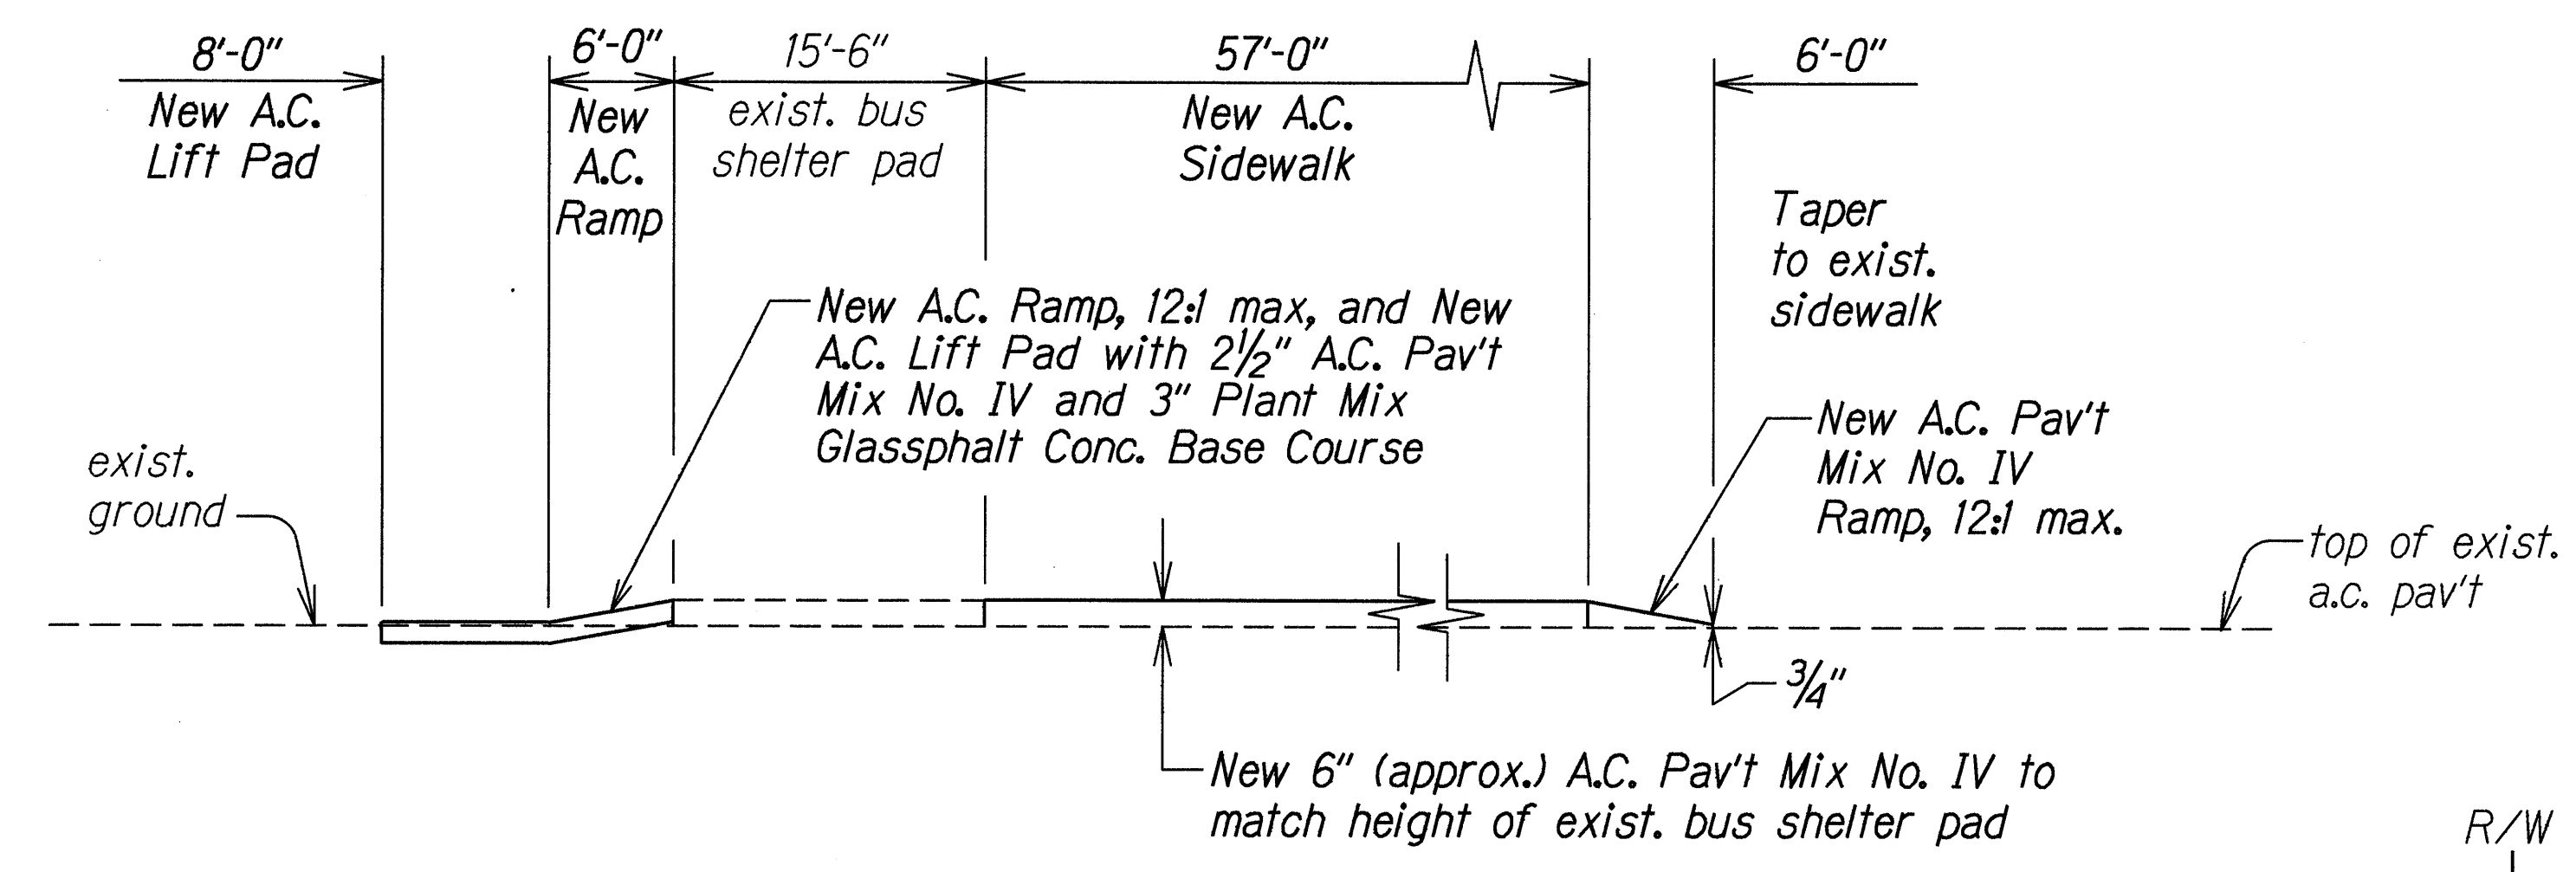


SECTION A-A
Not to Scale

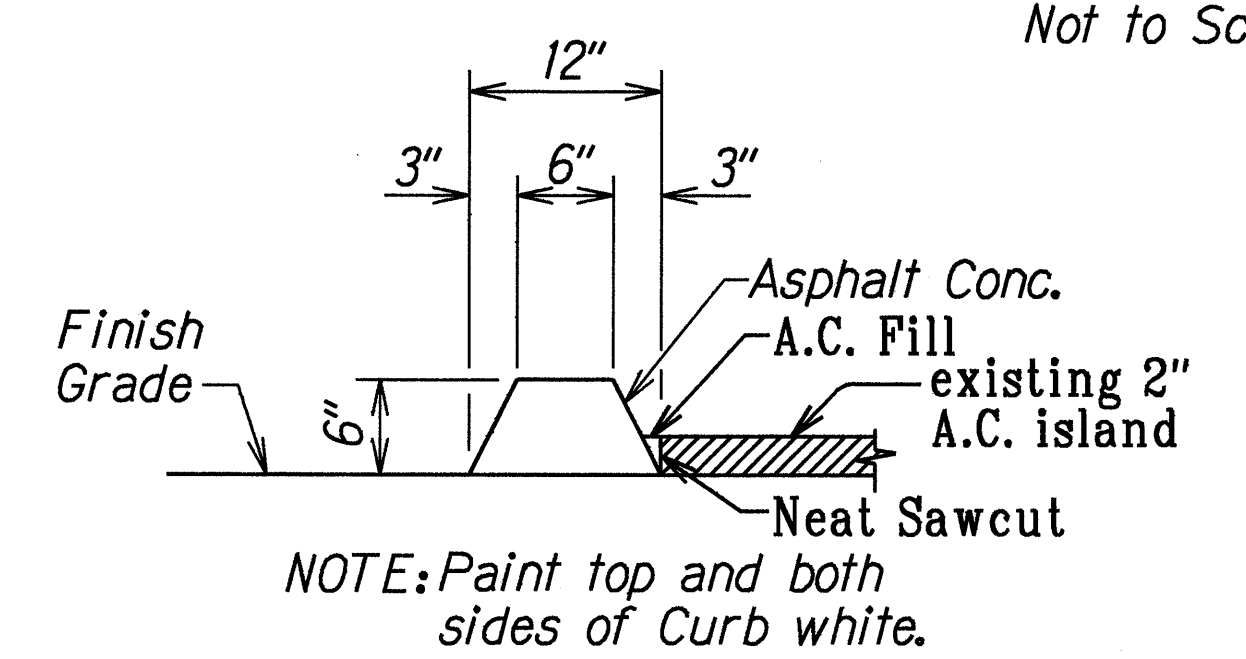


BITUMINOUS CURB, TYPE 6 DETAIL
Scale: 1" = 1'-0"

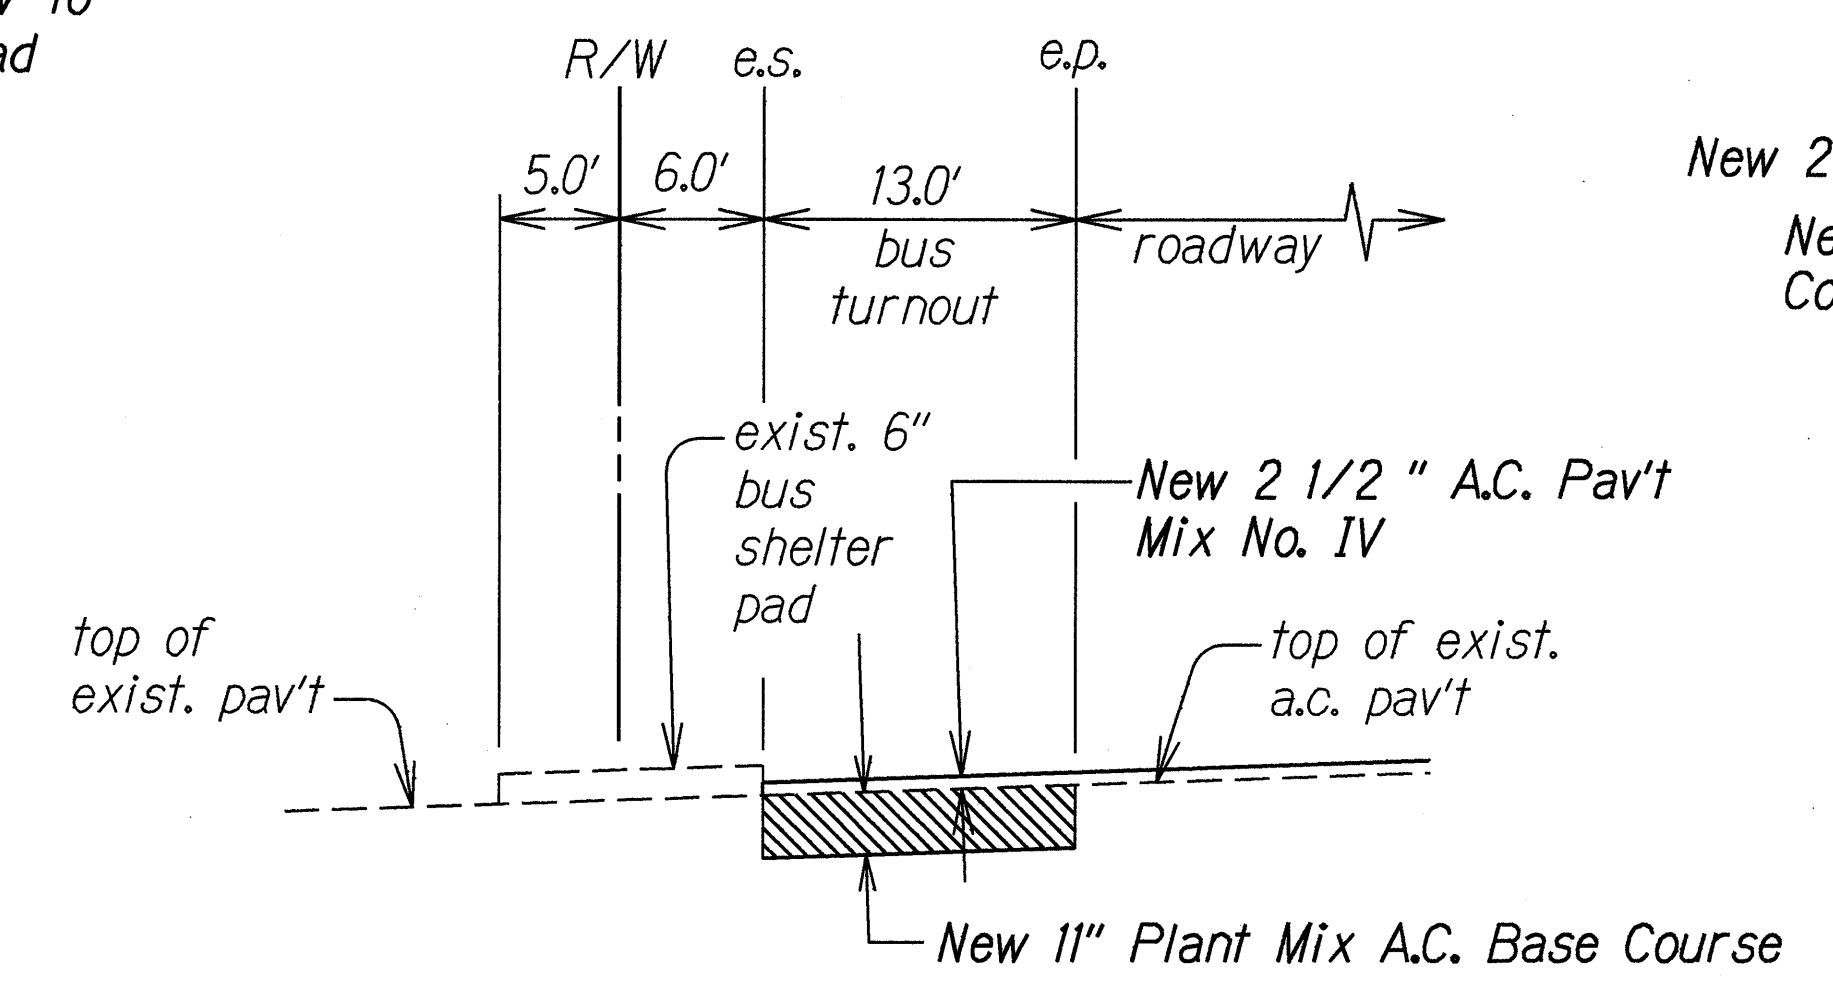


SECTION C-C
Not to Scale

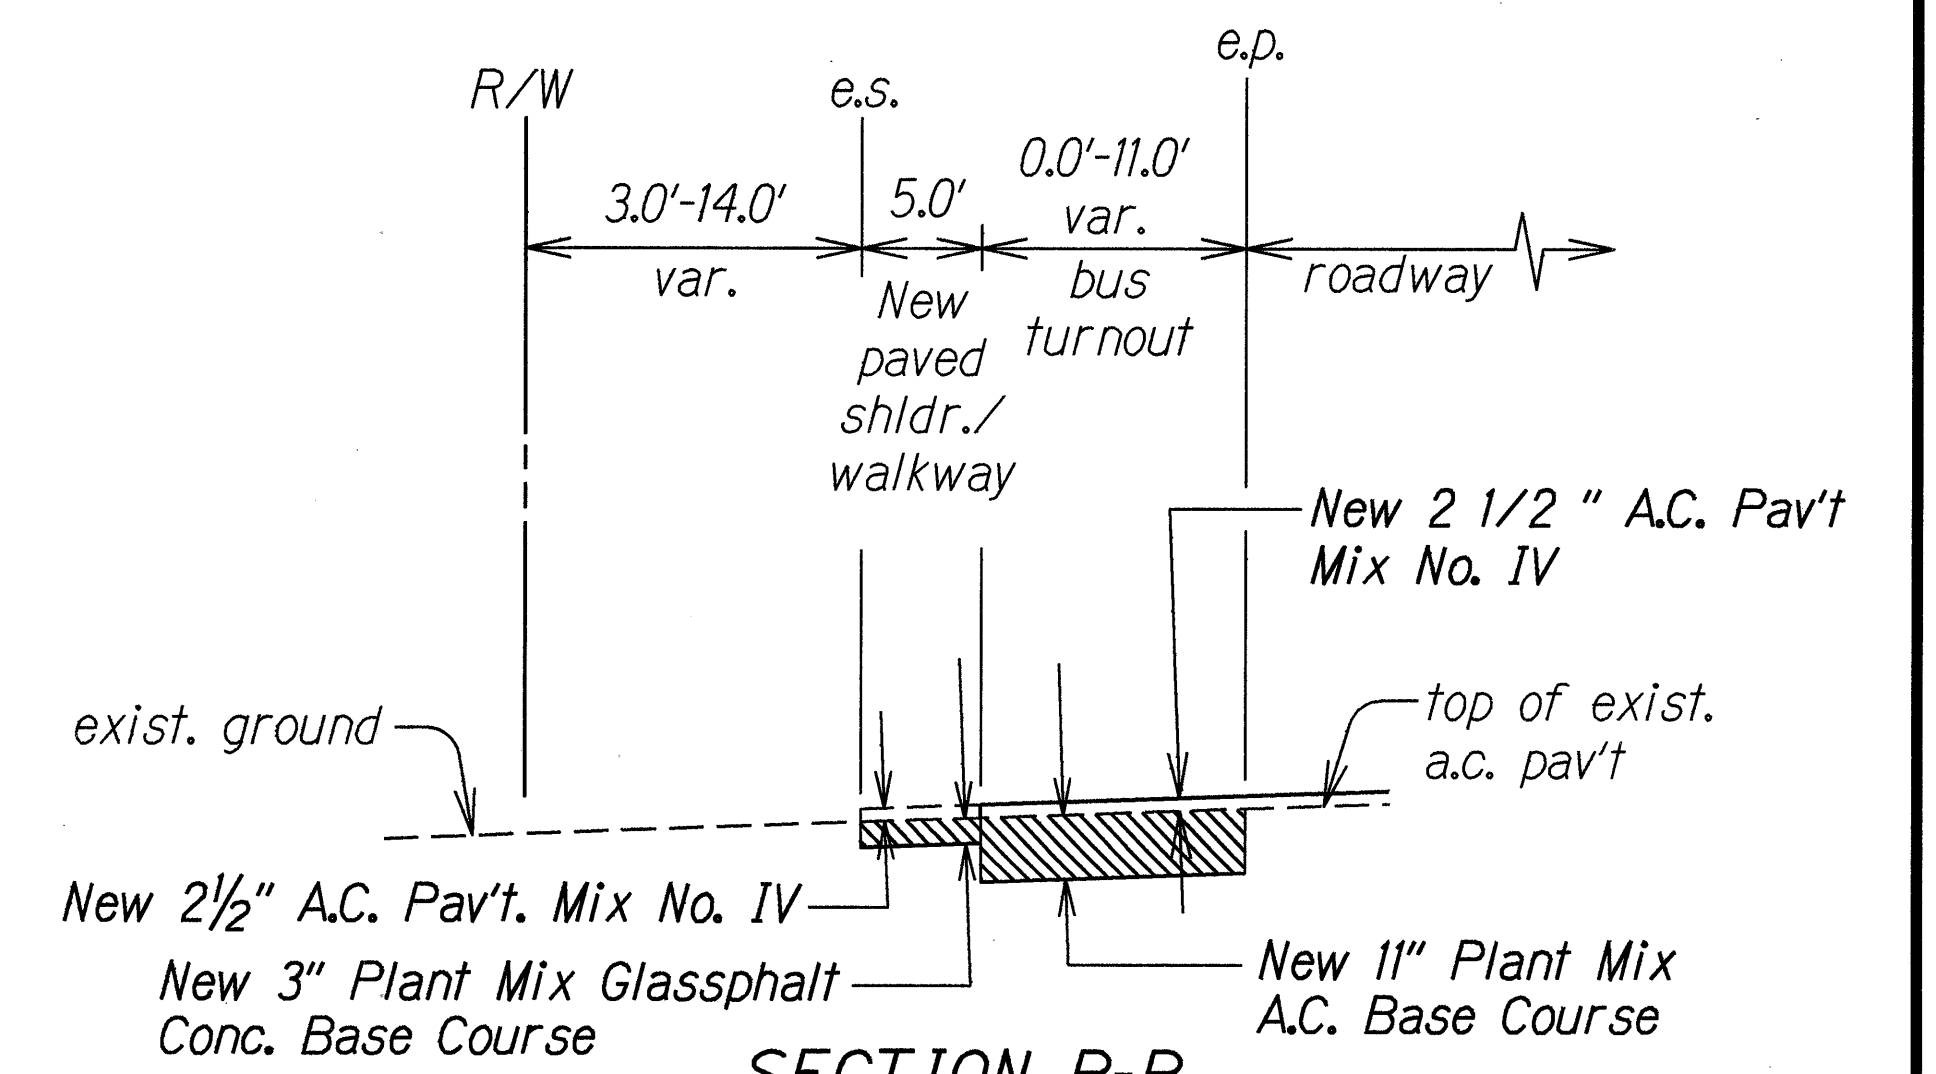

SECTION B-B
Not to Scale

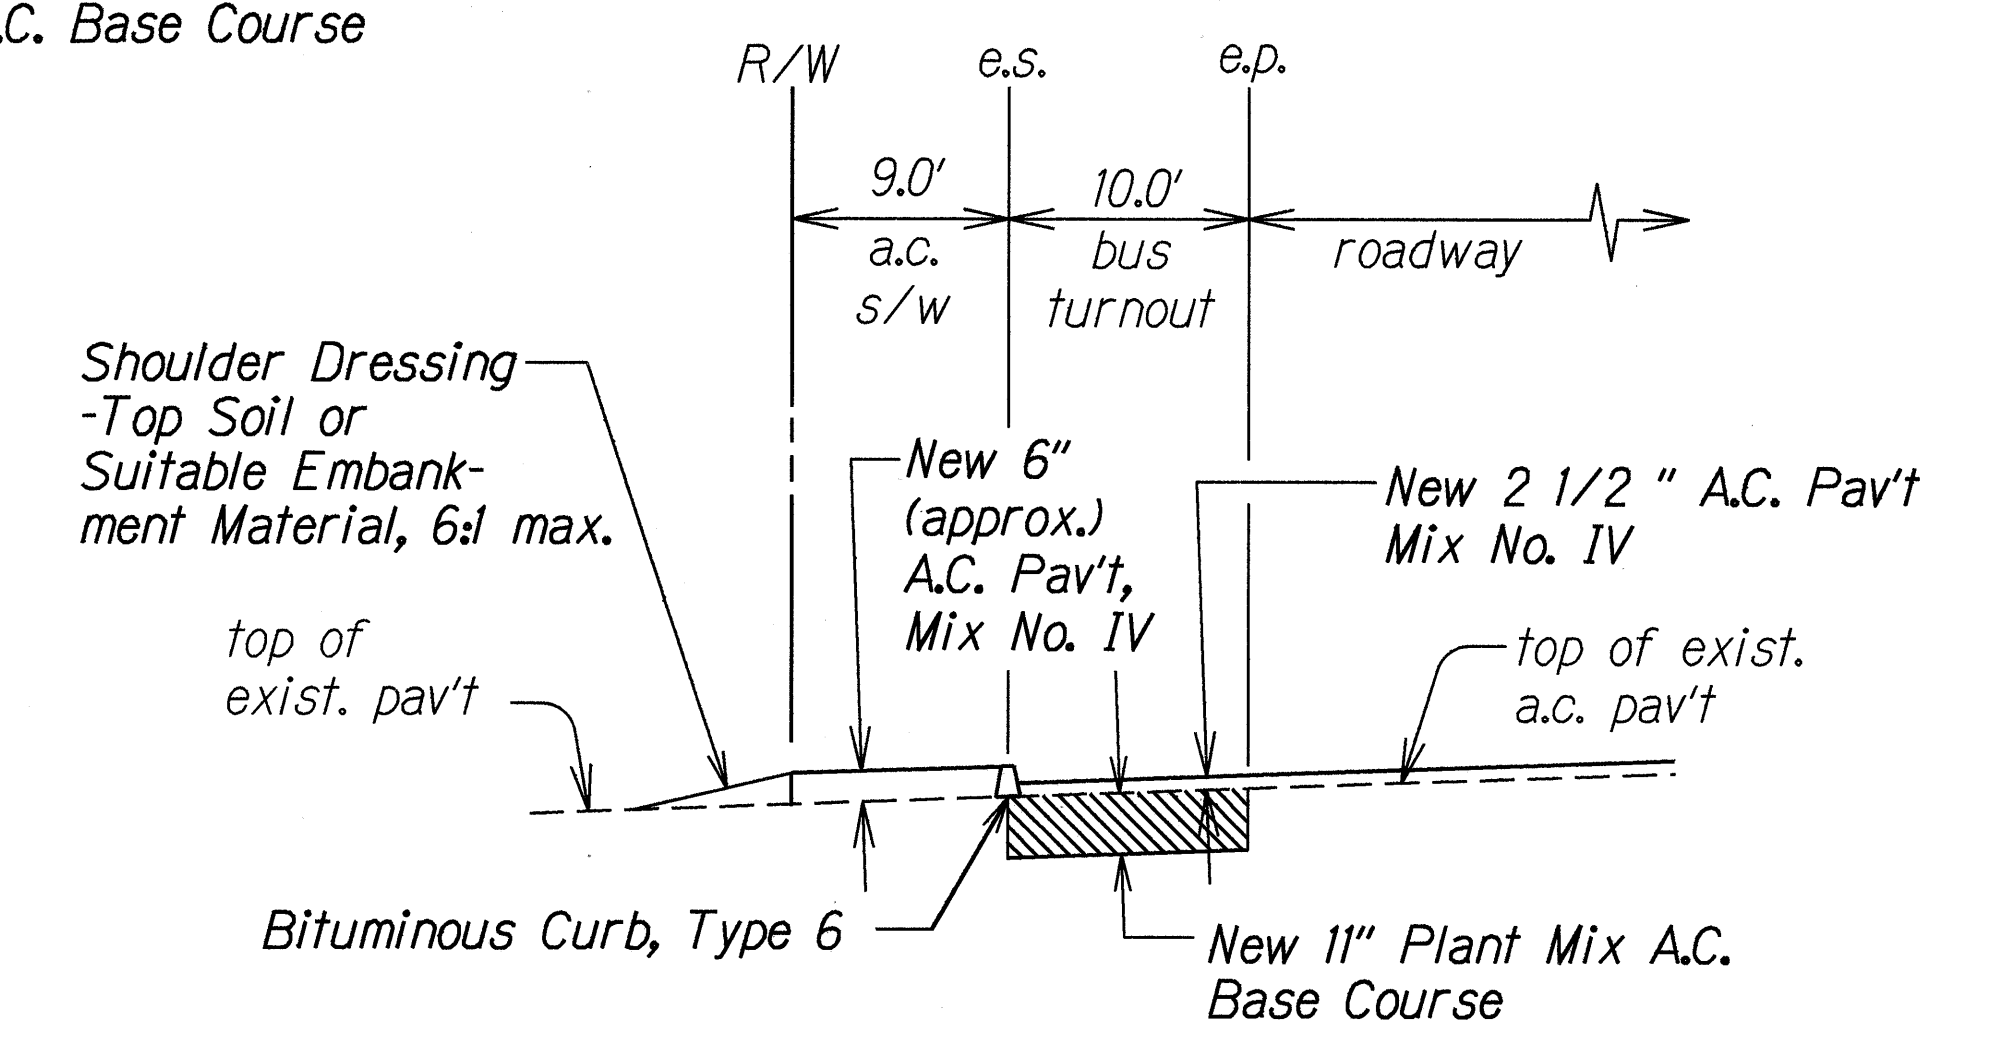

SECTION D-D
Not to Scale

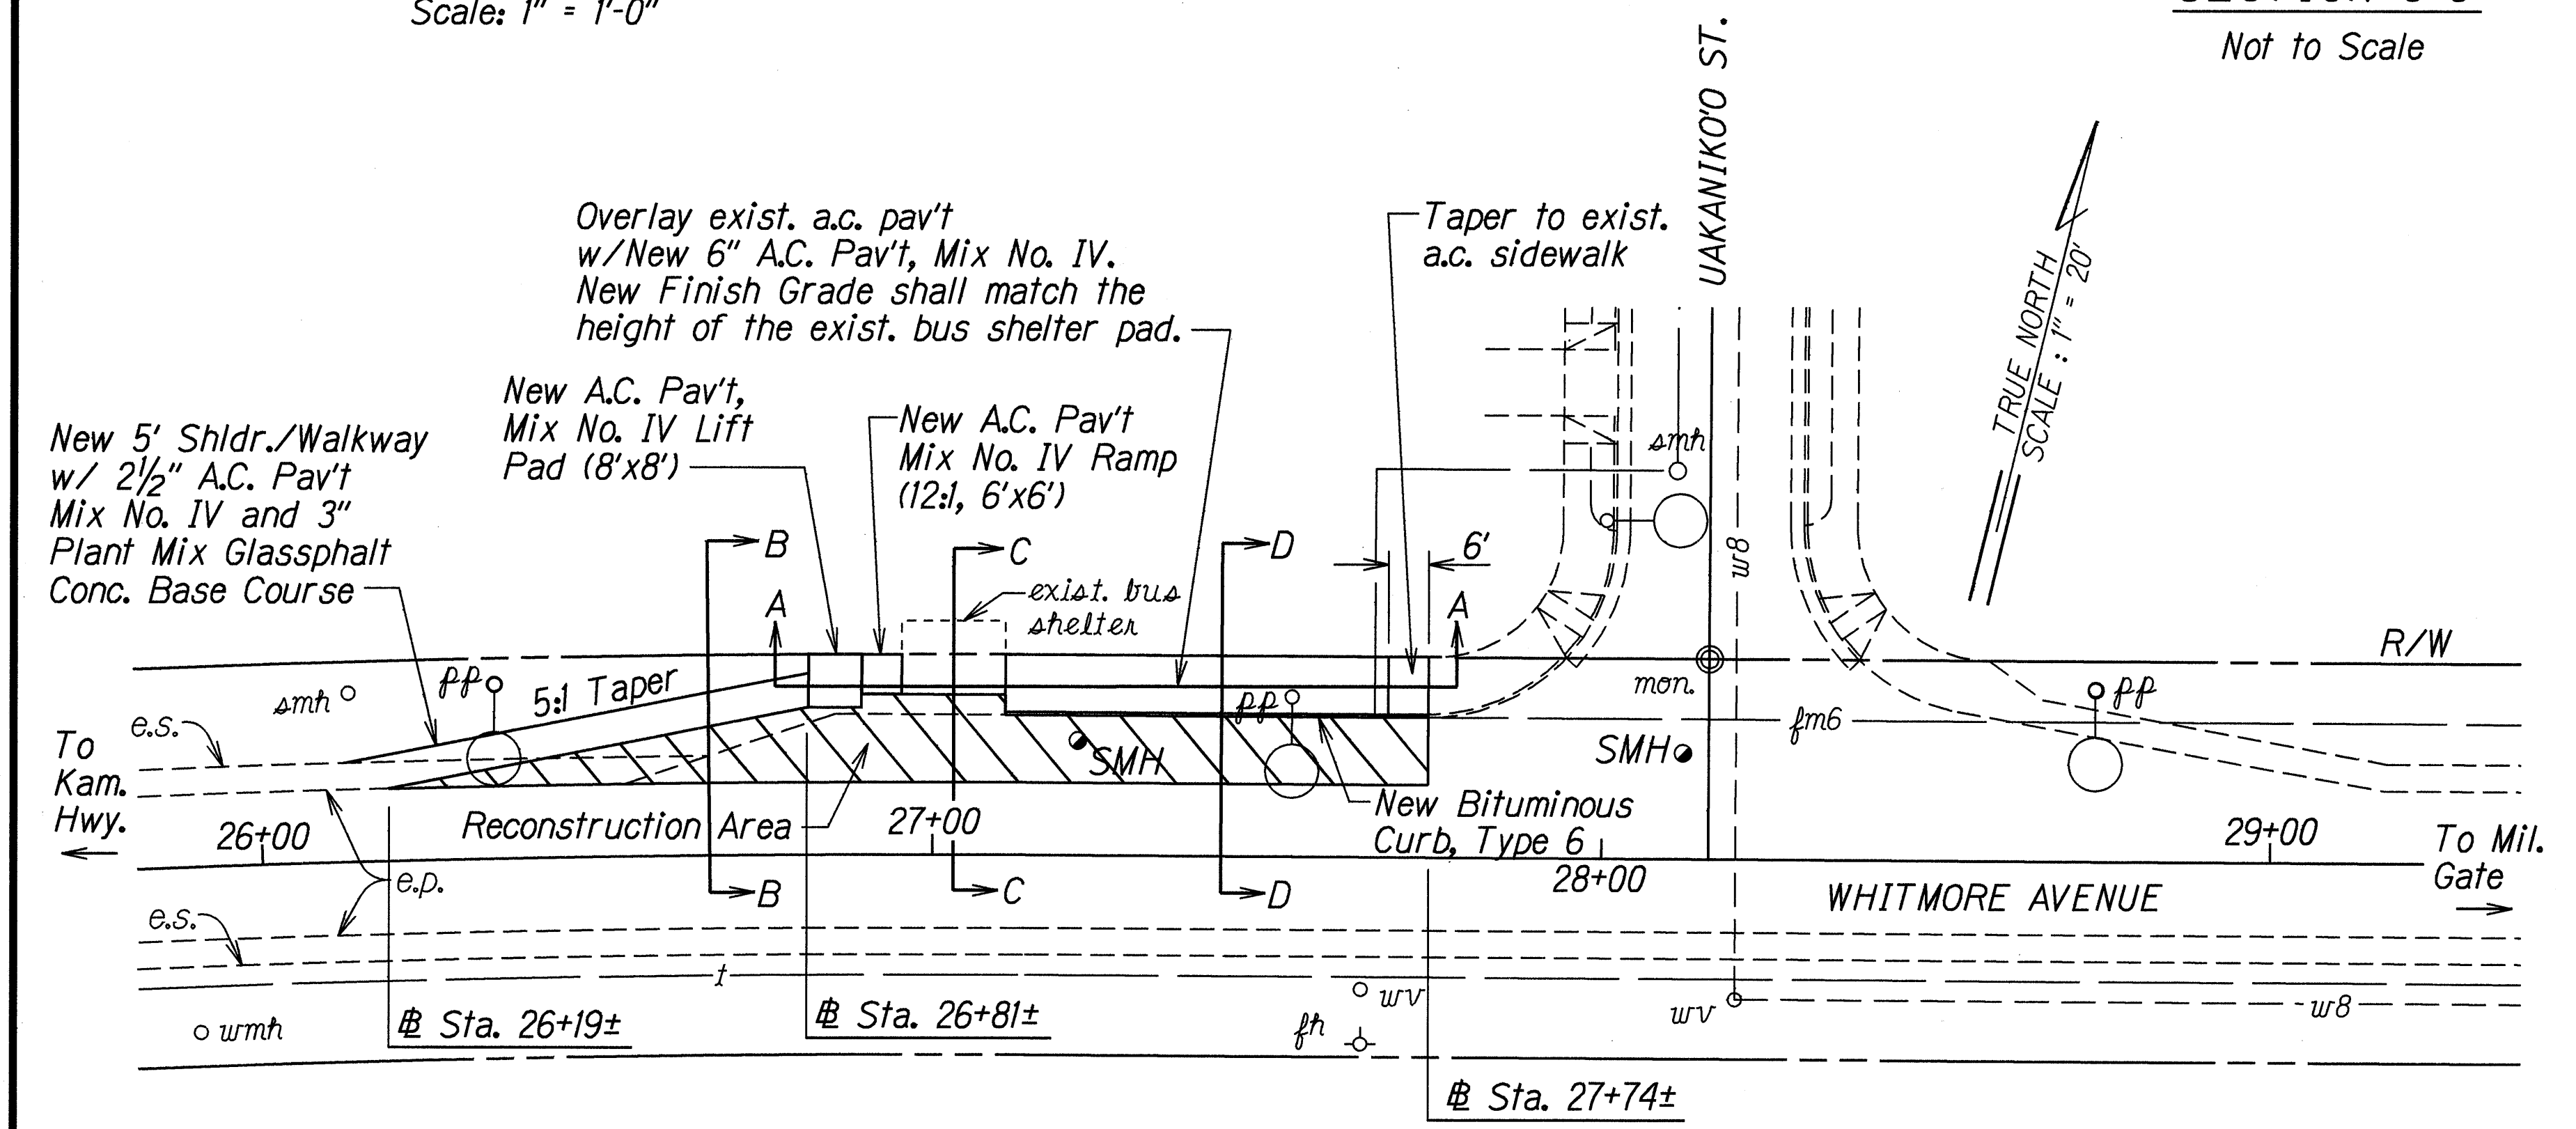

BUS TURNOUT AT UAKANIKO'O STREET
Scale: 1" = 20'

LEGEND FOR AS-BUILT POSTINGS	
	Squiggly line for as-built deletion
	Double line for as-built deletion
Roadway	Text for as-built posting

STATE OF HAWAII
DEPARTMENT OF TRANSPORTATION
HIGHWAYS DIVISION

MISCELLANEOUS DETAILS

WHITMORE AVENUE RESURFACING
Kamehameha Highway to Military Gate
Proj. No. 7012A-01-98M

Scale: As Noted Date: Jan. 1998

SHEET No. 6 OF 6 SHEETS

DATE	7-30-98
SURVEY PLOTTED BY	MM
DRAWN BY	LS
DESIGNED BY	LS
CHECKED BY	LS
ORIGINAL PLAN	del
NOTE BOOK	del
DATE	7-30-98
BY	MM