




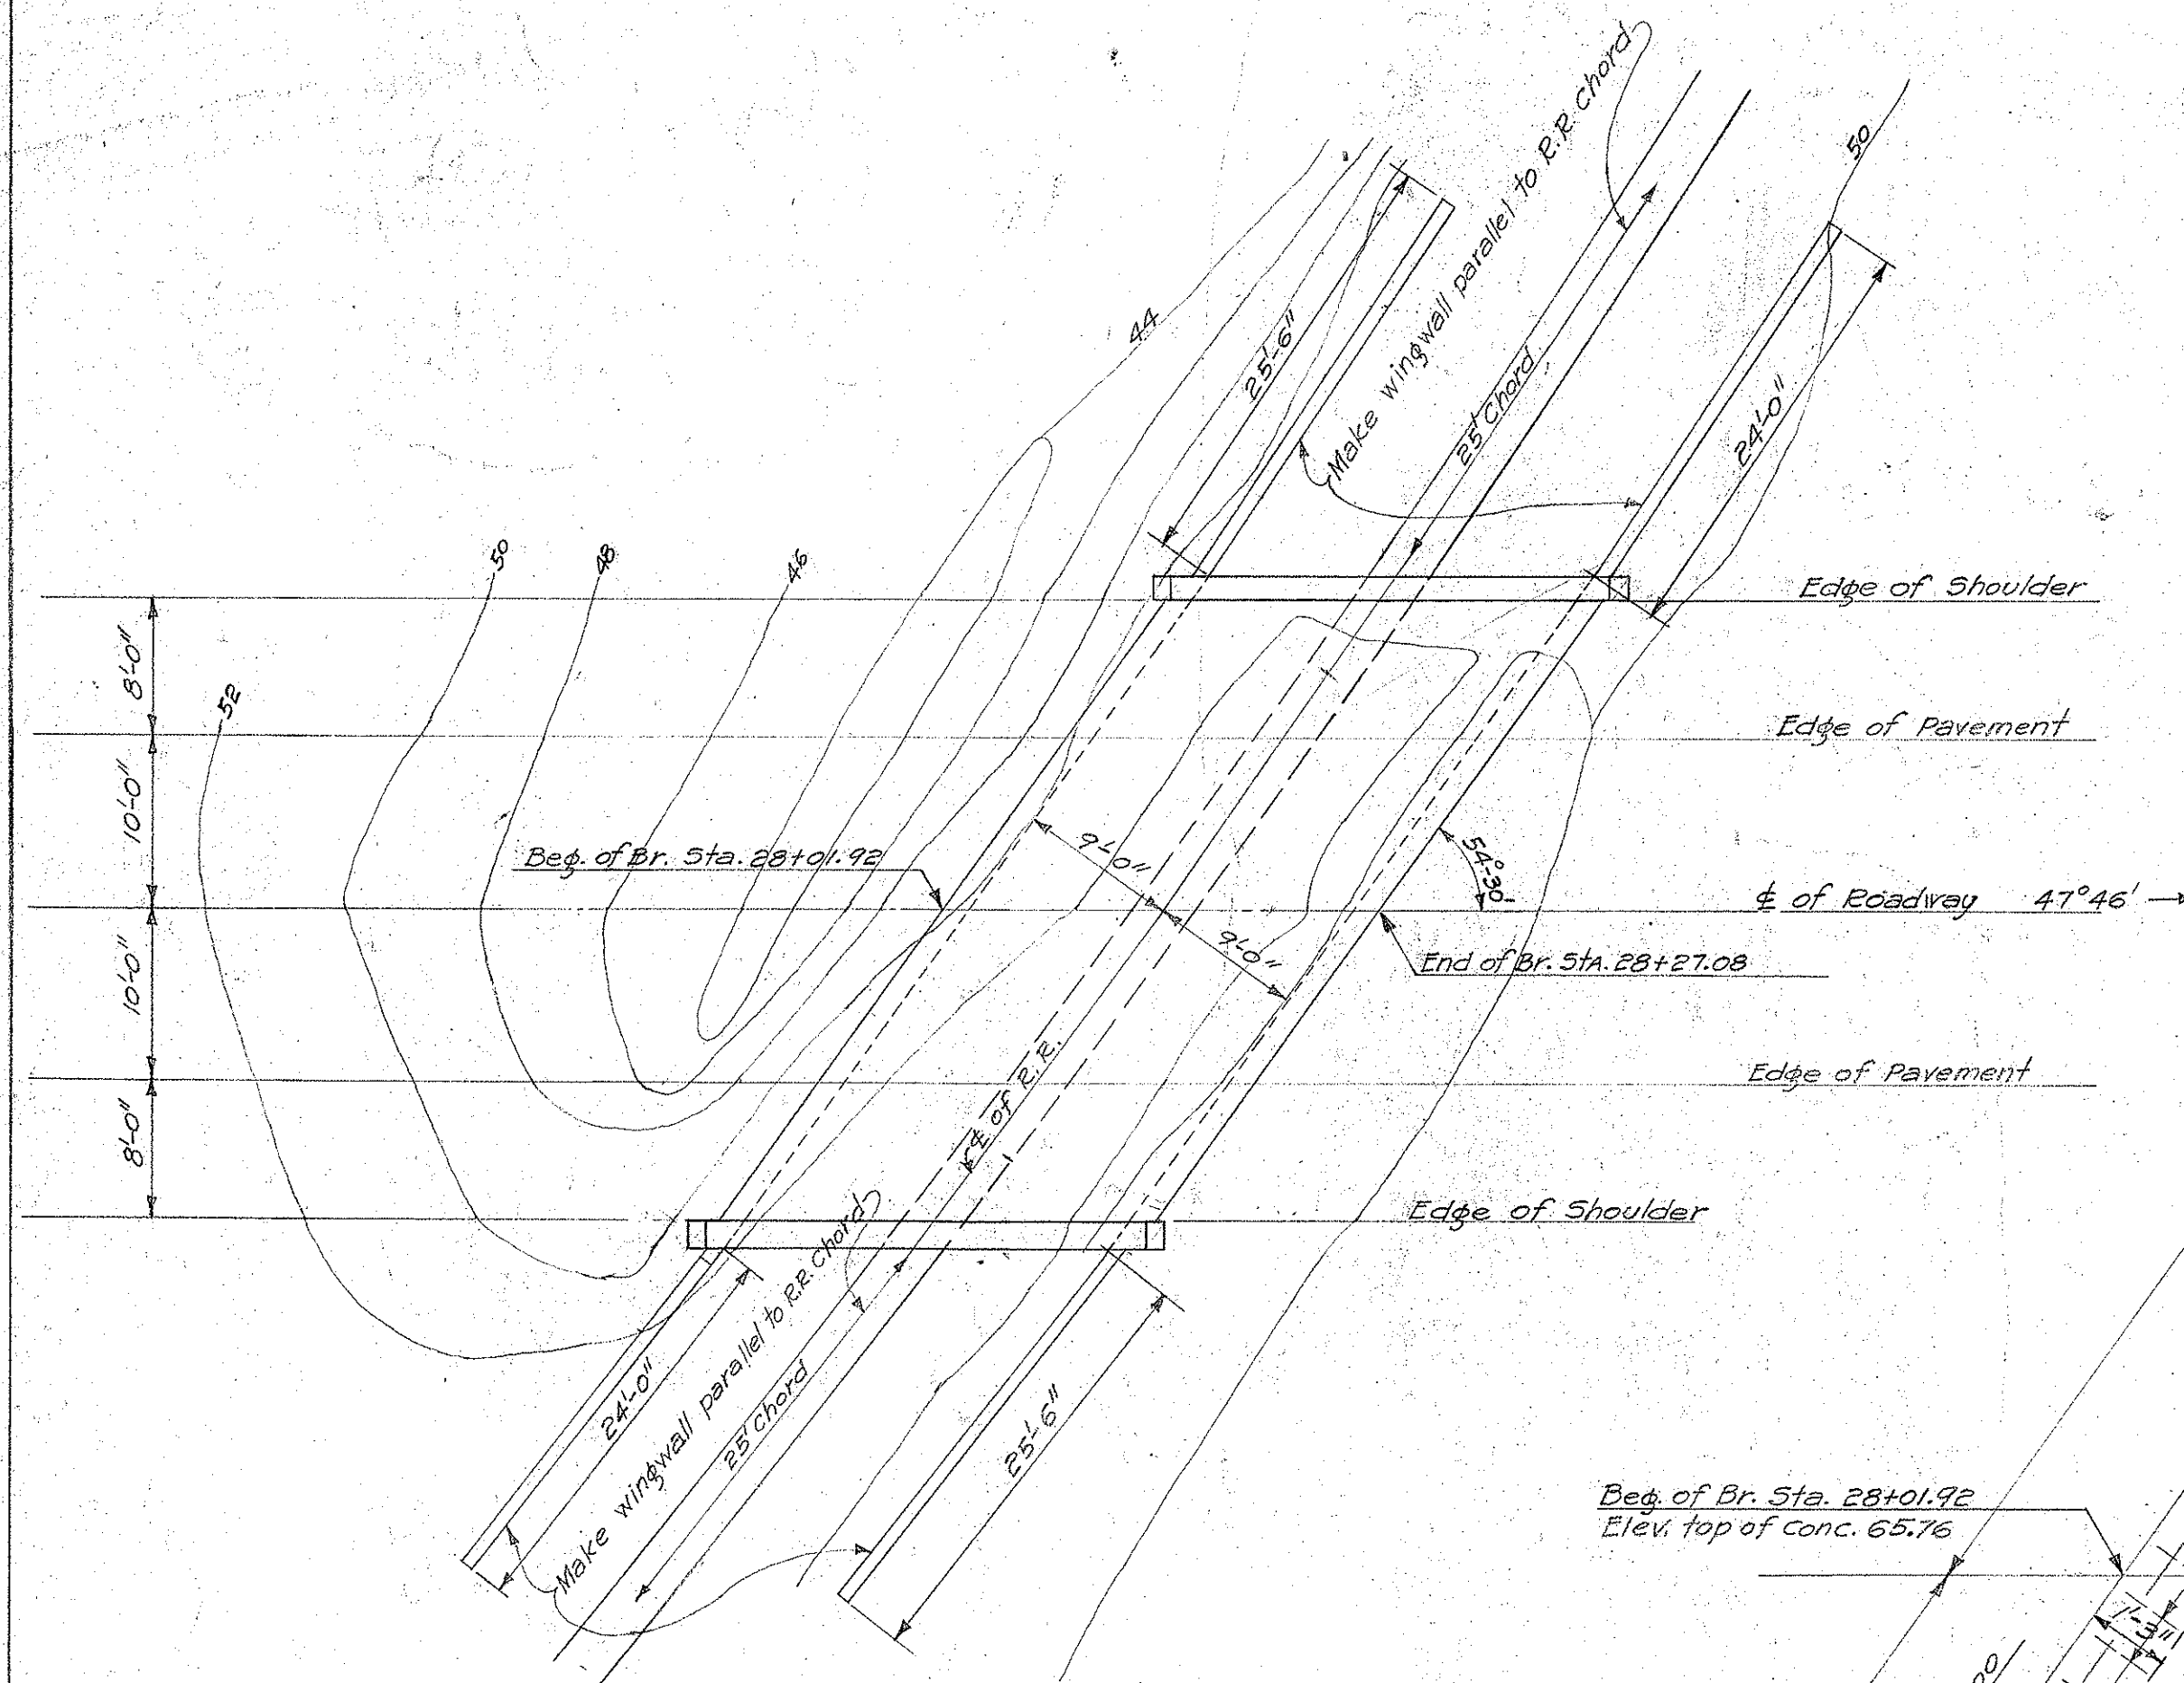


LAYOUT PLAN
Scale 1"=10'

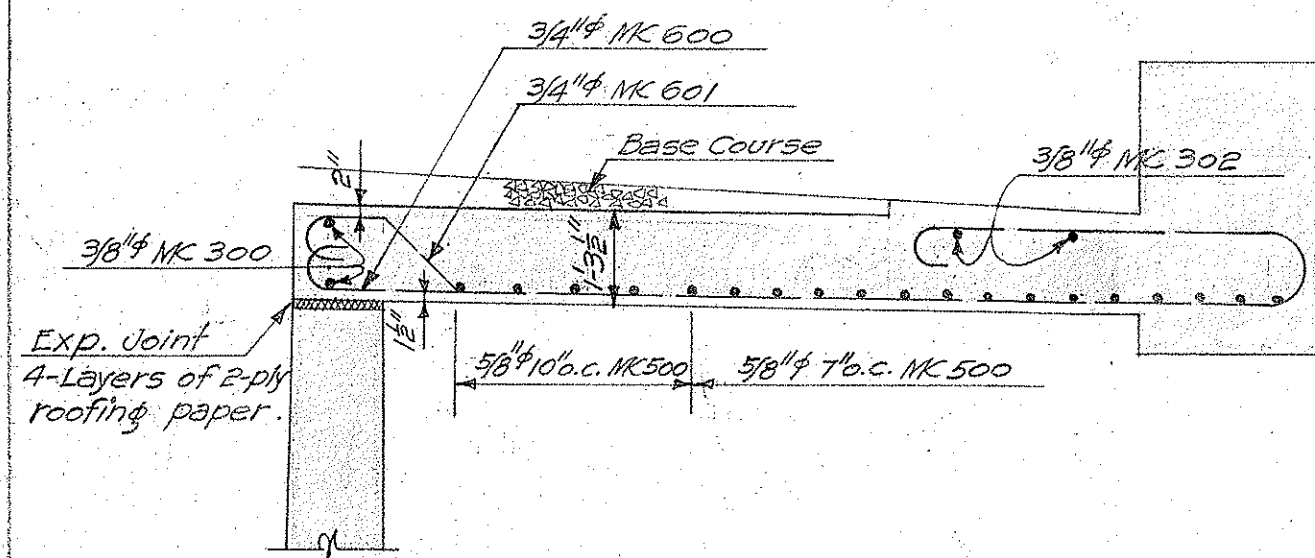

SECT. B-B
Scale 3/8"=1'0"

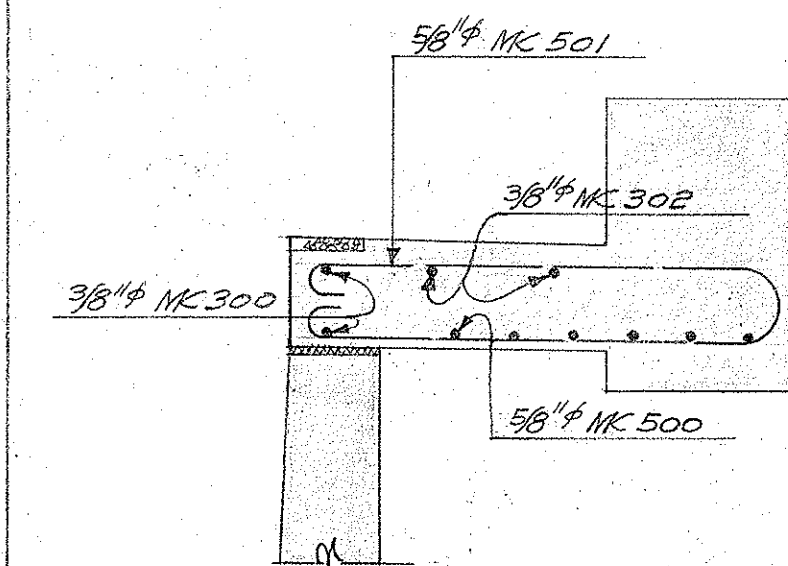

SECT. C-C
Scale 3/8"=1'0"

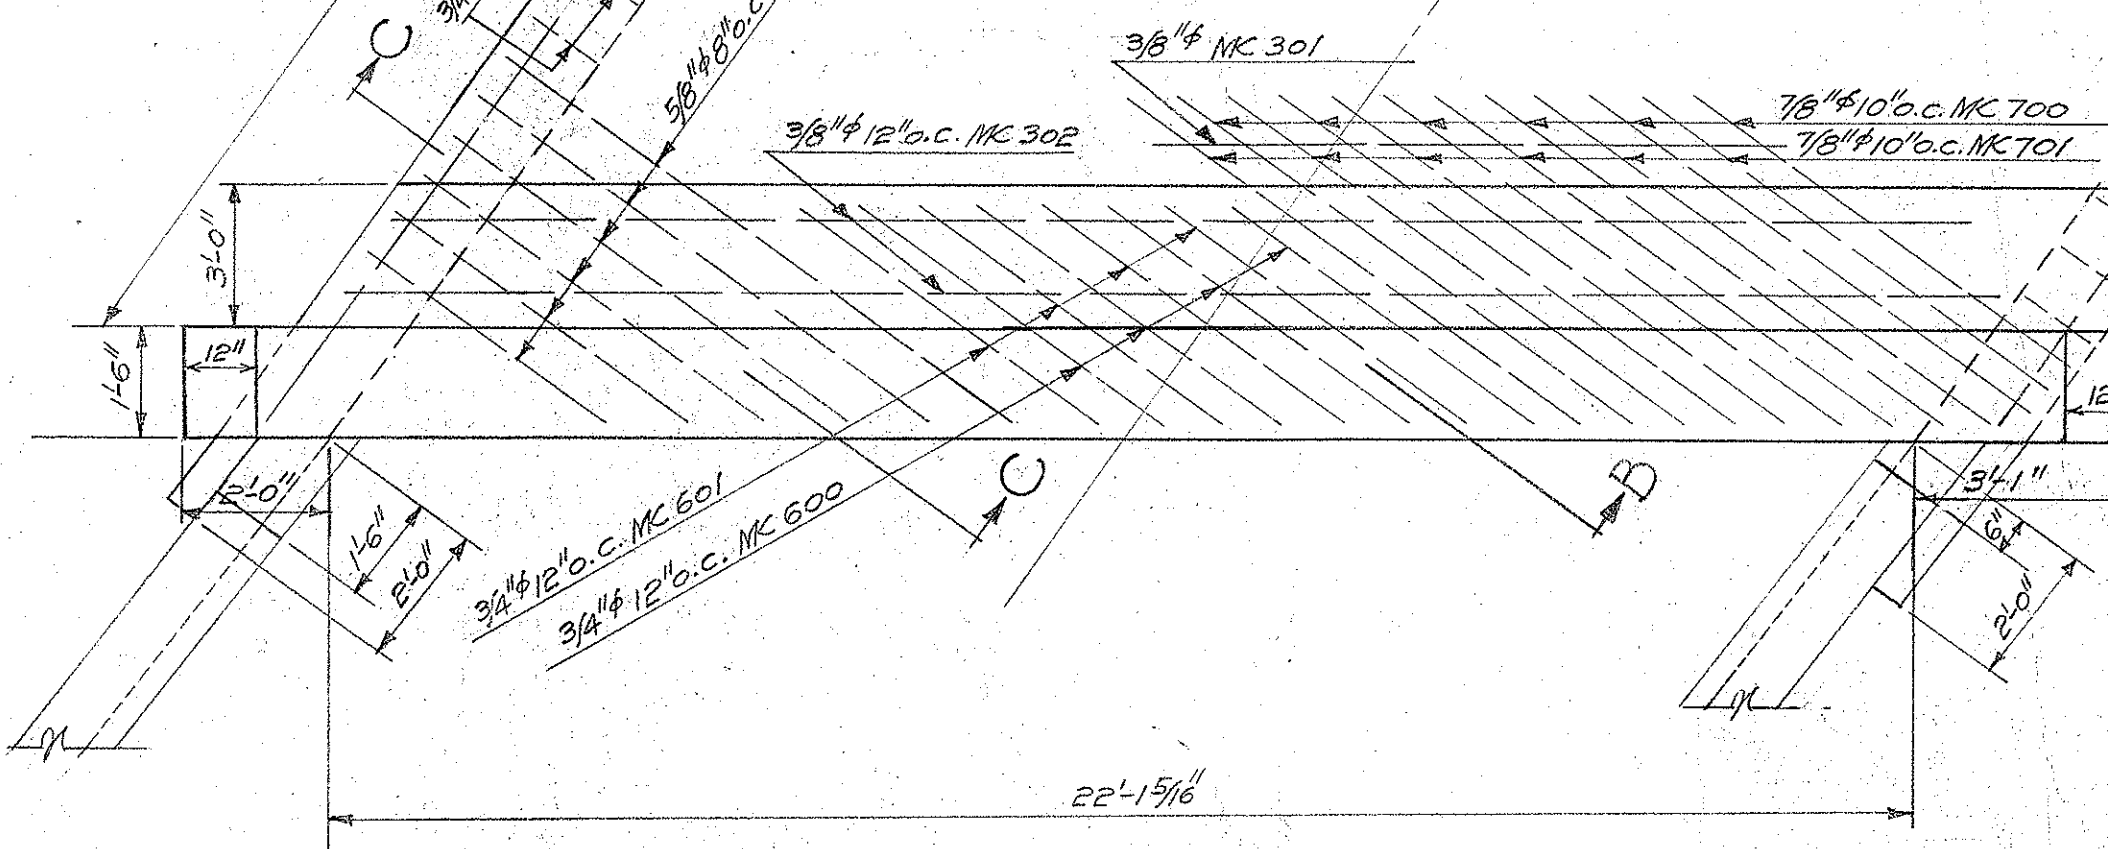


DECK REINF.
Scale 3/8"=1'0"

ESTIMATED QUANTITIES				
LOCATION	GLASS "A" CONC. C.Y.	REINF. ST. LBS	STRUCT. EXC. C.Y.	UNCLASS. EXC. C.Y.
Superstr.	55.3	7940		
Abut.	103.1	11656		
Wingwalls	33.9	3330		
Footings (Abut.)	77.0	4965	193.0	
Footings (W.W.)	33.1	1707	154.0	
Total	302.4	23,598	347.0	147.0


WATERBOUND MACADAM TYPE "B" & SURFACE TREATMENT

Mineral Aggregate	19.0 C.Y.
Filler	5.0 C.Y.
Sprinkling	1000 Gal.
Liquid Asphalt Primer	31.0 Gal.
Bituminous Binder	60.0 Gal.
Screenings	2.0 C.Y.
Chips	1.0 C.Y.

4450.17

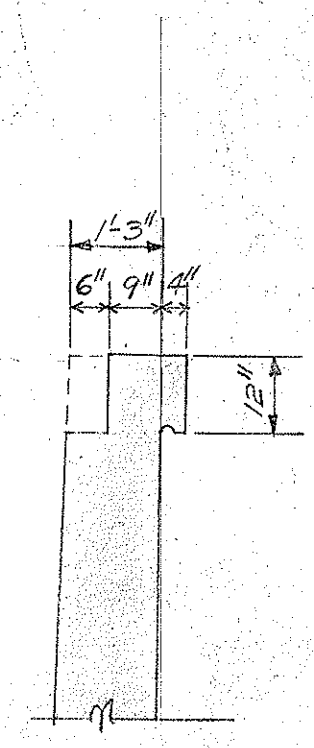

SECT. X-X

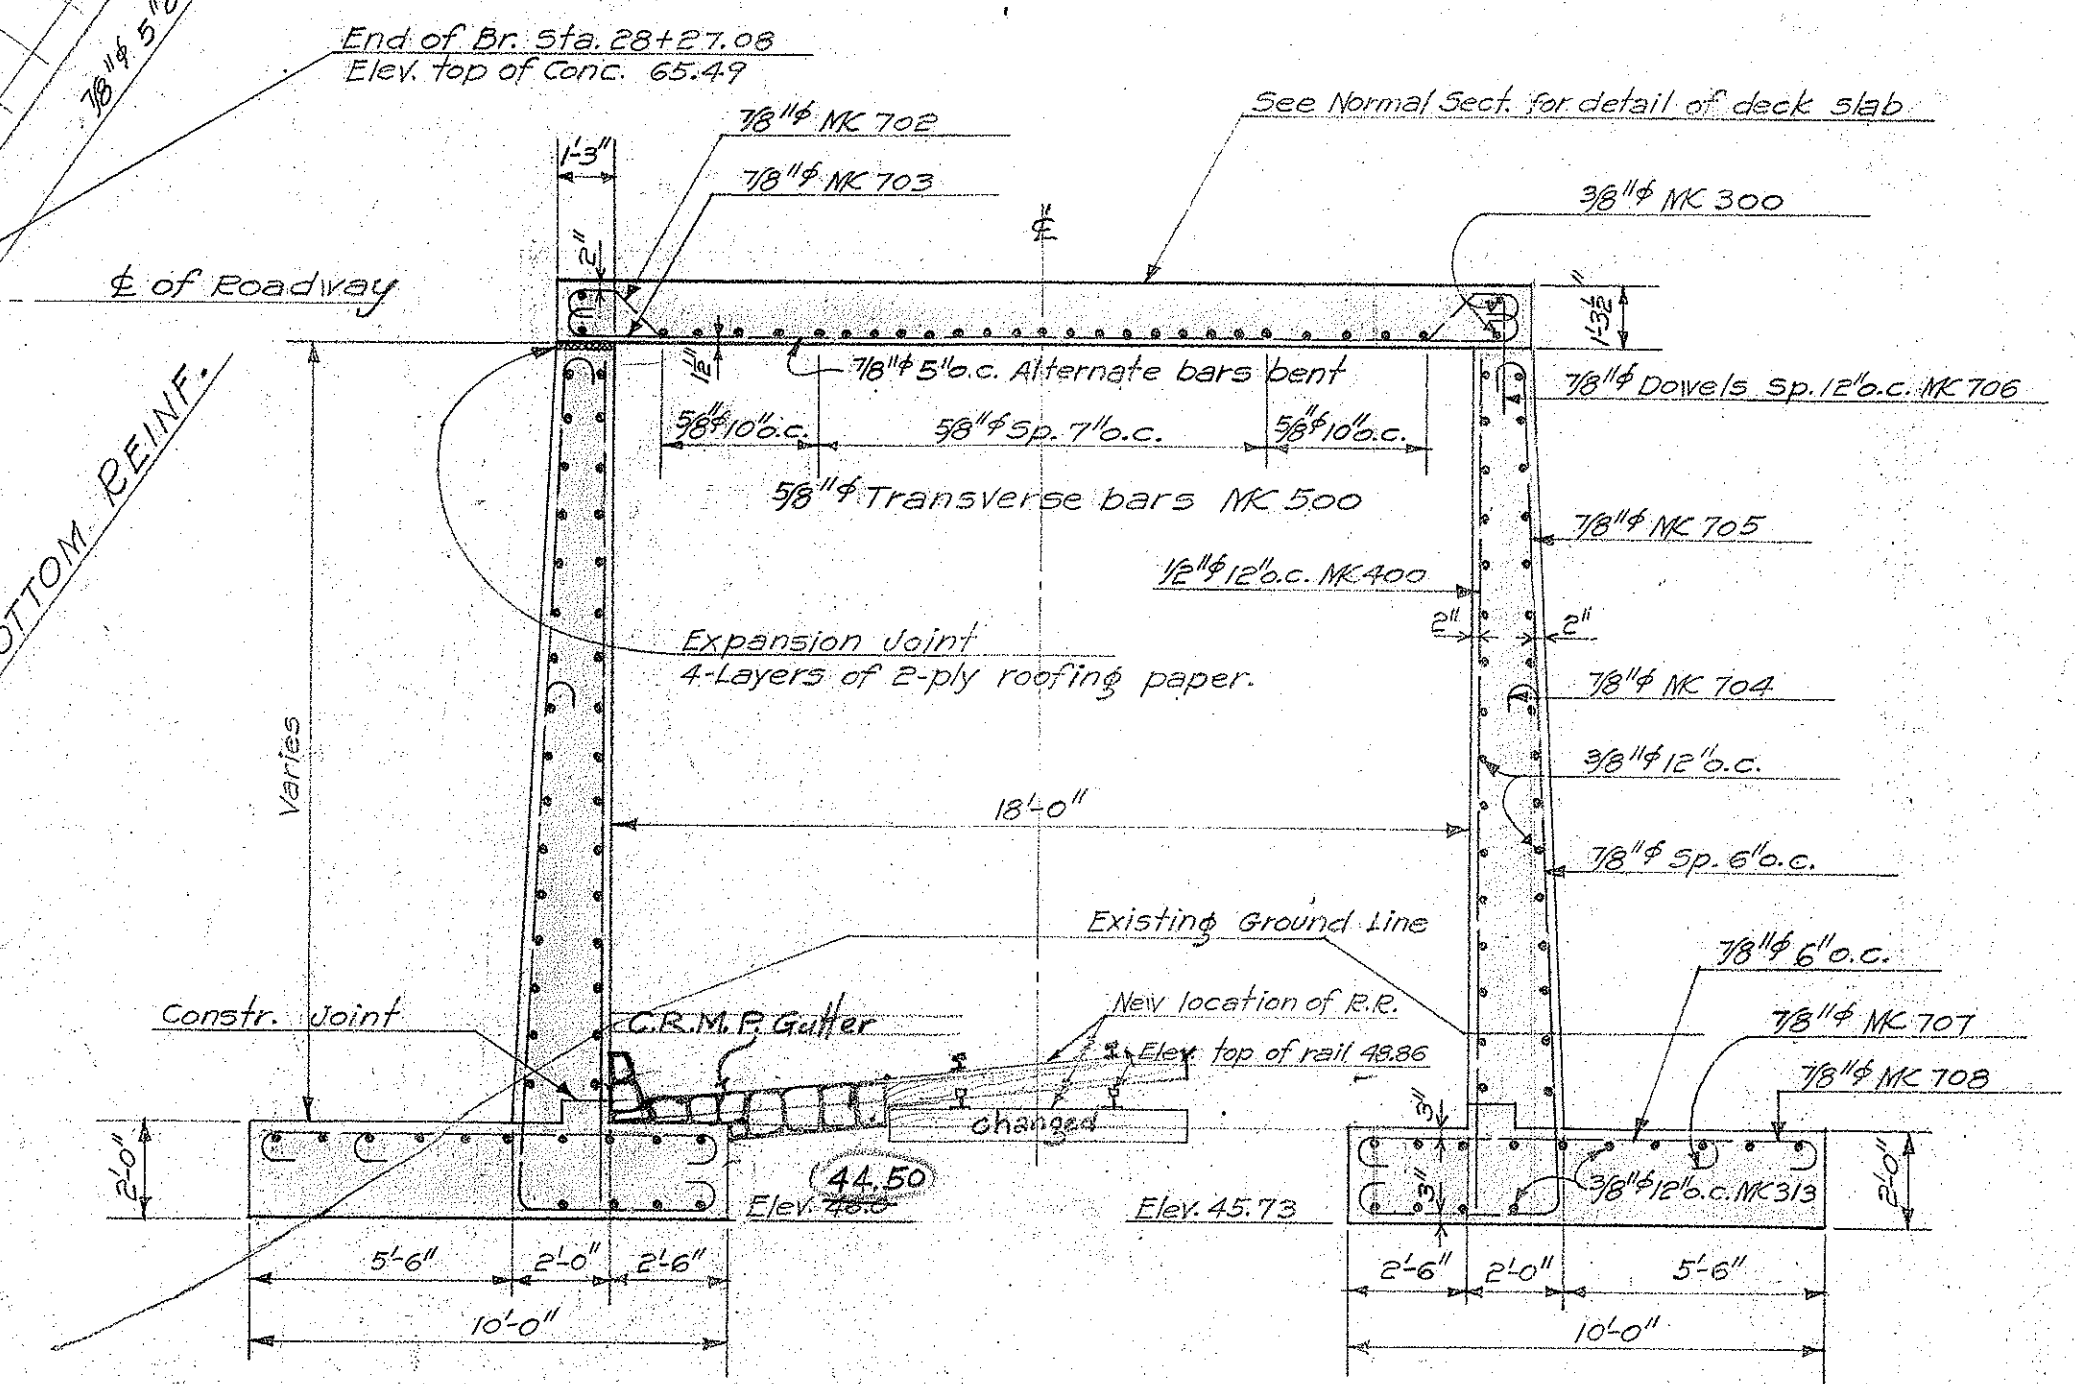


SECT. A-A
Scale 1/4"=1'0"


TERRITORIAL HIGHWAY DEPARTMENT
TERRITORY OF HAWAII

HIGHWAY OVERPASS
STA. 28+01.92 TO 28+27.08
VAIANAE ROAD F.A.G.H. 4-C


FED. ROAD DIST. NO.	STATE	FED. AID PROJ. NO.	FISCAL YEAR	SHEET NO.	TOTAL SHEETS
HAWAII	HAW	F.A.G.H. 4-C	1938	18	40

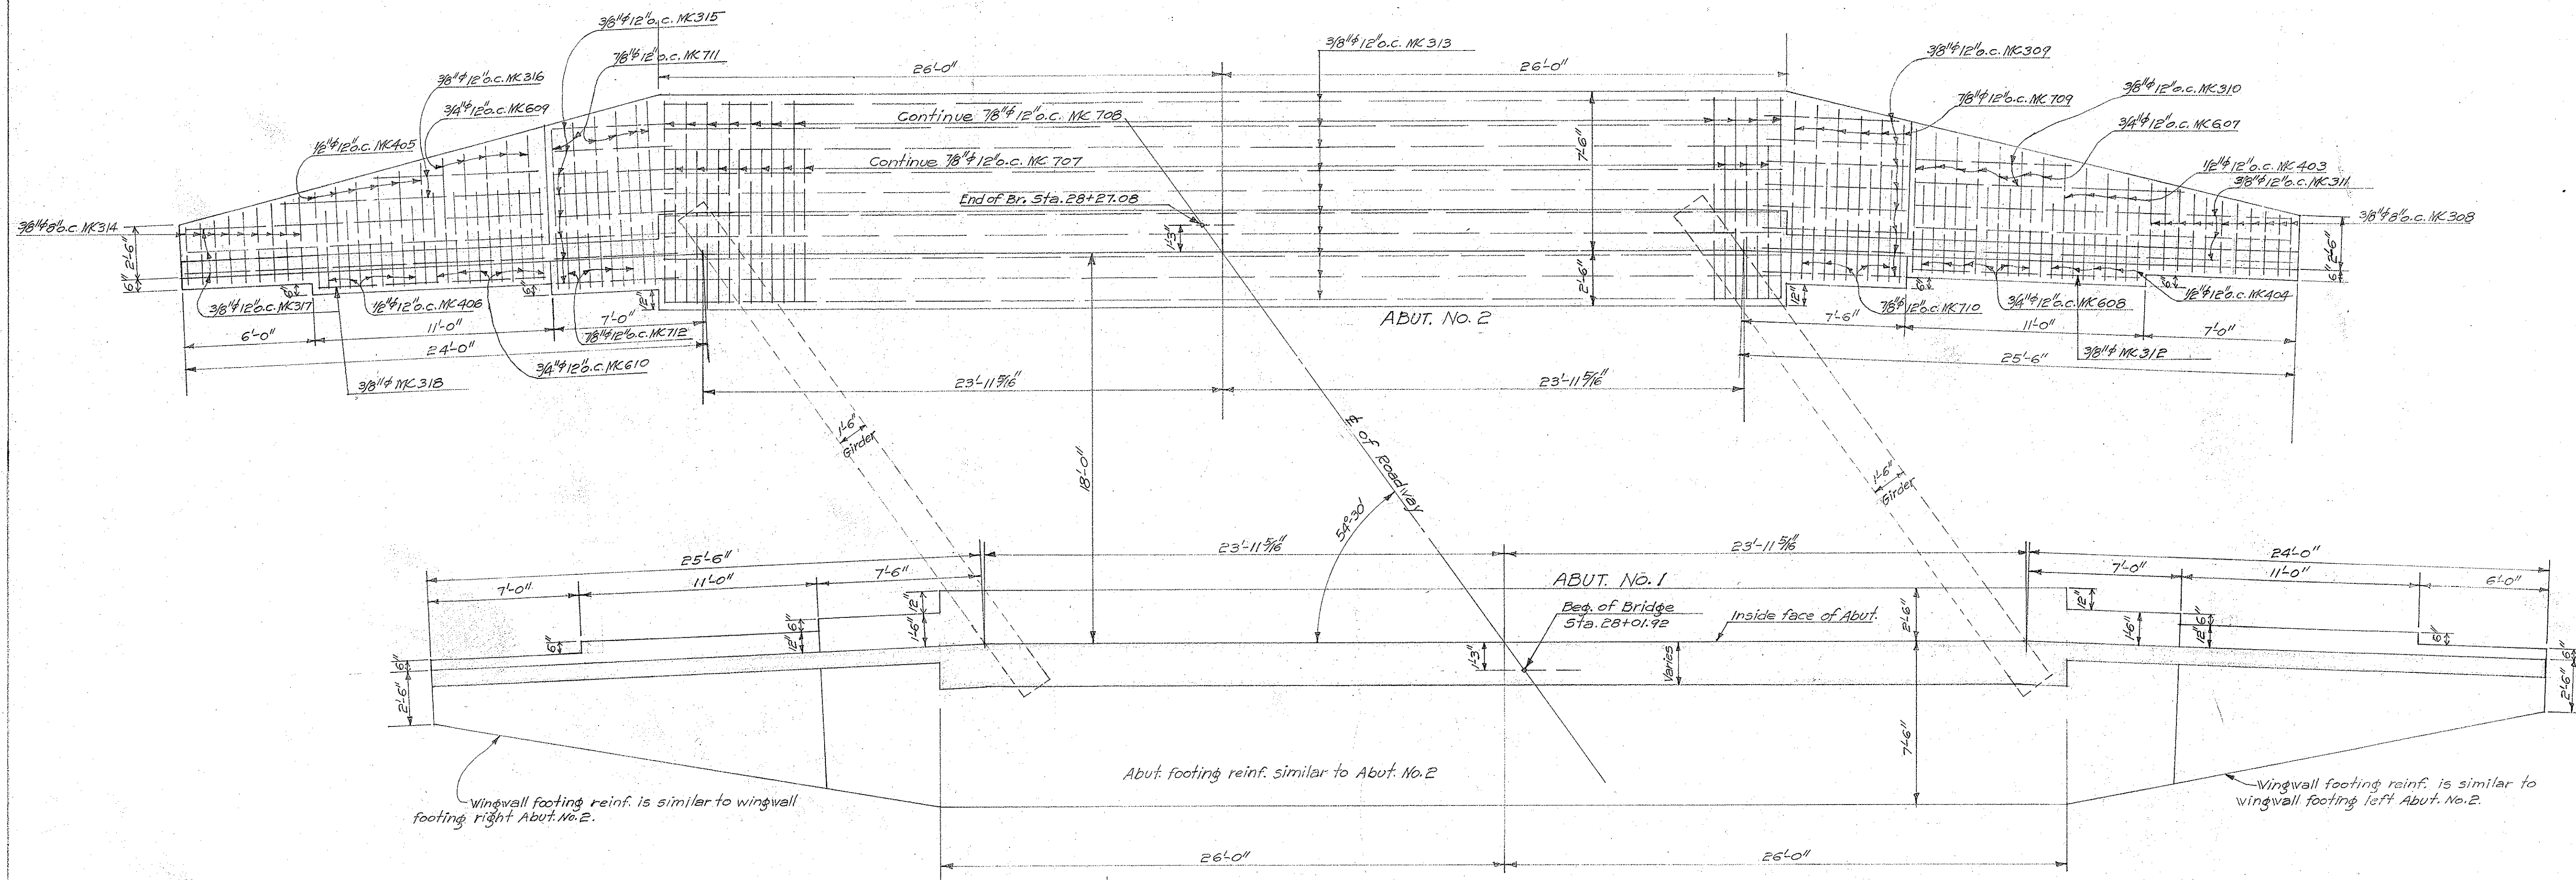


ABUTMENT & WINGWALL FOOTINGS
Scale 1/4"=1'-0"

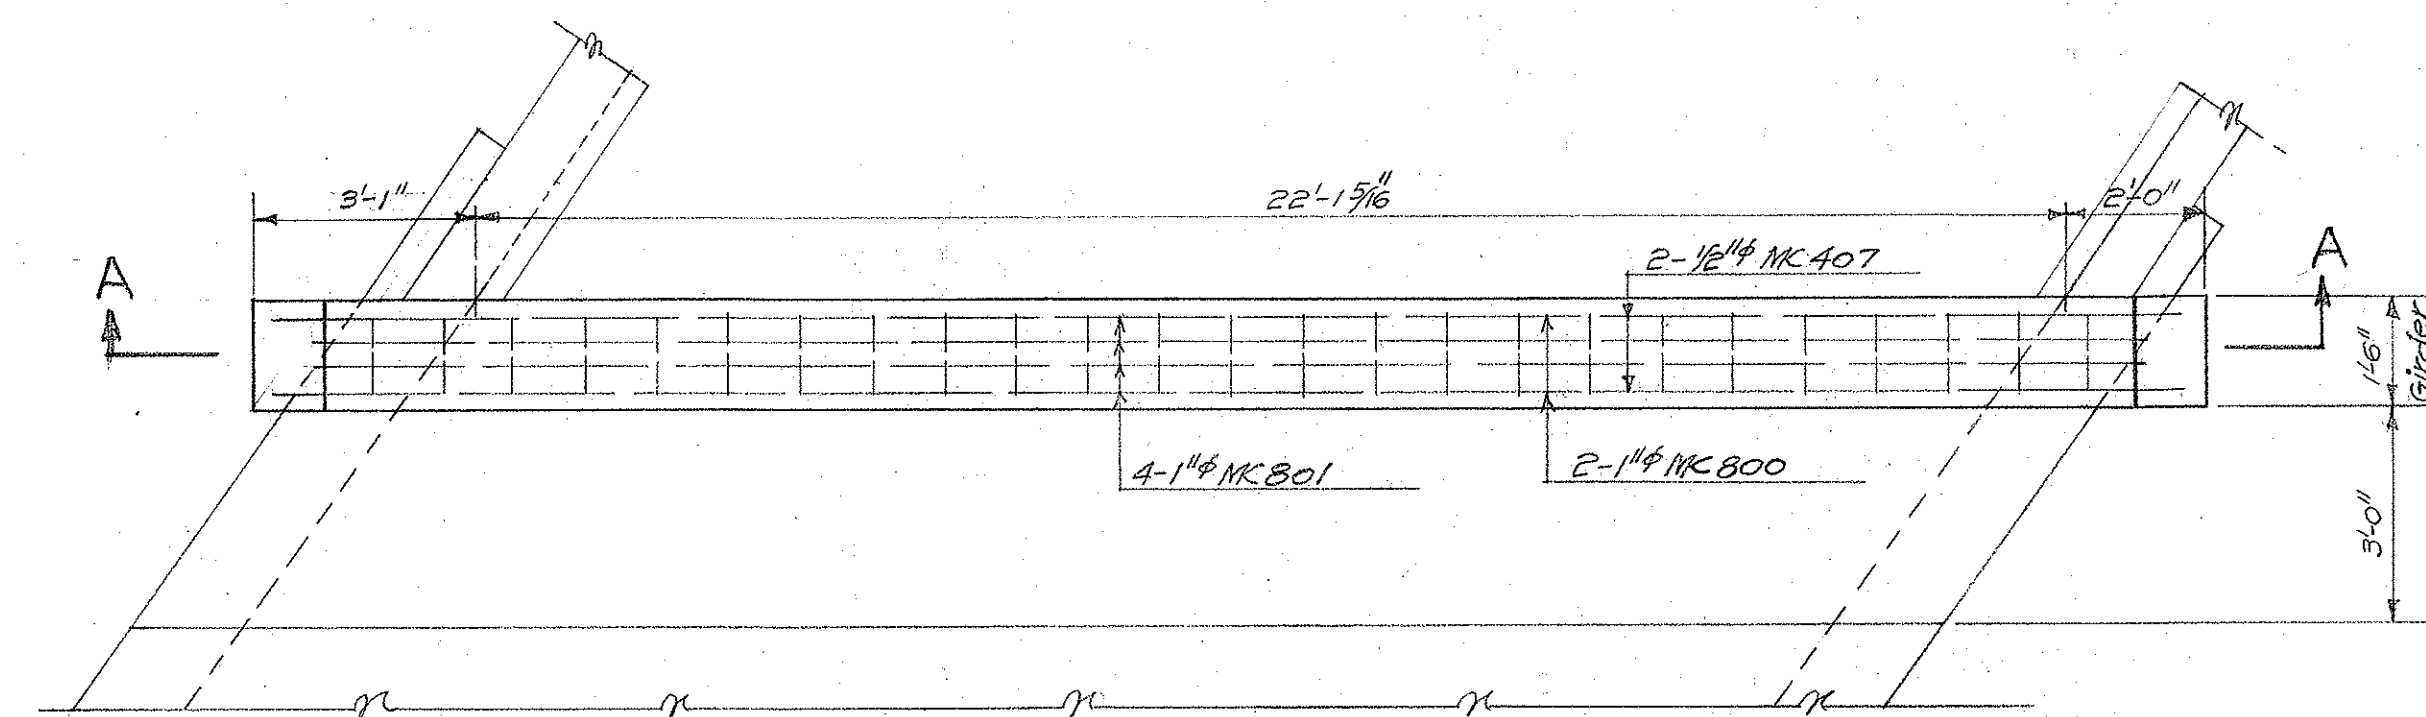

PART PLAN SHOWING GIRDER REINF.
Scale 3/8"=1'-0"

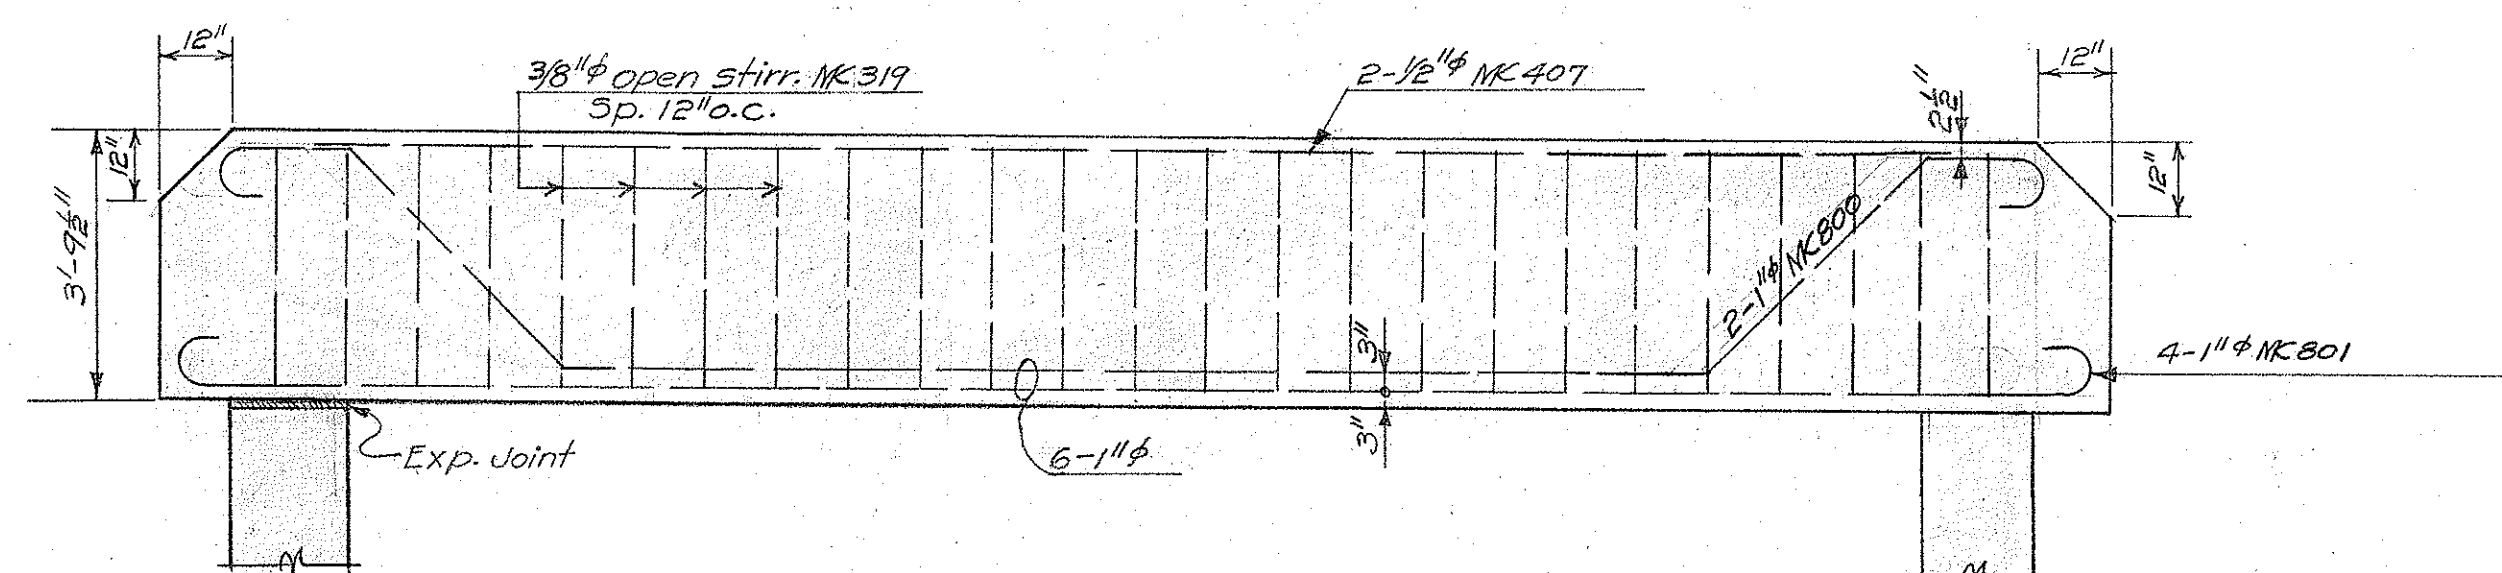

SECT. A-A
Scale 3/8"=1'-0"

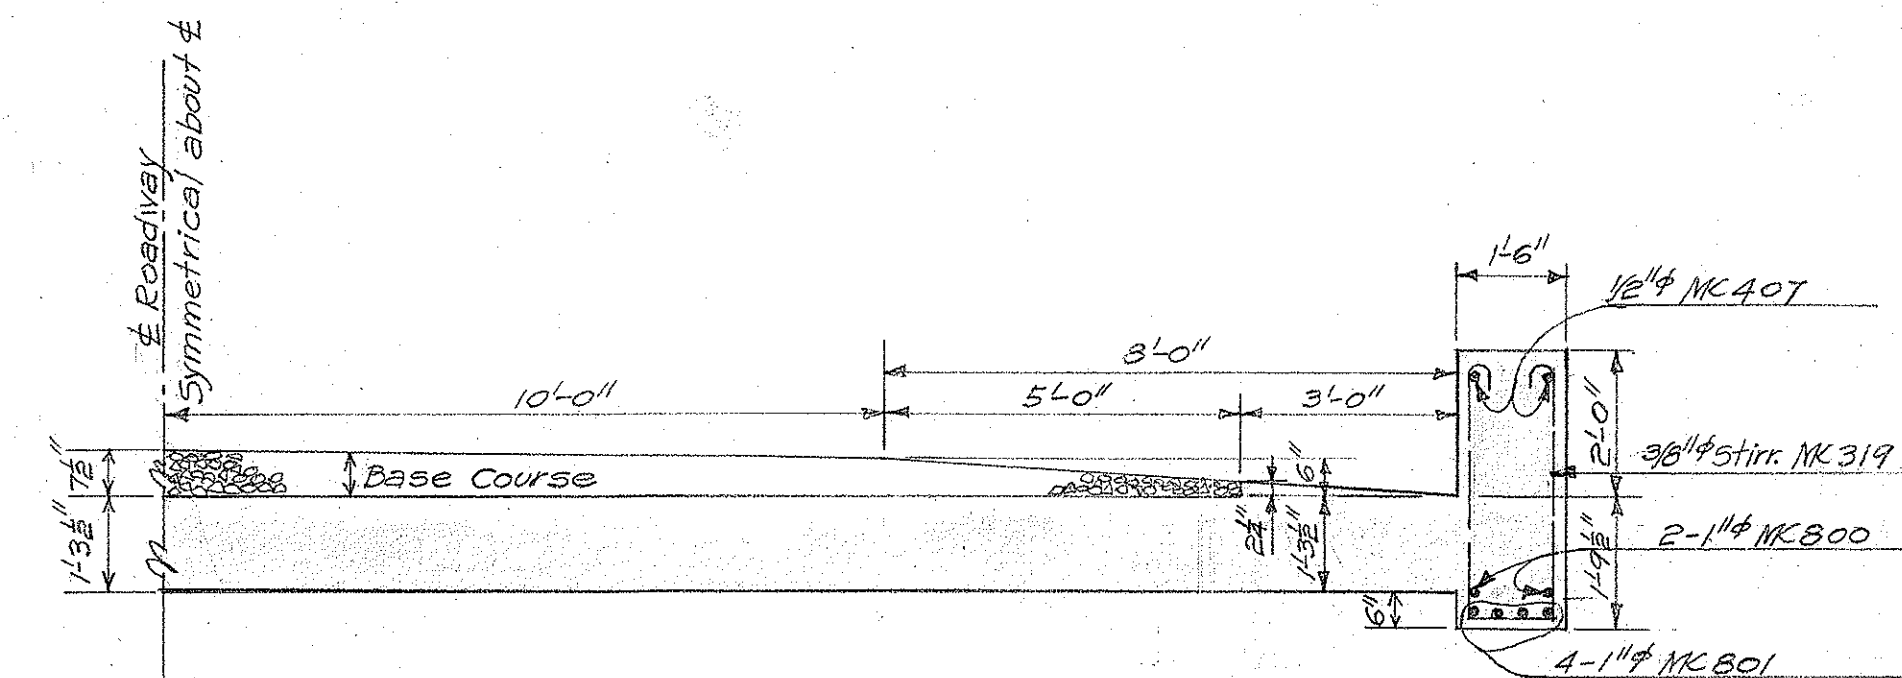

PART NORMAL SECTION
Scale 3/8"=1'-0"

TERRITORIAL HIGHWAY DEPARTMENT
TERRITORY OF HAWAII

HIGHWAY OVERPASS
STA. 28+01.92 TO 28+27.08
VAIANAE ROAD F.A.G.H. 4-C



SHEET NO. 2 OF 3 SHEETS.

4450.18



4450.18

ORIGINAL PLAN	DESIGNED BY	DATE
NOTED BY	BY	
CHECKED BY	BY	

FED. ROAD DIST. NO.	STATE	FED. AID PROJ. NO.	FISCAL YEAR	SHEET NO.	TOTAL SHEETS
HAWAII	HAW	F.A.G.H 4C	1938	19	40

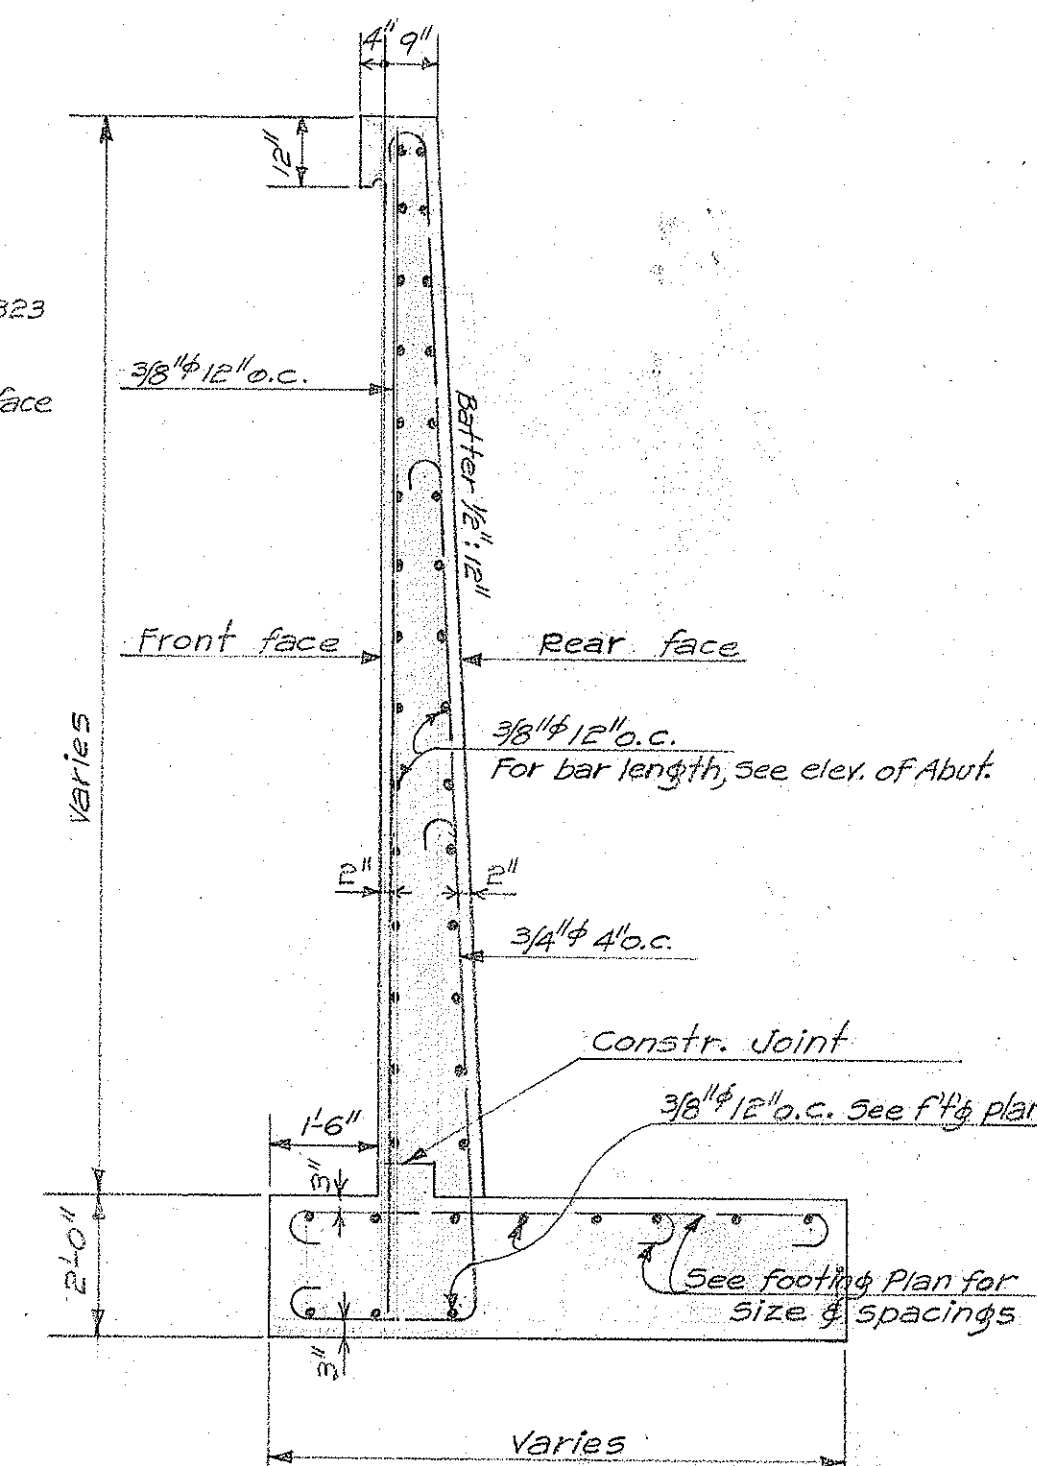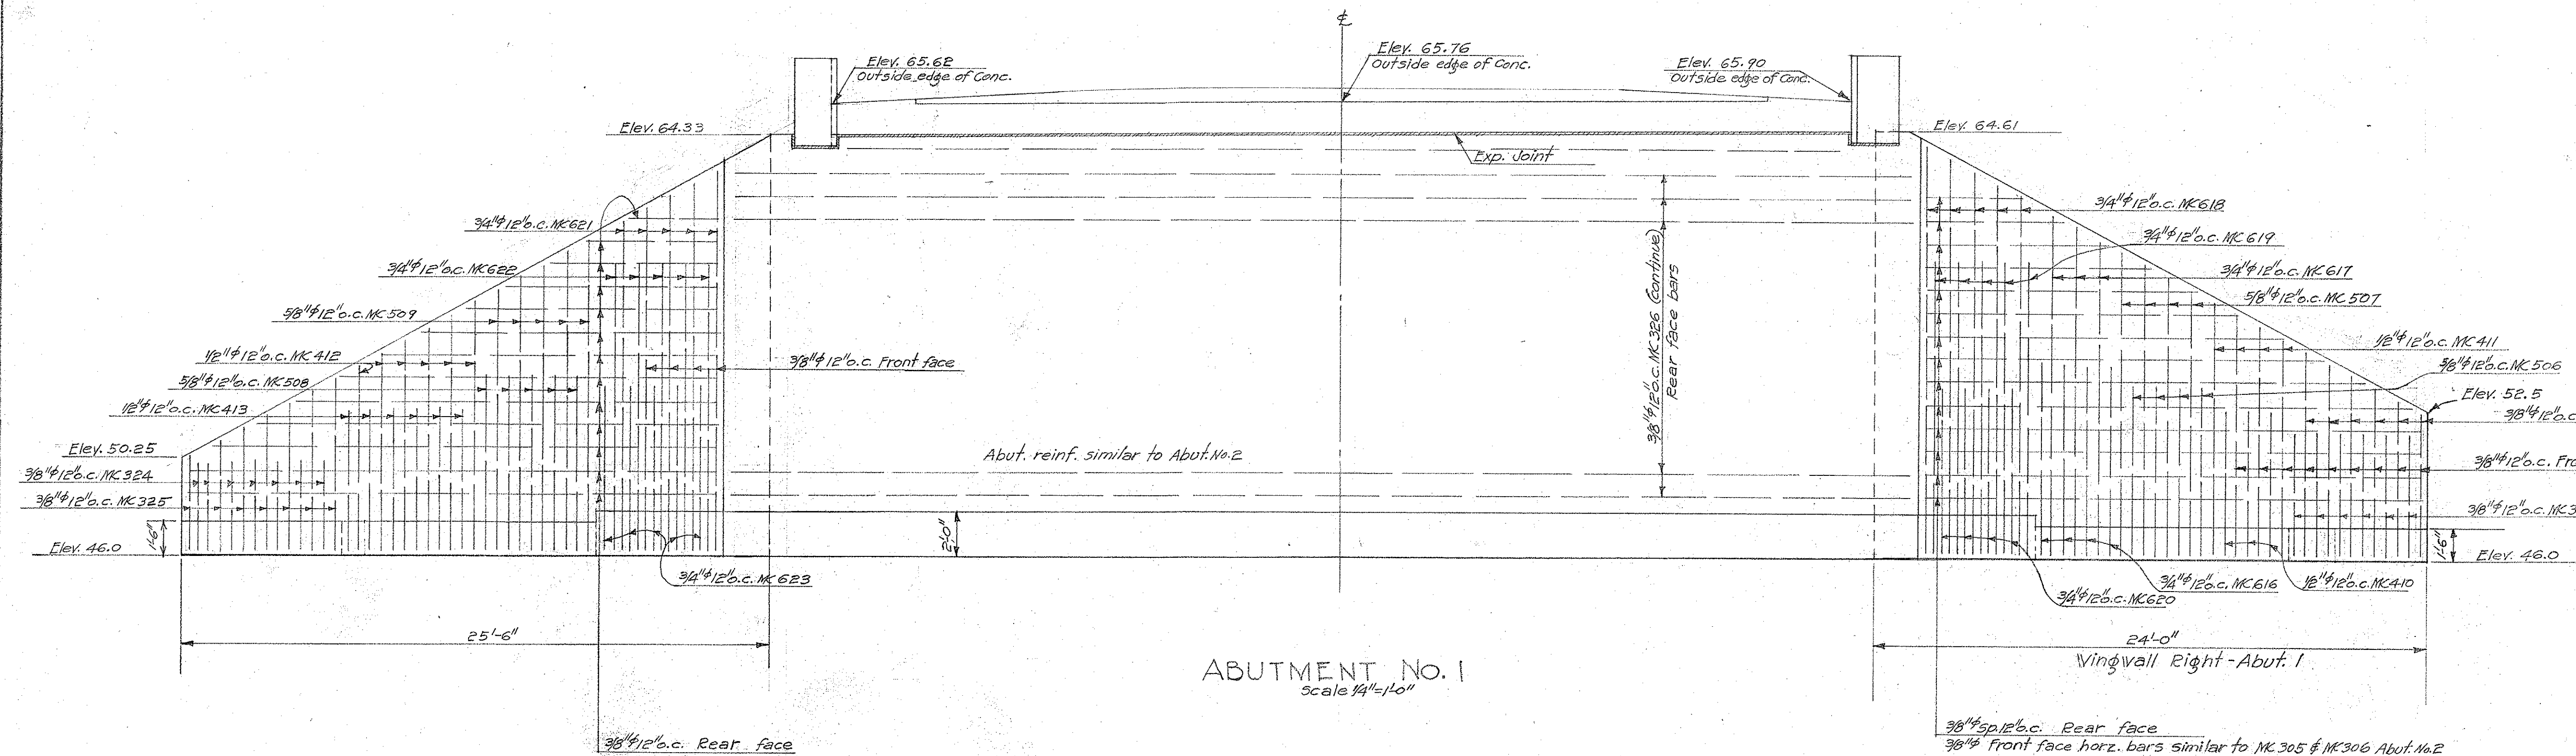

WINGWALL TYPE A
Scale 3/8"=1'-0"

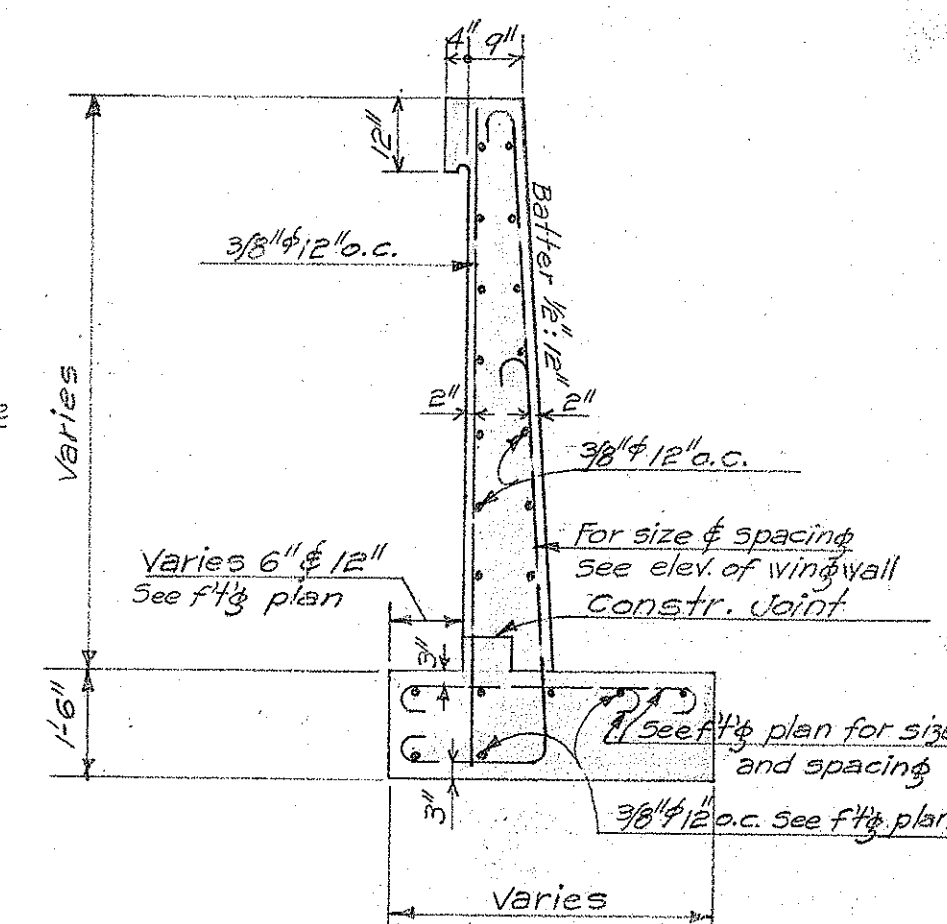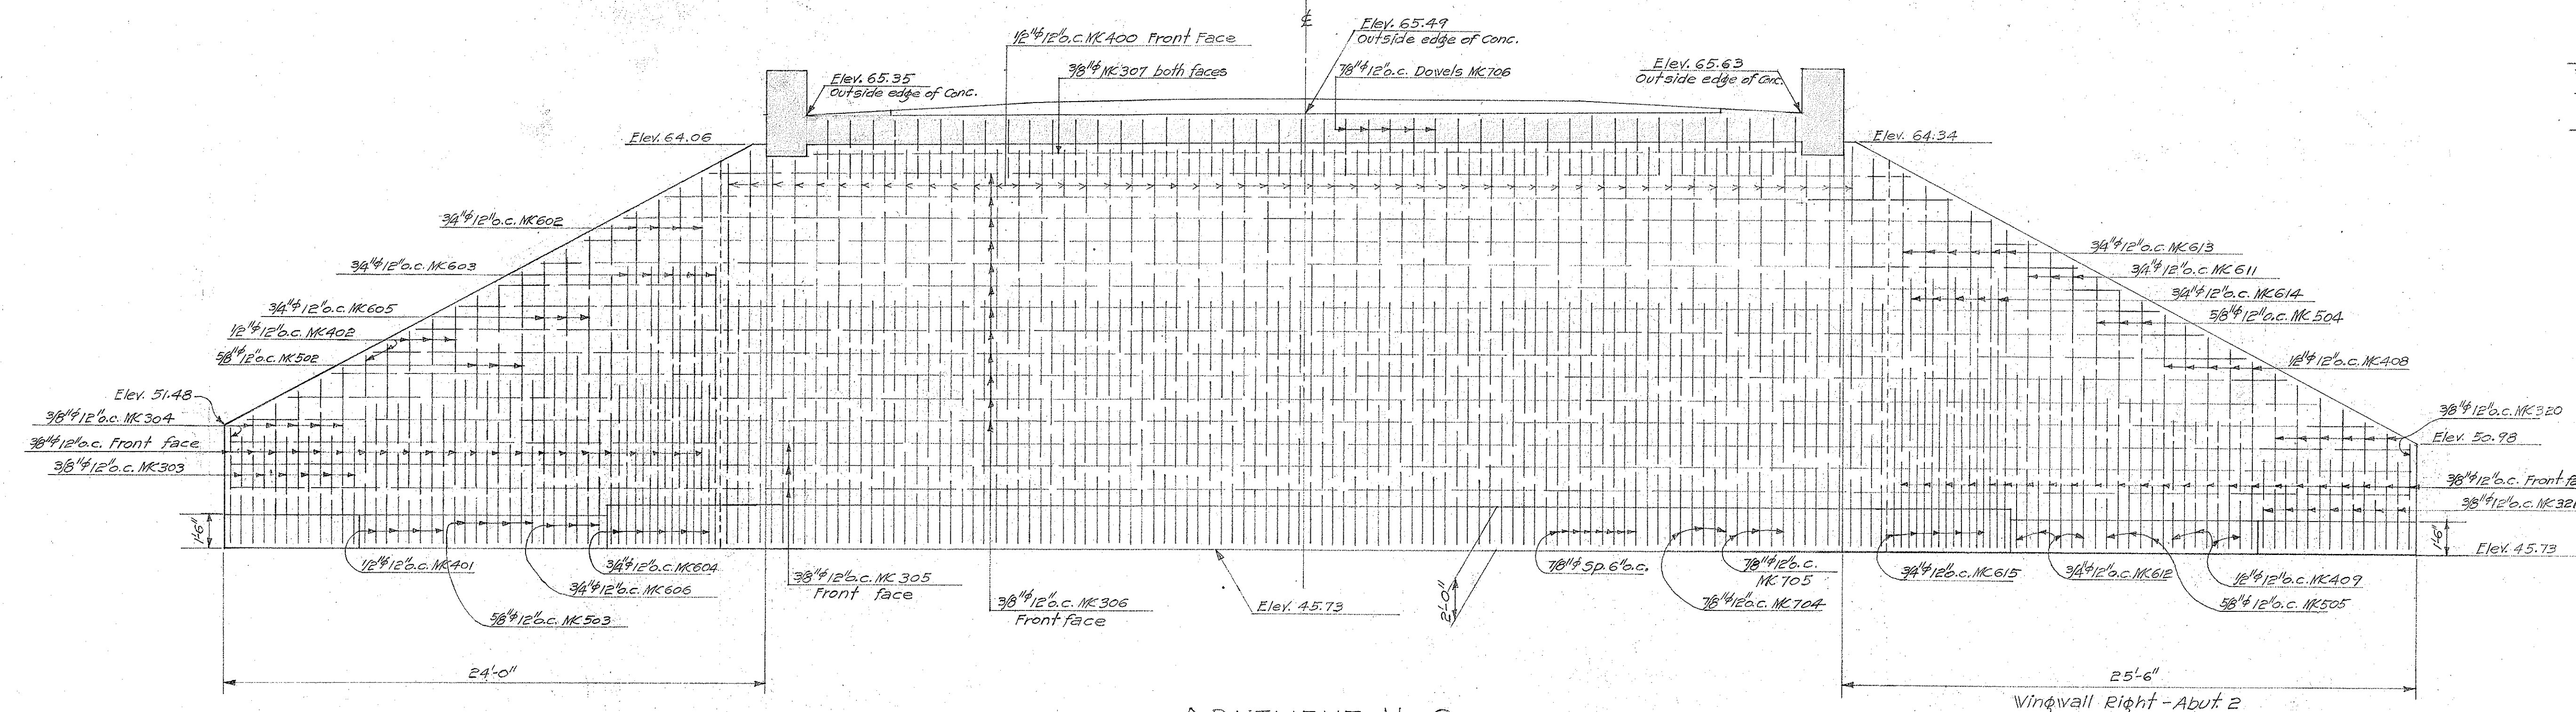

WINGWALL TYPE B
Scale $\frac{3}{8}'' = 1'-0''$








TERRITORIAL HIGHWAY DEPARTMENT
TERRITORY OF HAWAII
HIGHWAY OVERPASS
STA. 28+01.92 TO 28+27.08
WAIANAE ROAD F.A.G.H. 4-C

SHEET NO. 3 OF 3 SHEETS.

4450.19

ORIGINAL PLAN	SURVEY PLOTTED BY DESIGNED BY DRAWN BY TRACED BY QUANTITIES BY CHECKED BY	W. F. Bartels W. F. Bartels P. Kang P. Kang P. Kang P. Kang P. Kang W. F. Bartels	DATE " JUL 12 1958 " " " " " " " " " " " "
NOTE BOOK			

REVISED JUNE 10, 1938
REVISED AUG. 29, 1938

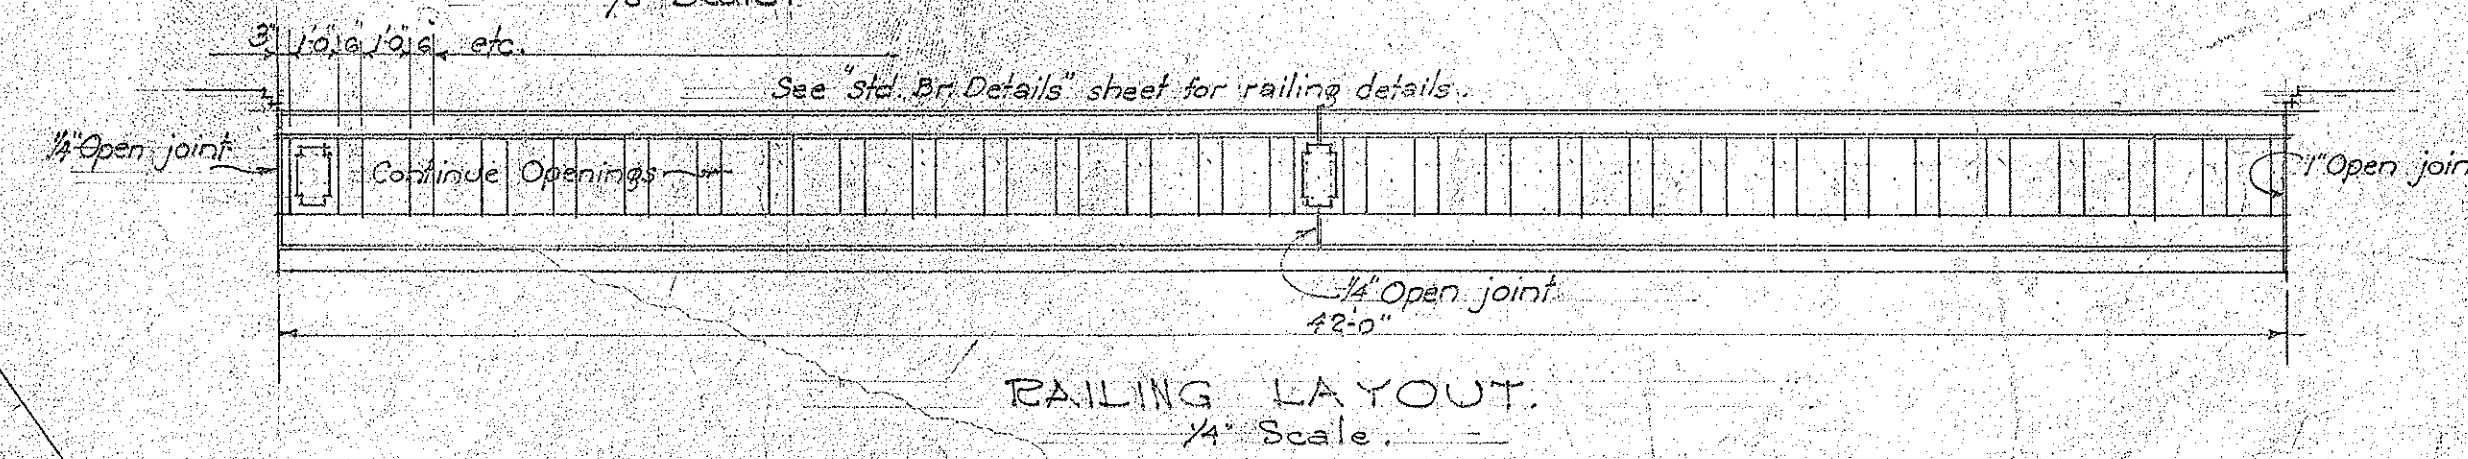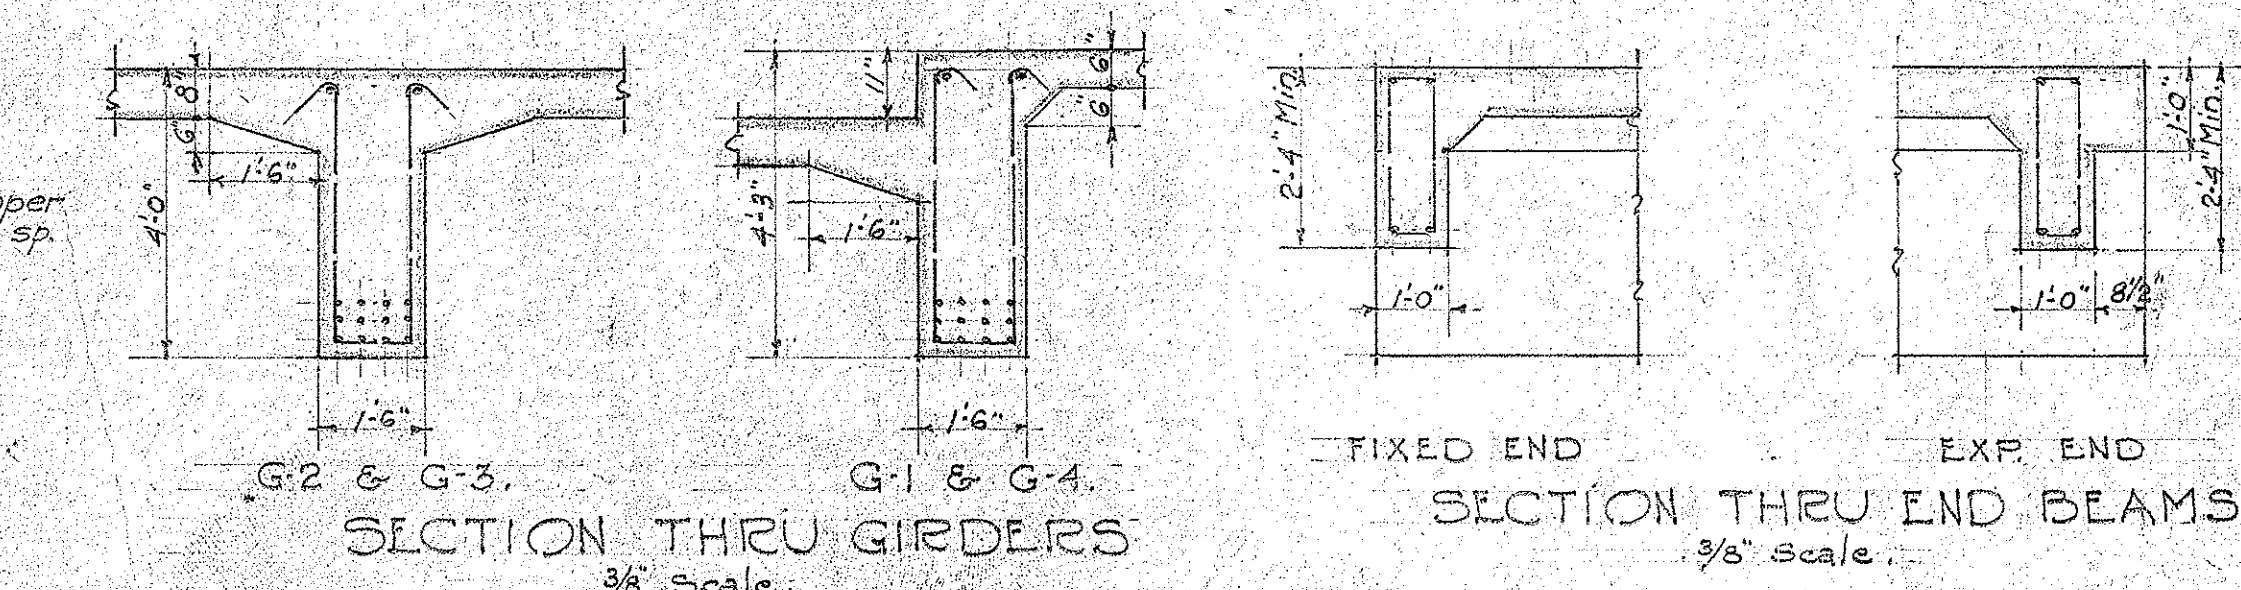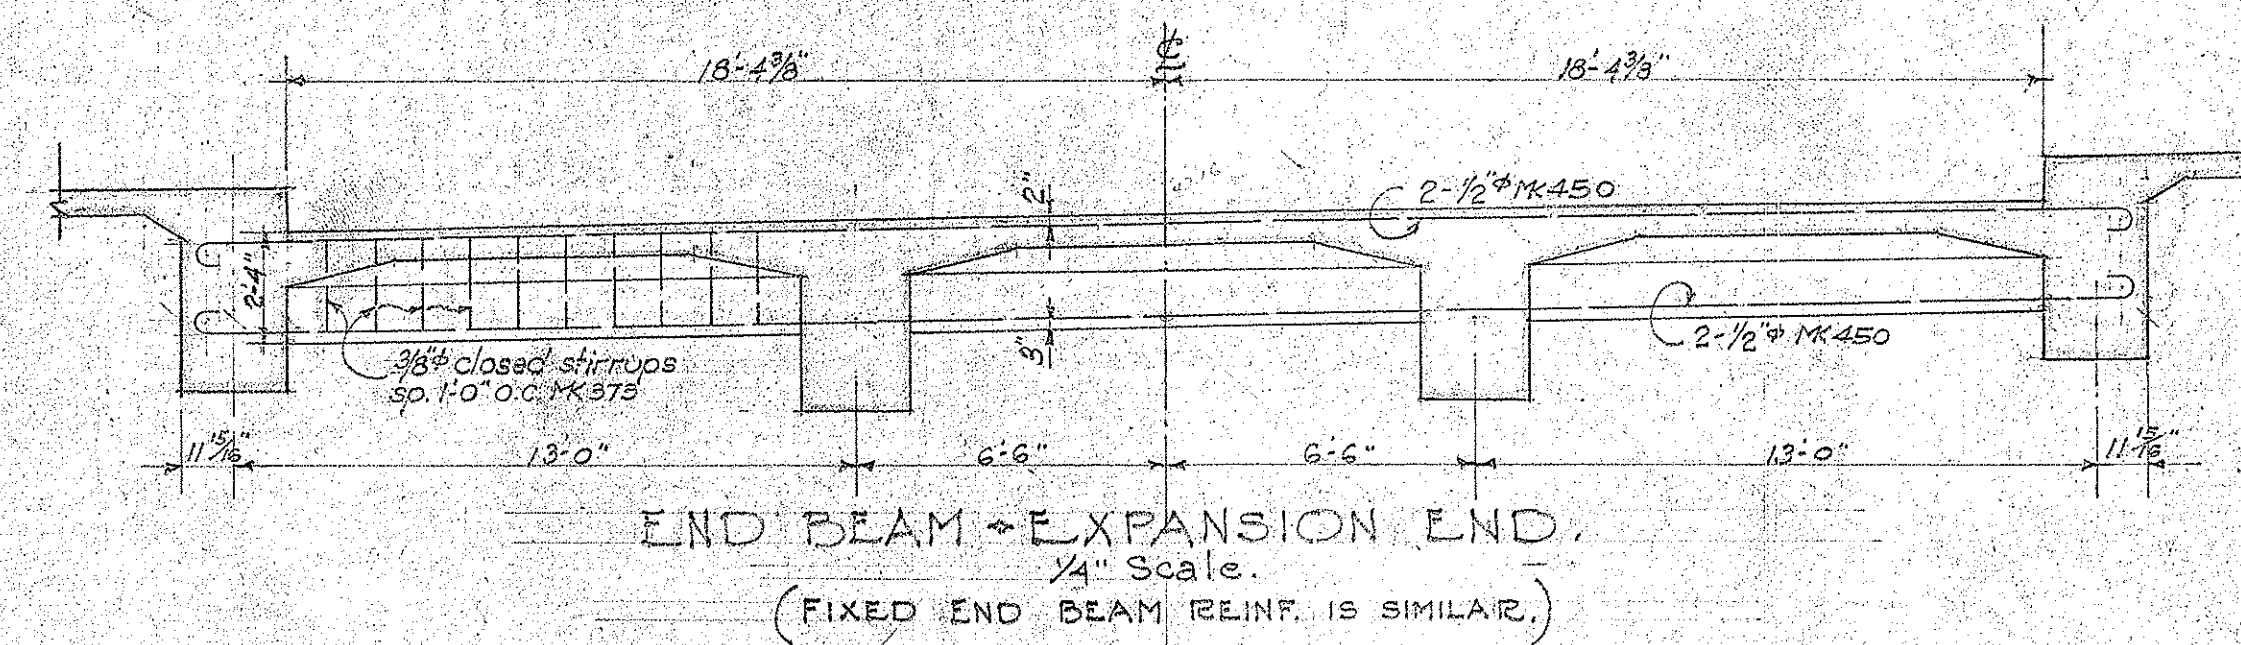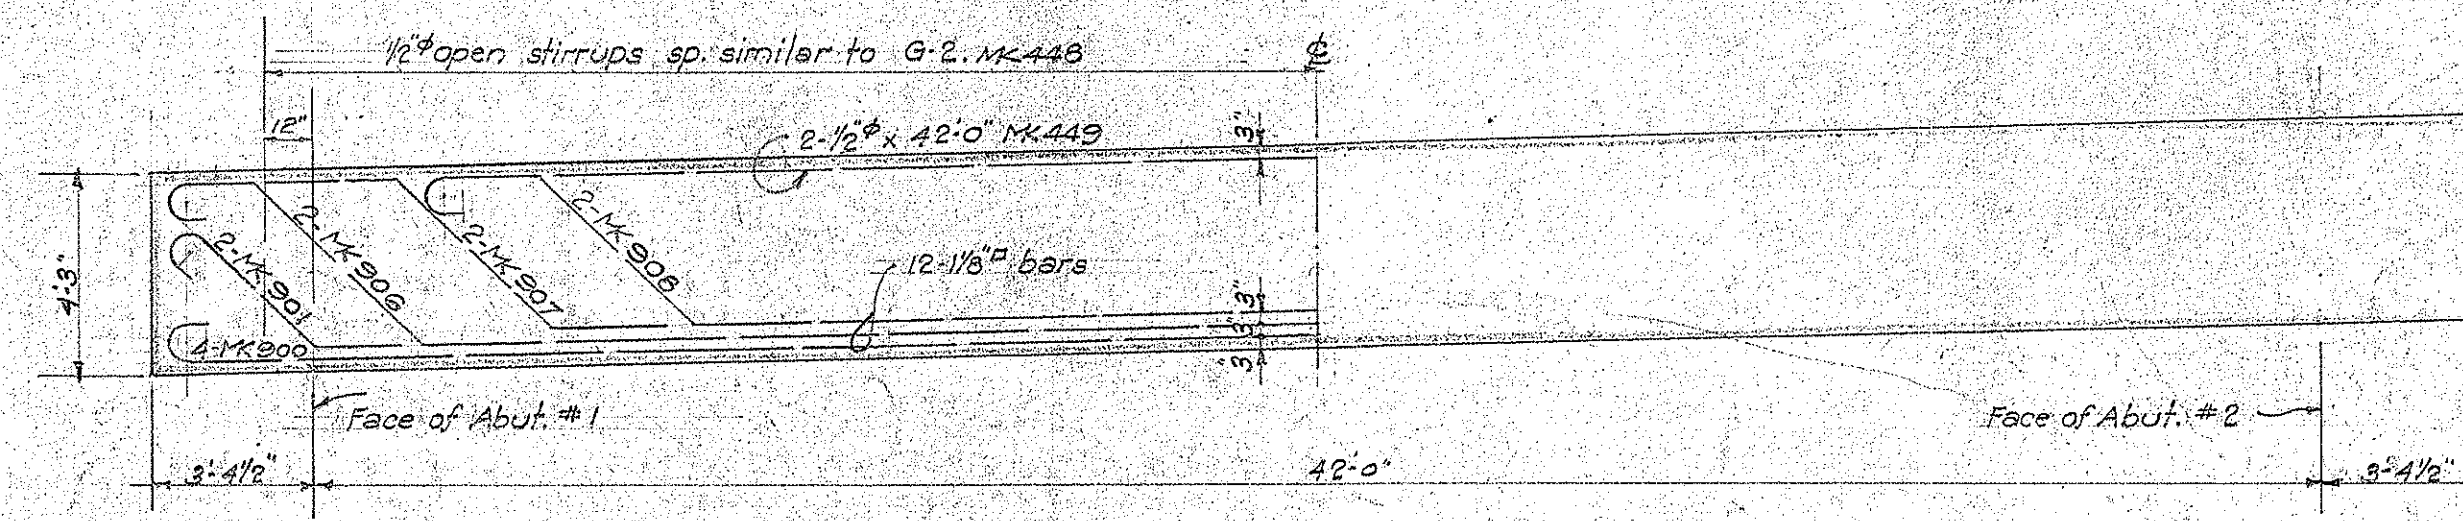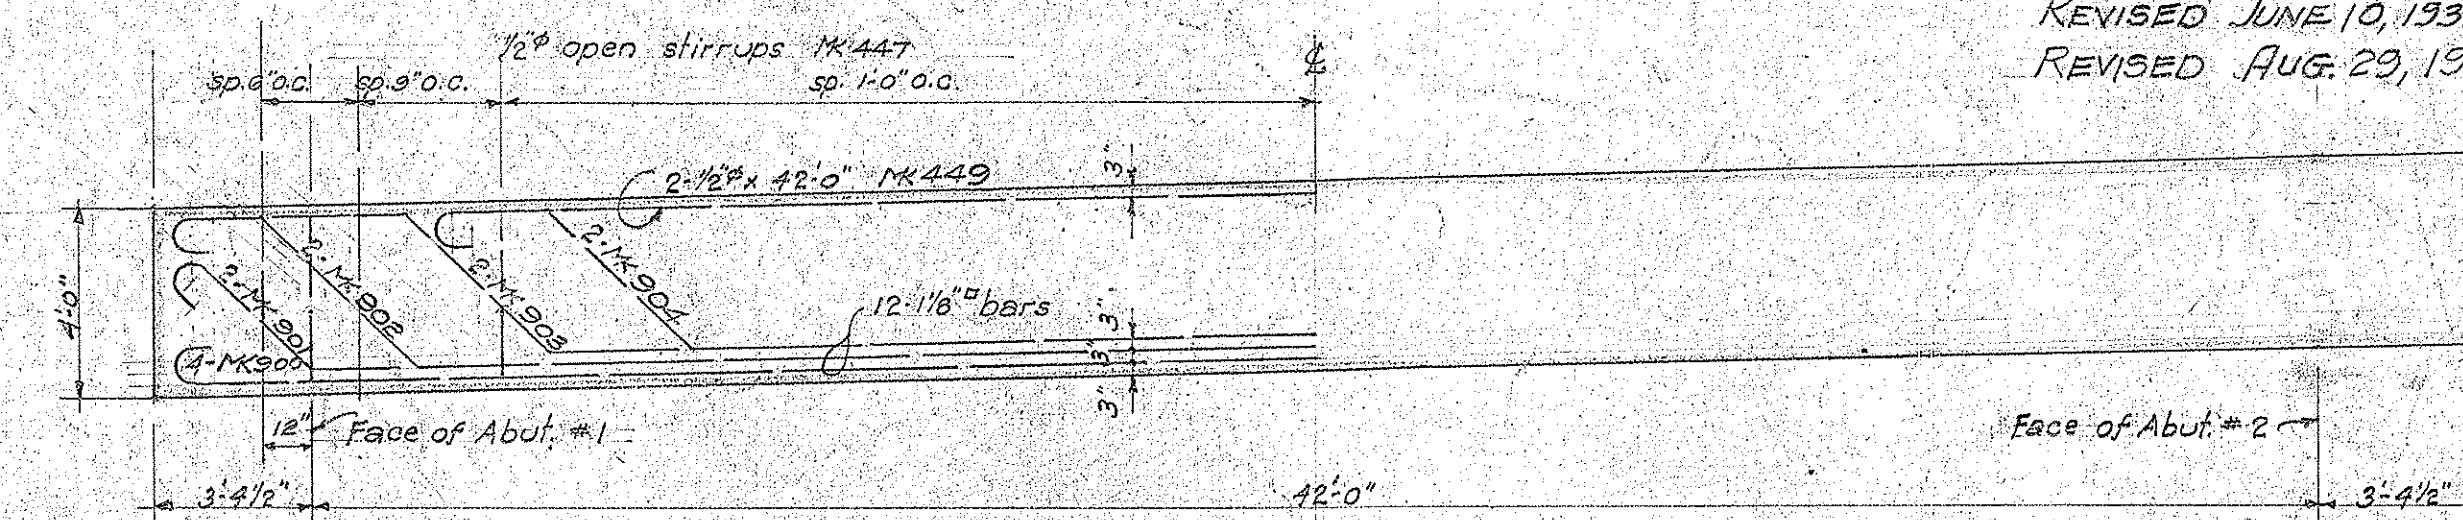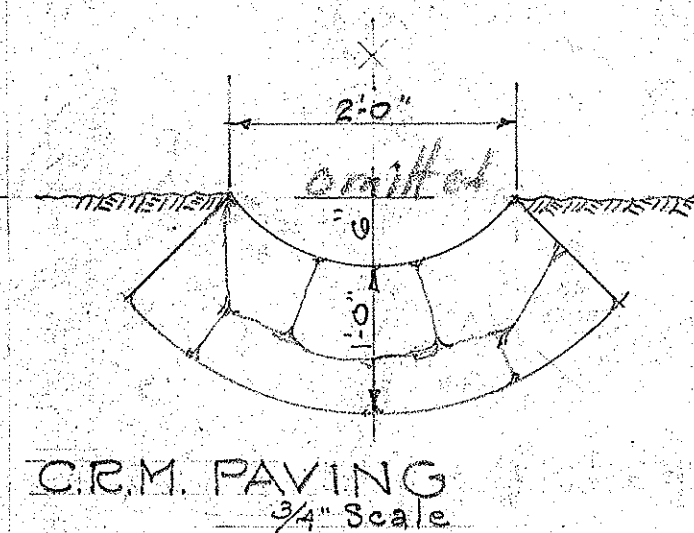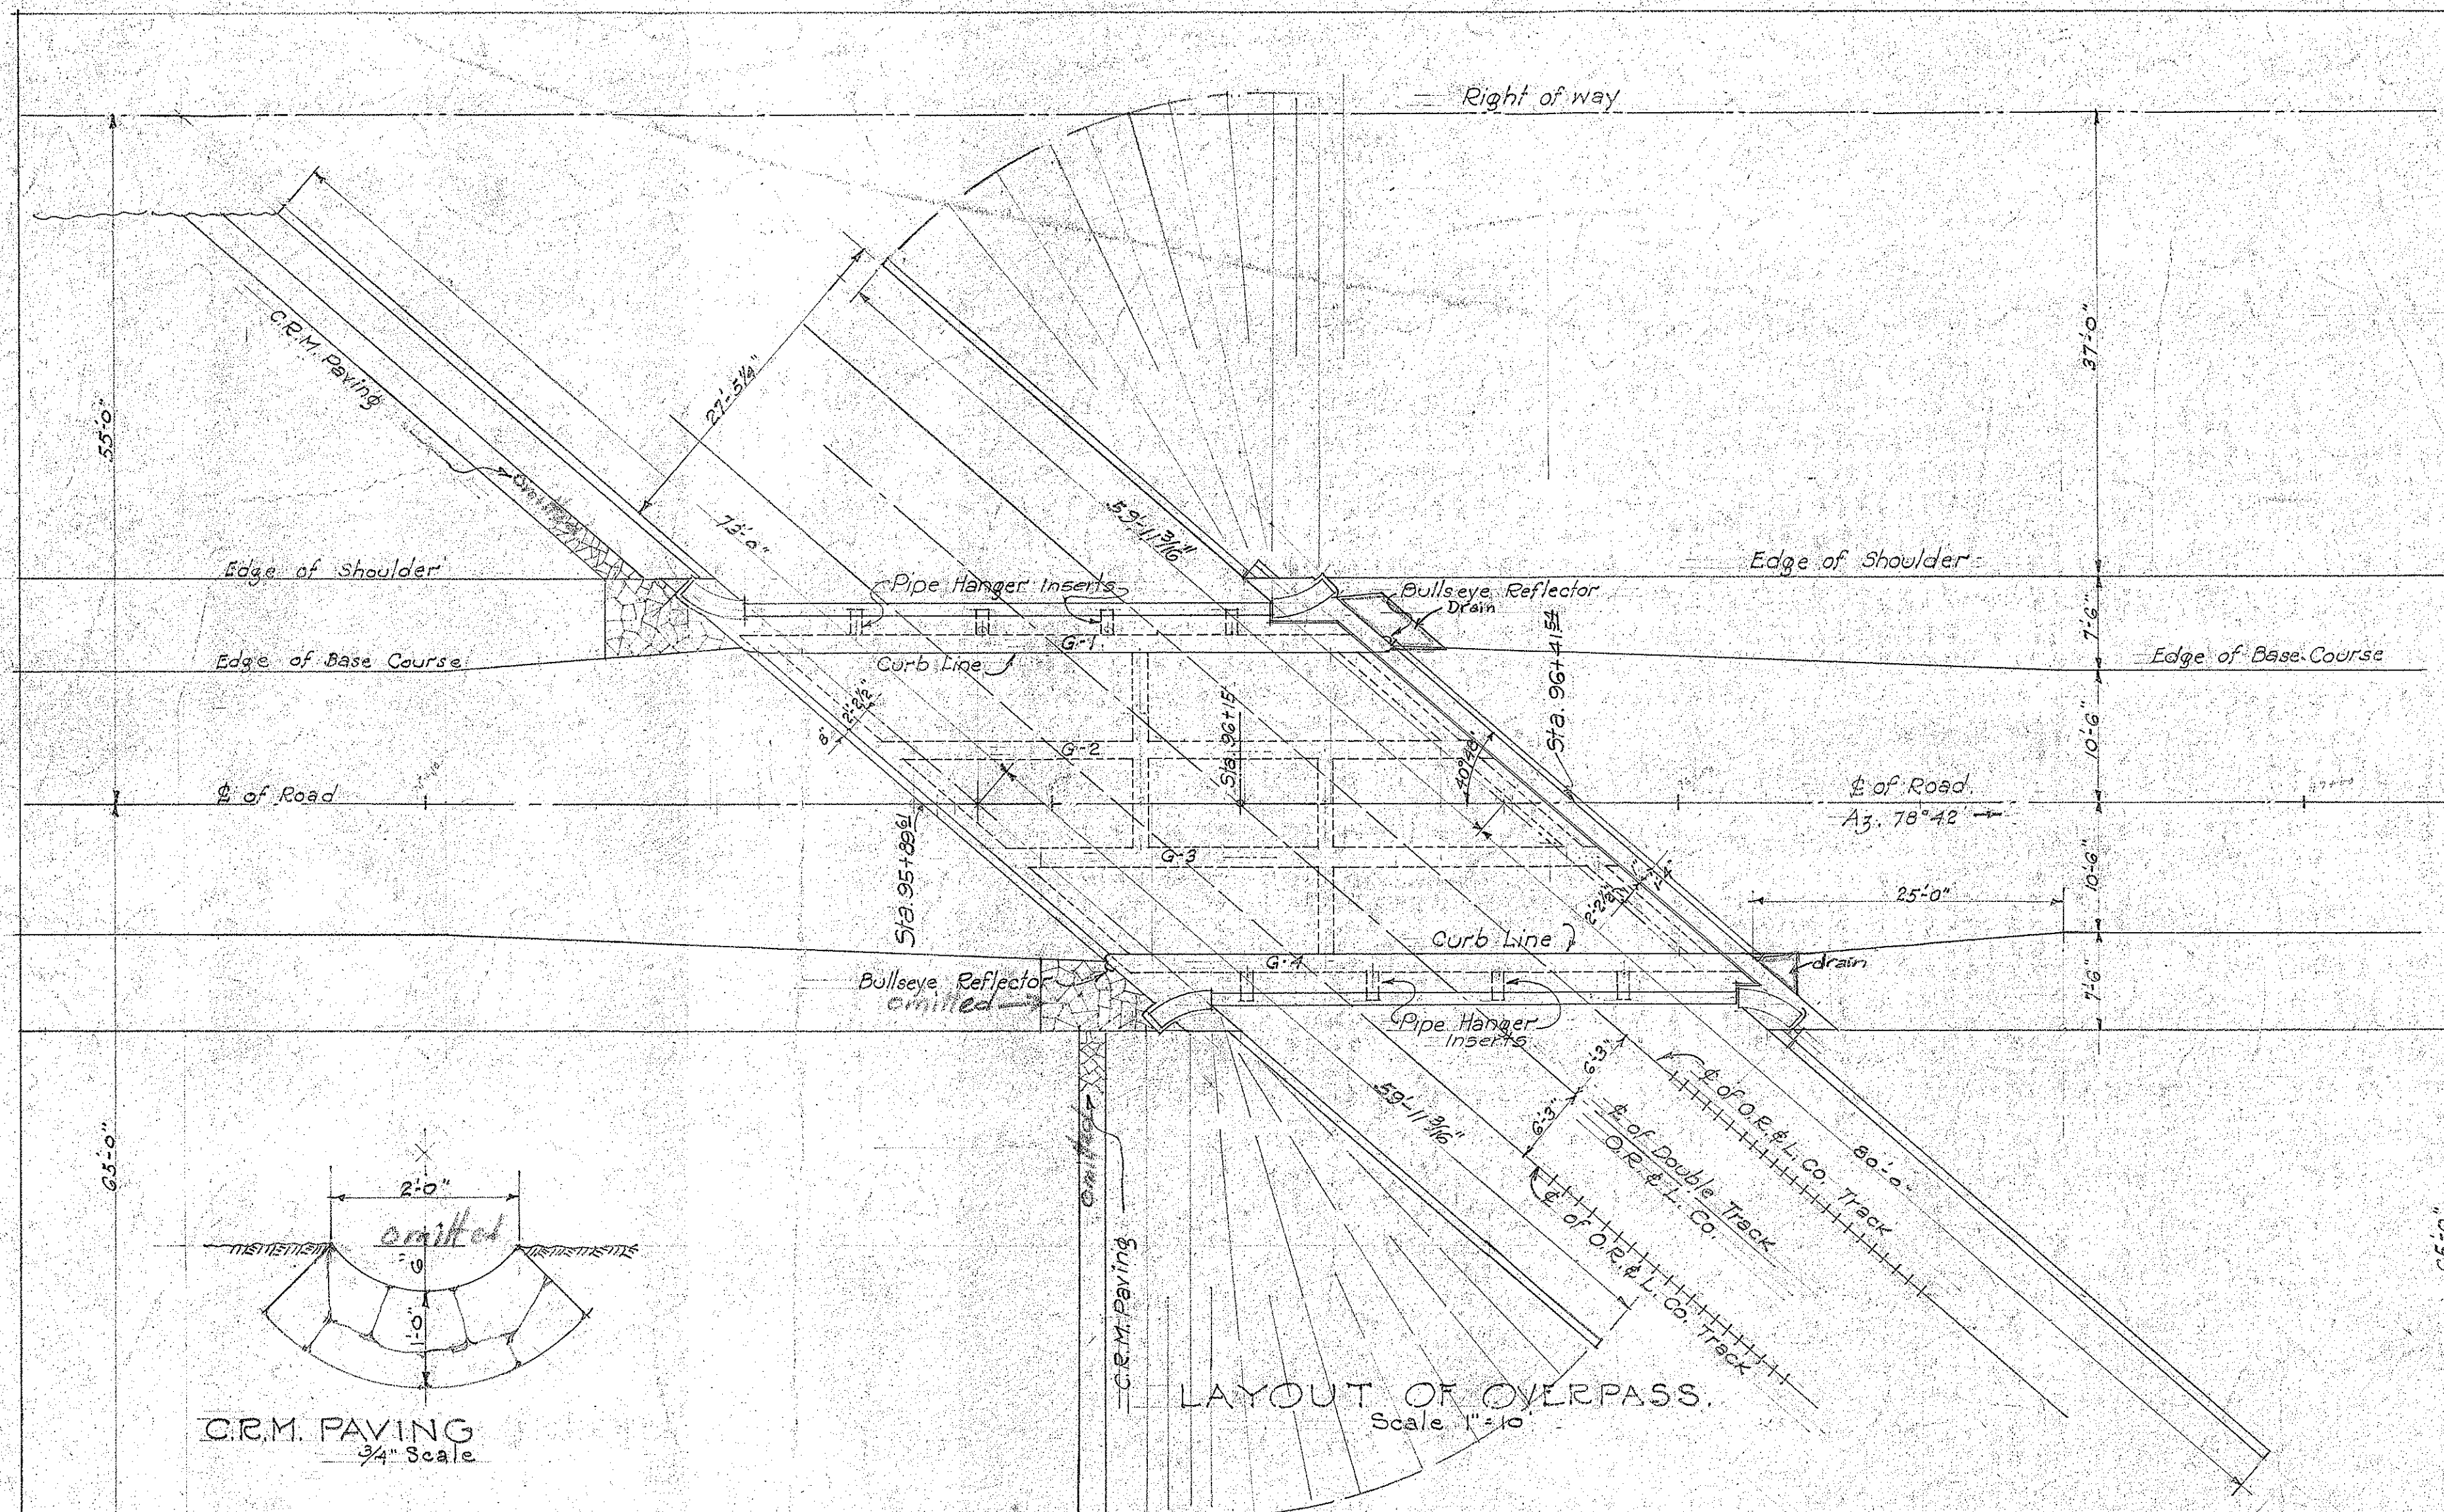

		ITEMIZED QUANTITIES		
		STR. EXC.	CONCRETE	STEEL
BRIDGE	FOOTING	267 C.Y.	135.1 C.Y.	17,679 LBS.
	ABUTMENT		288.3	49,921
	SUPERSTR.		886	19,634
	RAILING		90	646
	FOOTING	89	33.1	1,717
TOTAL	WALLS		37.5	4,391
	TOTALS	456 C.Y.	646.6 C.Y.	93,988 LBS.

TERRITORIAL HIGHWAY DEPARTMENT,
TERRITORY OF HAWAII.

HIGHWAY OVERPASS.

WAIANAE ROAD F.A.H. 4-C
DATE, FEB. 1938. SCALES AS NOTED.
SHEET NO. 1 OF 7 SHEETS.

4450.20

REVISION: Wingwall lengths corrected 9/29/39

DATE: FEB. 1938
DESIGNED BY: C.E.M. PAVING
CHECKED BY: T. Ling
NOTED BY: T. Ling
QUANTITIES BY: T. Ling
CERIFIED BY: T. Ling

SPECIFICATIONS FOR ASPHALT FILLER:
Melting Point 180-200 (A.S.T.M. D36-26)
Penetration 30-40 (A.S.T.M. D5-25)
Flash Point min. 400 (A.S.T.M. D93-22)

Note: Backfilling of Abutments must be done before placing of superstructure.


Note: 4" weep holes in Abut. & wing walls at elev. to be determined by the Res. Engr. Weep holes to be placed between counterforts in Abutments and 6' o.c. in Wingwalls.

Note: Timber bumpers to be furnished and installed as an incidental to class 'A' conc.

See Weep Hole Notes.

SECTION ALONG FACE OF G-2. 1/4" Scale.

REVISED JUNE 10, 1938




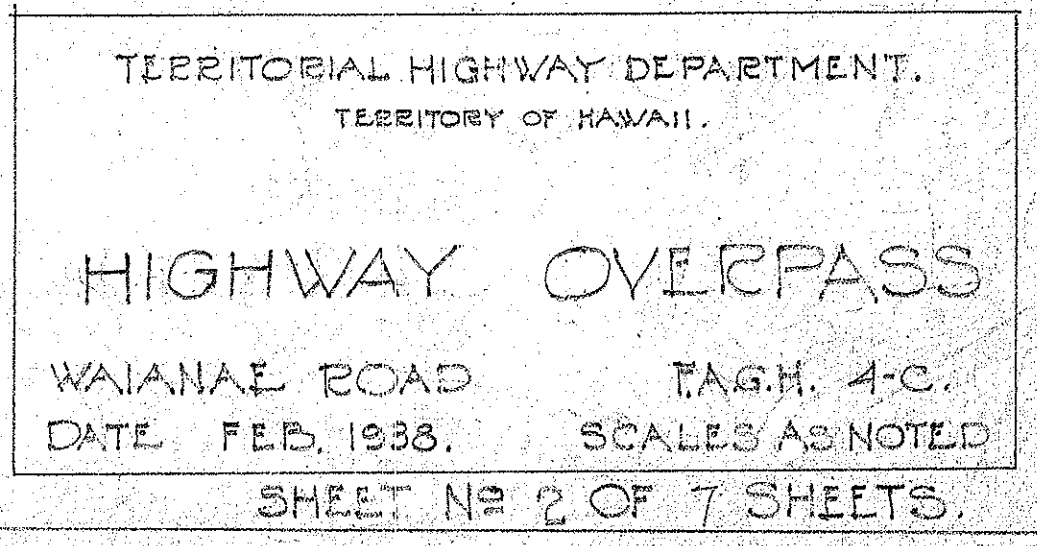


4450.21

REVISION Wingwalls & Abut. changed

ORIGINAL PLAN	SURVEY PLOTTED BY V. P. Bartels	DATE July 1938
NOTE BOOK	DRAWN BY C. E. Wagner	FILE NO. 156
No.	QUANTITIES BY C. E. M.	
	CHECKED BY	

REVISED JUNE 10, 1938
REVISED AUG. 29, 1938

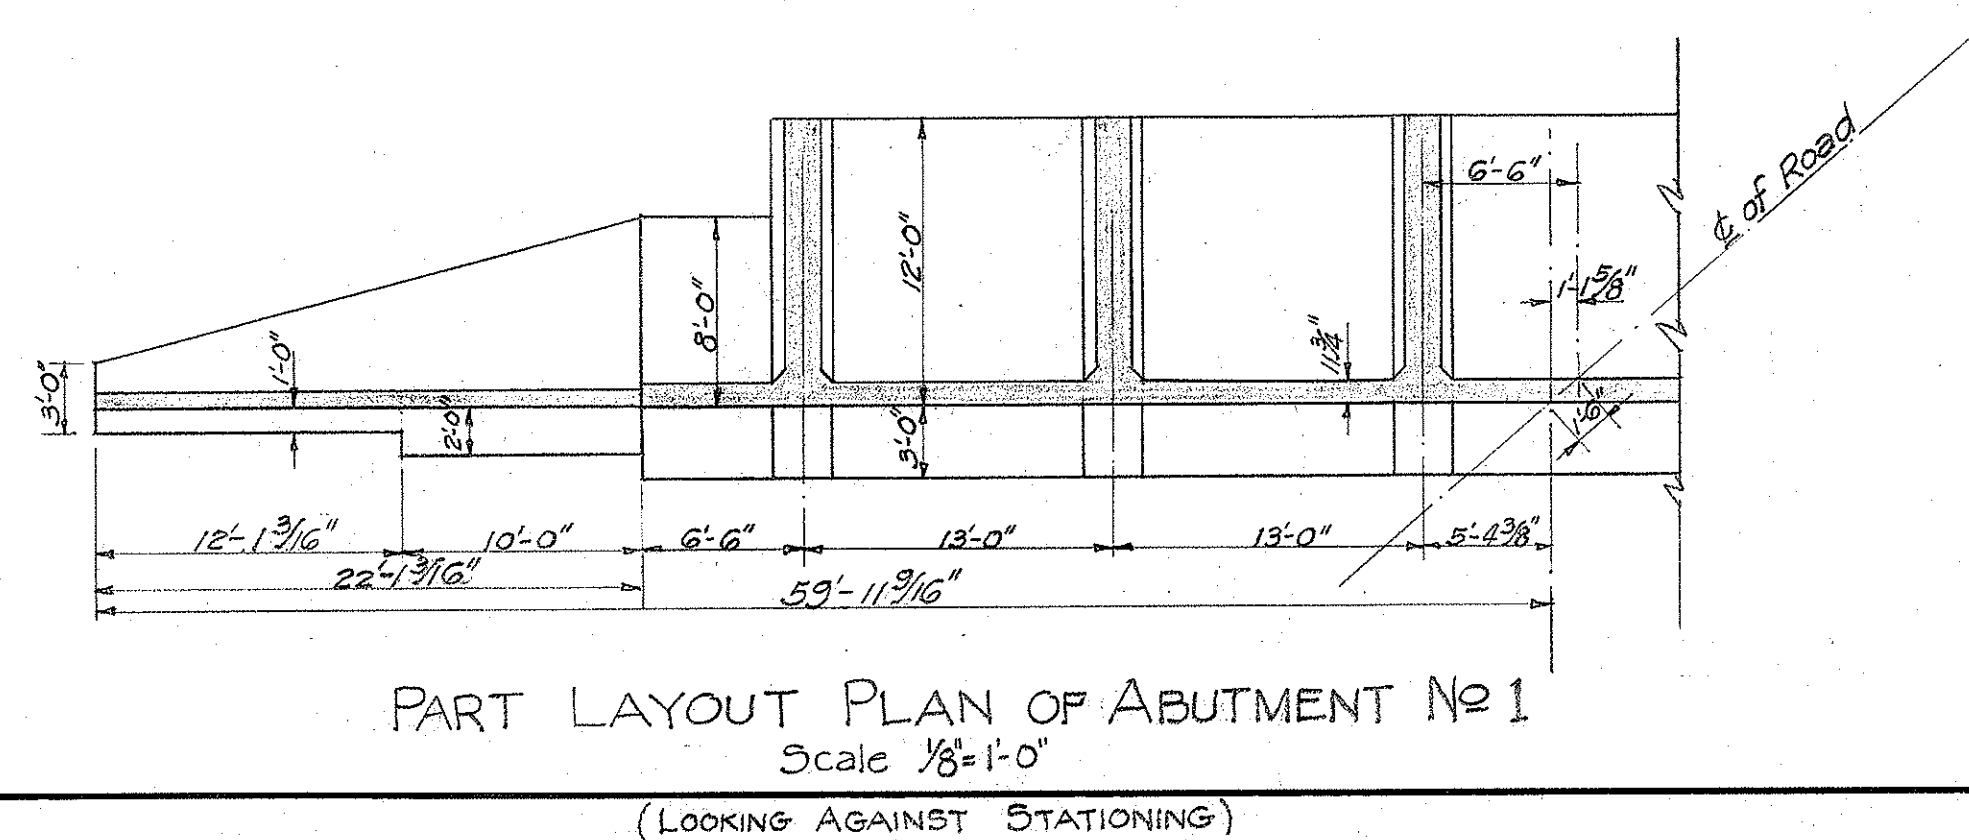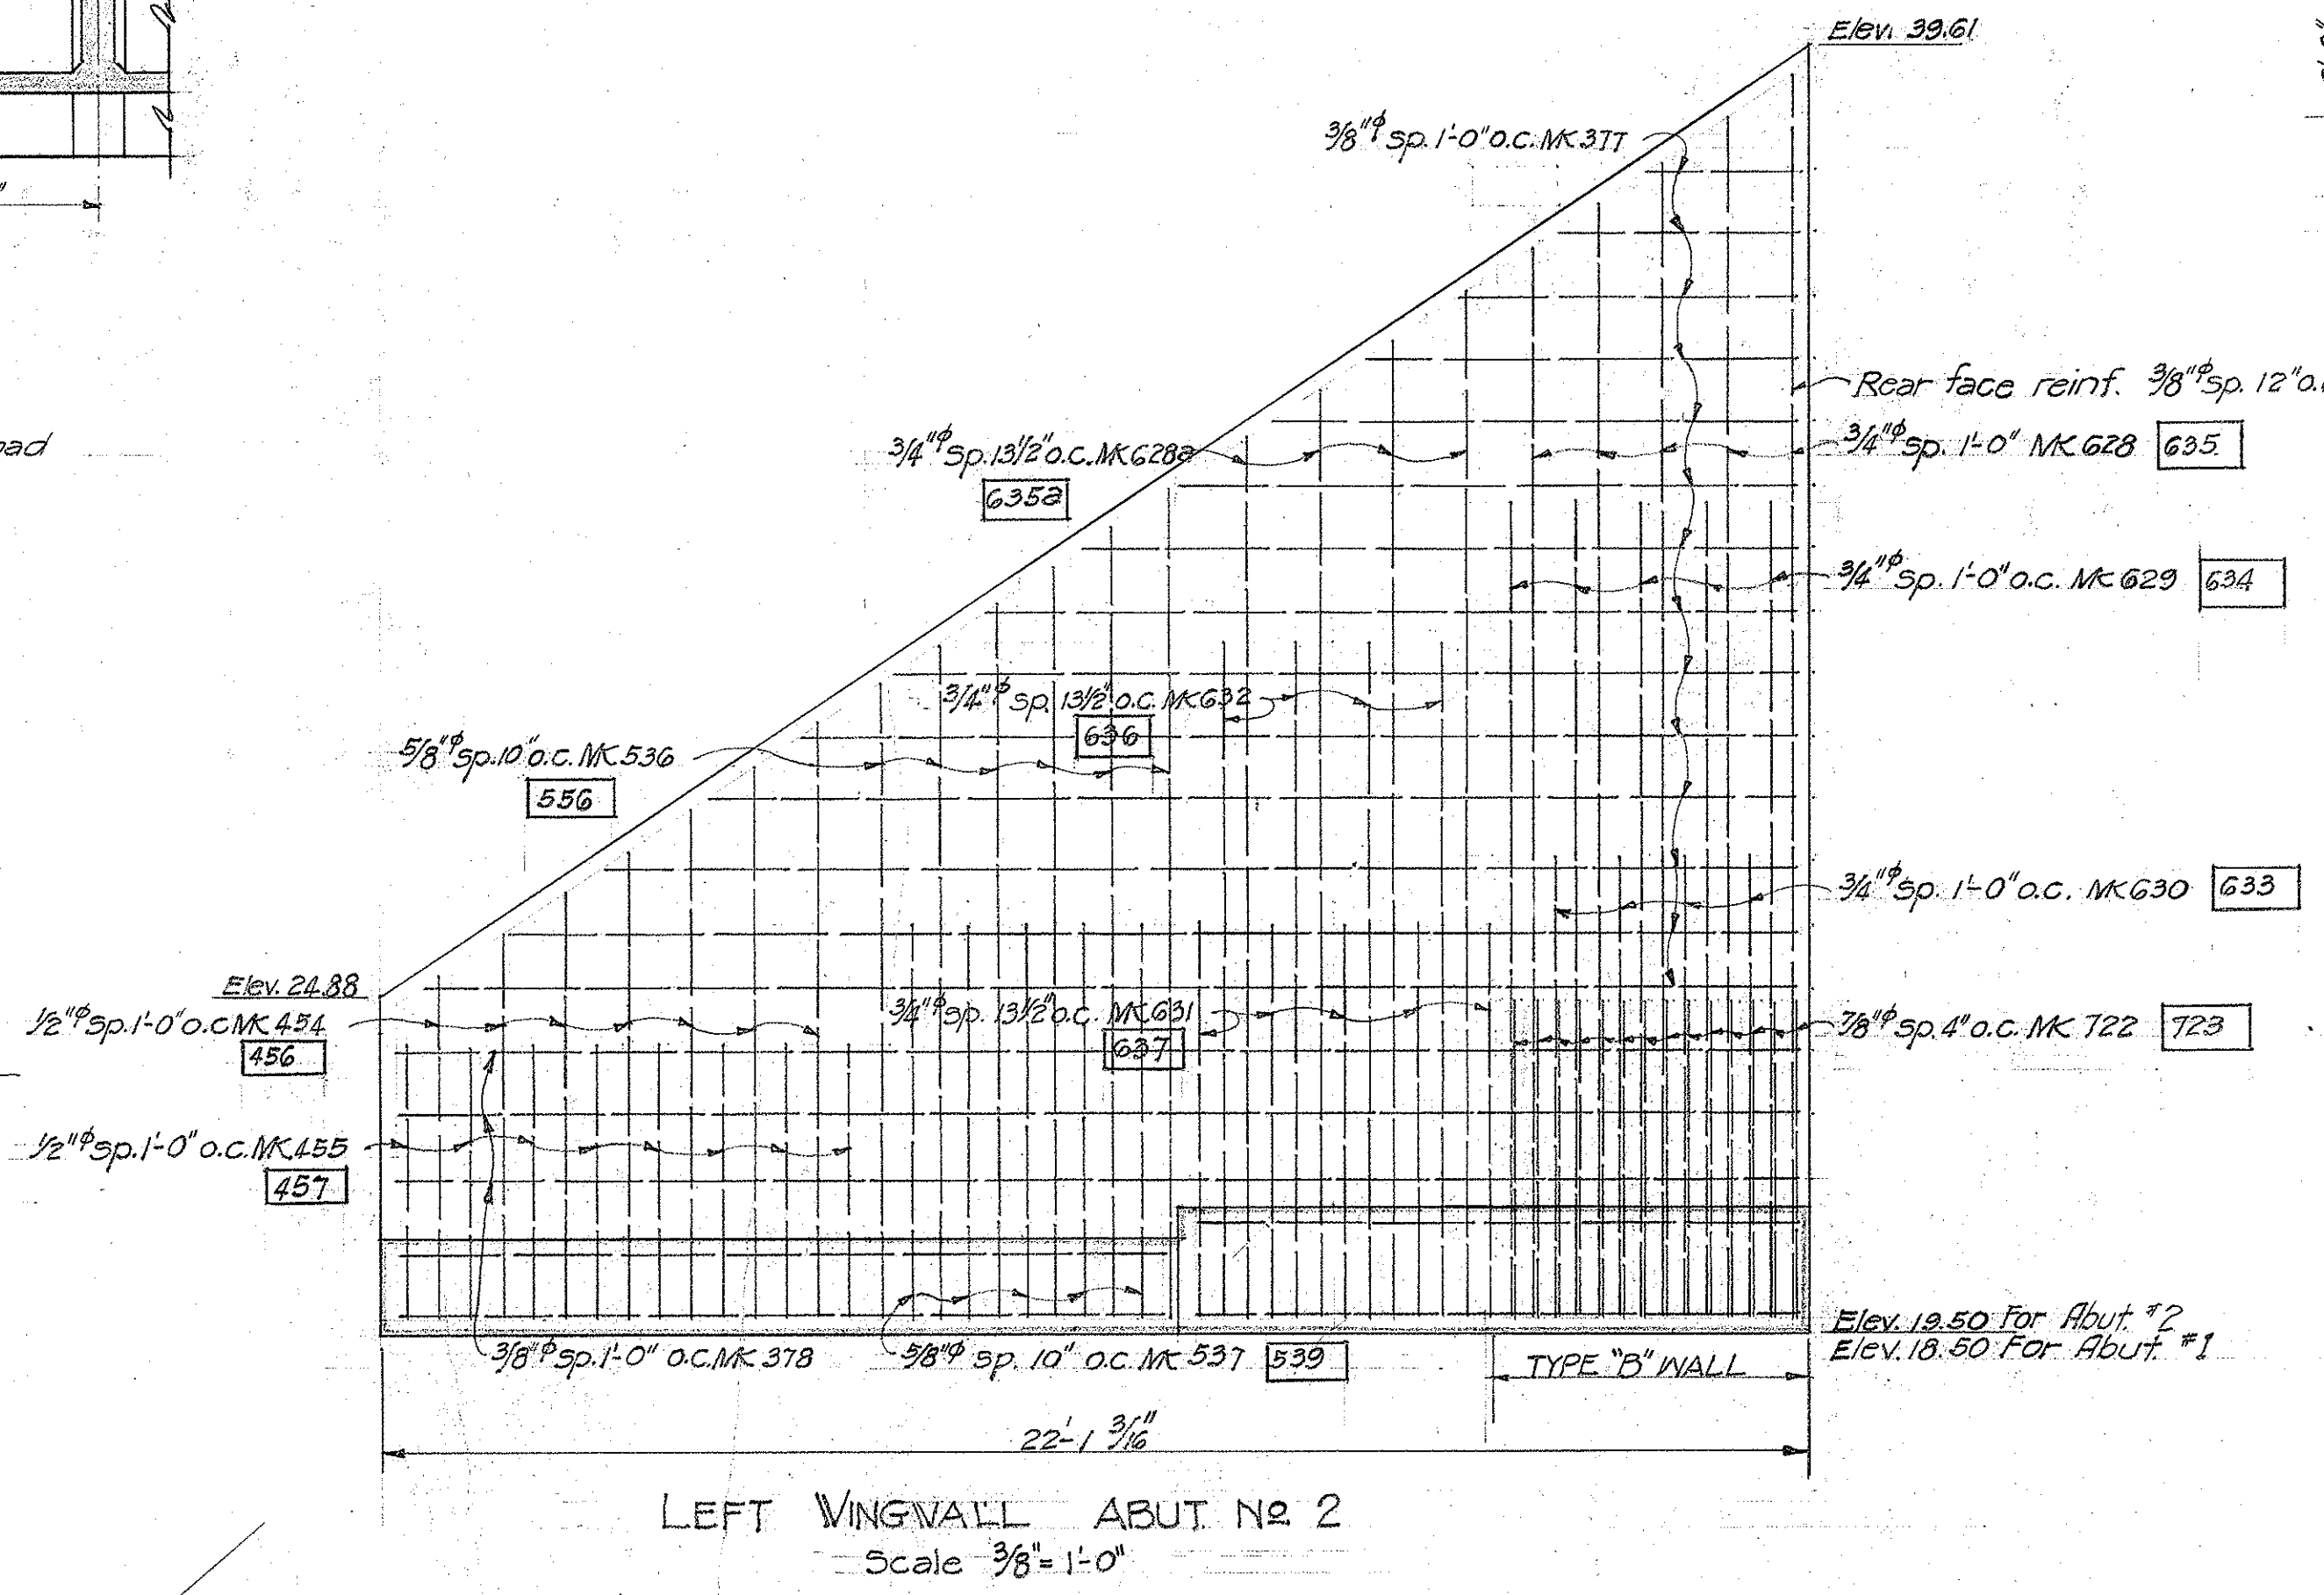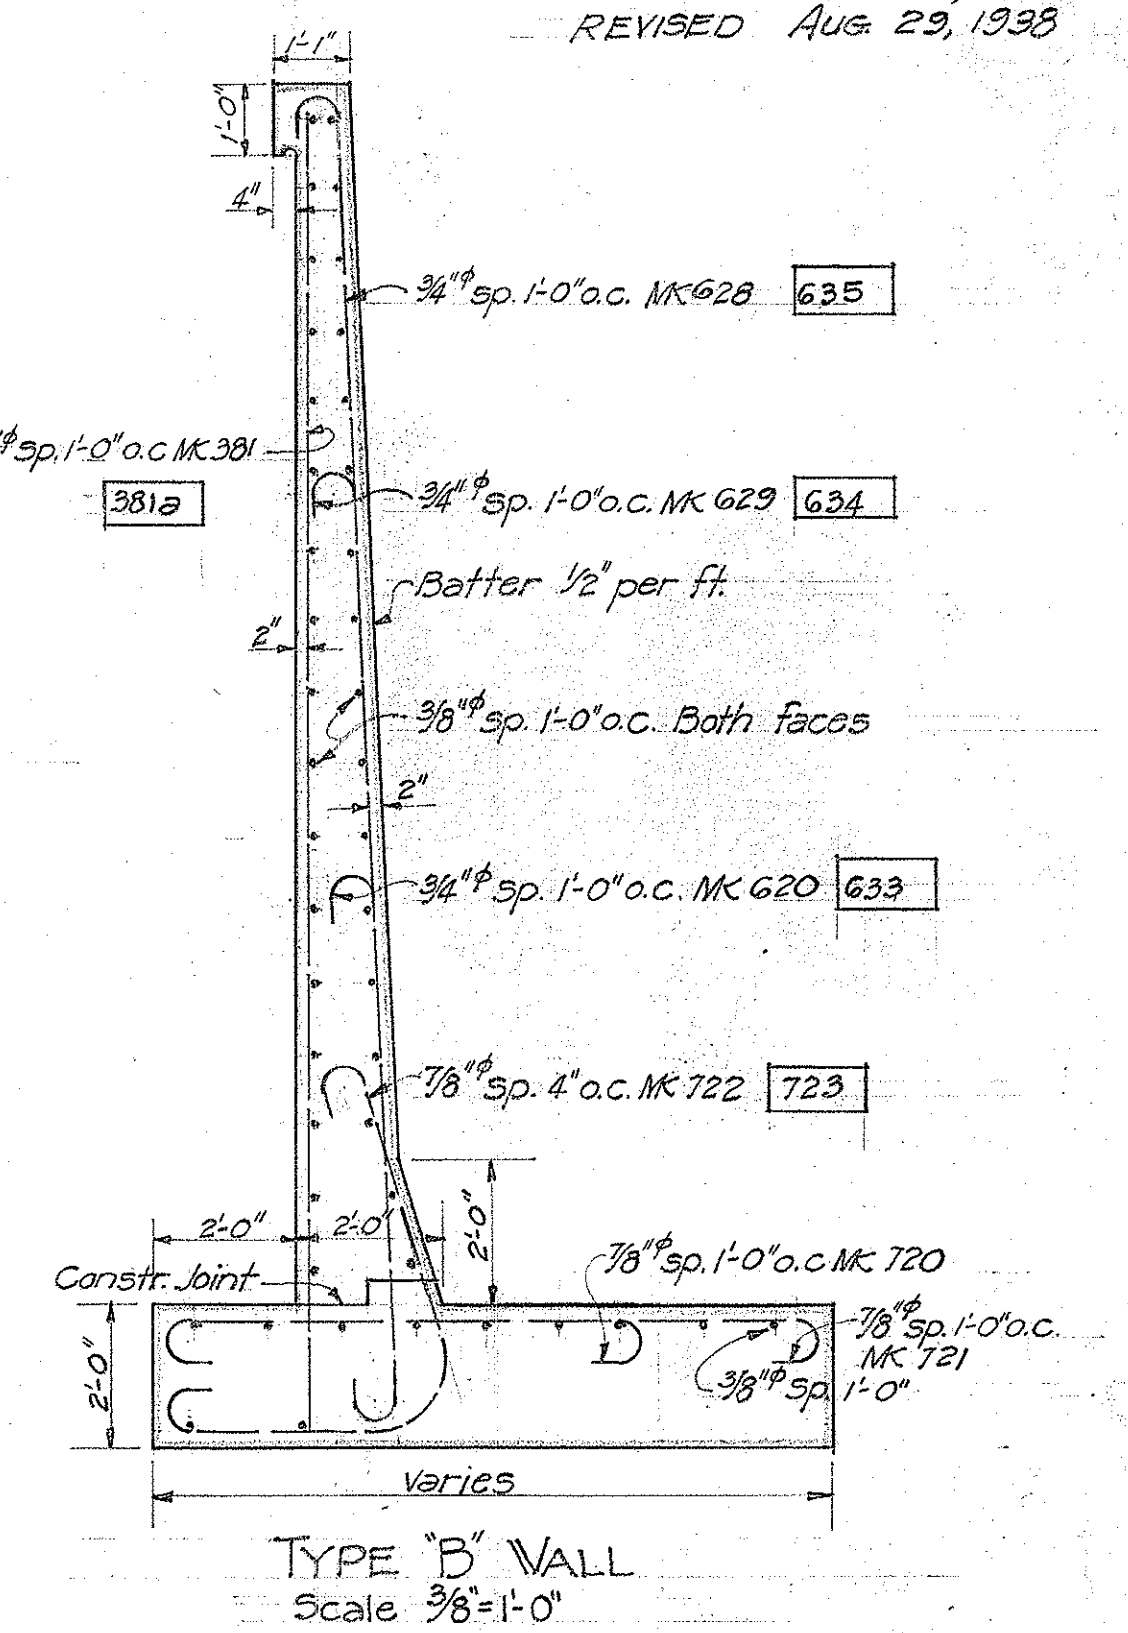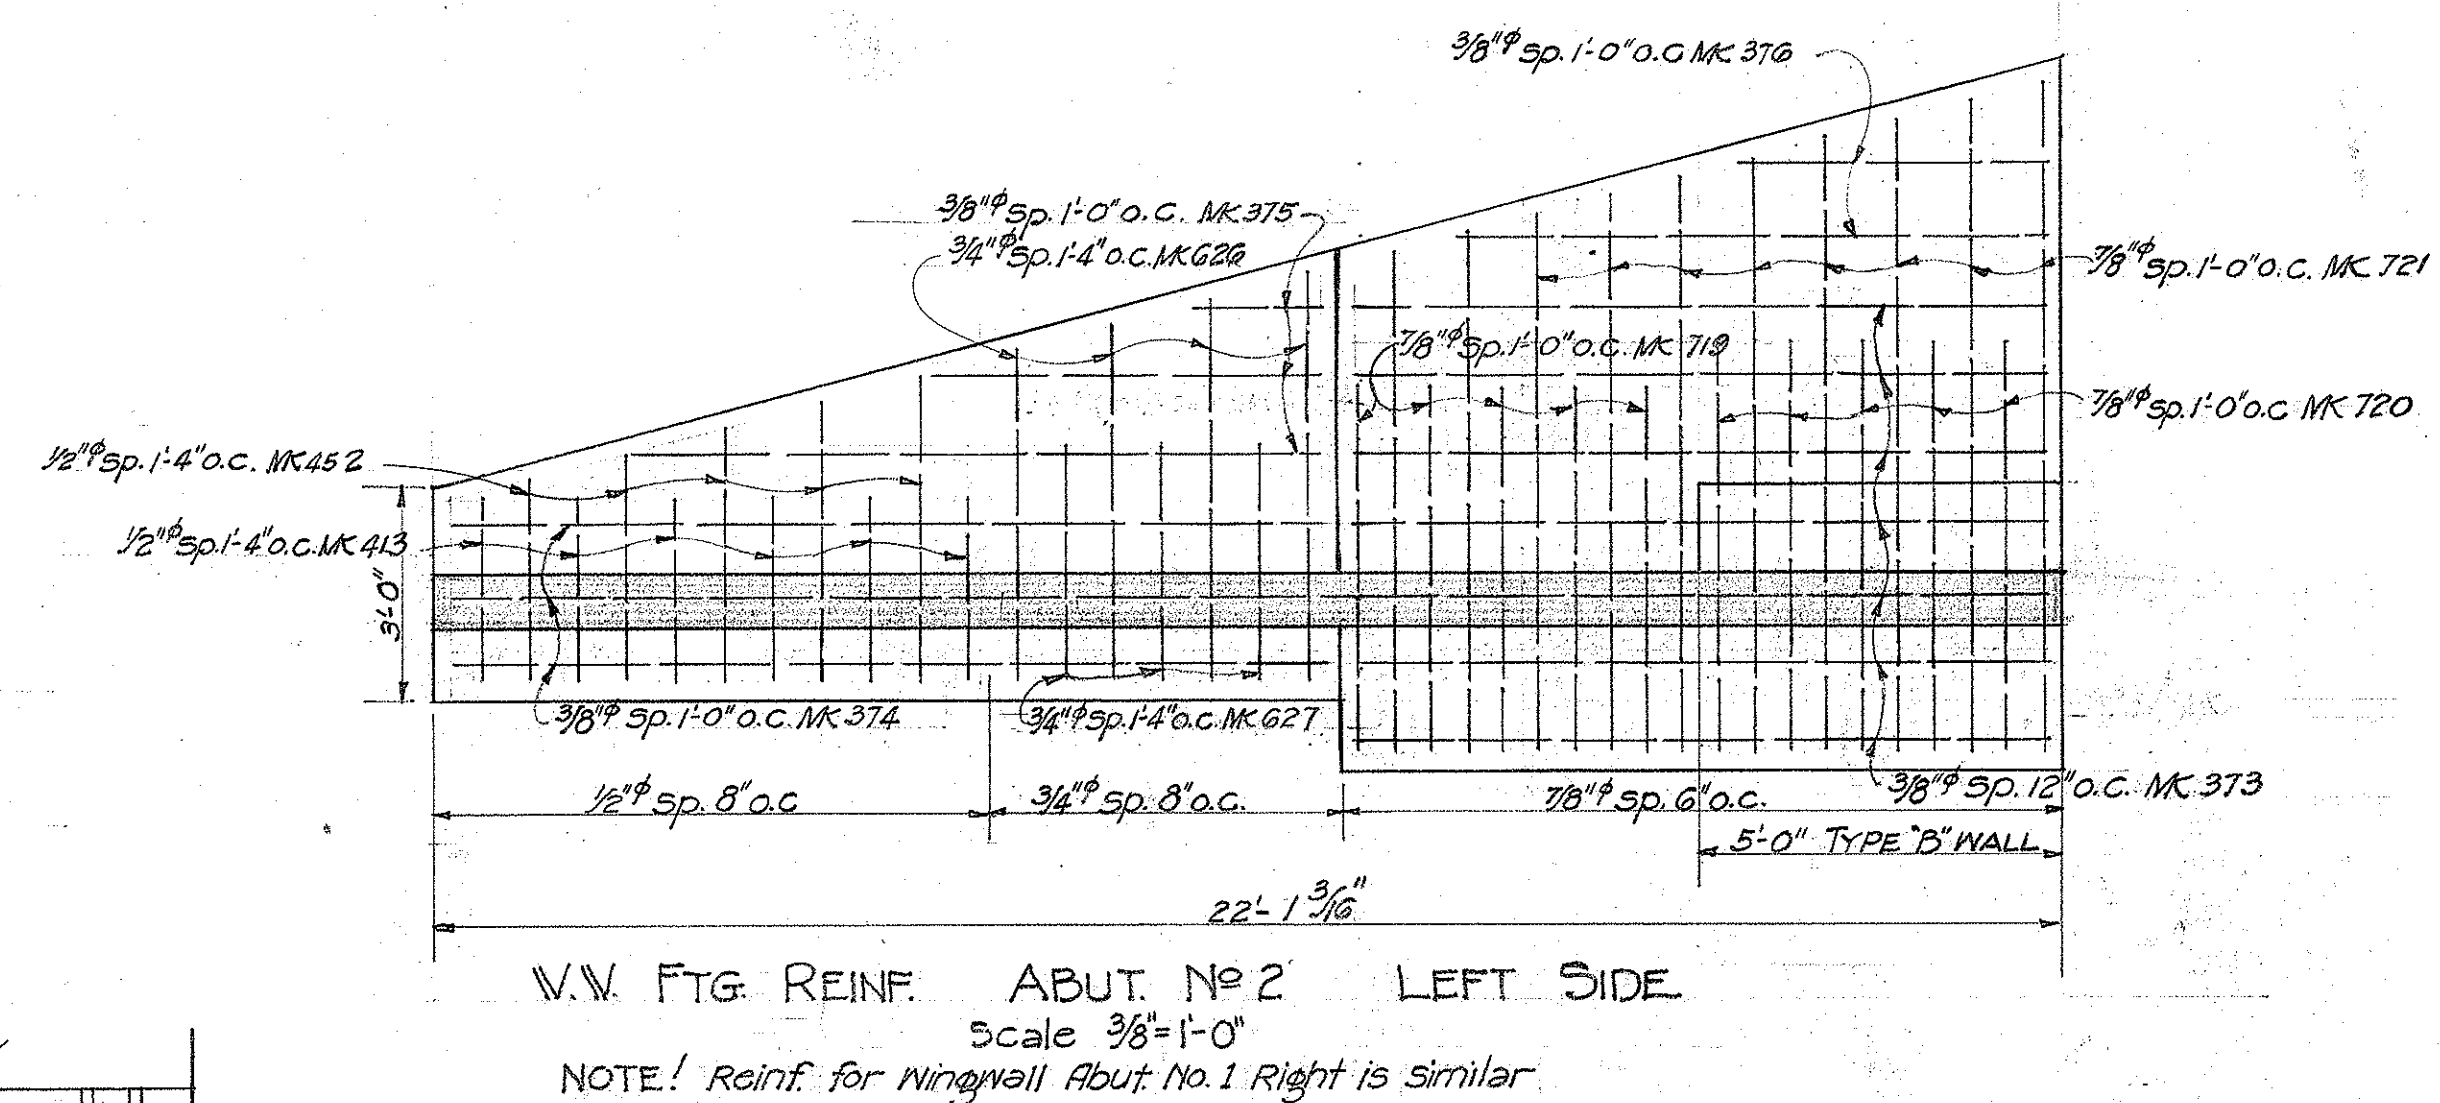

NOTE! Reinf. for Wingwall Abut. No. 1 Right is similar
Bar MK's are shown:

TERRITORIAL HIGHWAY DEPARTMENT
TERRITORY OF HAWAII

HIGHWAY OVERPASS

WAIANAE ROAD F.A.G.H. 4-C
DATE JUNE 1938 SCALES AS NOTED

SHEET No 2A OF 7 SHEETS

4450.21A


4470.21 A

REVISION Wingwalls of Abut. changed
REVISION 8/29/38 Wingwall length change from 22'-7¹³/₁₆" to 22'-7⁹/₁₆"


ORIGINAL	SURVEY PLOTTED BY	DATE
PLAN	DESIGNED BY	"
	DRAWN BY <i>W. Yamamoto</i>	" <i>6/38</i>
NOTE BOOK	TRACED BY	"
	QUANTITIES BY <i>W. Yamamoto</i>	"
	QUANTITIES CHECKED BY	"
No.	CHECKED BY	"

REVISED JUNE 10, 1938

Note: Reinf. in top similar to bottom except for bars indicated.

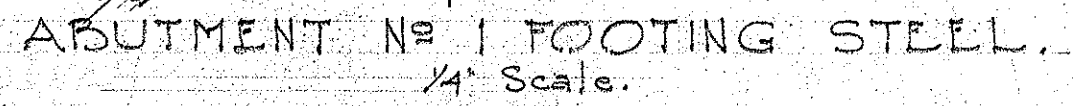

SIMILAR LAYOUT FOR ABUT. #2 FTG.

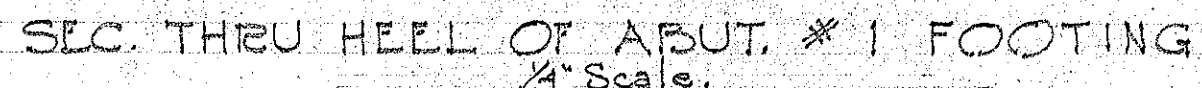


SIMILAR LAYOUT FOR ABUT. NO 2.

HALF SLC. THRU TOE OF ABUT. #1 FOOTING.


SIMILAR LAYOUT FOR ABUT. NO 2.



100

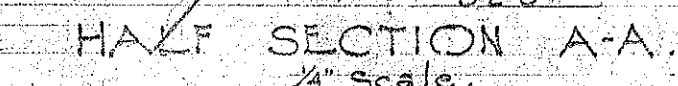


+

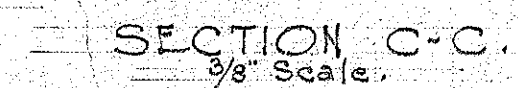

3/8" Scale.



THE JOURNAL OF THE

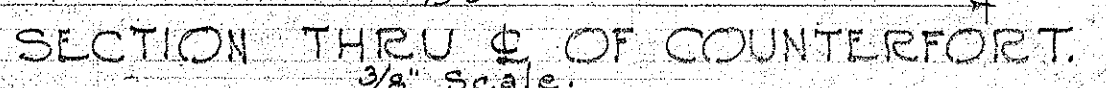

100

SHEET NO 3 OF 7 SHEETS


4450.22

REVISION: Windows & About changed.

ORIGINAL PLAN	SURVEY PLOTTED BY W. R. GARDNER	DATE Jan. 1933
NOTEBOOK	DRAWN BY C. F. VANDER	" Feb "
	TRACED BY C. F. W.	" "
	QUANTITIES BY L. J. G.	" "
No. _____	CHECKED BY _____	" "


REVISED JUNE 10, 1938

NOTE: Rein. in top similar to bottom except for bars indicated.

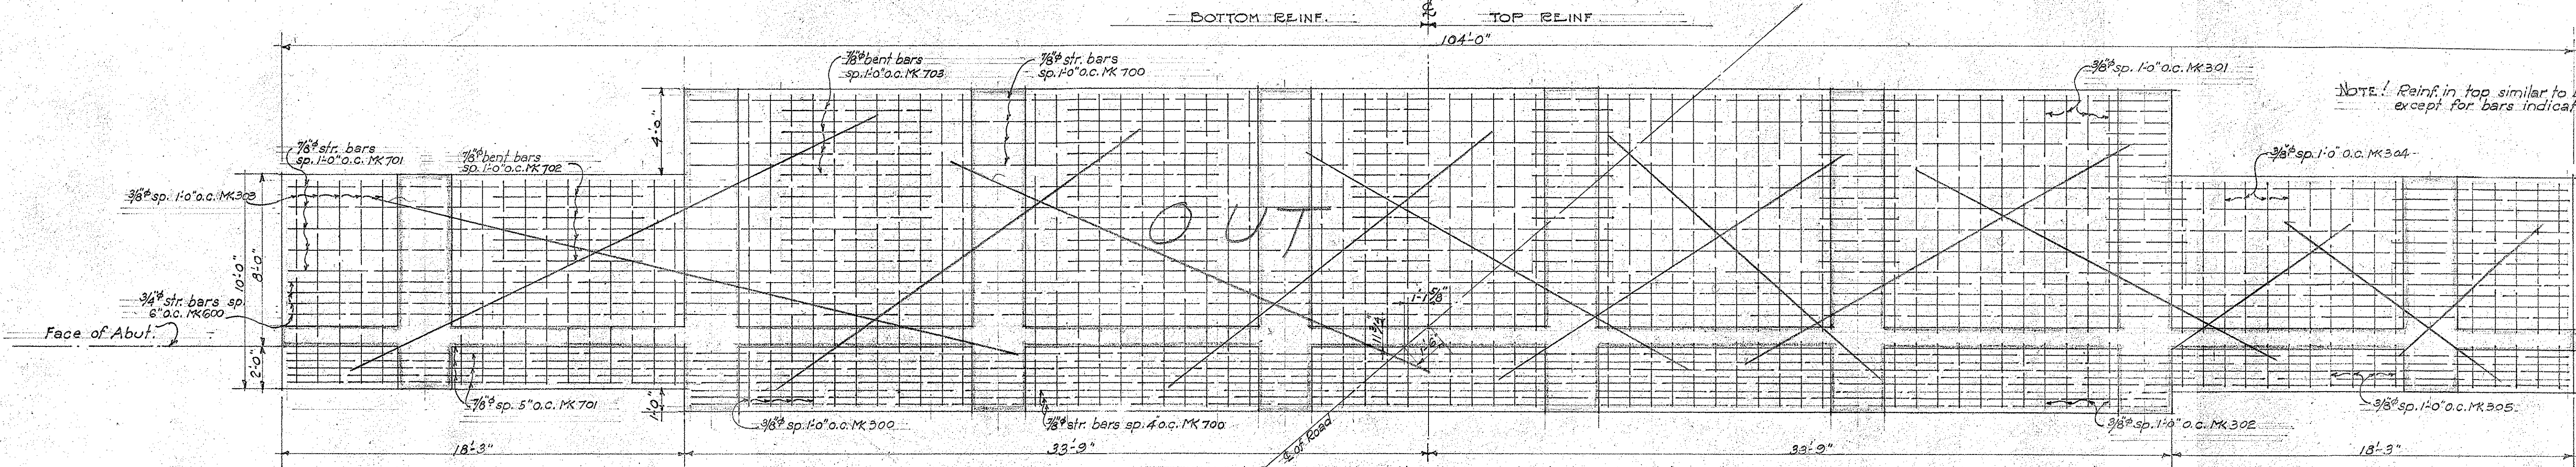

ABUTMENT #1 FOOTING STEEL.
1/4" Scale.


SIMILAR LAYOUT FOR ABUT. #2 FTG.

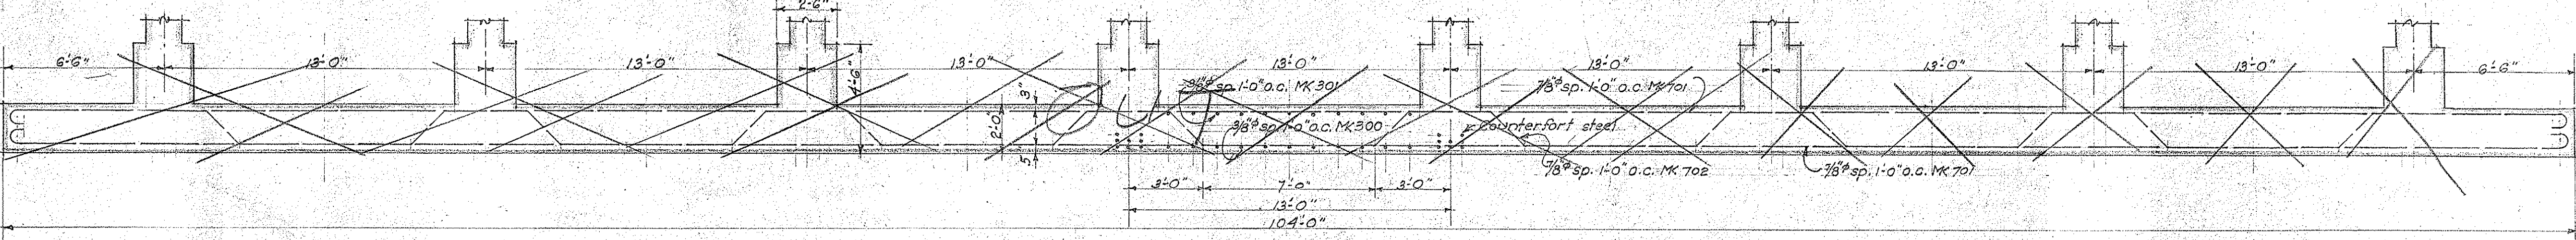

SEC. THRU HEEL OF ABUT. #1 FOOTING
1/4" Scale.


SIMILAR LAYOUT FOR ABUT. #2.

NOTE: FOR REVISED DETAILS, OF DETAILS
CROSSED OUT SEE SHEET NO 4450.22A

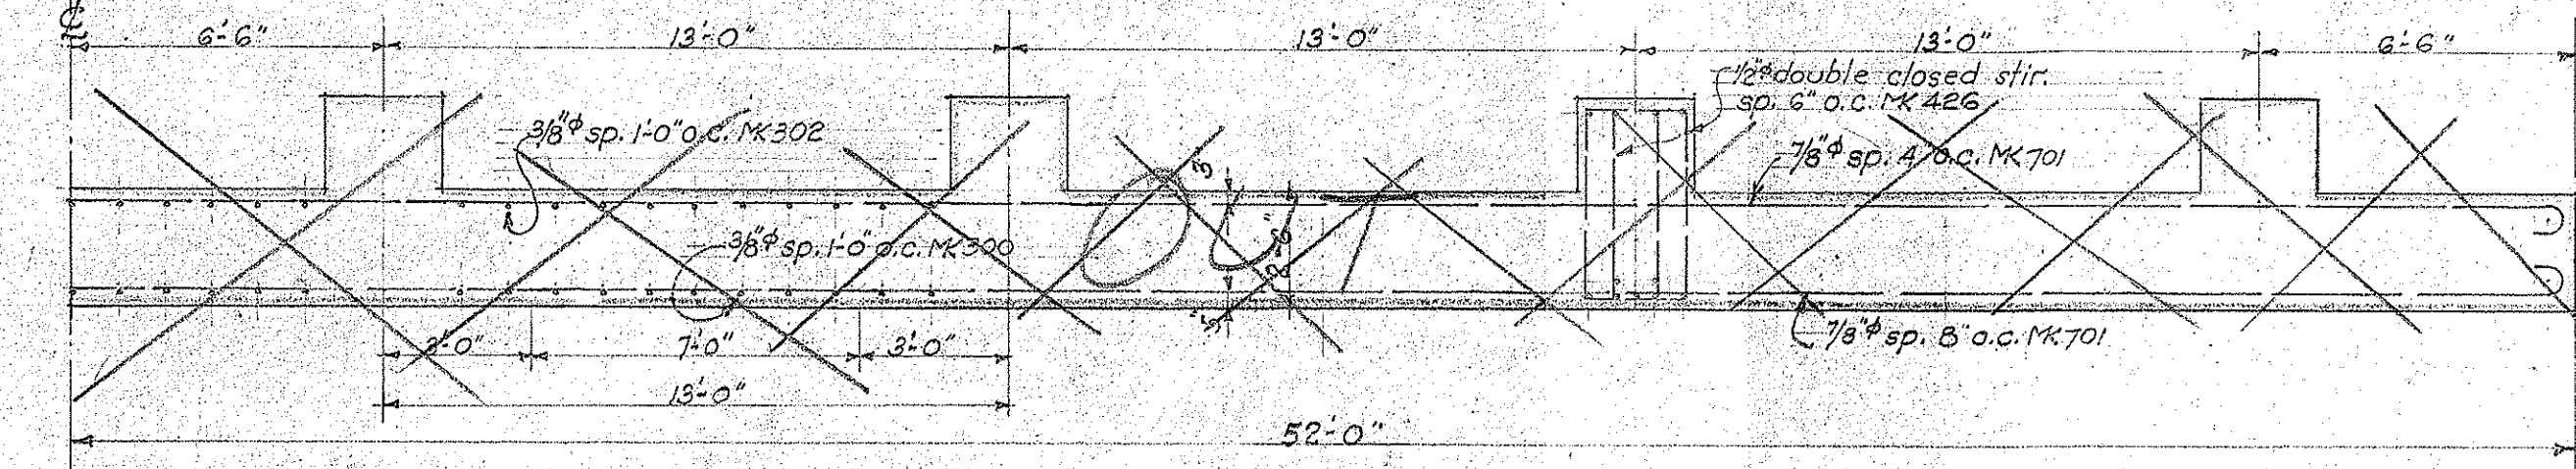


HALF SEC. THRU TOE OF ABUT. #1 FOOTING.
1/4" Scale.


SIMILAR LAYOUT FOR ABUT. #2.

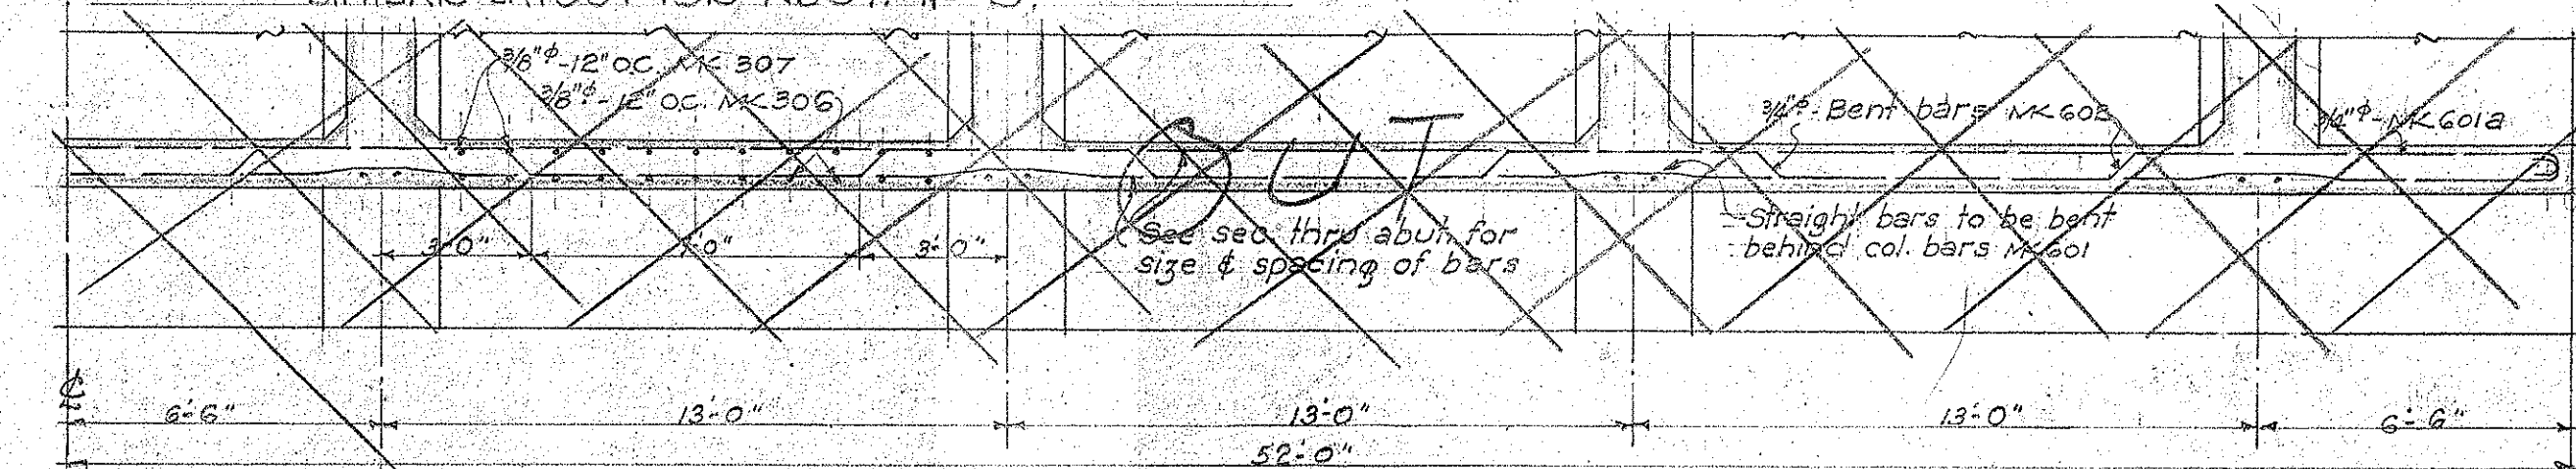


HALF SECTION B-B.
1/4" Scale.

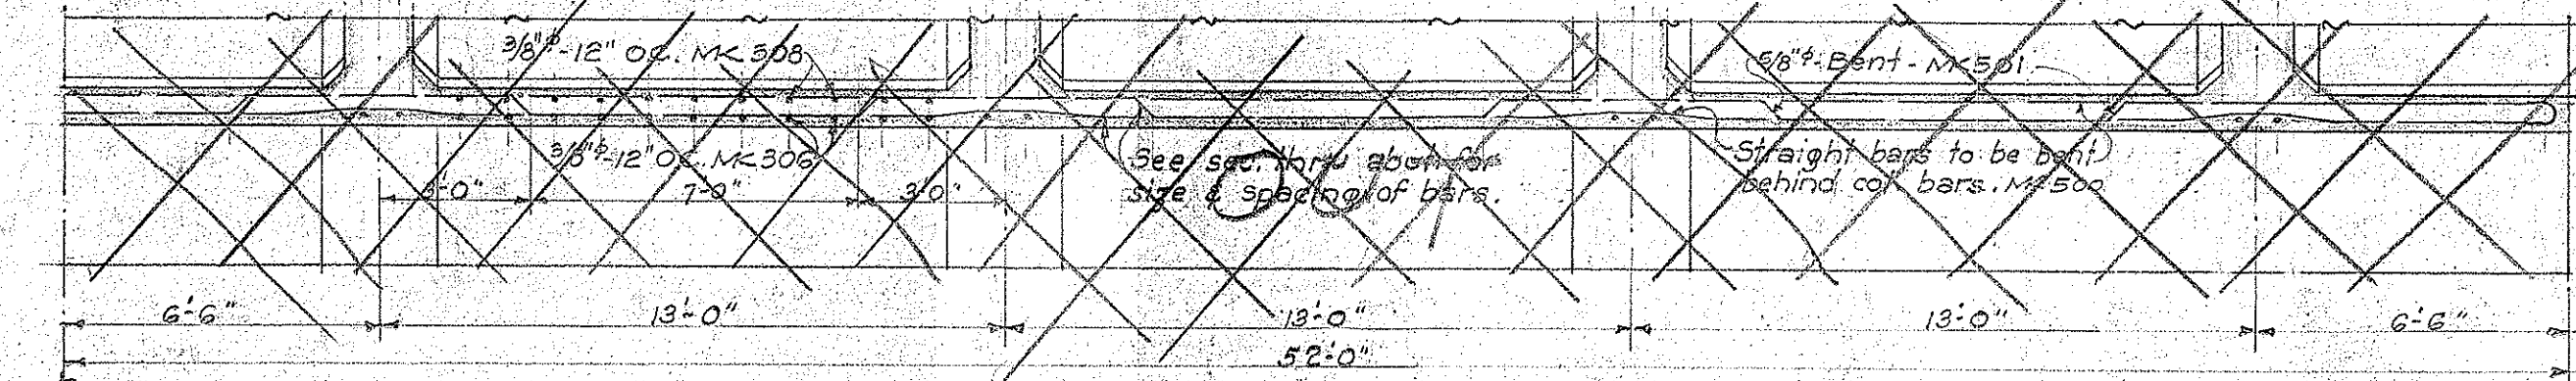

HALF SECTION A-A.
1/4" Scale.

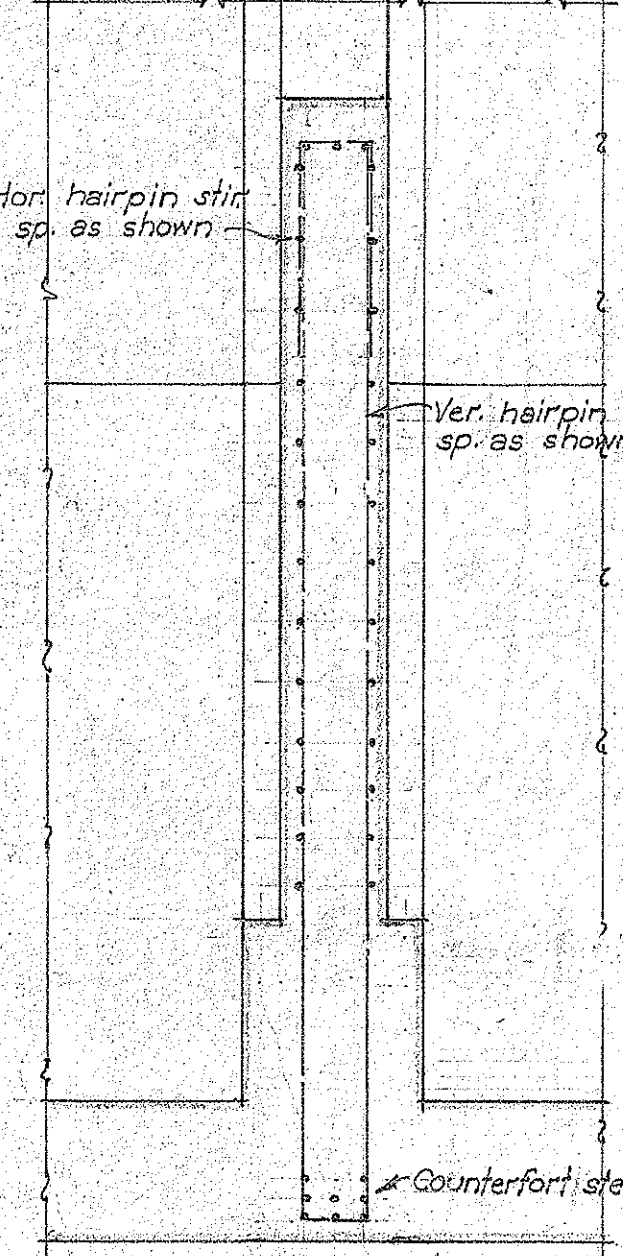


SECTION C-C.
3/8" Scale.

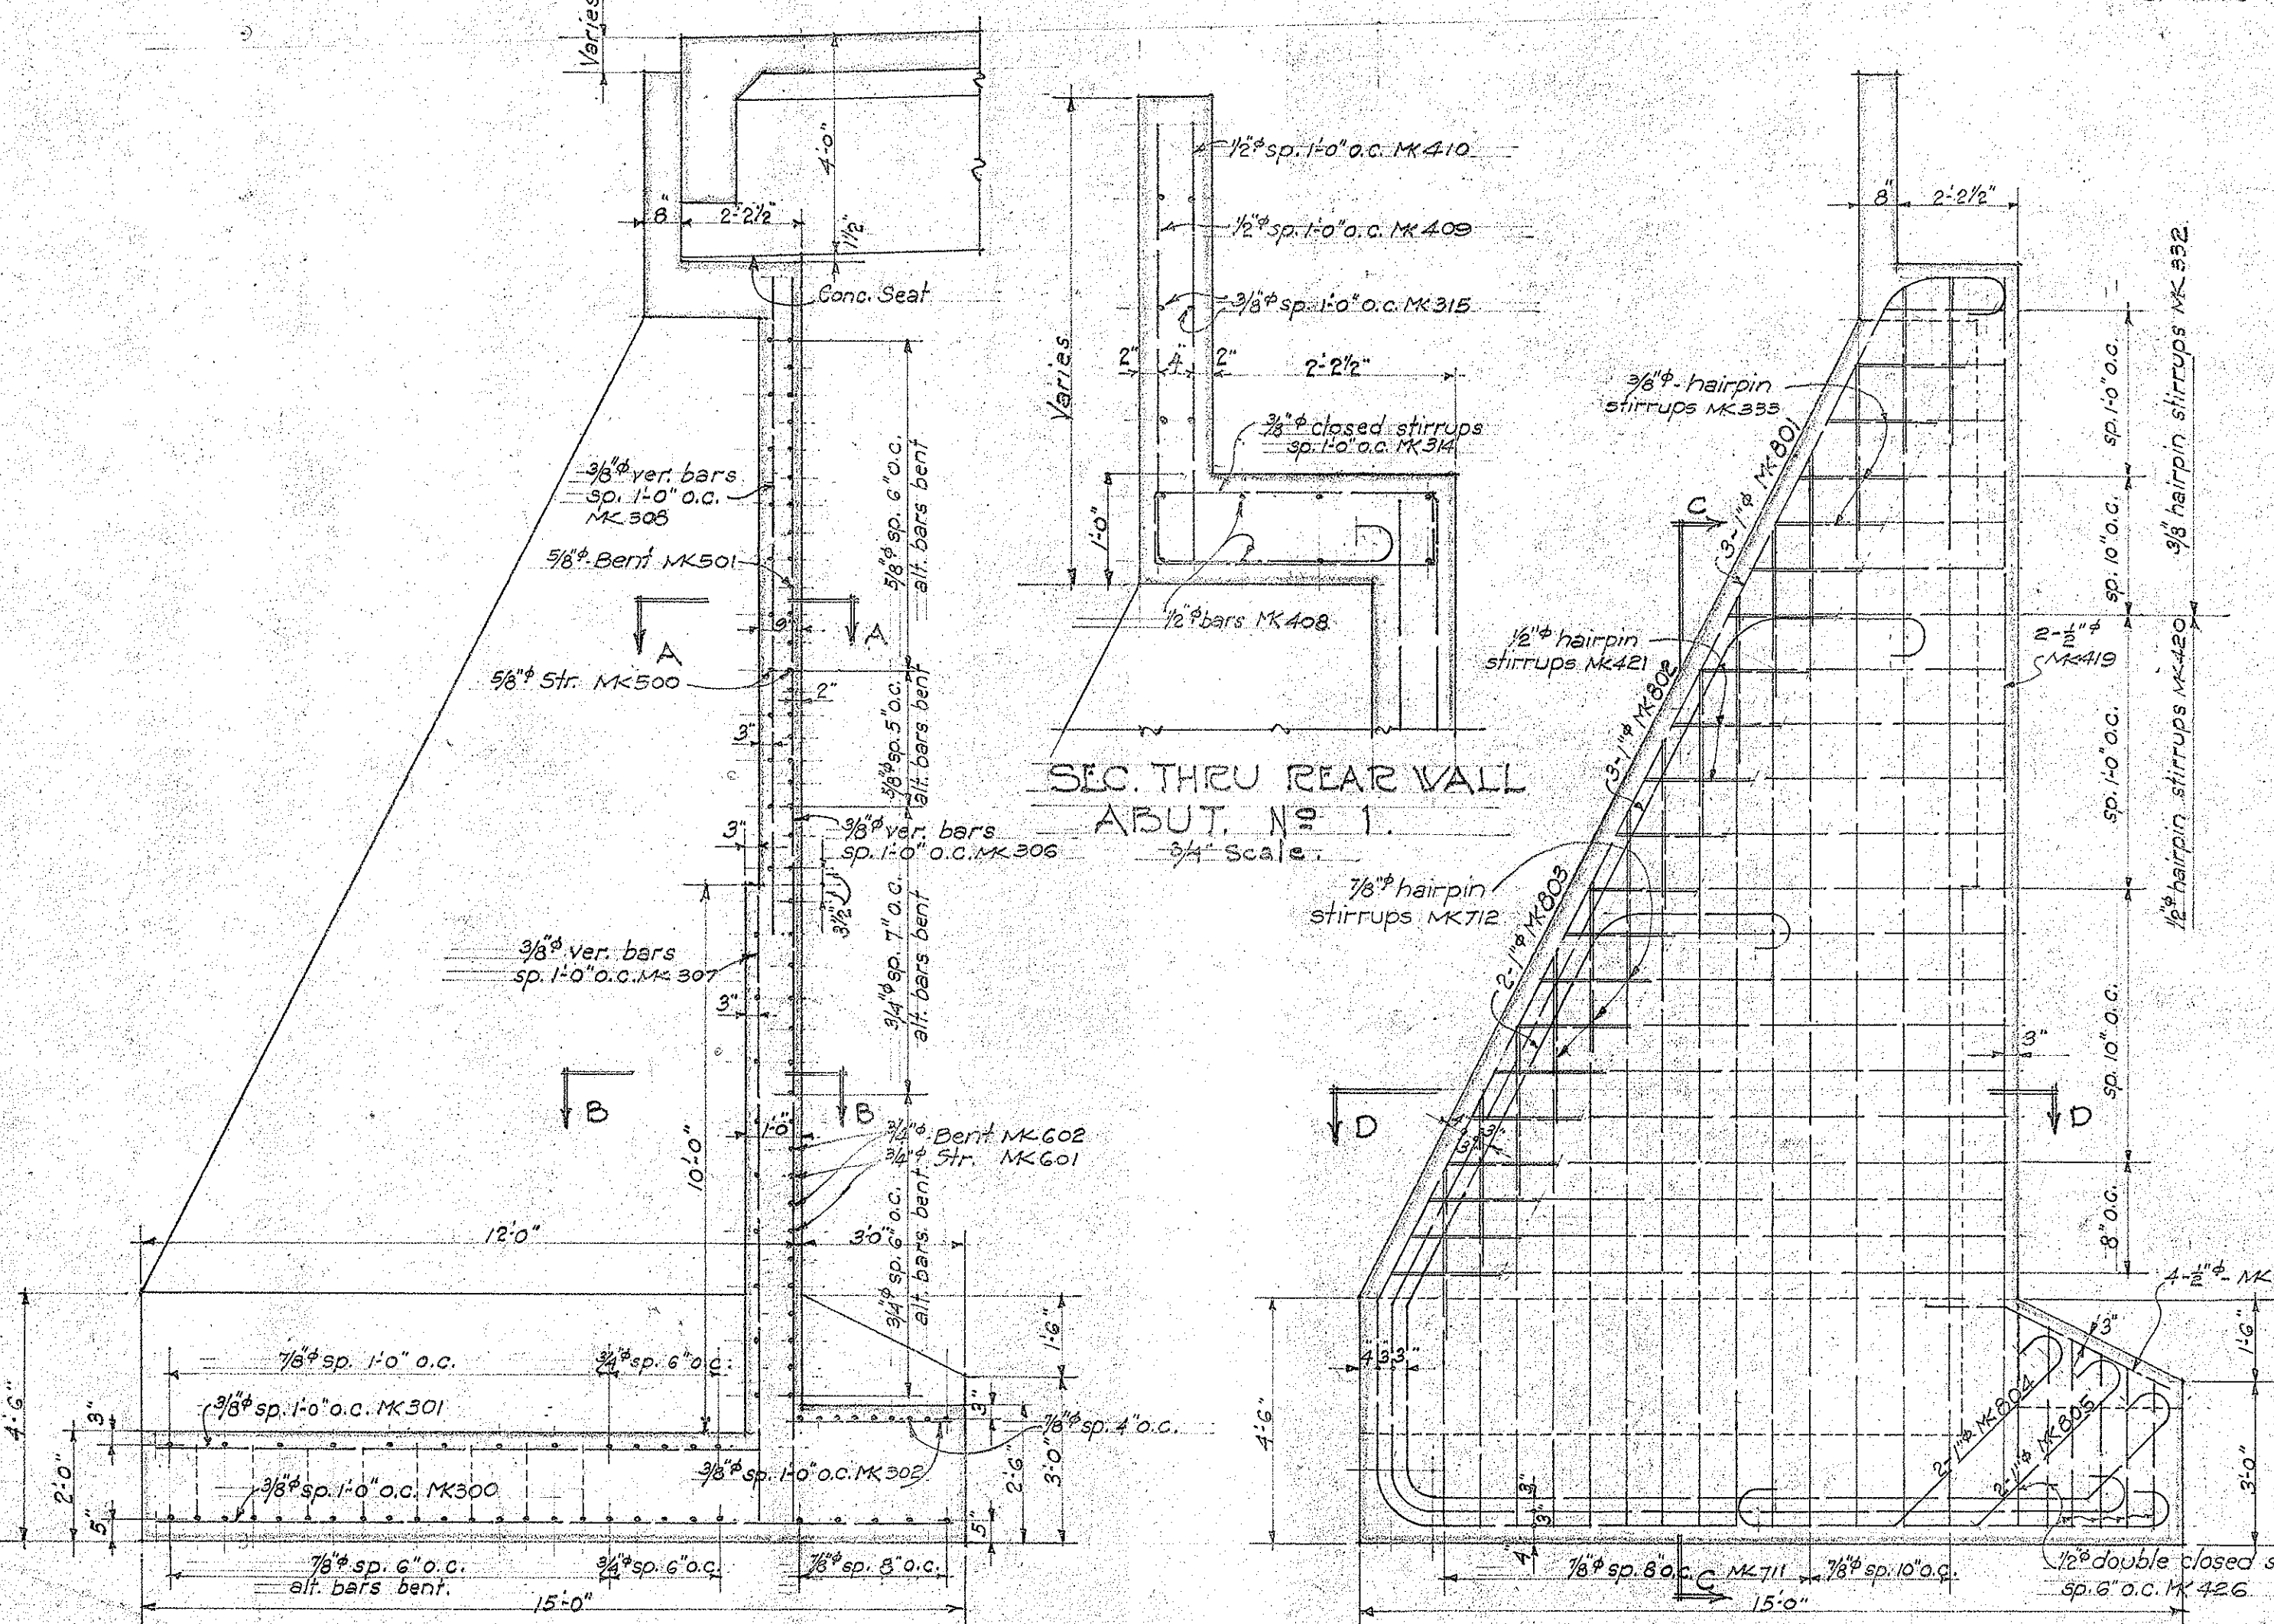

SEC. THRU REAR WALL
ABUT. #1.

3/4" Scale.

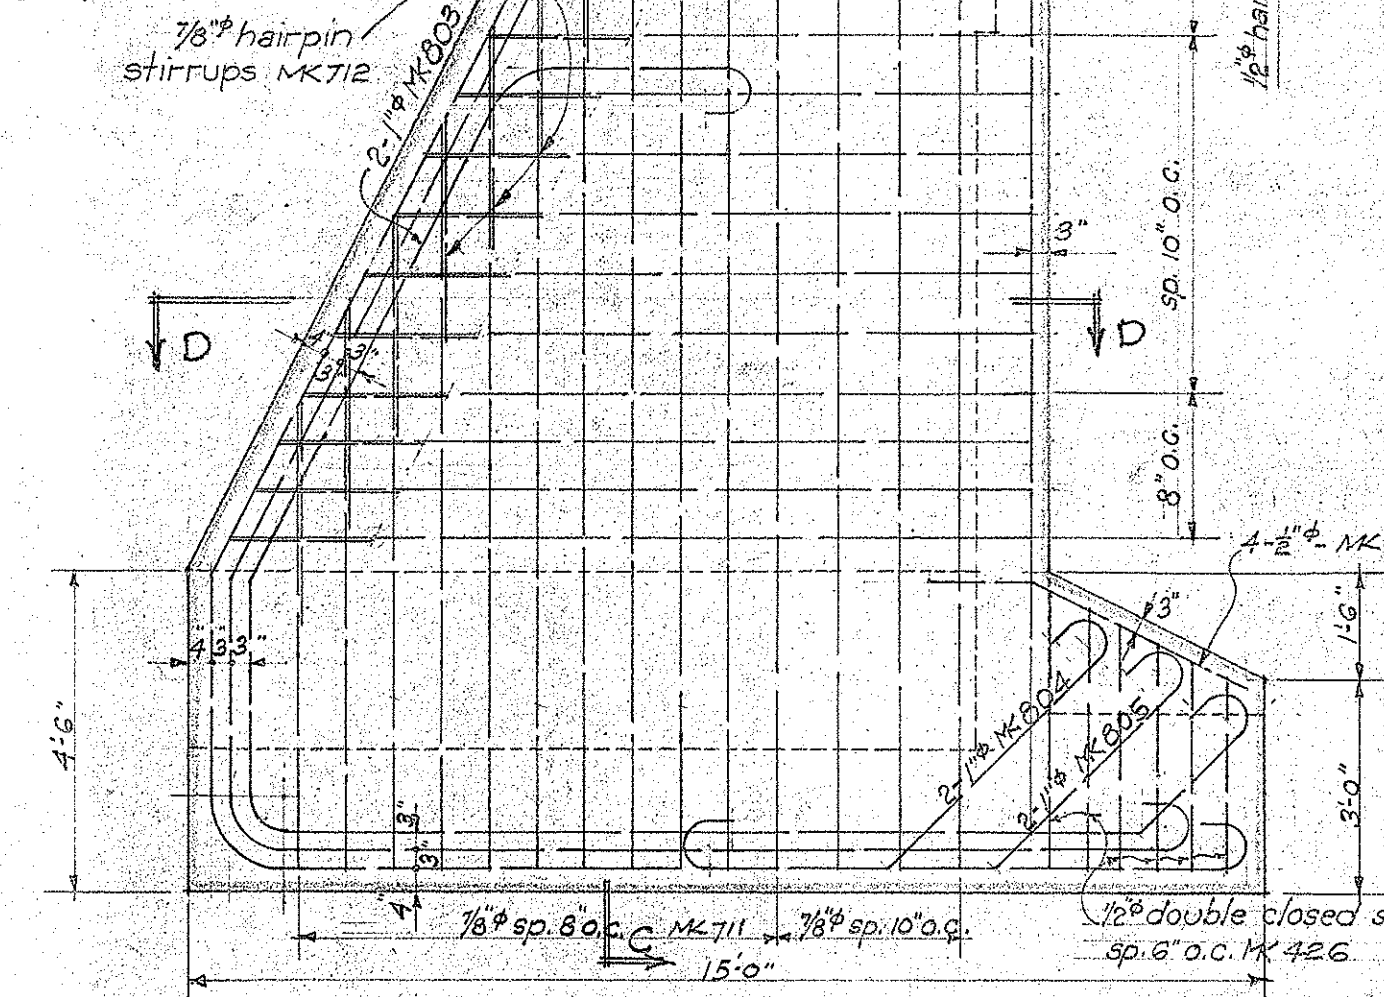




SECTION THRU E. OF COUNTERFORT.
3/8" Scale.

SEC. THRU ABUTMENT #1
3/8" Scale.

REVISION: Wingwalls of Abut. changed.

DATE	BY	REASON
Jan. 1938	C.F. Wagner	Original Plan
Feb. 1938	C.F. Wagner	Revised
Mar. 1938	C.F. Wagner	Revised
Apr. 1938	C.F. Wagner	Revised
May 1938	C.F. Wagner	Revised
Jun. 1938	C.F. Wagner	Revised
Jul. 1938	C.F. Wagner	Revised
Aug. 1938	C.F. Wagner	Revised
Sep. 1938	C.F. Wagner	Revised
Oct. 1938	C.F. Wagner	Revised
Nov. 1938	C.F. Wagner	Revised
Dec. 1938	C.F. Wagner	Revised

REVISED JUNE 10, 1938





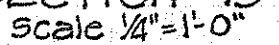
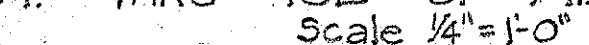
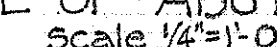


4450.22A

ORIGINAL PLAN	NOTE BOOK No.
------------------	------------------

QUANTITIES	
CONCRETE - Class B	13.3 C.Y.
TIMBER - UNTREATED	1.7 MBM.
METAL FLUME	82 Lin. Ft.
STR. EXC.	15 C.Y.
STR. STEEL	210 LBS.

Note:- All concrete to be Class "B"
 All bolts to be 3/4" with Ogee C.I. washers where bearing is against wood.
 All timber to be untreated Douglas Fir - Coast Region - of select structural grade.
 All hardware and structural metal to be galvanized.
 Sheet Brackets, Anchor bolts, Anchor straps are included in "Structural Metal"

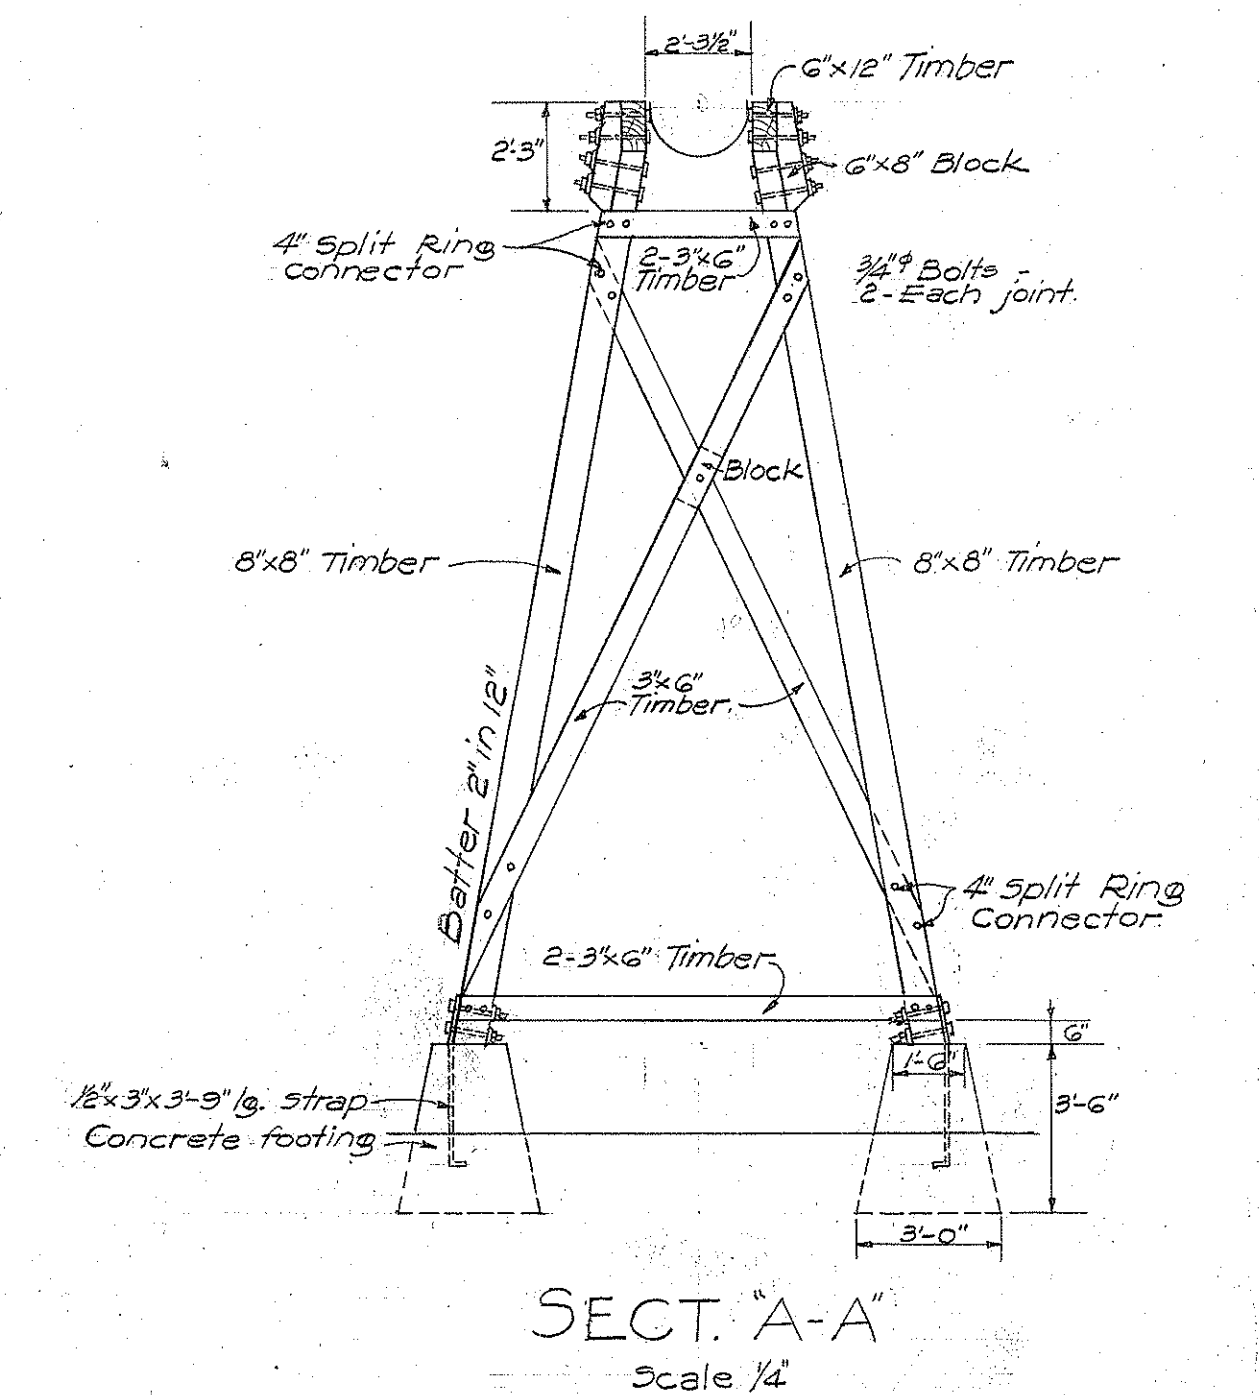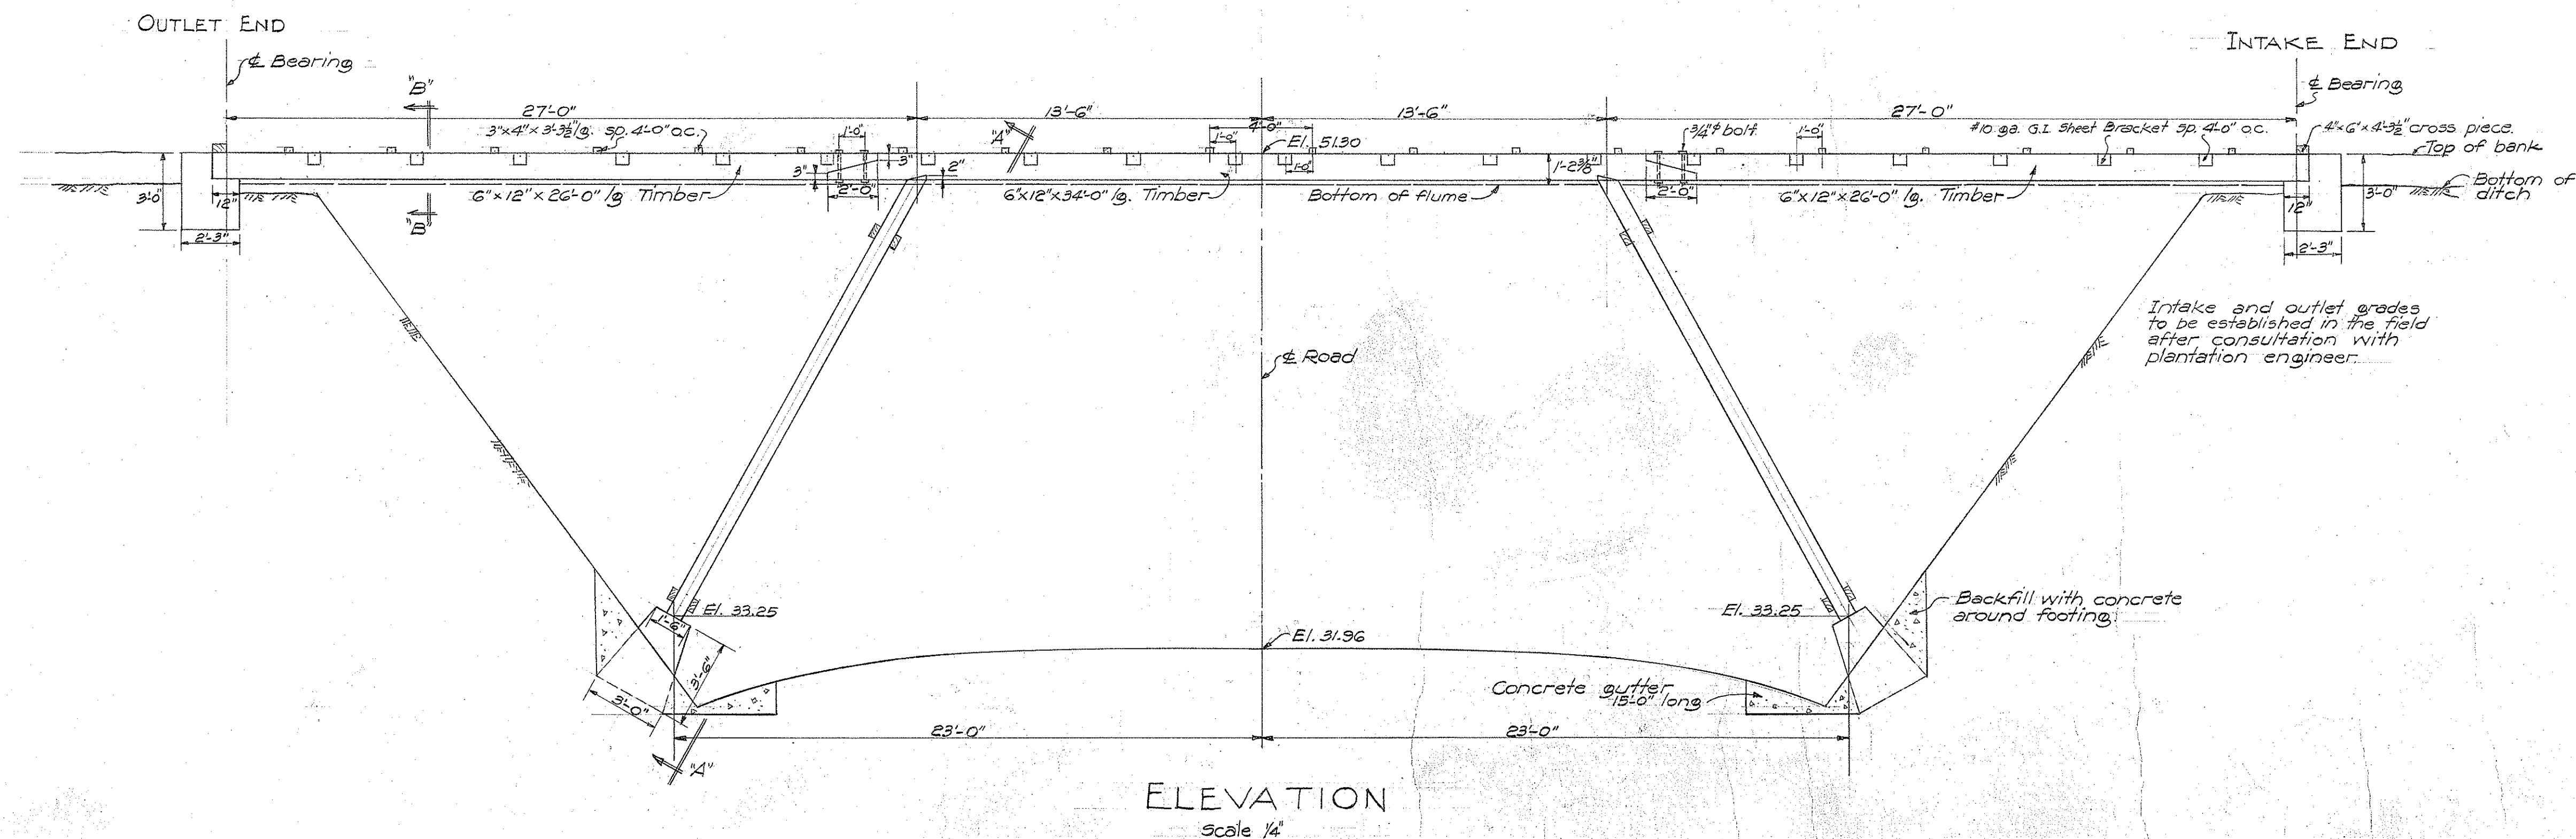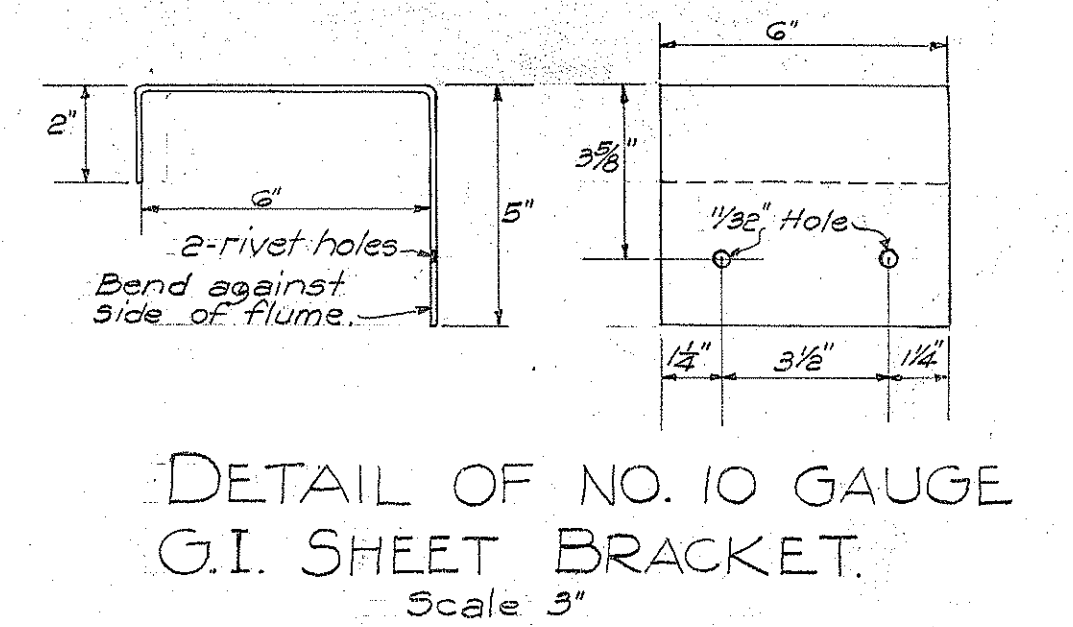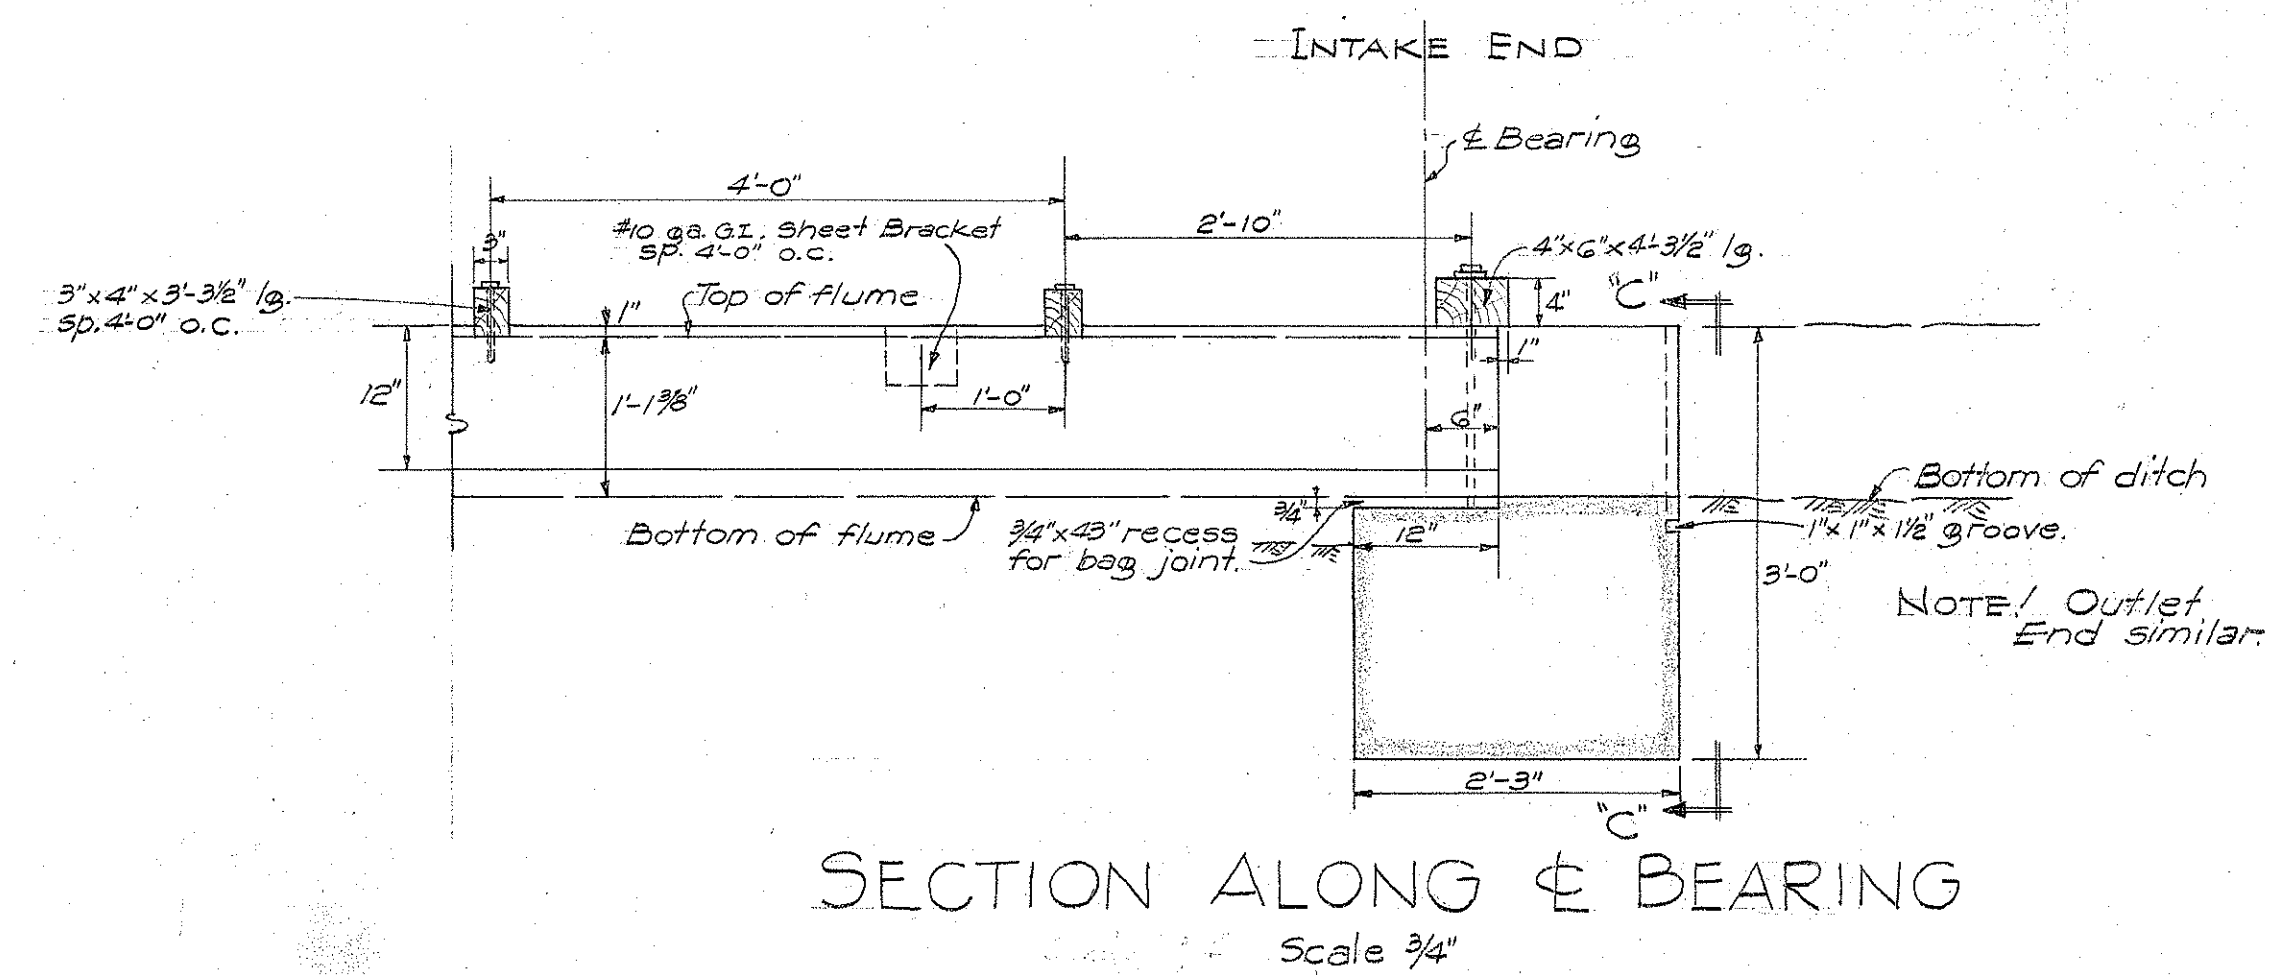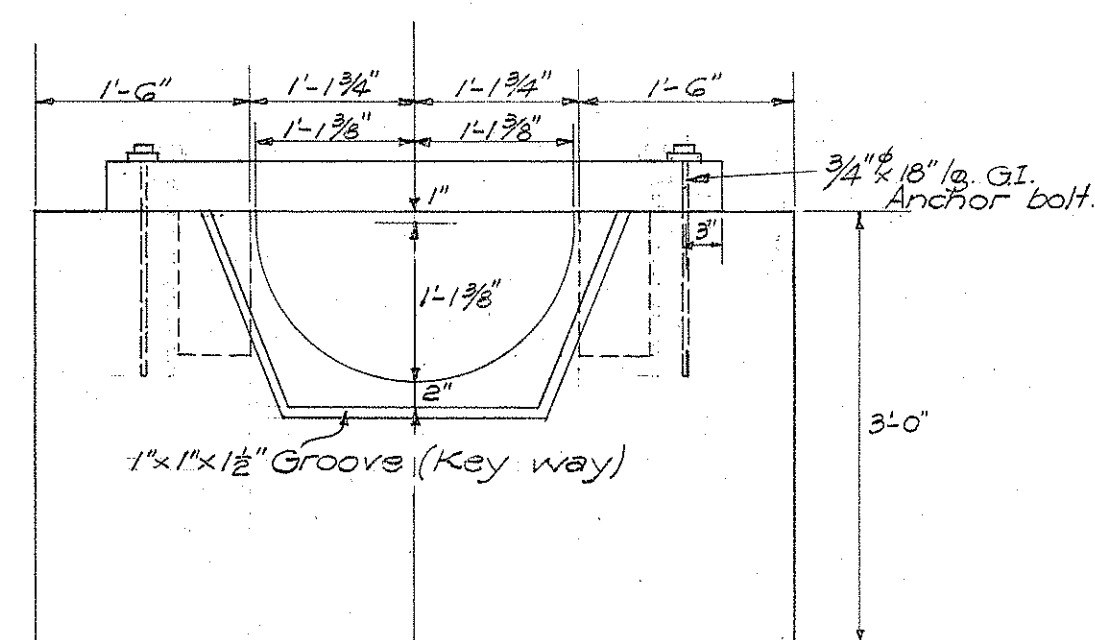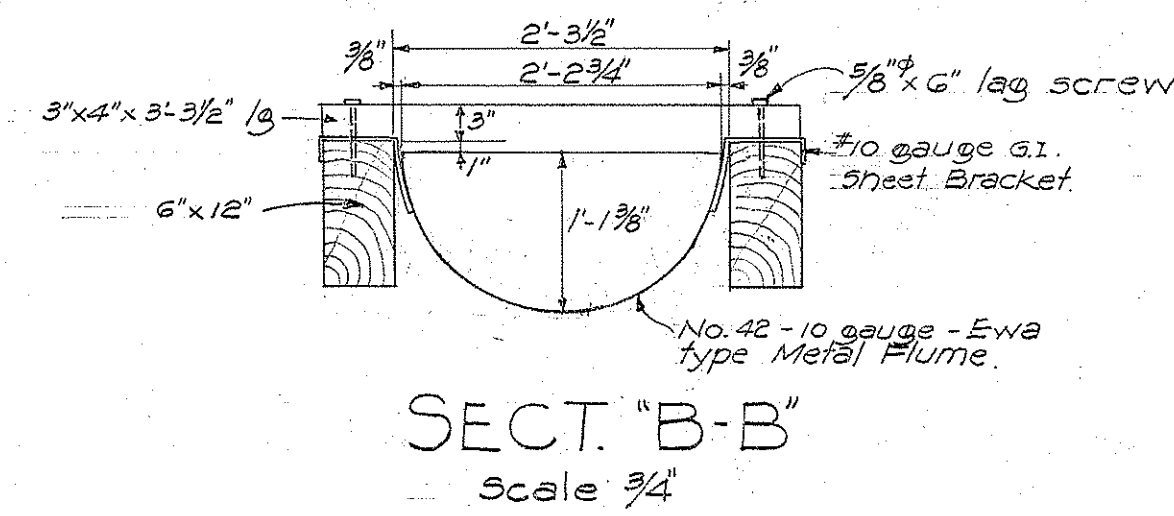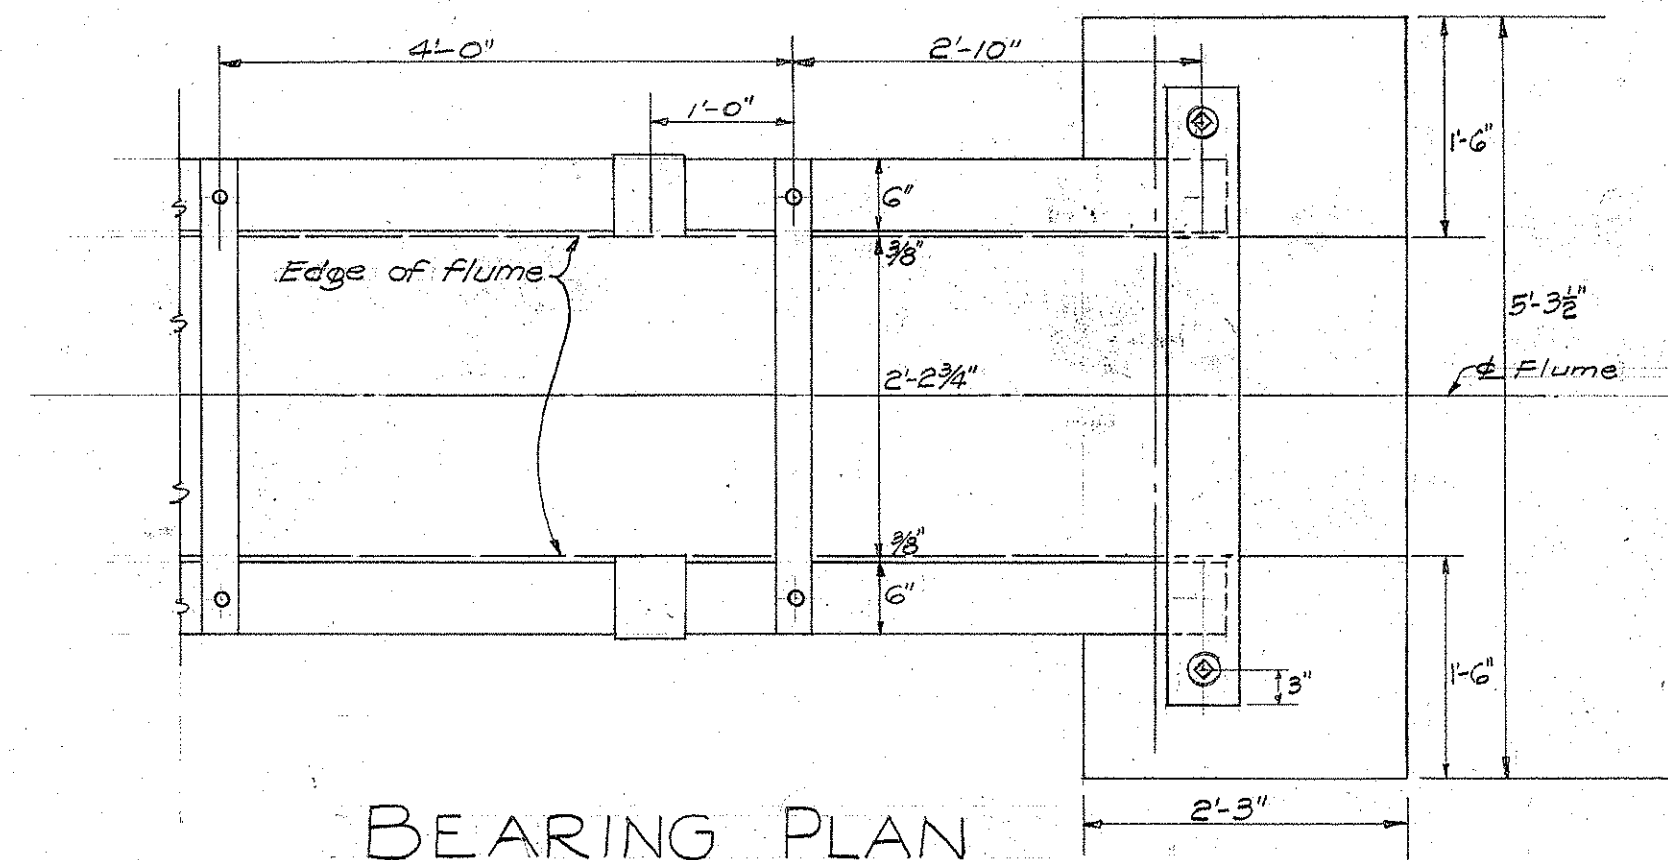



TERRITORIAL HIGHWAY DEPARTMENT
TERRITORY OF HAWAII
SEMICIRCULAR METAL FLUME
STA. 153+00
WAIANAE ROAD
JUNE - 1938

FAP 4C
SCALES AS NOTED
SHEET NO. 228 OF 75 SHEETS

SURVEYED BY: [blank]
 DATE: [blank]
 DRAWN BY: [blank]
 CHECKED BY: [blank]
 QUANTITIES CHECKED BY: [blank]
 NOTE BOOK: [blank]
 No. [blank]

4449.22B

REVISED JUNE 10, 1938

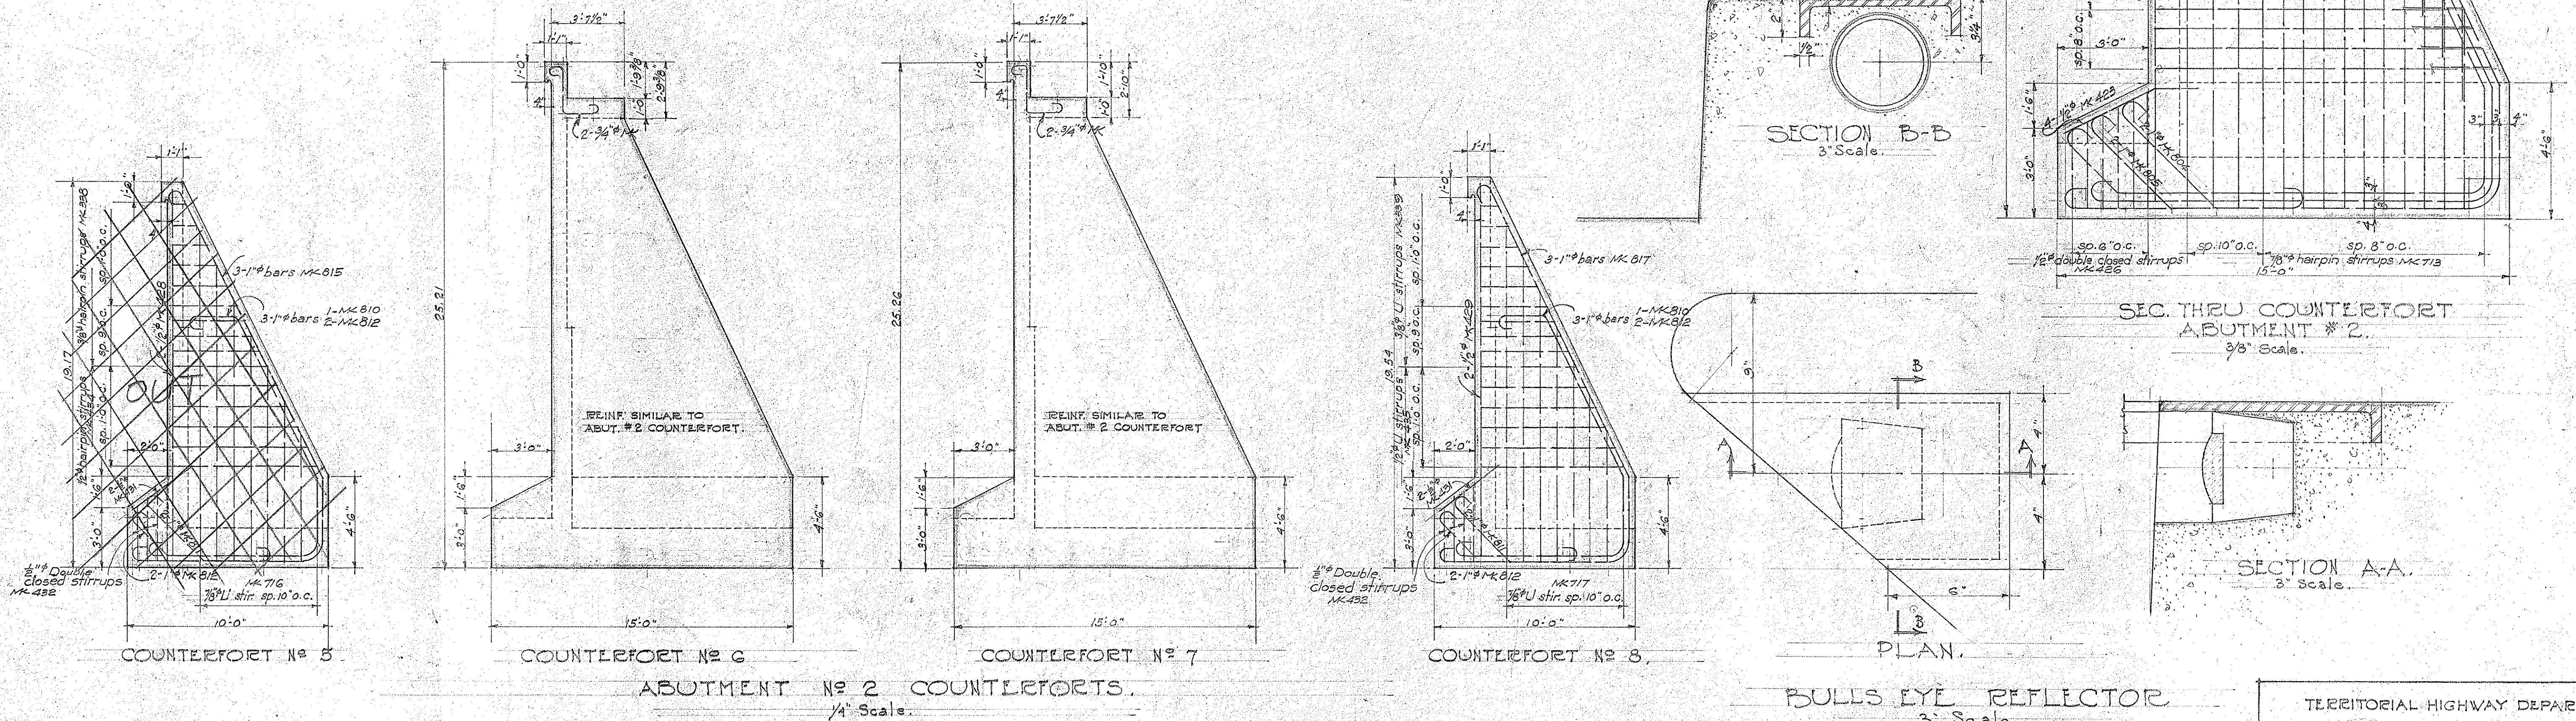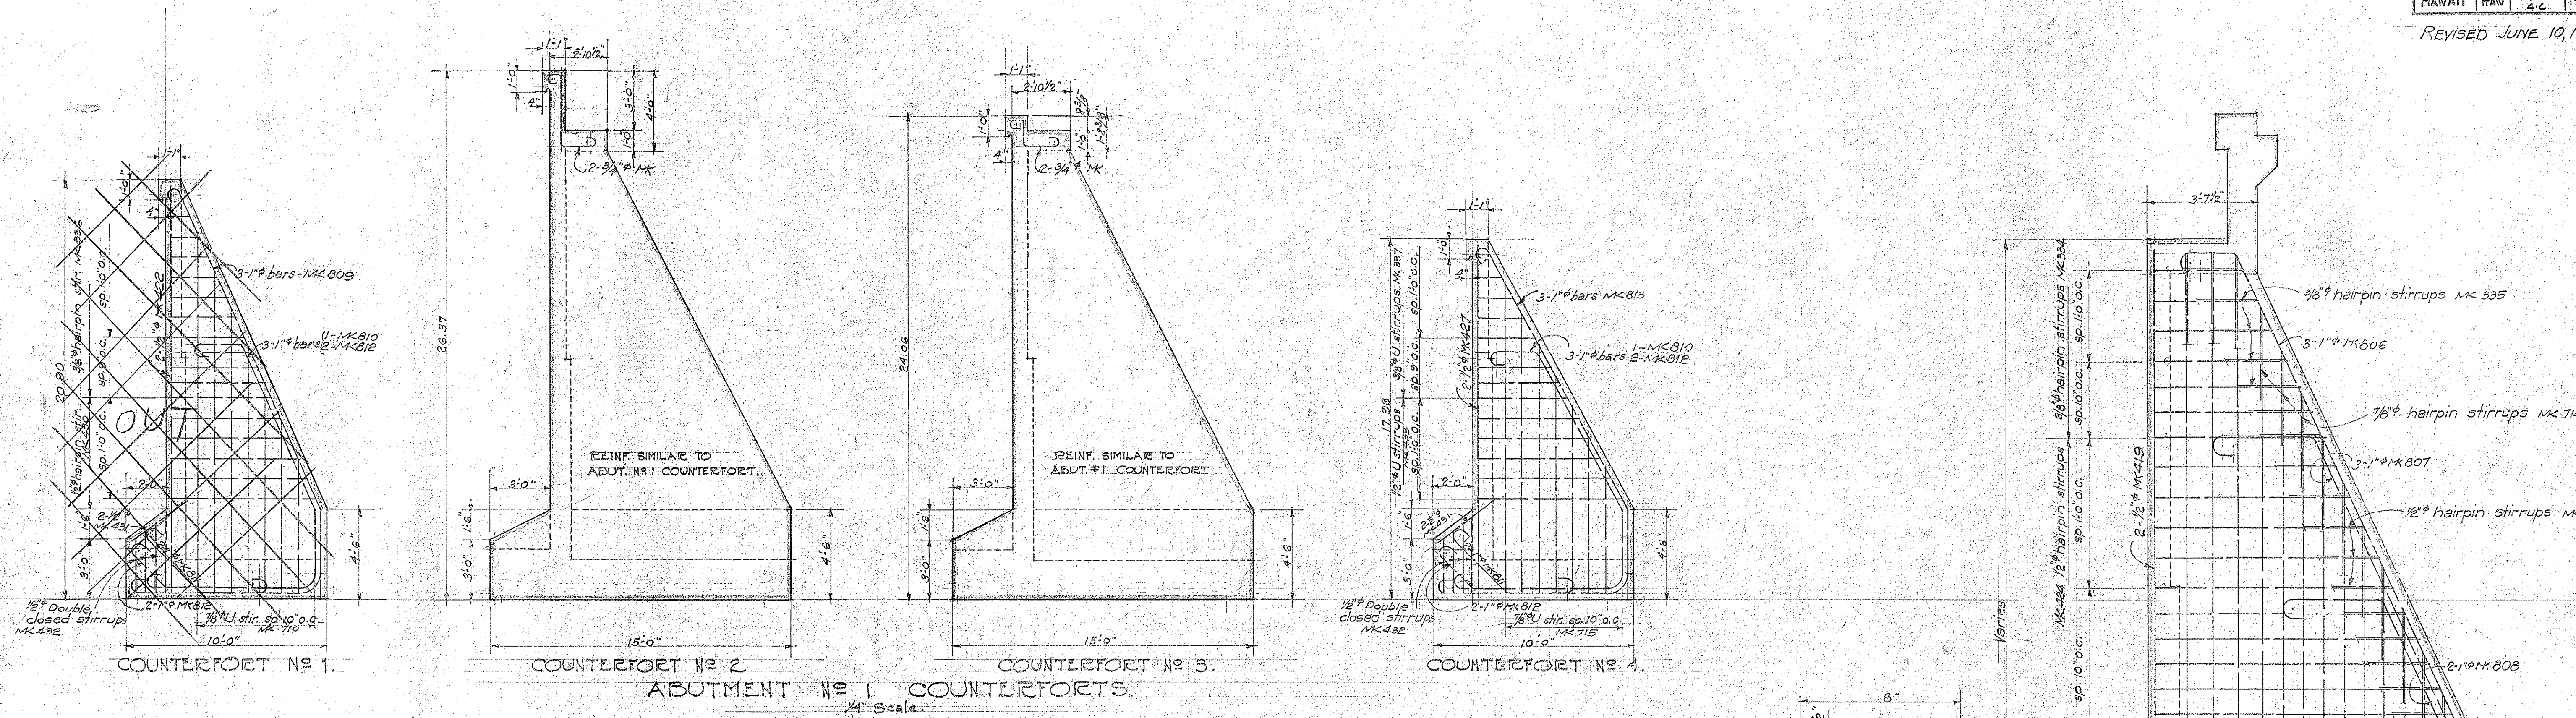

BULLS EYE REFLECTOR

3" Scale.

Note: Bulls-eye Reflector to be furnished by Ter. Hy. Dept. and installed by the Contractor. Bronze plates to be furnished by the Contractor.
Material for top plate of Bulls-eye reflector to be of Phosphor Bronze, same as bearing plate material.

TERRITORIAL HIGHWAY DEPARTMENT,
TERRITORY OF HAWAII.

HIGHWAY OVERPASS.

WAIANAE ROAD F.A.G.H. 4-C
DATE FEB. 1938 SCALES AS NOTED.

SHEET NO. 5 OF 7 SHEETS

4450.24

REVISION Counterfort #1 & 5 omitted

ORIGINAL	DATE
FLAN	JAN. 1938
DESIGNED BY	W. E. Bartlett
TRACED BY	C. F. M. M. M.
NOTED BY	L. L. M.
CHECKED BY	

FED. ROAD DIST. NO.	STATE	FED. AID PROJ. NO.	FISCAL YEAR	SHEET NO.	TOTAL SHEETS
HAWAII	HAW	4-C	1938	76	40

SECTION Y-Y.
3/8" Scale.

PLAN - LEFT SIDE OF ABUT. NO. 2.
3/8" Scale.

PLAN - RIGHT SIDE OF ABUT. NO. 2.
3/8" Scale.

PLAN - LEFT SIDE OF ABUT. NO. 1.
3/8" Scale.

PLAN - RIGHT SIDE OF ABUT. NO. 1.
3/8" Scale.

SLAB REINF. LAYOUT.
3/8" Scale.

NORMAL SEC. SHOWING SLAB REINF.
3/8" Scale.

CROSS BEAM REINF.
3/8" Scale.

SECTION THRU CROSS-BEAM.
3/8" Scale.

SECTION J-J. OMITTING END POST.
3/8" Scale.

SECTION K-K. OMITTING END POST.
3/8" Scale.

SEC. SHOWING STUB BARS.
3/8" Scale.

SECTION X-X.
3/8" Scale.

TERRITORIAL HIGHWAY DEPARTMENT.
TERRITORY OF HAWAII.

HIGHWAY OVERPASS

WAIANAE ROAD TAG. H. 4-C.
DATE FEB. 1938 SCALES AS NOTED
SHEET NO. 7 OF 7 SHEETS.

4450.26

DESIGNED BY	DATE
W. C. Bartlett	Jan. 1938
CHECKED BY	
C. F. McGee	
NOTED BY	
W. C. Bartlett	
QUANTITIES BY	
CHECKED BY	