


NOTE: All existing buildings, fences and other structures etc. on the % shall be demolished and removed by the contractor and disposed of as directed under the item "Clearing and Grubbing" unless removed by their owners.

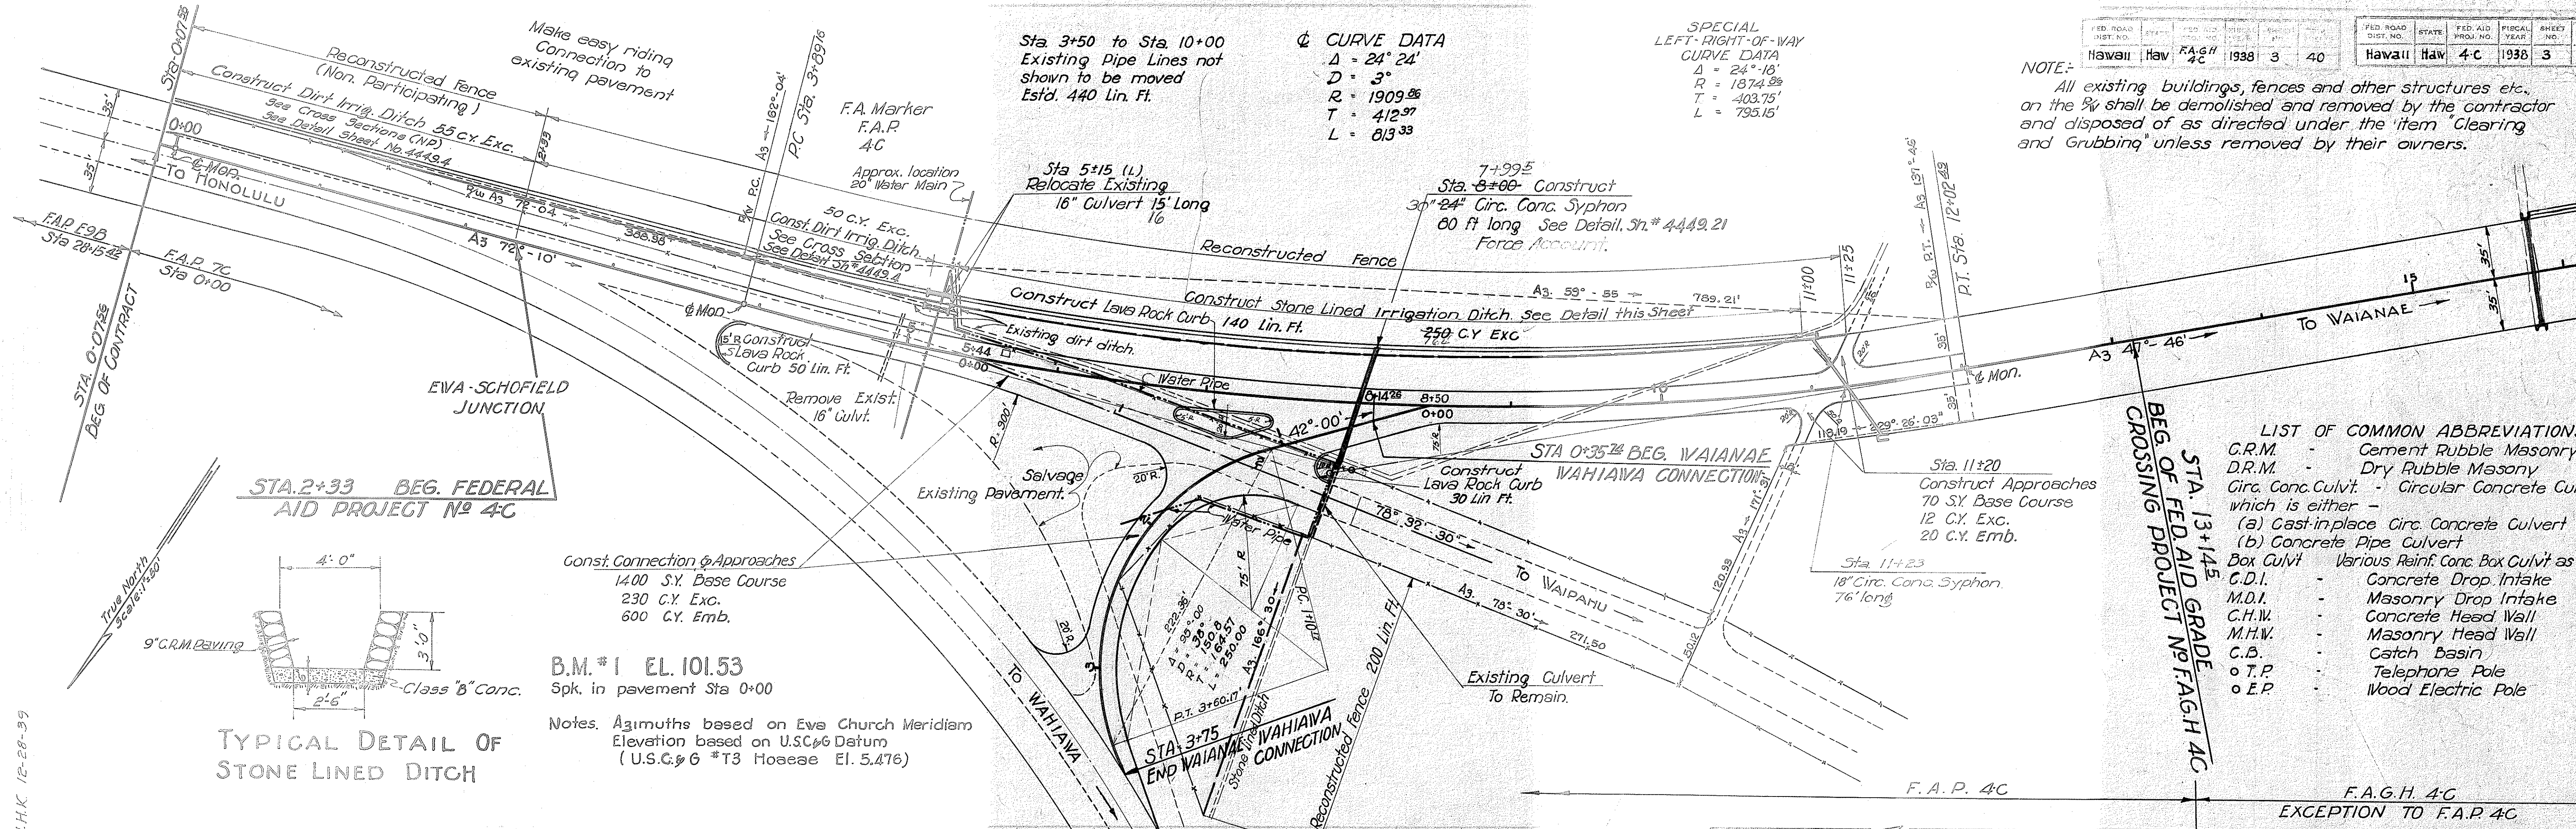





Q CURVE DATA

$\Delta = 24^\circ 24'$
 $D = 3^\circ$
 $R = 1909.86$
 $T = 412.97$
 $L = 813.33$

SPECIAL LEFT-RIGHT-OF-WAY CURVE DATA

$\Delta = 24^\circ 18'$
 $R = 1874.88$
 $T = 403.75'$
 $L = 795.15'$

- LIST OF COMMON ABBREVIATIONS**
- C.R.M. - Cement Rubble Masonry
 - D.R.M. - Dry Rubble Masonry
 - Circ. Conc. Culvert - Circular Concrete Culvert which is either -
 - (a) Cast-in-place Circ. Concrete Culvert or
 - (b) Concrete Pipe Culvert
 - Box Culvert - Various Reinf. Conc. Box Culvert as detailed
 - C.D.I. - Concrete Drop Intake
 - M.D.I. - Masonry Drop Intake
 - C.H.W. - Concrete Head Wall
 - M.H.W. - Masonry Head Wall
 - C.B. - Catch Basin
 - T.P. - Telephone Pole
 - E.P. - Wood Electric Pole

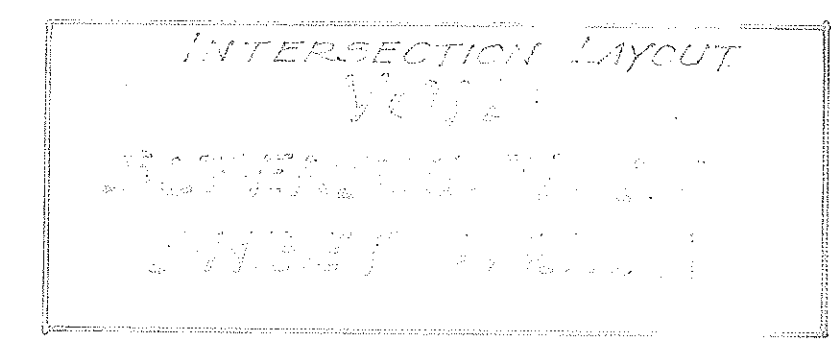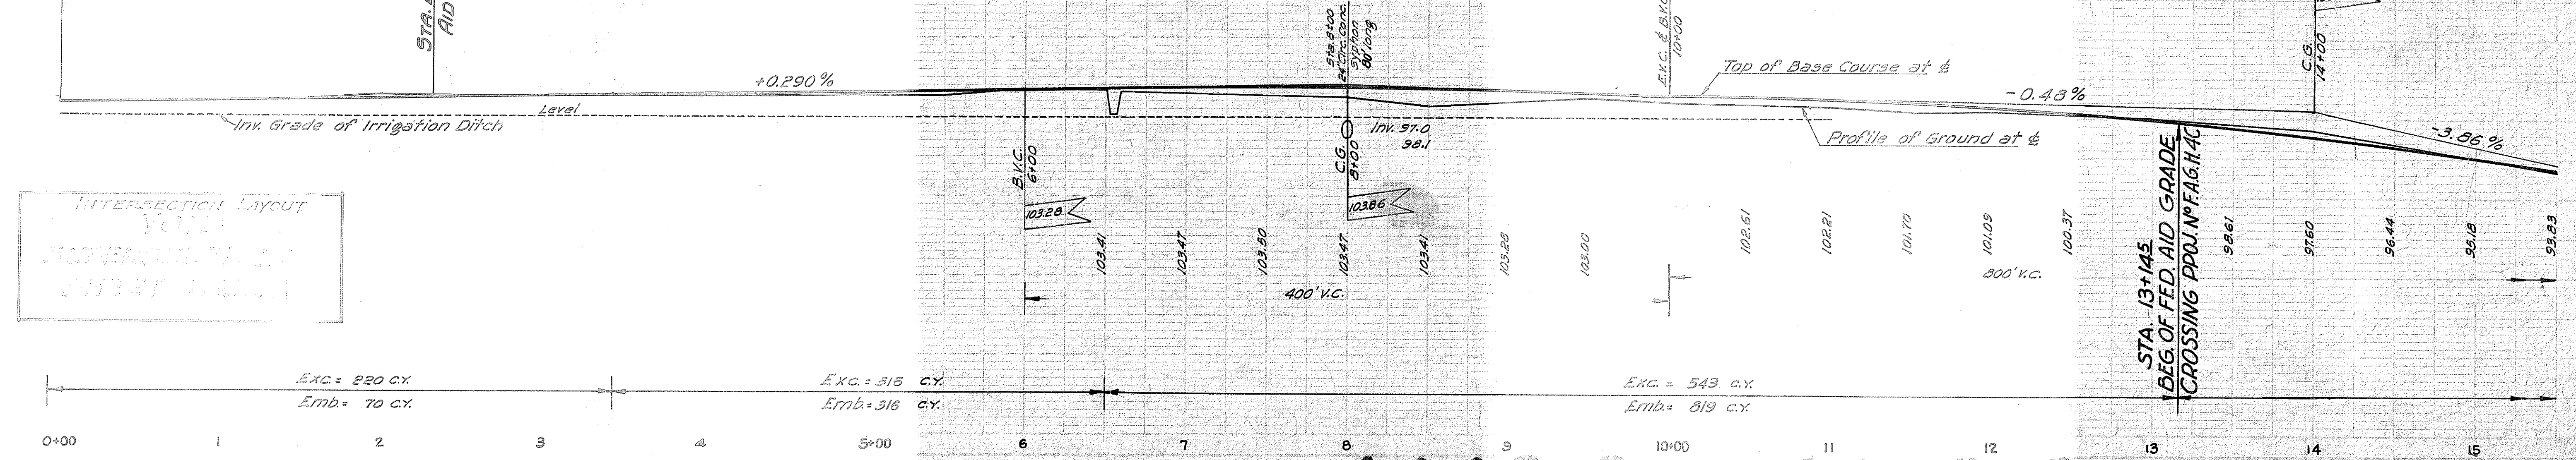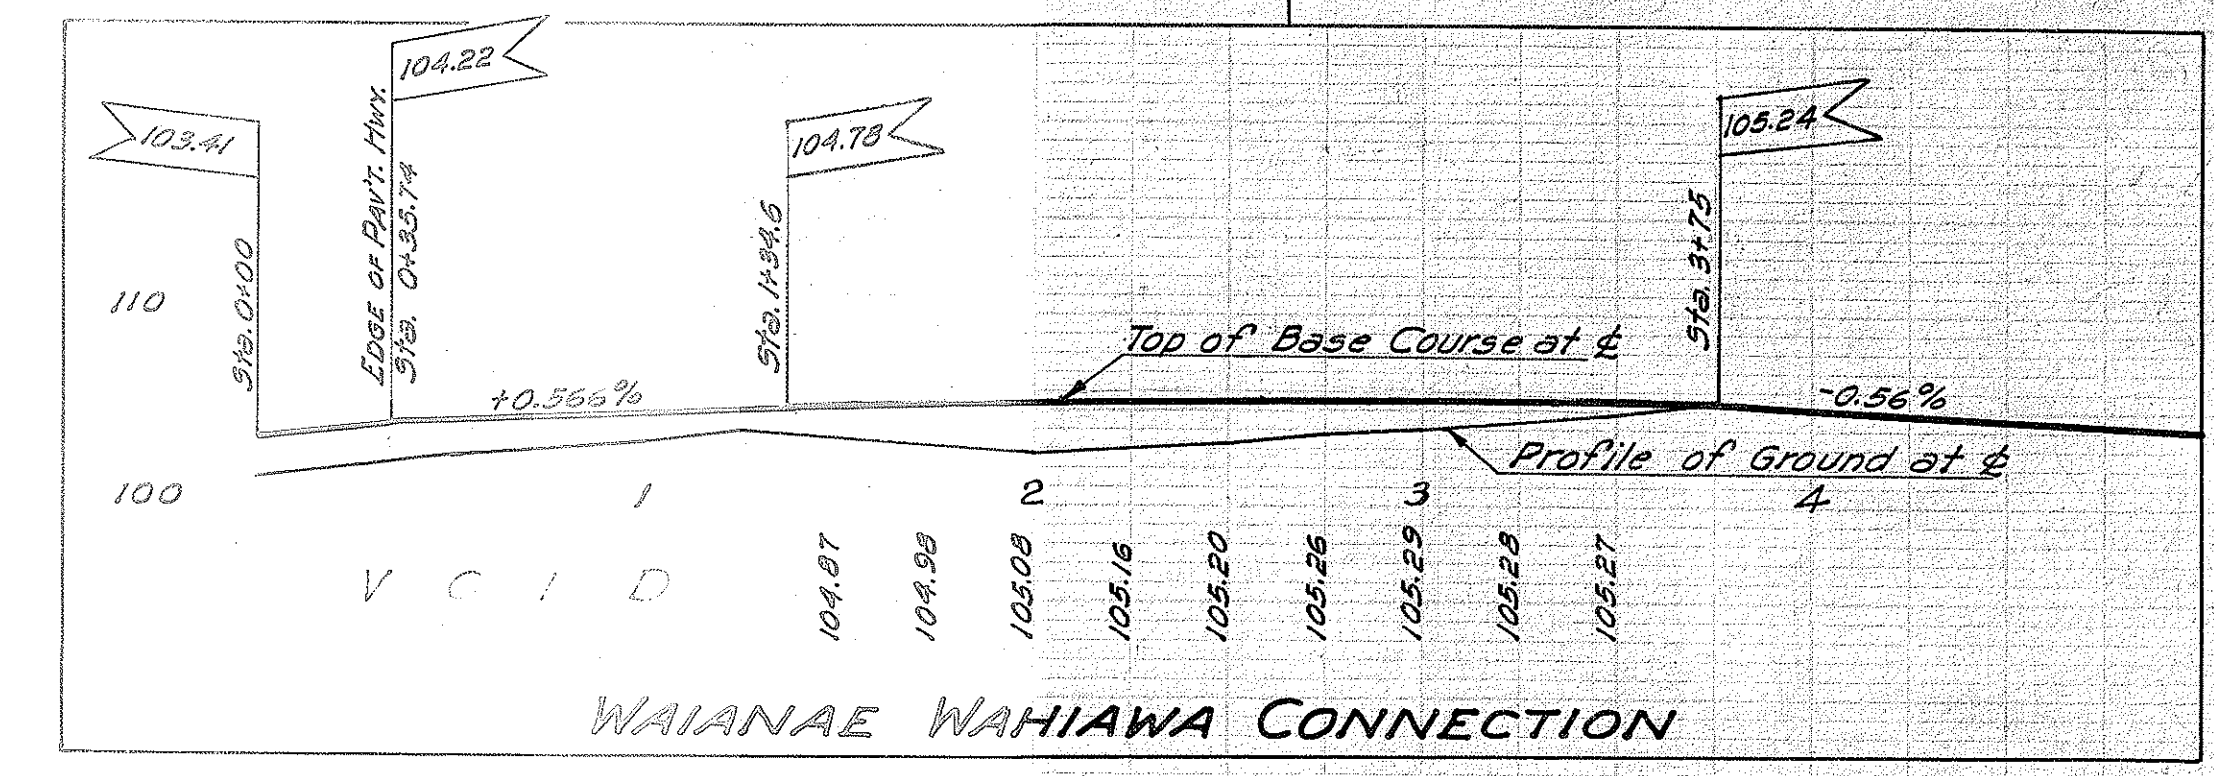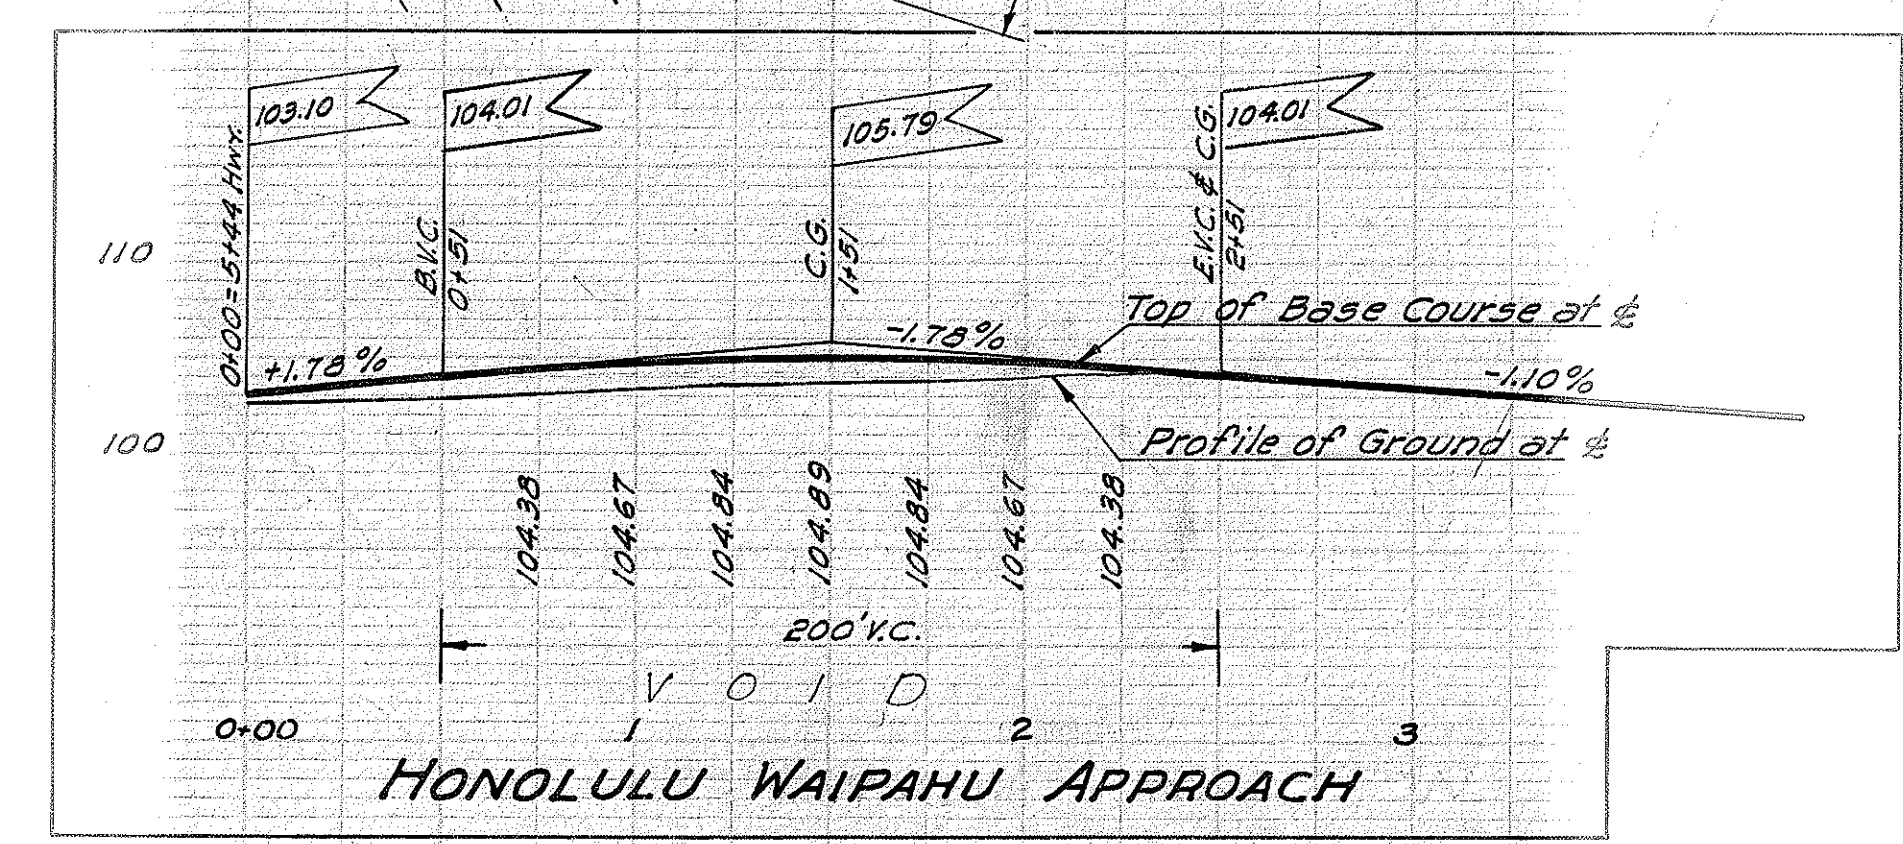


Corrections: H.H.K. 12-28-39

J.L.P. 8-36 11-37


DATE	0-26	11-37
DESIGNED	J.L.P.	
CHECKED		
NOTED		
NO.		

DATE	0-26	11-37
DESIGNED	J.L.P.	
CHECKED		
NOTED		
NO.		

STATE	FED. AID	FISCAL	SHEET	TOTAL
HAWAII	HAW	F.A.G.H. 4-C	1938	4
				40

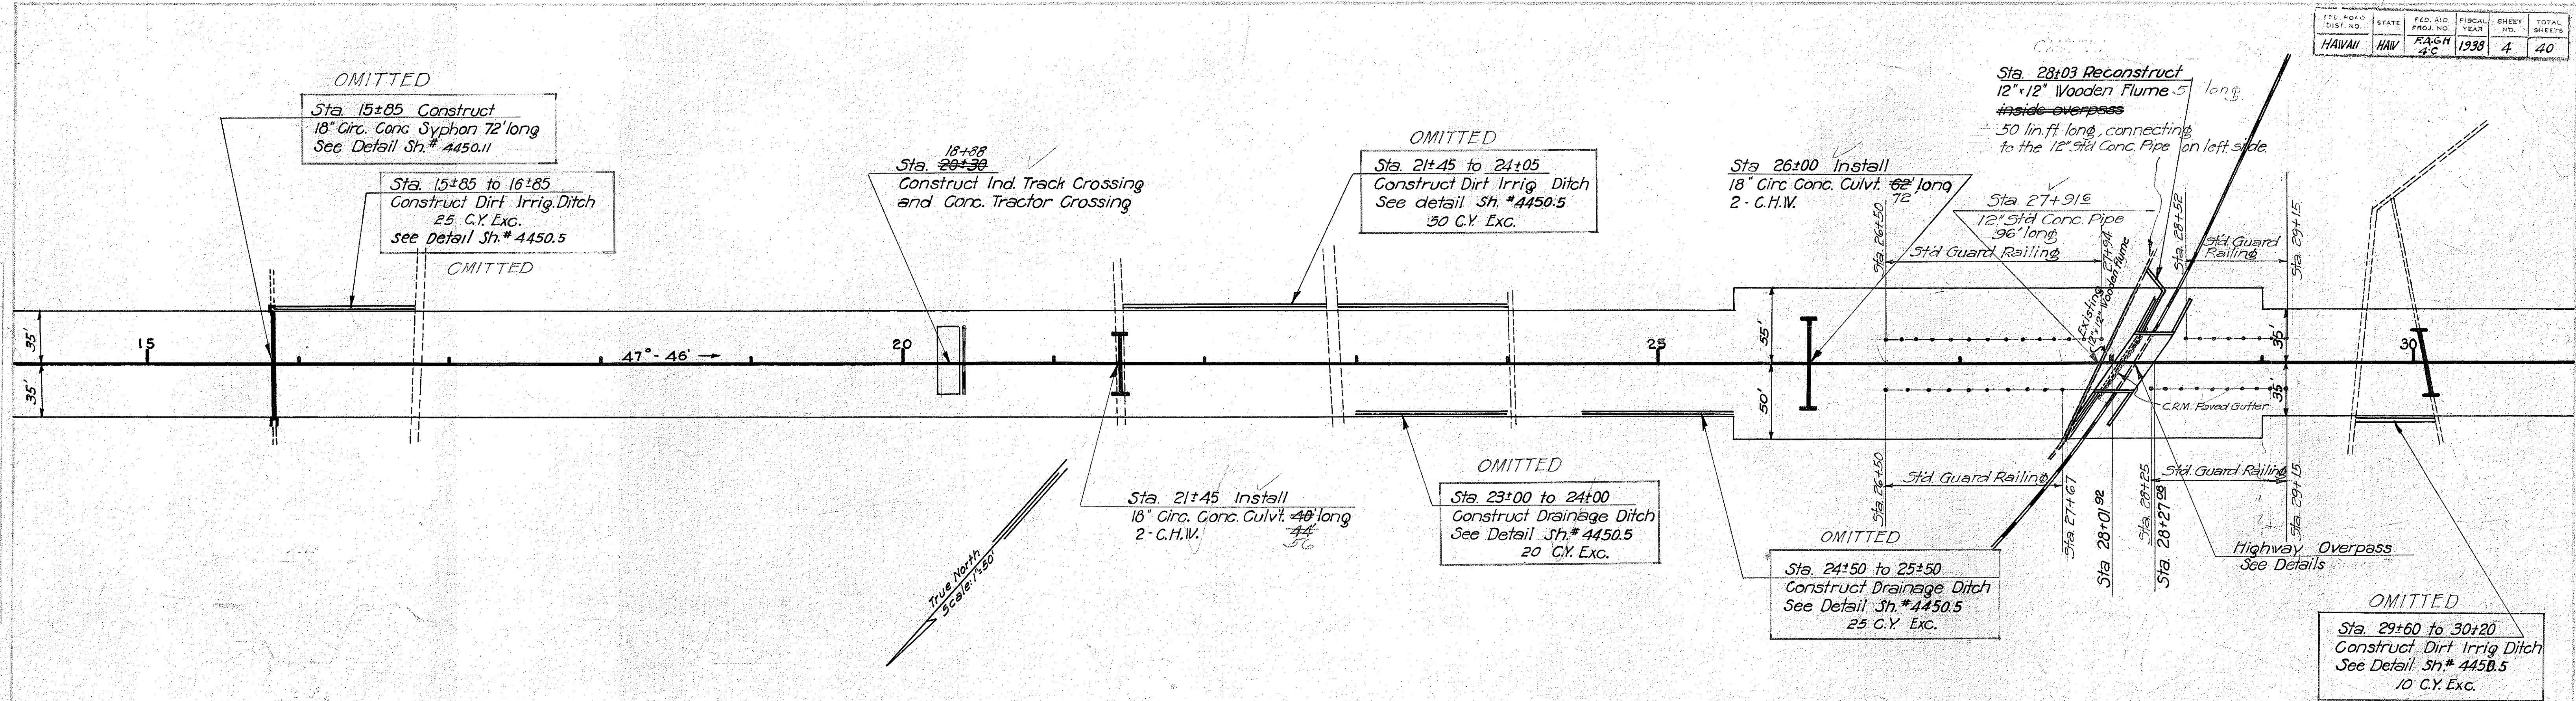



F.A.G.H. 4-C
EXCEPTION TO F.A.P. 4-C

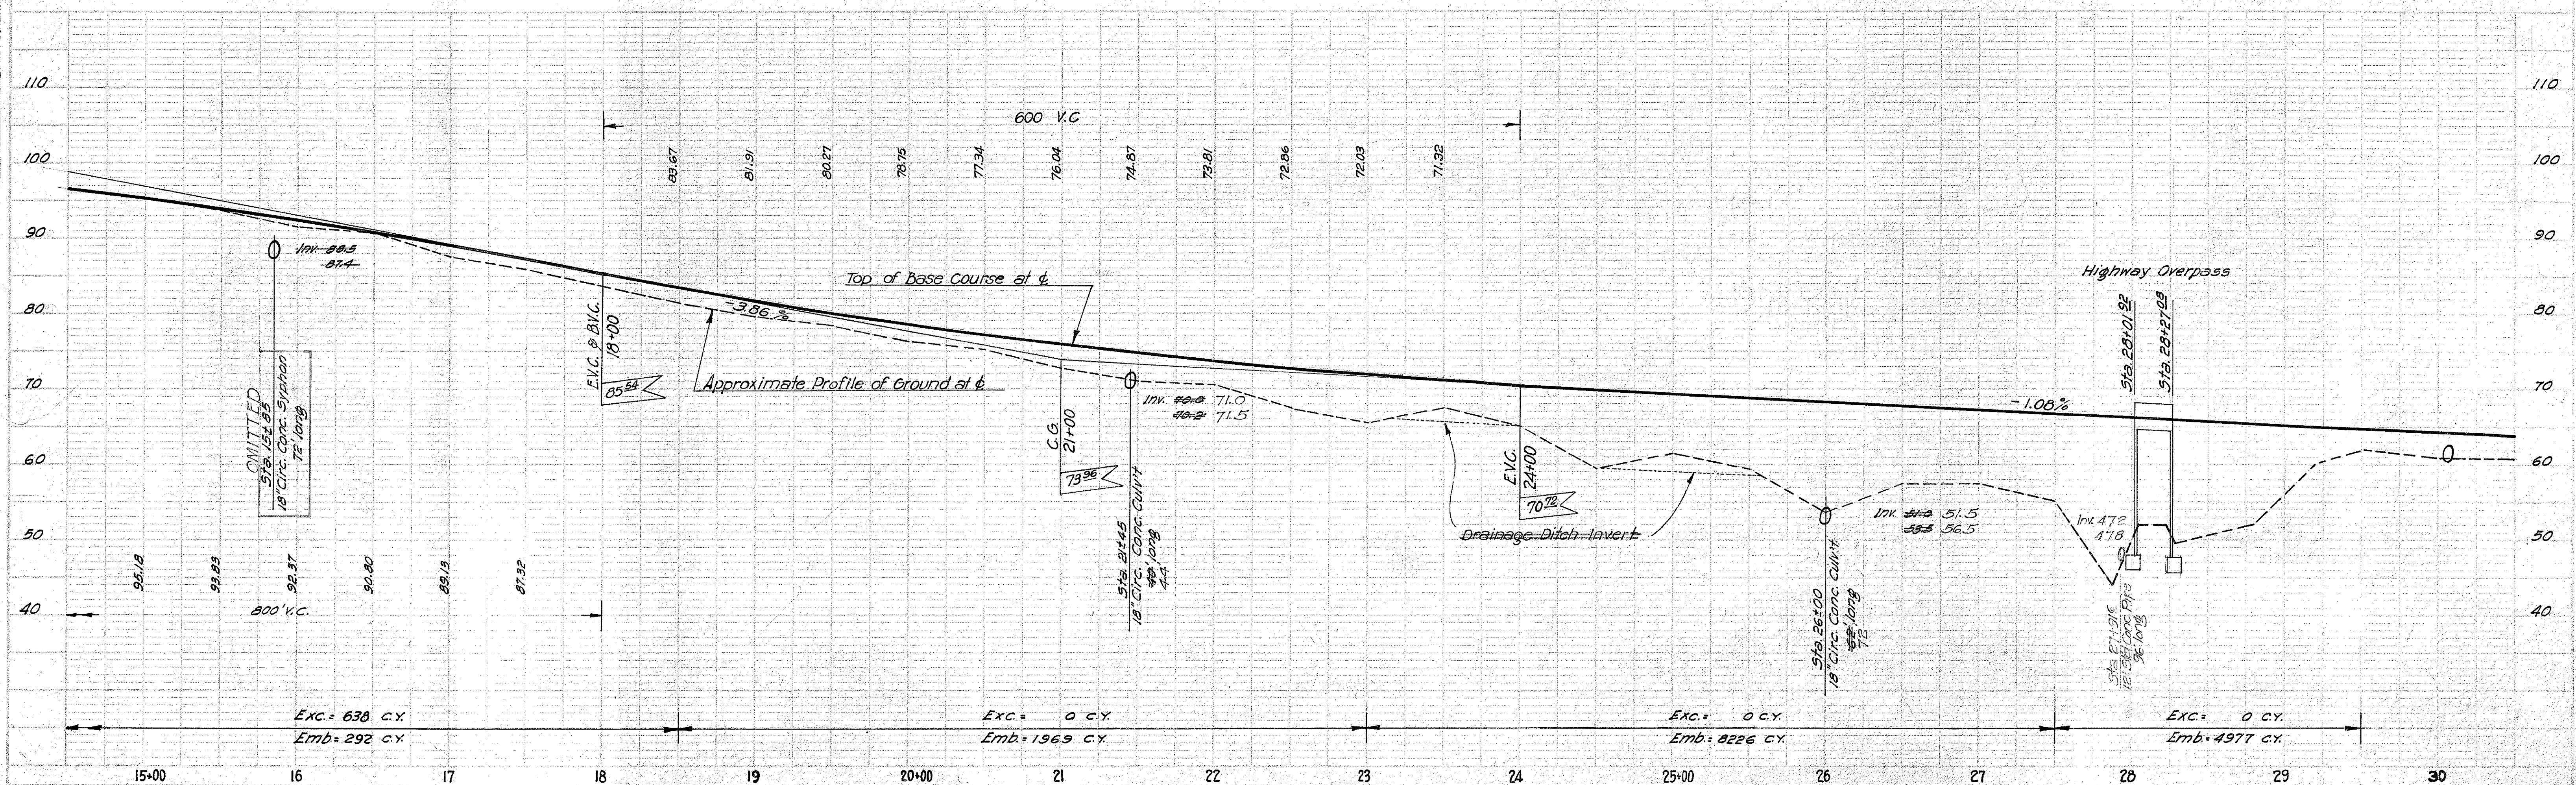

4450.4



PLAN	SURVEYED	DATE
NO.	BY	
	NOTED	
	ALIGNED	
	CHECKED	
	RT. OF WAY	

PROFILE	SURVEYED	DATE
NO.	BY	
	NOTED	
	ALIGNED	
	CHECKED	
	STRUCTURE NOTING	

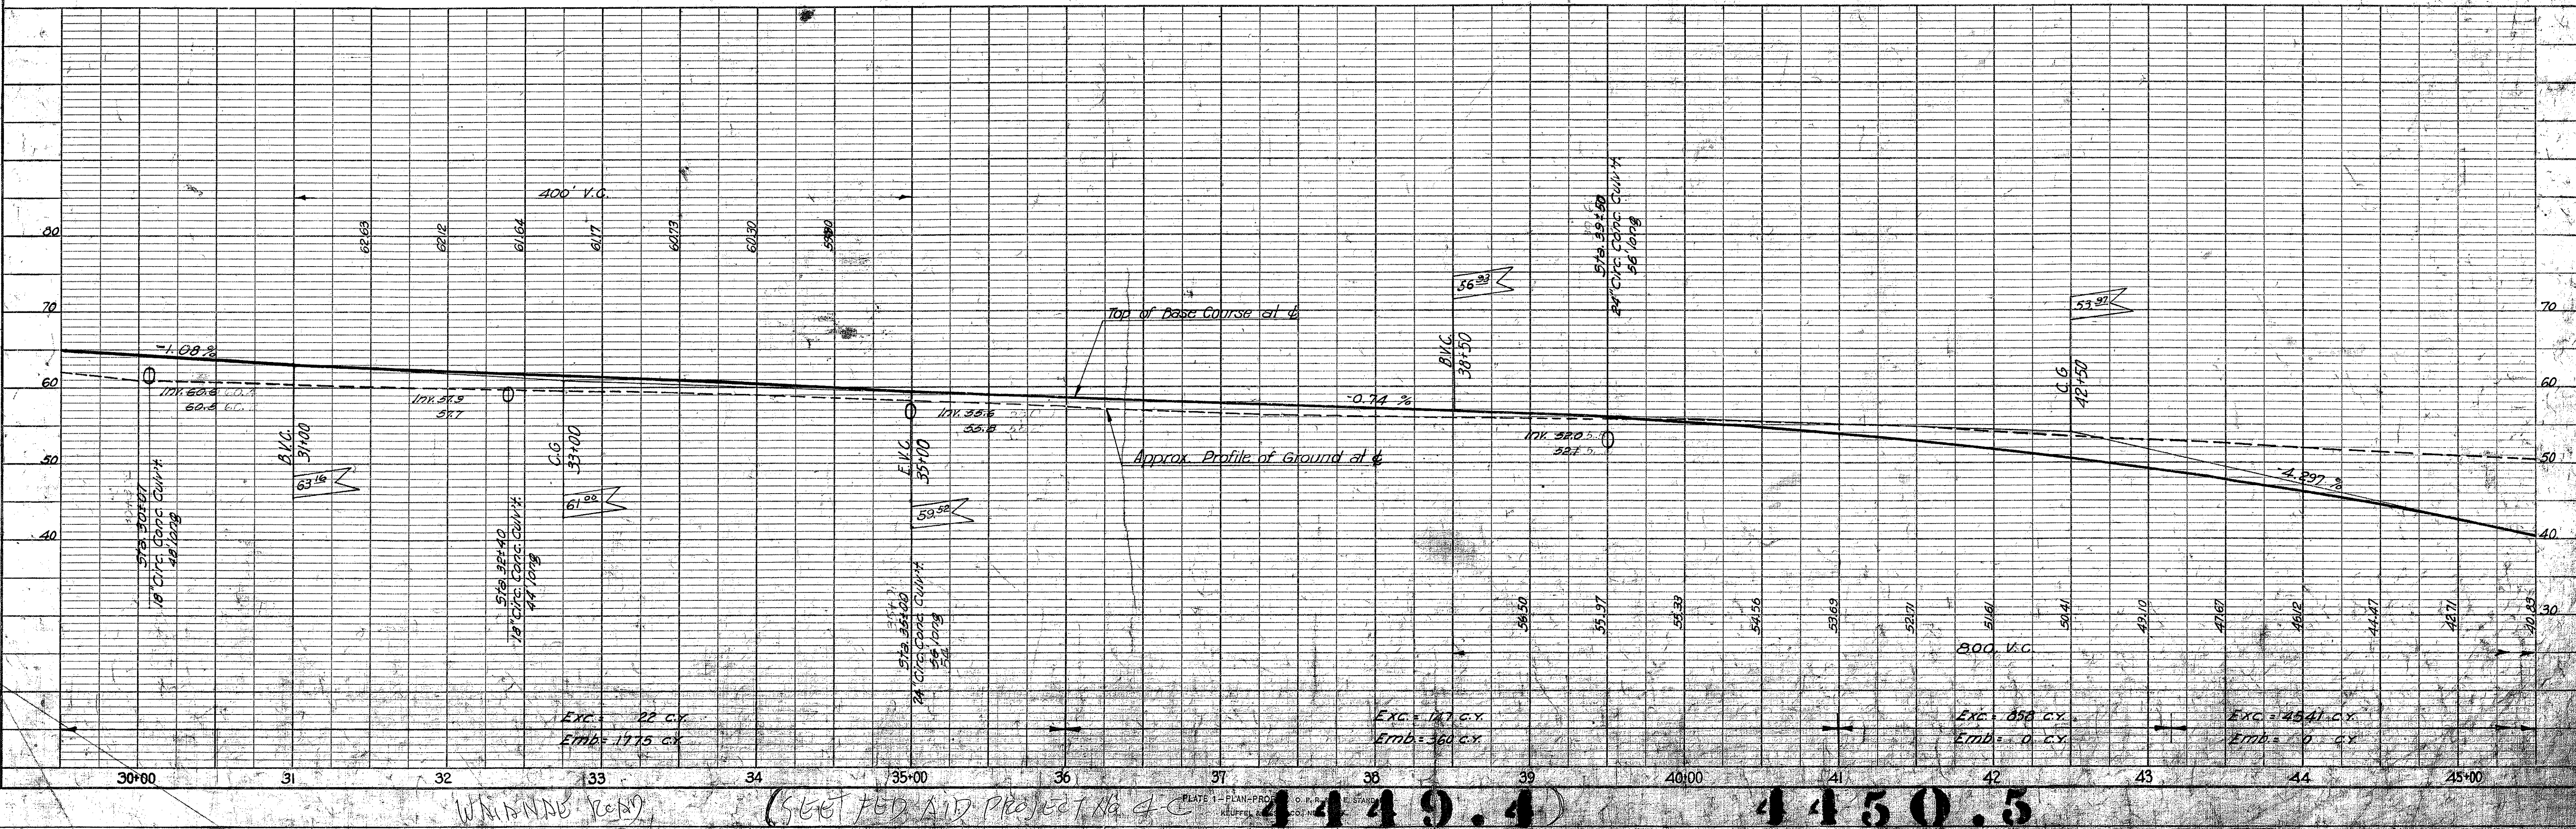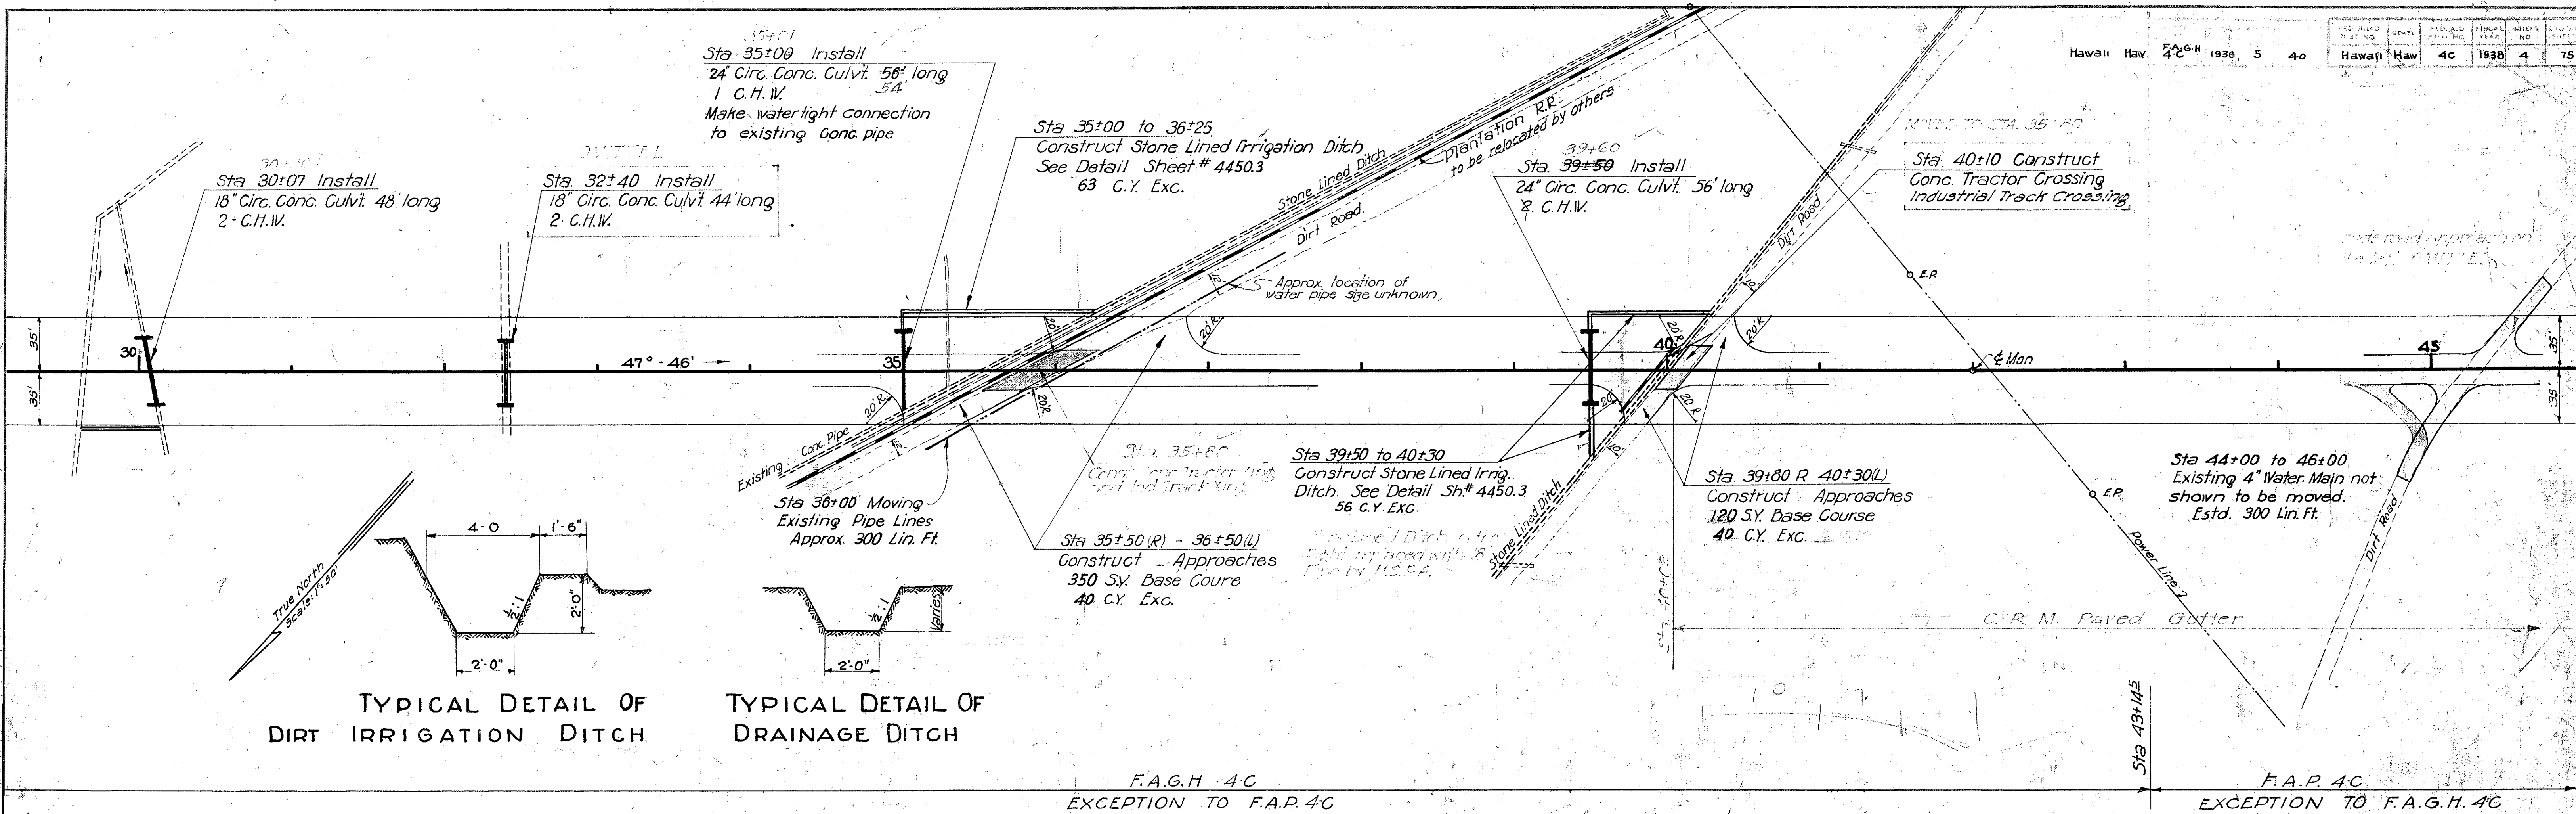

DATE	7-27
BY	J.L.P.
SURVISED	
PLANNED	
NOTE BOOK	
NO.	

DATE	7-27
BY	J.L.P.
SURVISED	
PLANNED	
NOTE BOOK	
NO.	

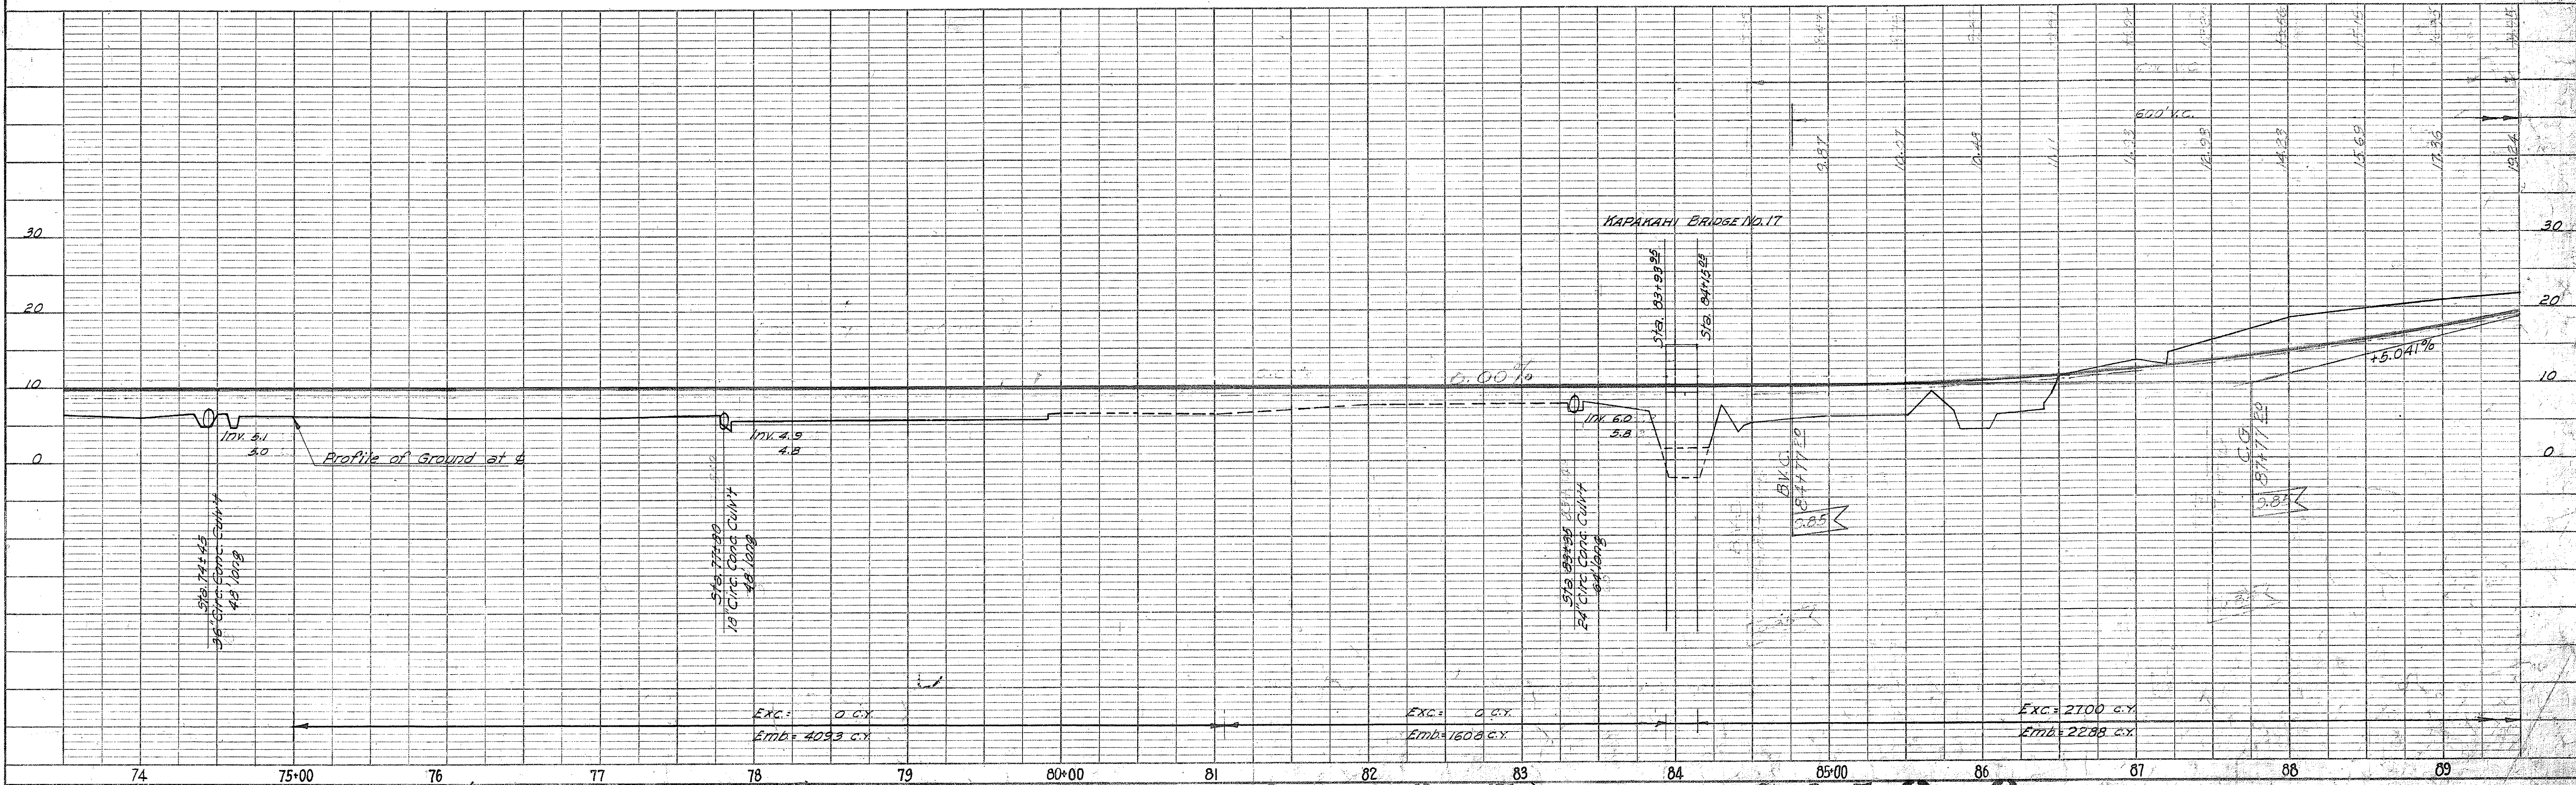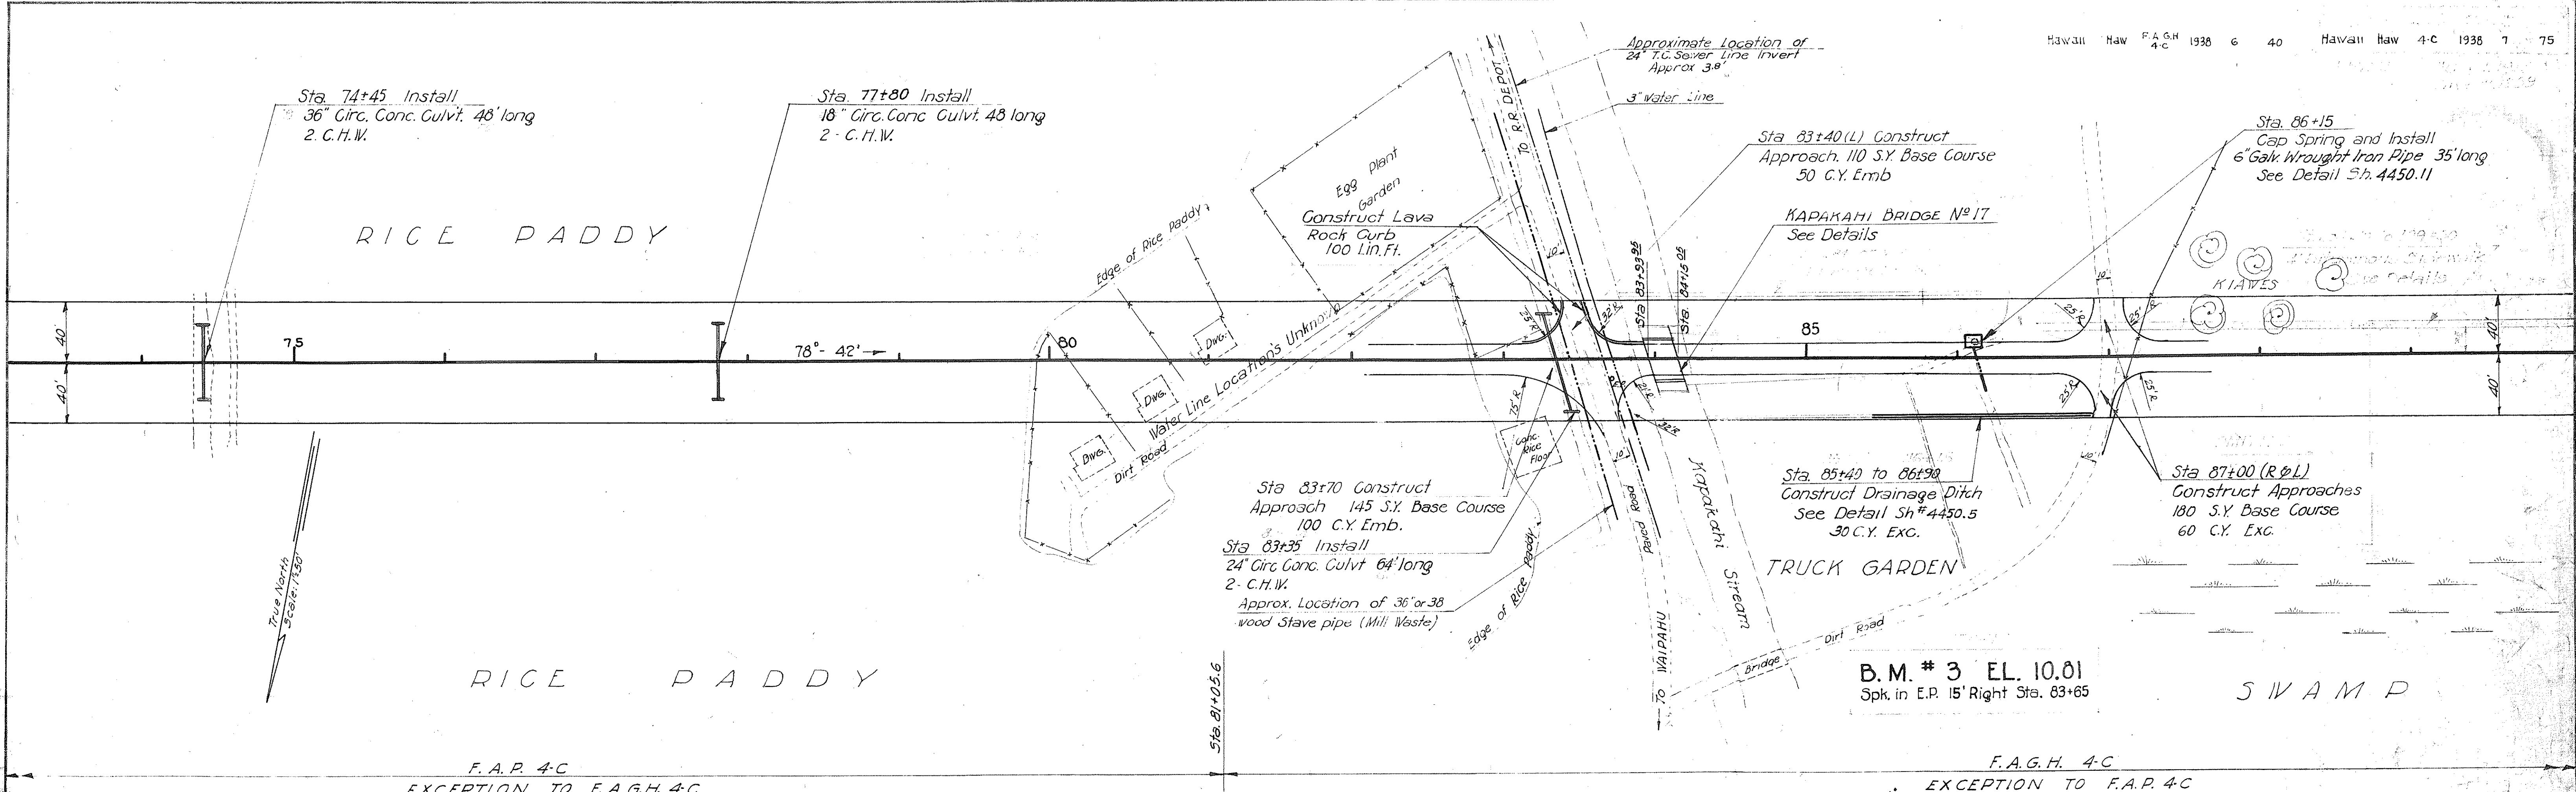


WIANAPPE ROAD (SEE PROJECT NO. 4-C)

PLATE 1 - PLAN-PROFILE OF ROAD

4450.6

PROFILE	SURVEYED	BY	DATE
NOTE BOOK	PLOTTED	J. L. P	8 - 26
NO.	GRACES CHECKED	"	11 - 27
	6. M & NOTED		
	STRUCTURE NOTATIONS CHKD.		

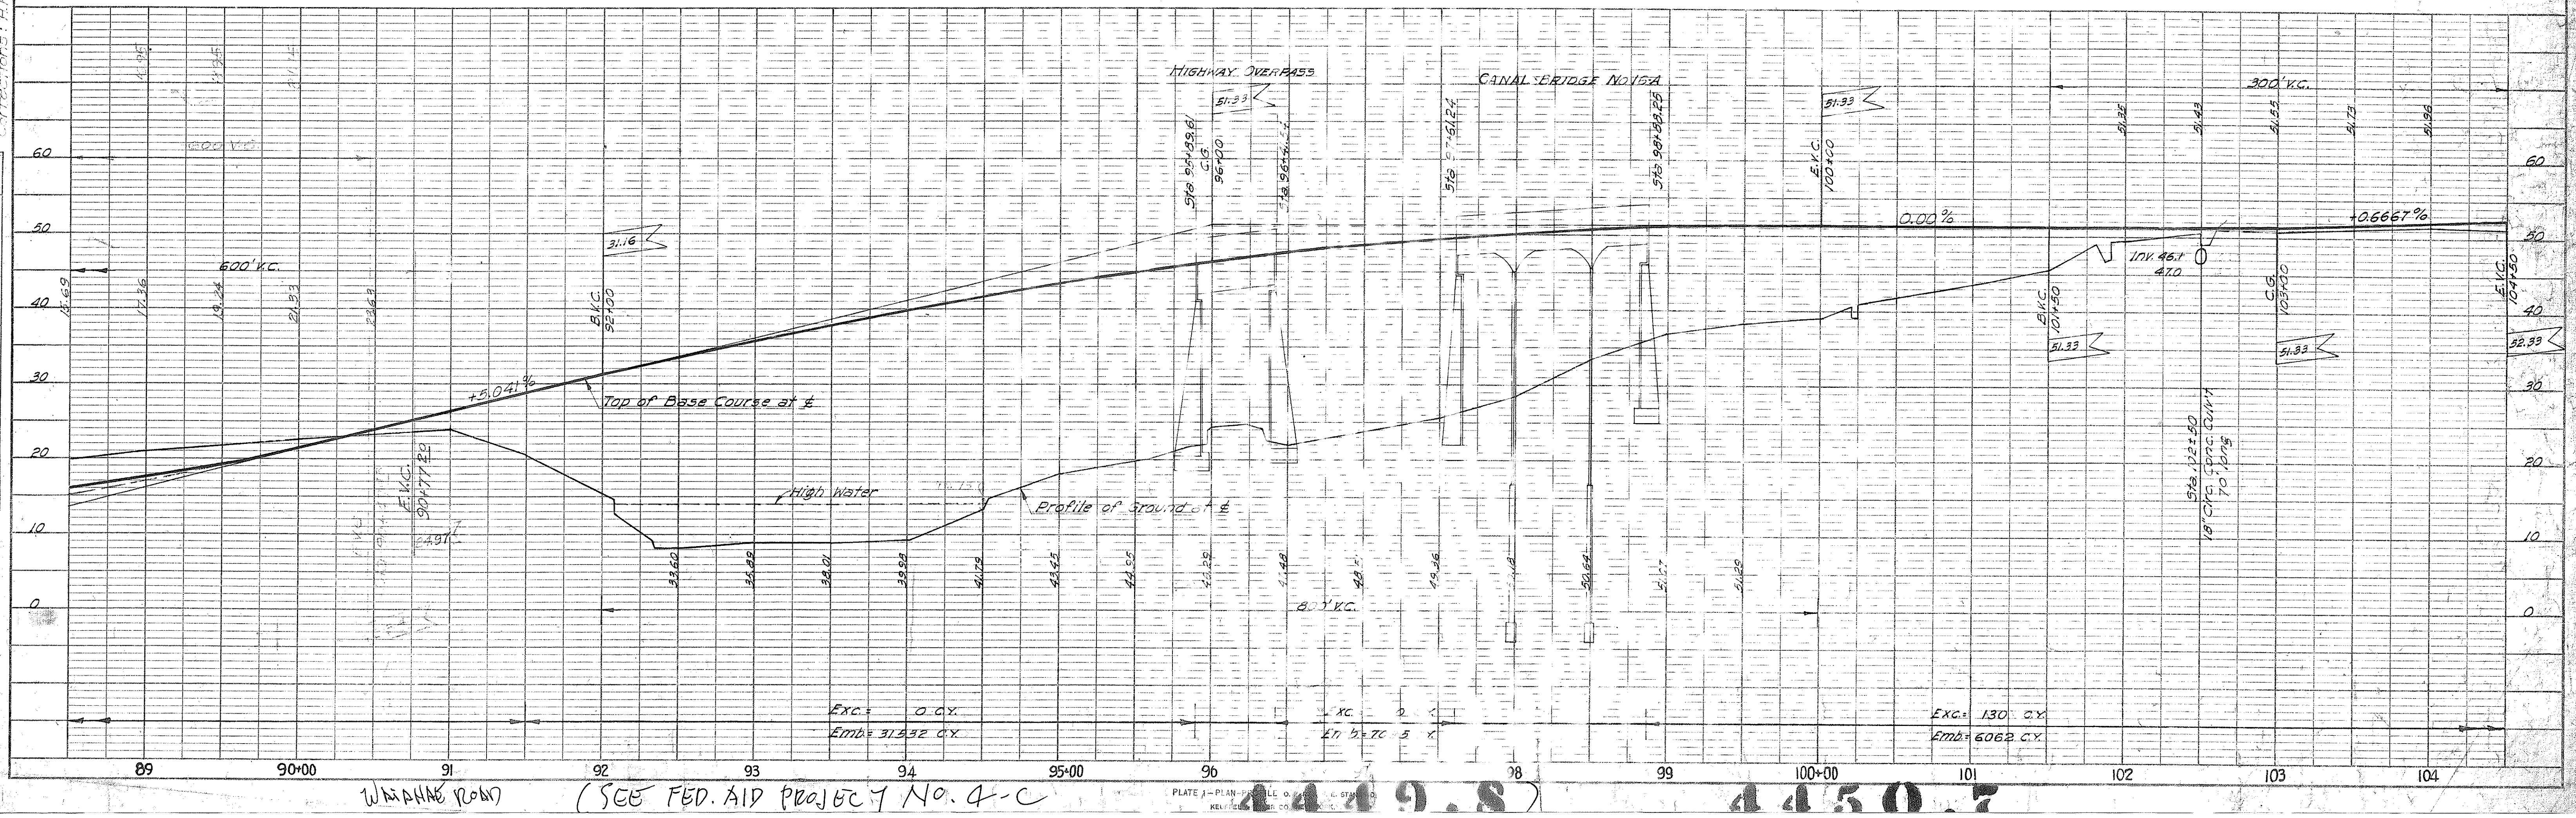

PROFILE		BY	DATE
SURVEYED			6-26
PLOTTED		6	11-27
NOTE BOOK	GRADES CHECKED		
NO.	B. M.'S NOTED		
	STRUCTURE NOTATIONS CHECKED		

