
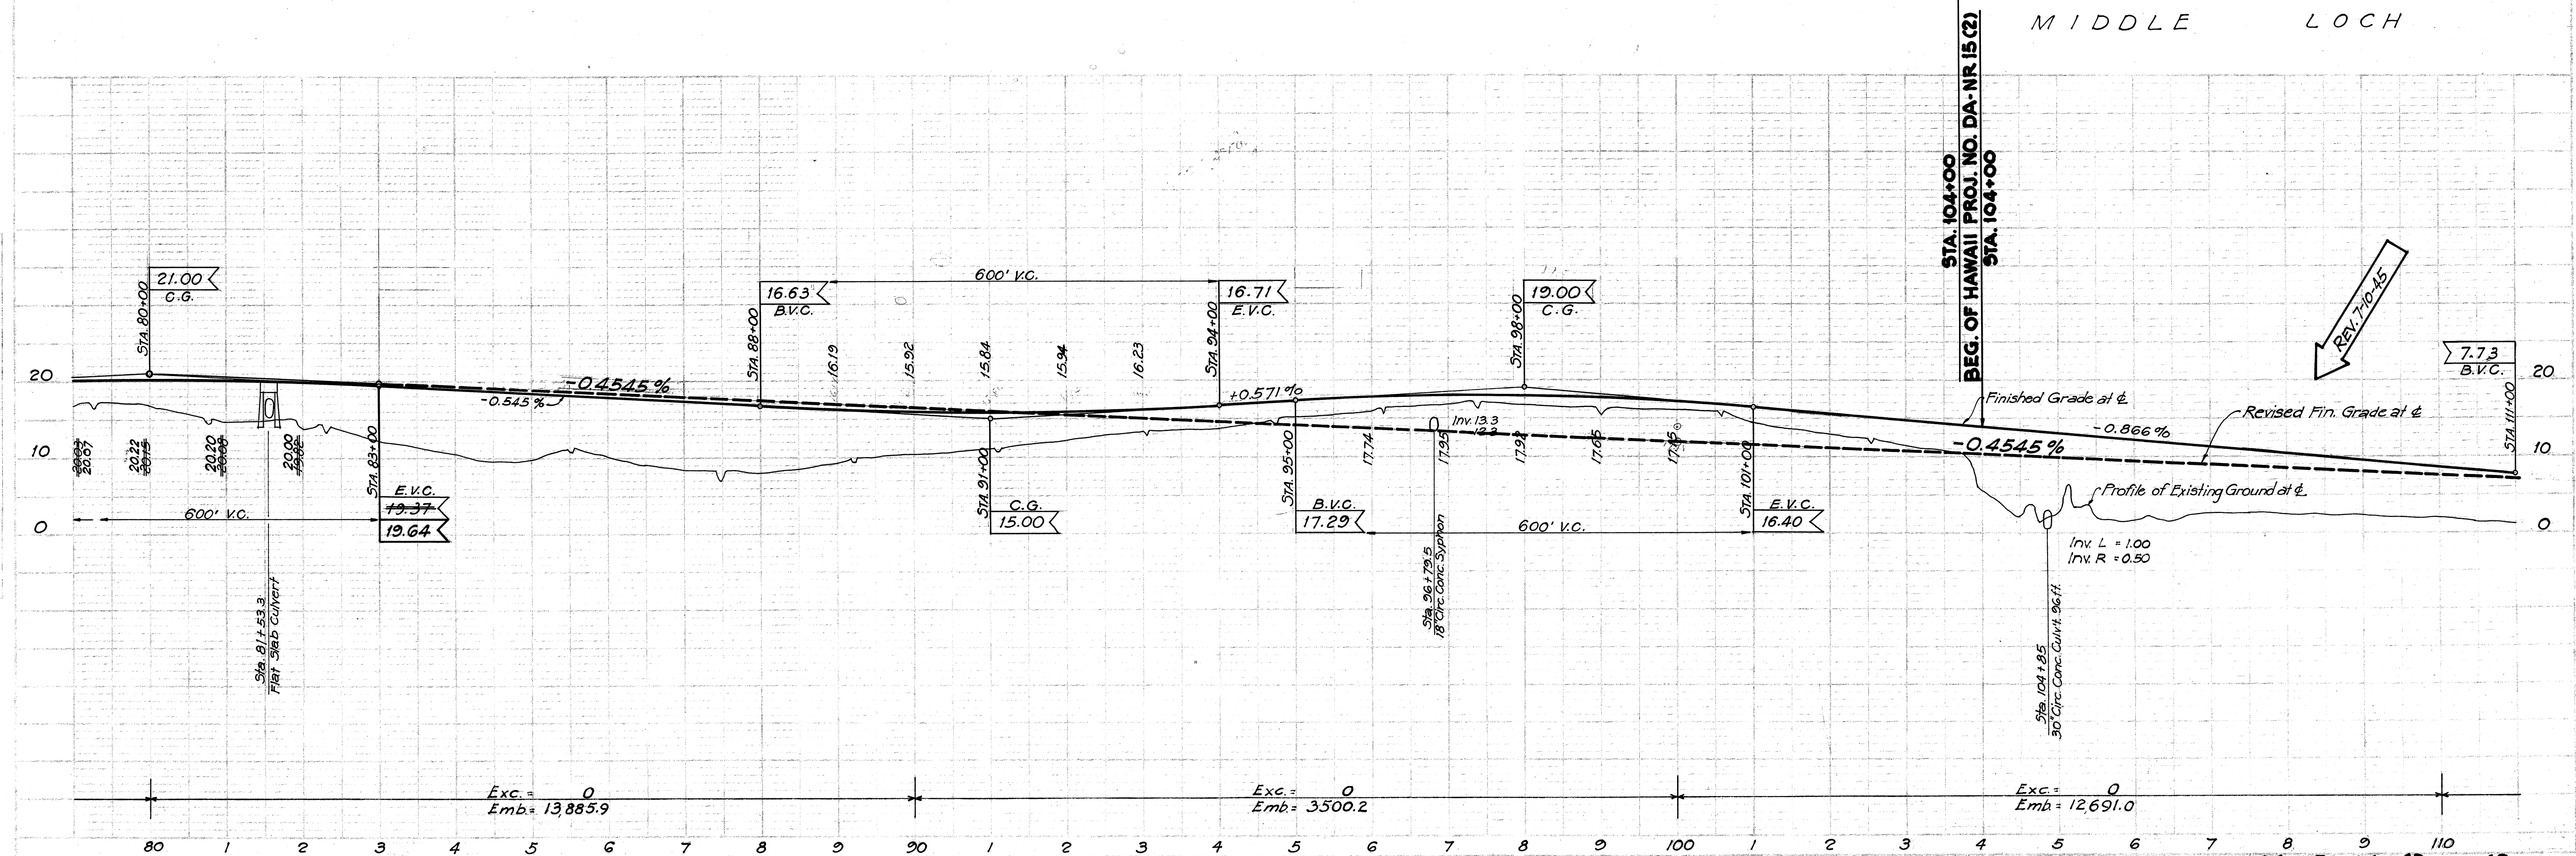


PLAN
 DATE
 BY
 CHECKED
 DESIGNED
 DRAWN
 IN CHARGE

PROFILE
 DATE
 BY
 CHECKED
 DESIGNED
 DRAWN
 IN CHARGE

Rev. July 10, 1945

FED. ROAD DIST. NO.	STATE	FED. AID PROJ. NO.	FISCAL YEAR	SHEET NO.	TOTAL SHEETS
HAWAII	HAW.	DA-NR-154	1945	3	32

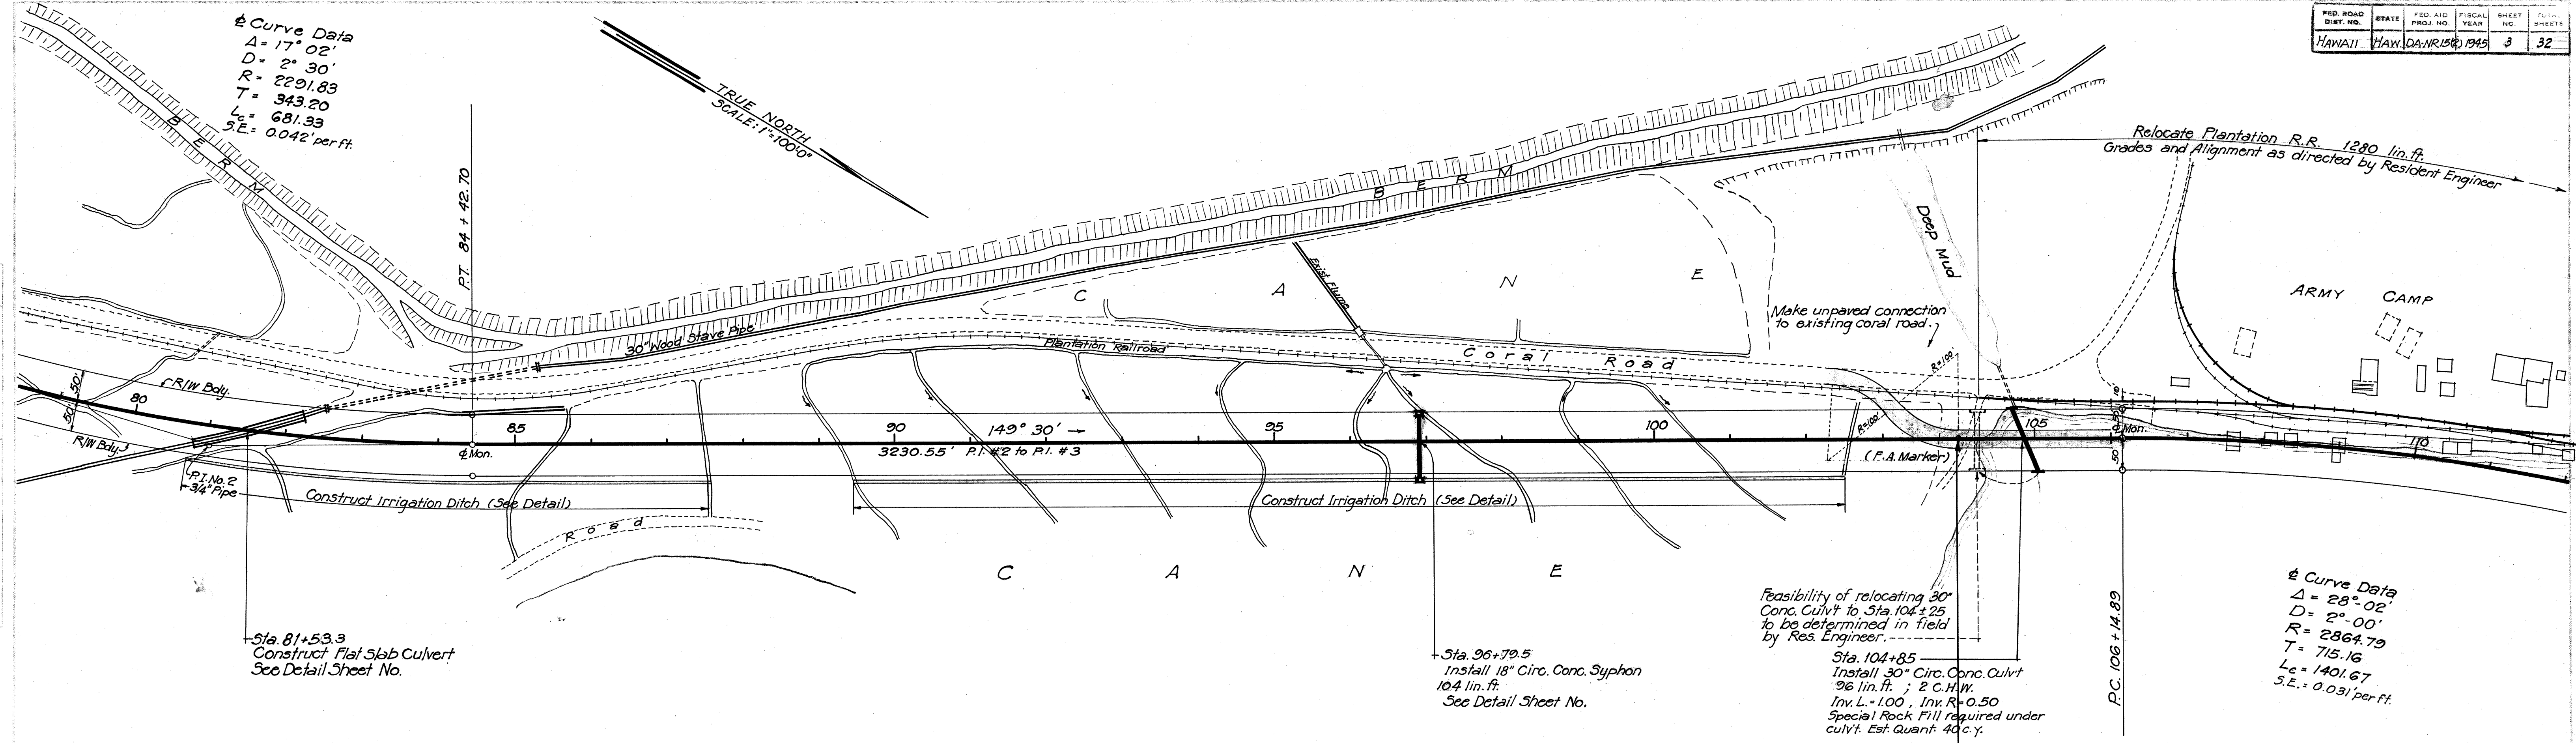


5152.3



PLAN
DATE: 7-10-45
BY: [illegible]
CHECKED: [illegible]
APPROVED: [illegible]

REV. 7-10-45 Grades.

PROFILE
DATE: 7-10-45
BY: [illegible]
CHECKED: [illegible]
APPROVED: [illegible]

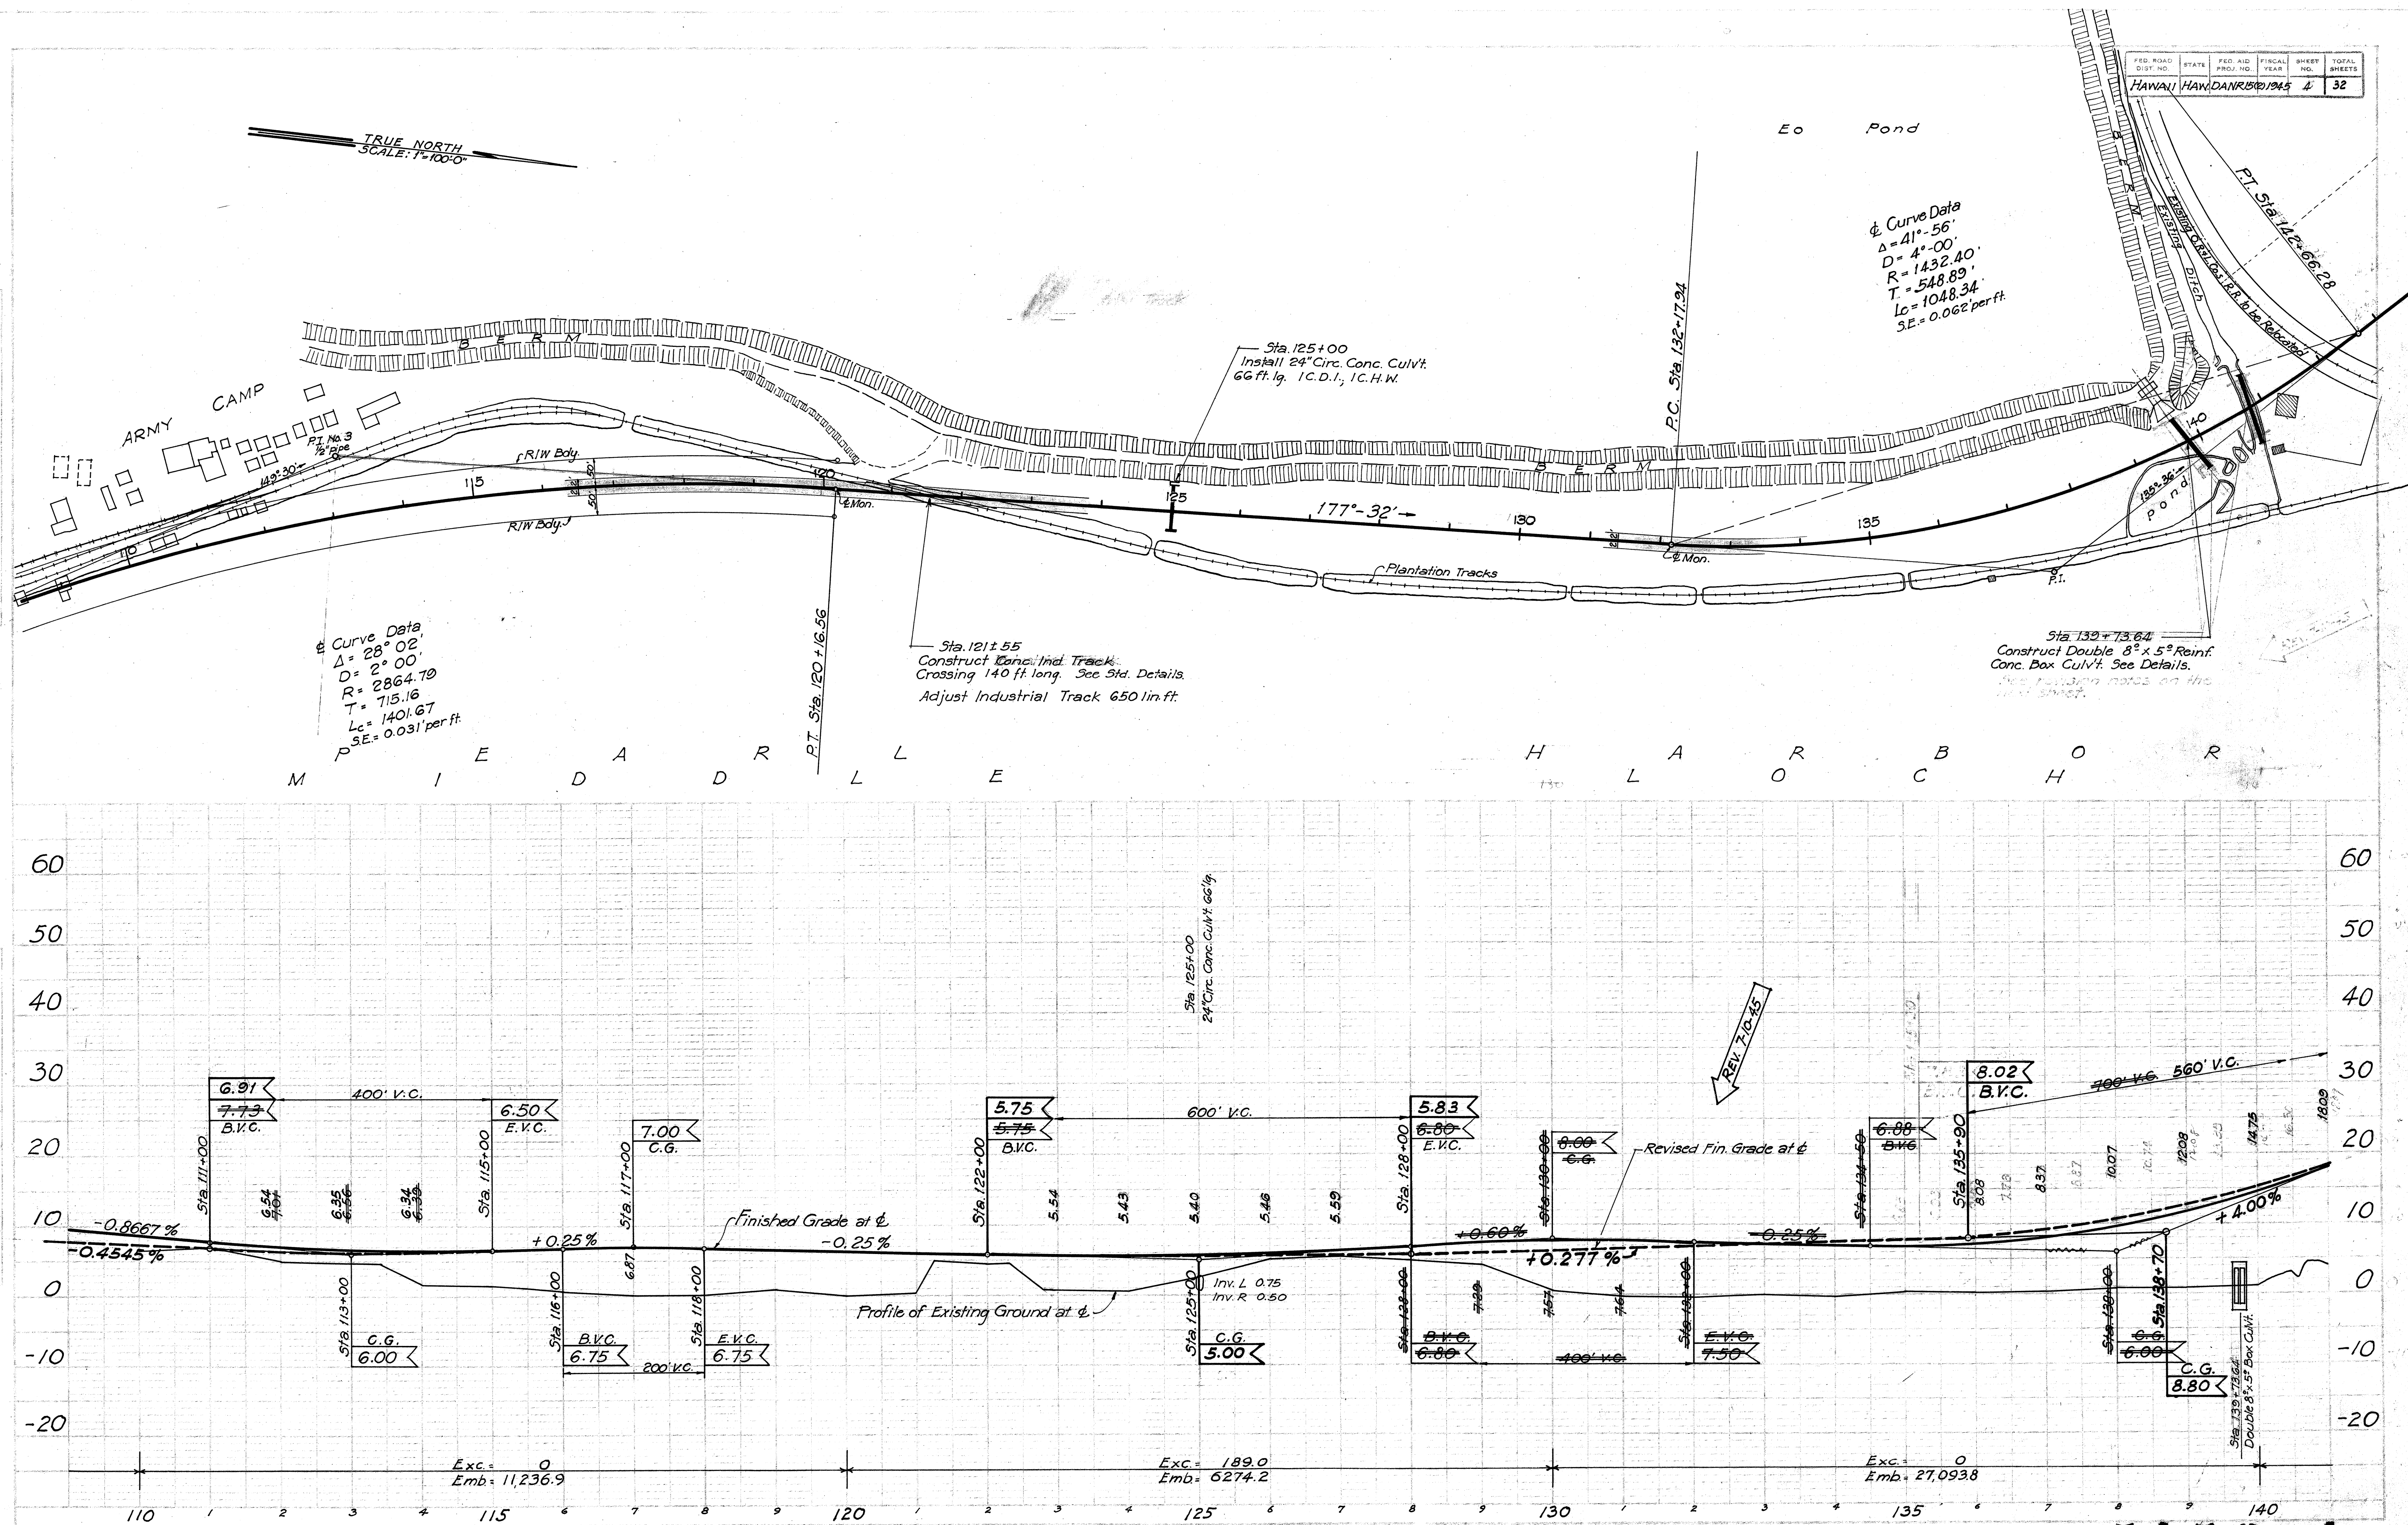

FED. ROAD DIST. NO.	STATE	FED. AID PROJ. NO.	FISCAL YEAR	SHEET NO.	TOTAL SHEETS
HAWAII	HAW.	DA-NR 15(2)	1946	5	32

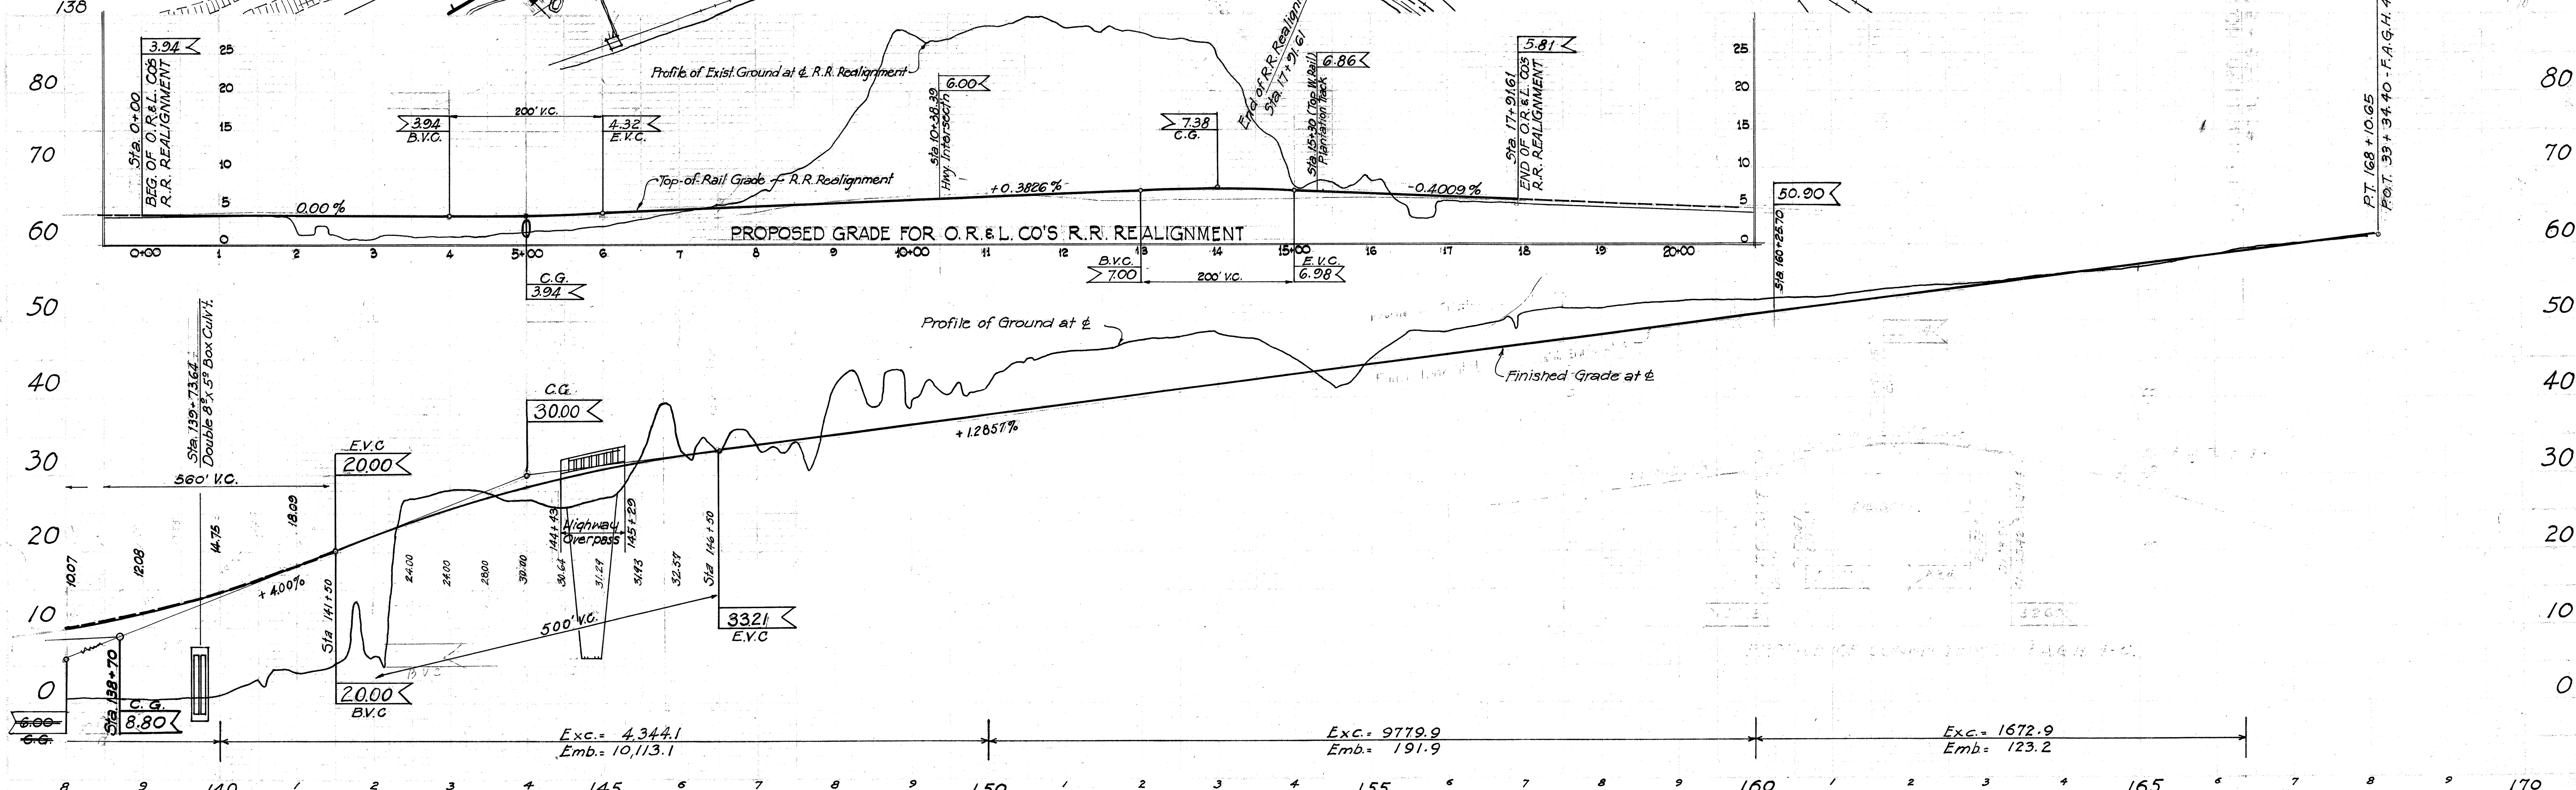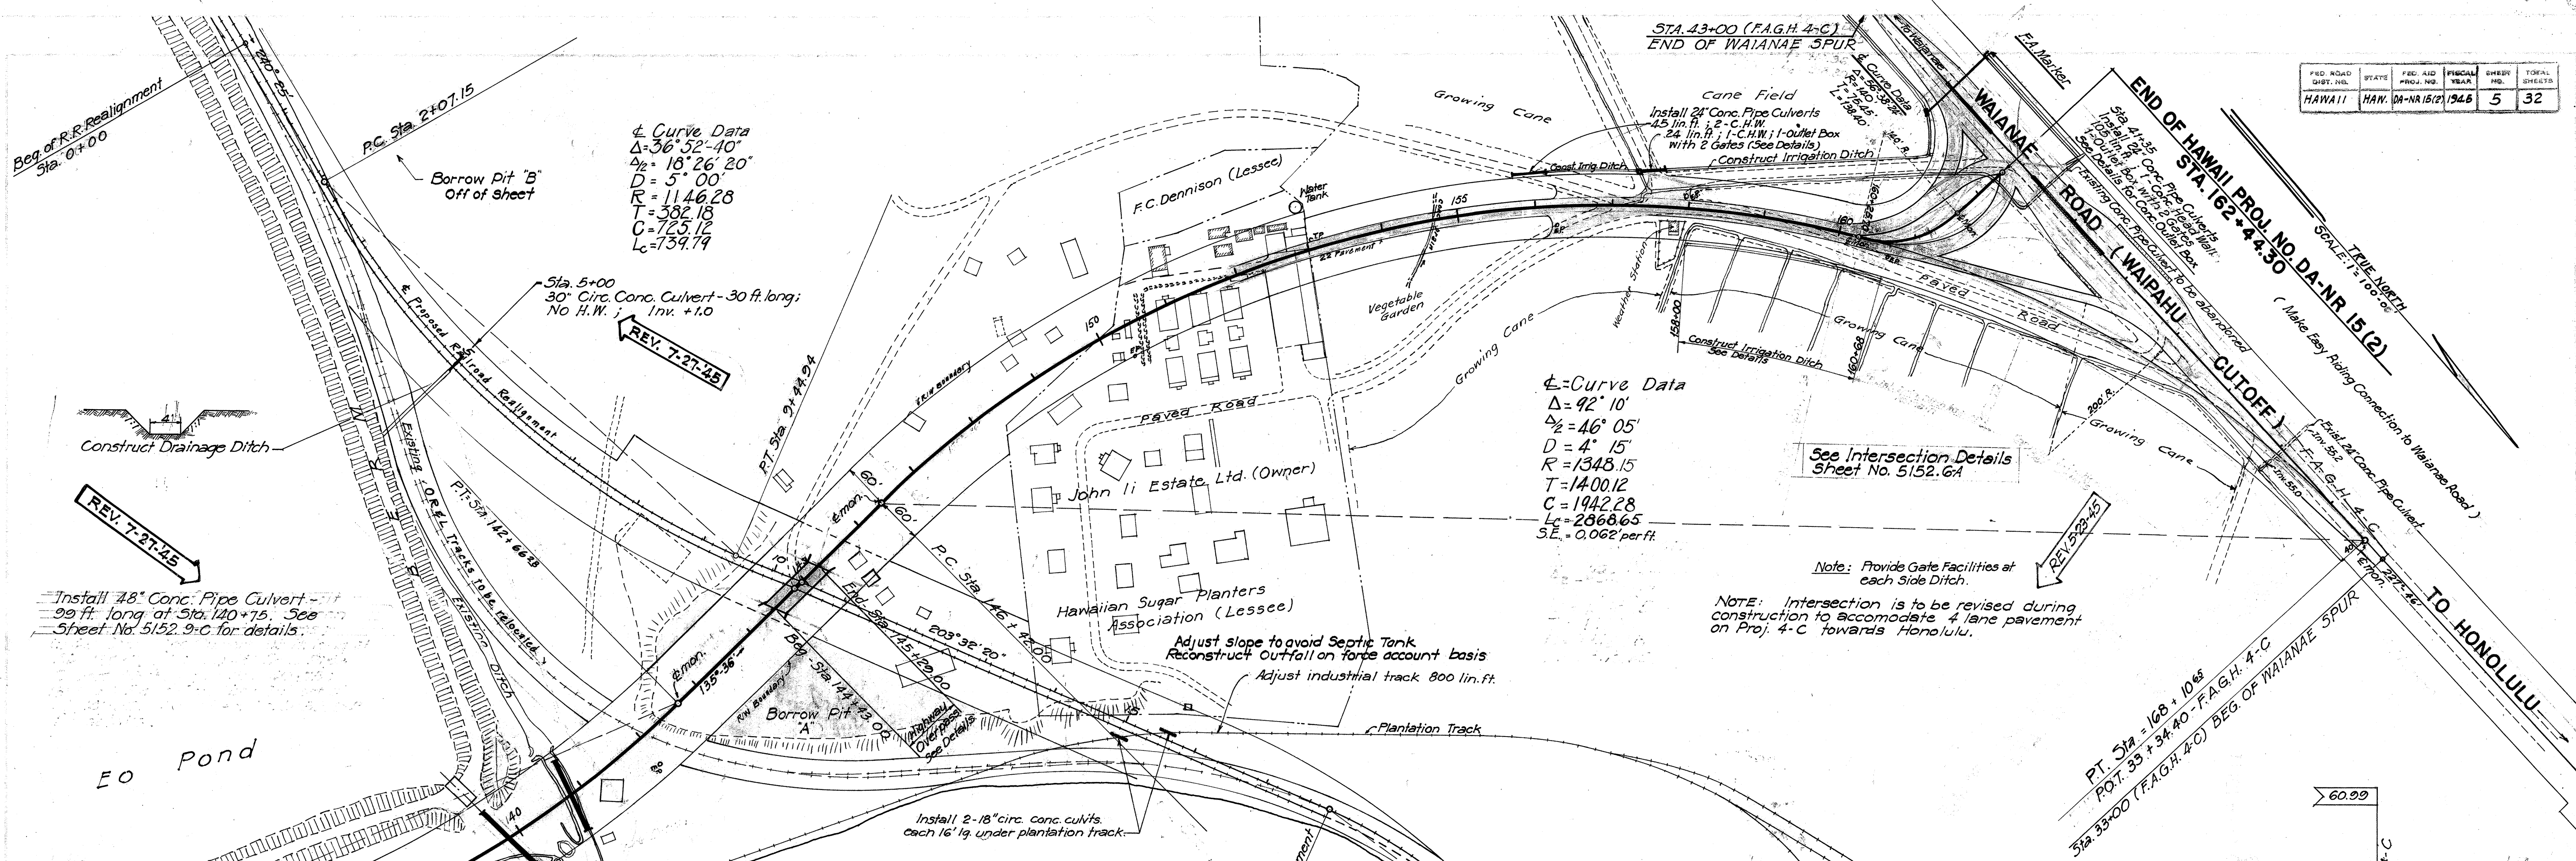

5152.5