



INDEX TO DRAWINGS	
SHEET NO.	DESCRIPTION
1	Title Sheet
2	Typical Section
3-5	Plan & Profile
6	Intersection Details
7-8 & 8-A	Standard Details
9-10	Culvert Details
11	Standard Bridge Details
12-17	Bridge Details
18-32	Cross Sections

TERRITORY OF HAWAII
TERRITORIAL HIGHWAY DEPARTMENT
HONOLULU - T. H.
PLANS OF
WAIPIO POINT ACCESS ROAD
HAWAII PROJECT NO. DA-NR 15 (2)
EWA DISTRICT, ISLAND OF OAHU

SCALES	
PLAN	1 INCH = 100 FEET
PROFILE	HOR: 1 INCH = 100 FEET VER: 1 INCH = 10 FEET
CROSS SECTIONS	HOR: 1 INCH = 10 FEET VER: 1 INCH = 5 FEET

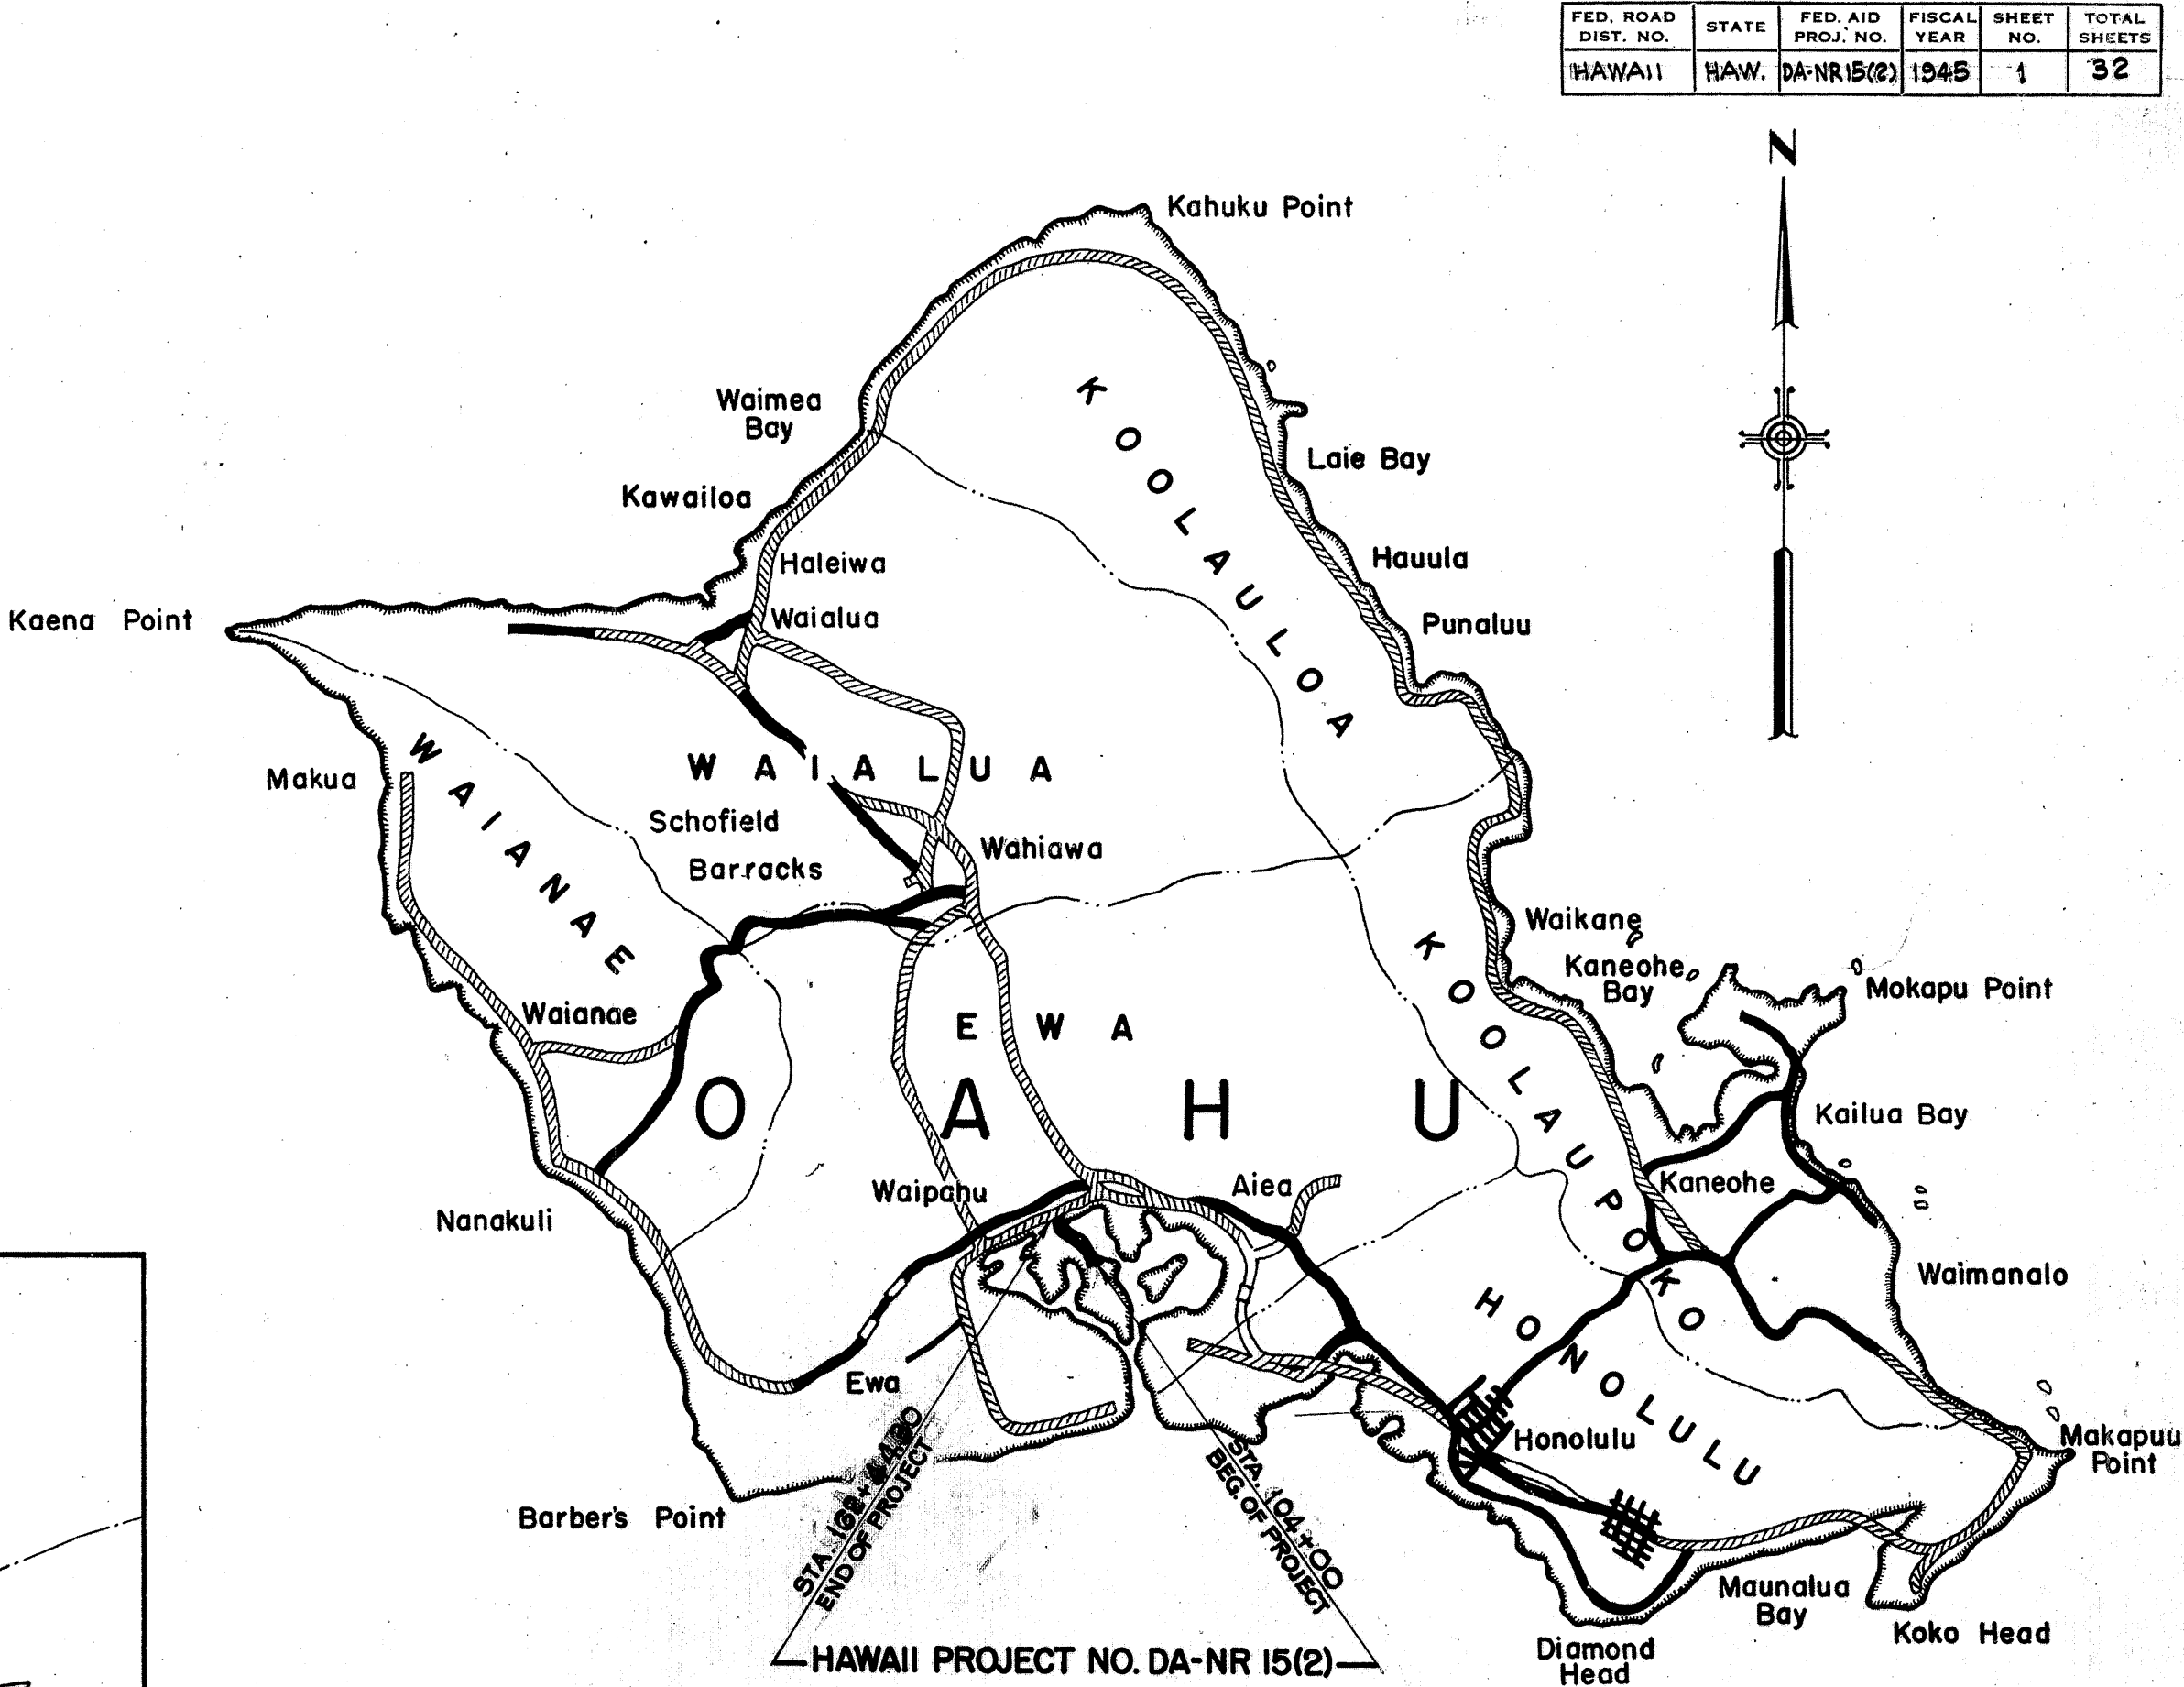

CONVENTIONAL SIGNS	
Centerline	55
Boundary Lines	or
Fences (Noted)	or
Existing Roadway	
Circular Conc. Culvert	
Railroad	
Telephone Pole	O.T.P.
Electric Power Line Pole	O.E.P.
Sewer Manhole	O.S.M.H.
Telephone Manhole	O.T.M.H.
Fire Hydrant	O.F.H.

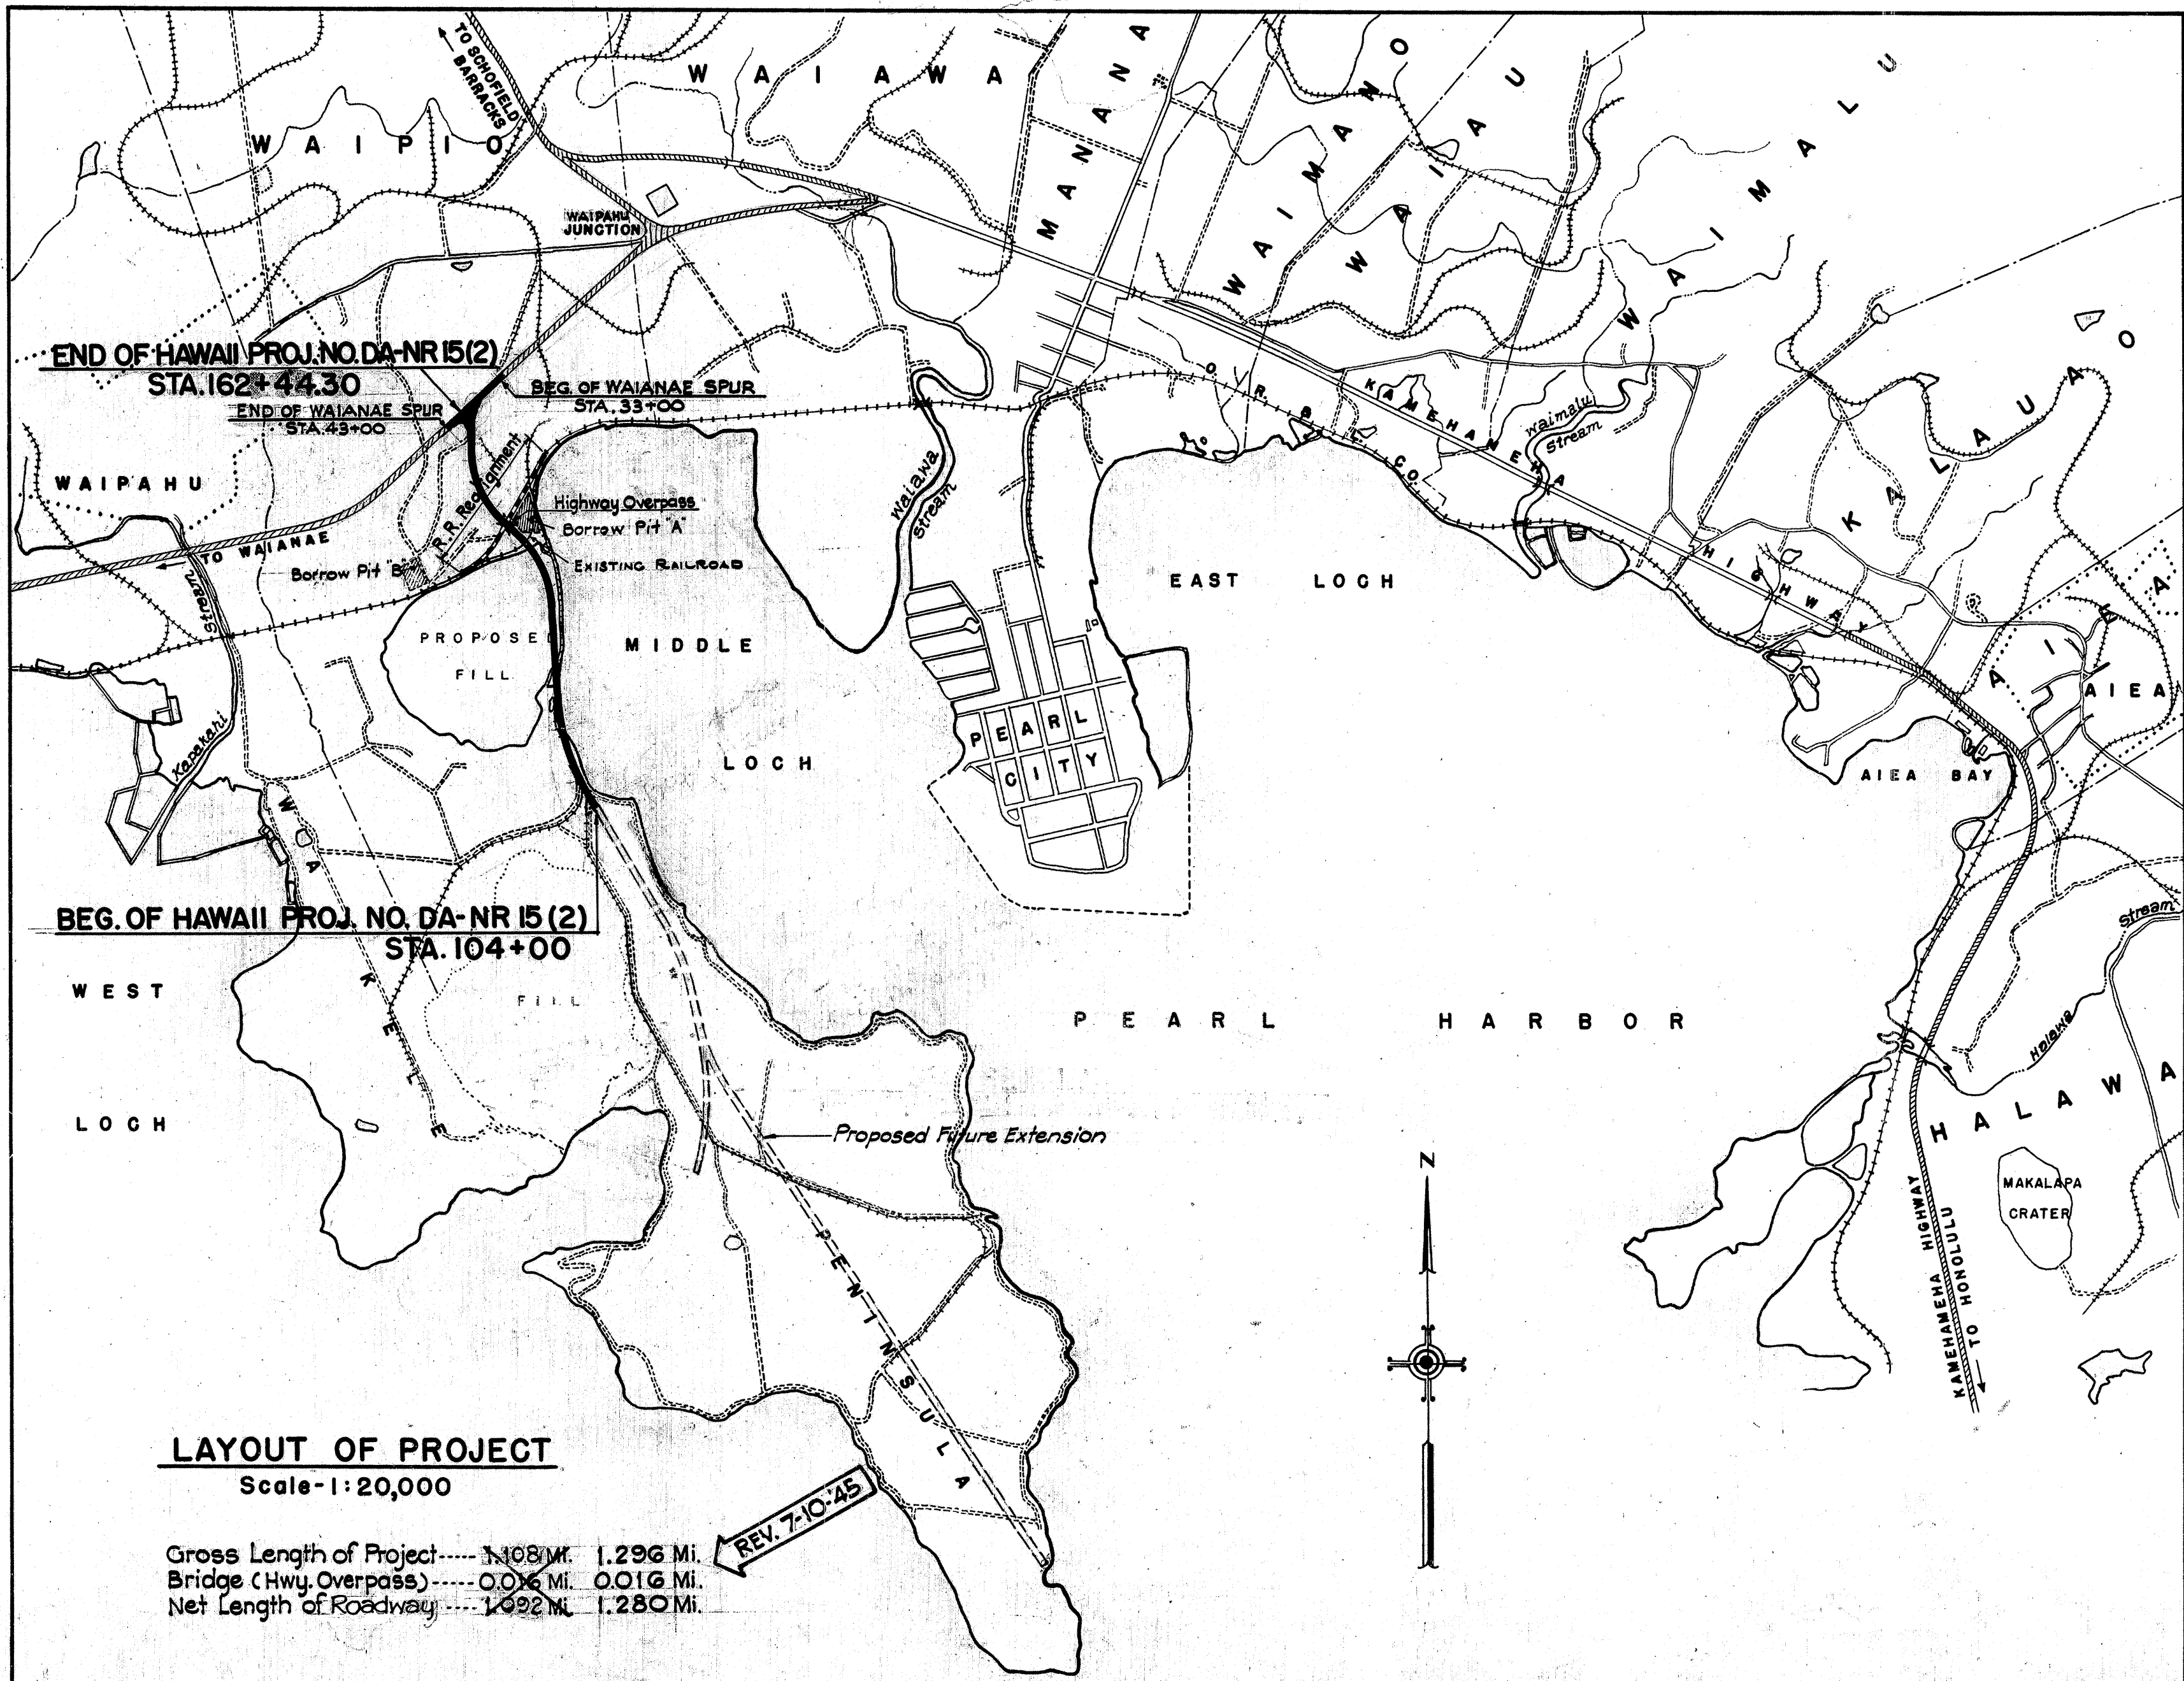

REVISED INDEX TO DRAWINGS				INSERTED	
REF. NO.	DESCRIPTION	SHEET NO.	REV. DATE	SHEET NO.	DATE
1	Title Sheet	5152.1	July 10, '45		
2	Typical Section	5152.2	"		
3-5	Plan & Profile	5152.3-5	"		
6	Intersection Details			5152.6-A	July 10, '45
7-9	Standard Details	5152.7, 8, 8-A	No Rev.		
10	Culvert Details			5152.9-B	July 10, '45
11	Std. Bridge Details	5152.11	No Rev.		
12-17	Bridge Details	5152.12-17	"		
18-32	Cross Section	5152.18-32	"		

Sheets deleted-----5152. 6, 9, 9-A, 10.

APPROVED

TERRITORIAL HIGHWAY ENGINEER
DATE: 4-27-45

RECOMMENDED FOR APPROVAL
DISTRICT ENGINEER
Public Roads Administration,
Federal Works Agency
RECOMMENDED FOR APPROVAL
CHIEF WESTERN REGION
Public Roads Administration,
Federal Works Agency
APPROVED
COMMISSIONER
Public Roads Administration,
Federal Works Agency