


FED. ROAD DIST. NO.	STATE	FED. AID PROJ. NO.	FISCAL YEAR	SHEET NO.	TOTAL SHEETS
Hawaii	Hawaii	F-4(7)	1951	18	25

FINAL SURVEY	DATE
NOTE BOOK	BY
AREAS CHECKED	

ORIGINAL SURVEY	DATE
NOTE BOOK	BY
AREAS CHECKED	

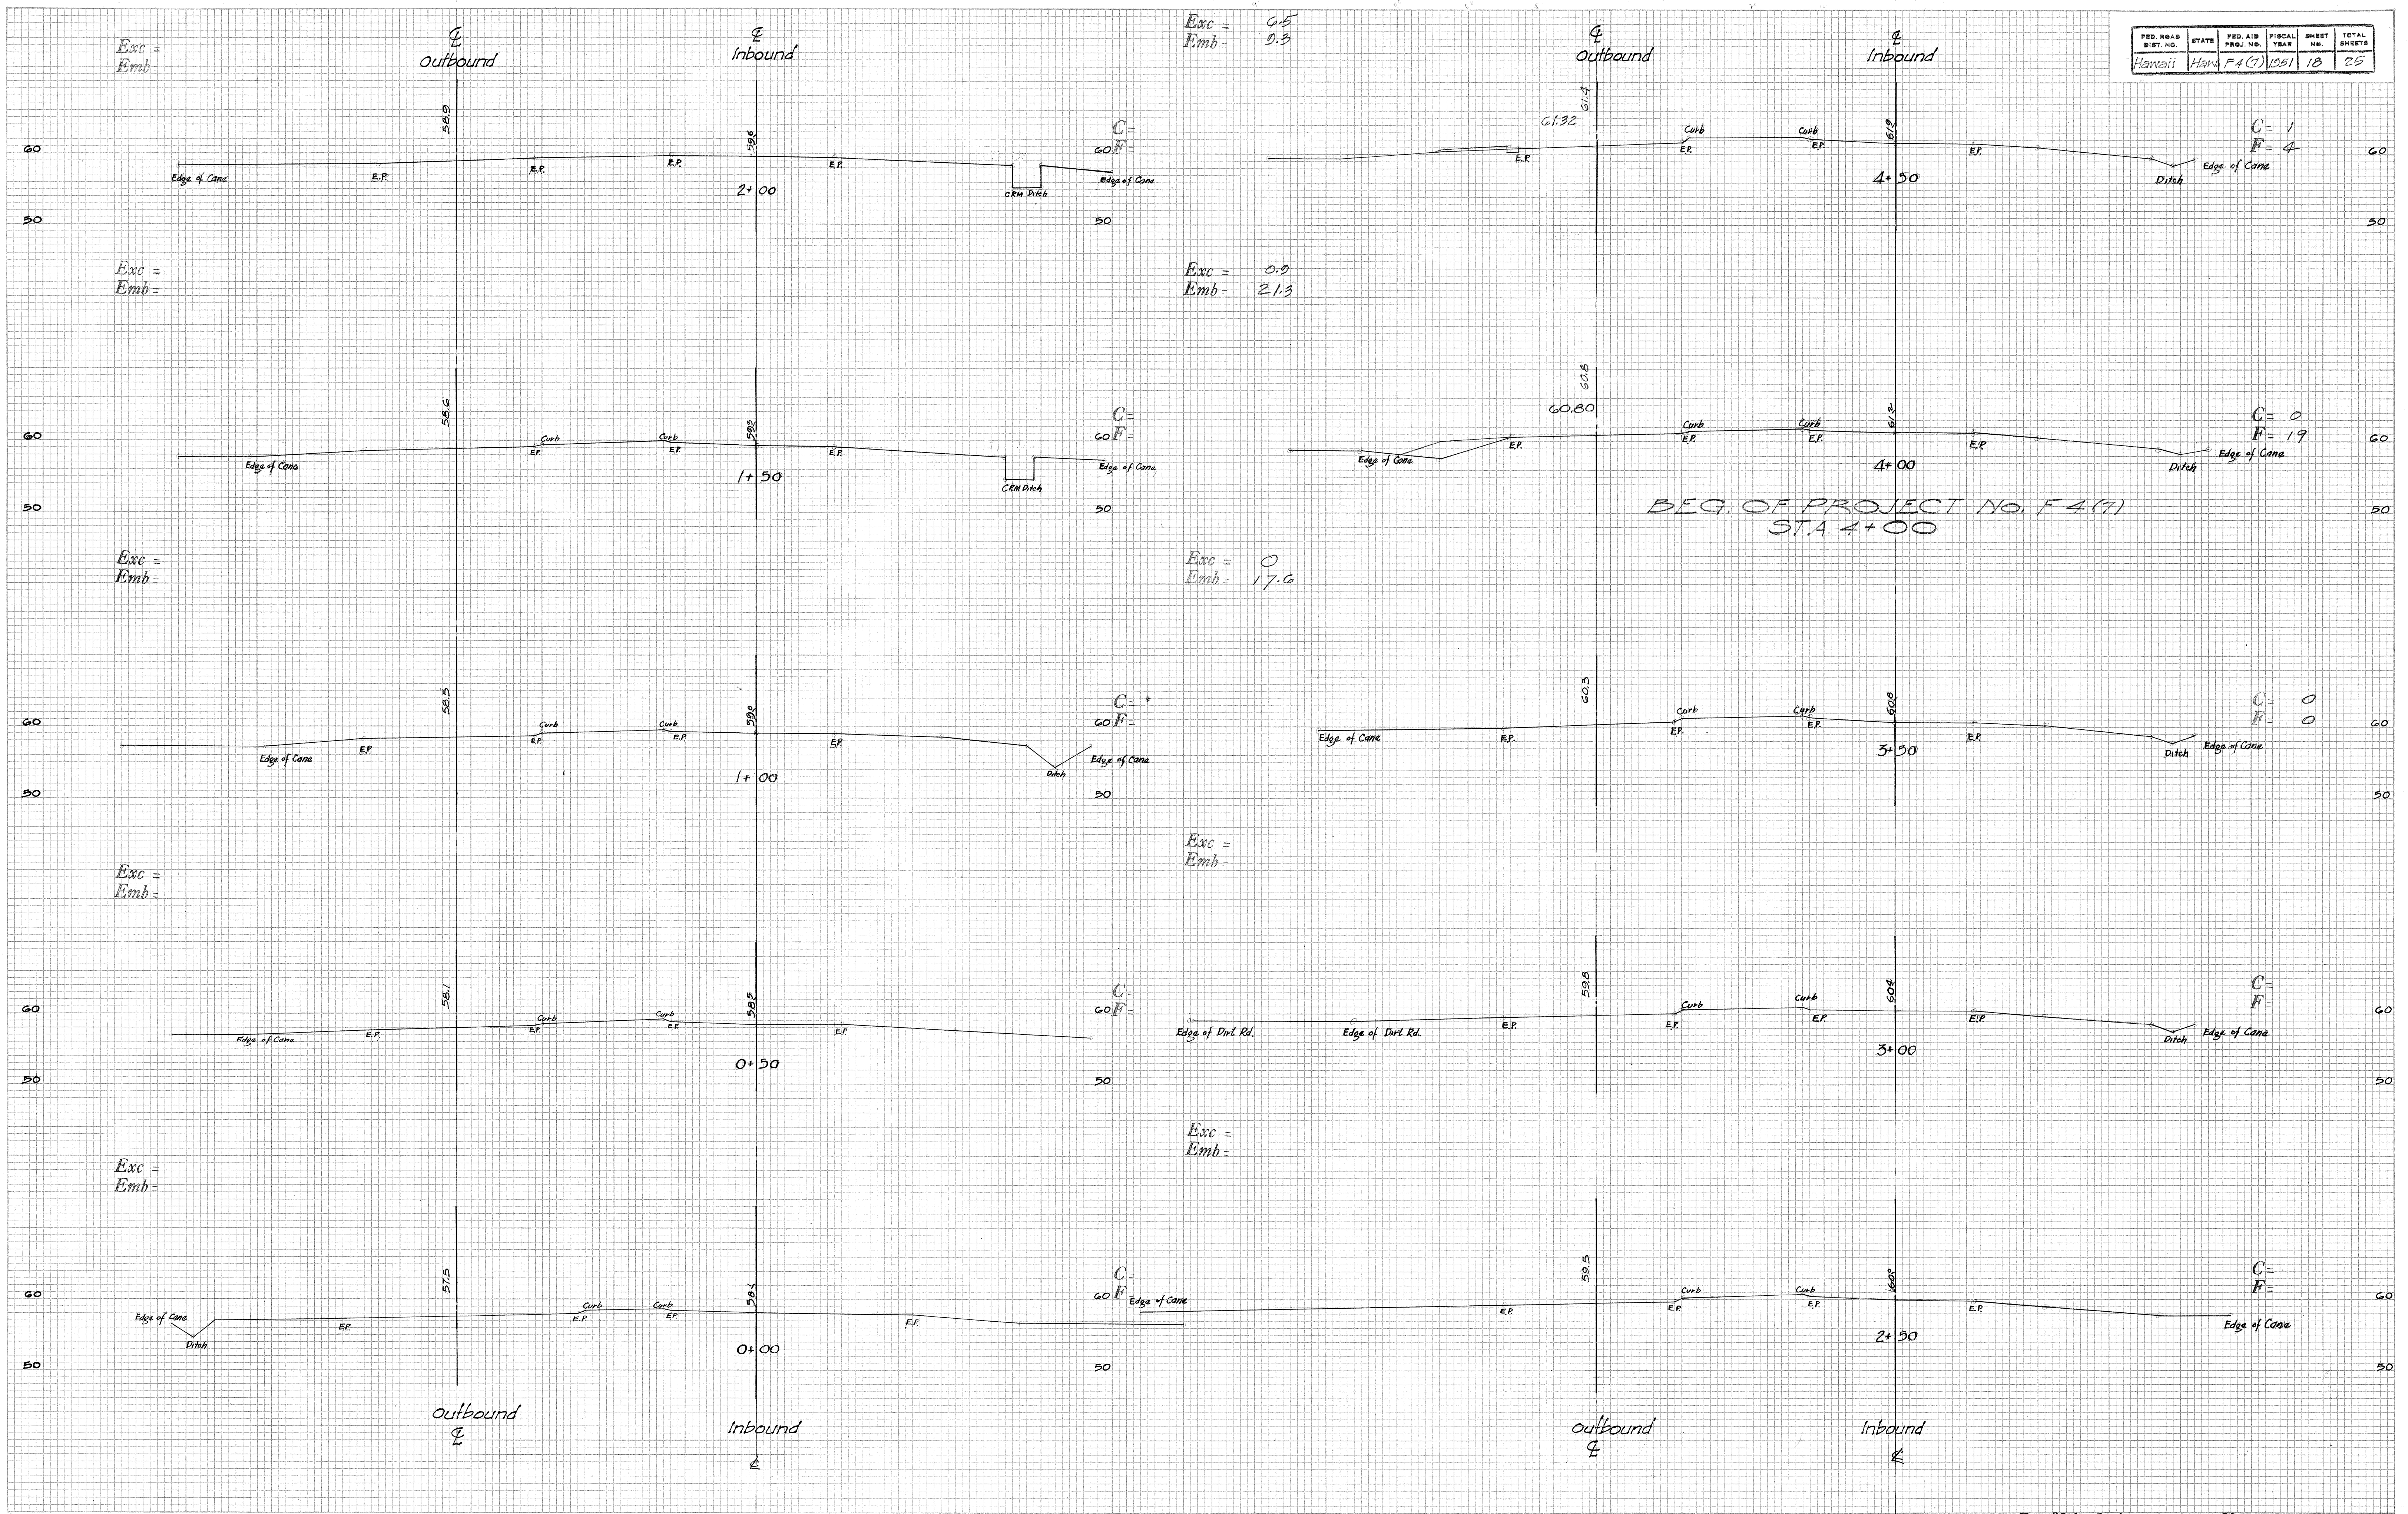


5477.18

FINAL SURVEY	DATE
	BY
	SURVEYED PLOTTED NOTE BOOK AREAS CHECKED
	NO.

ORIGINAL SURVEY	DATE
	BY
	SURVEYED PLOTTED NOTE BOOK AREAS CHECKED
	NO.


FED. ROAD DIST. NO.	STATE	FED. AID PROJ. NO.	FISCAL YEAR	SHEET NO.	TOTAL SHEETS
HAWAII	HAWAII	F-1 (7)	1951	19	25

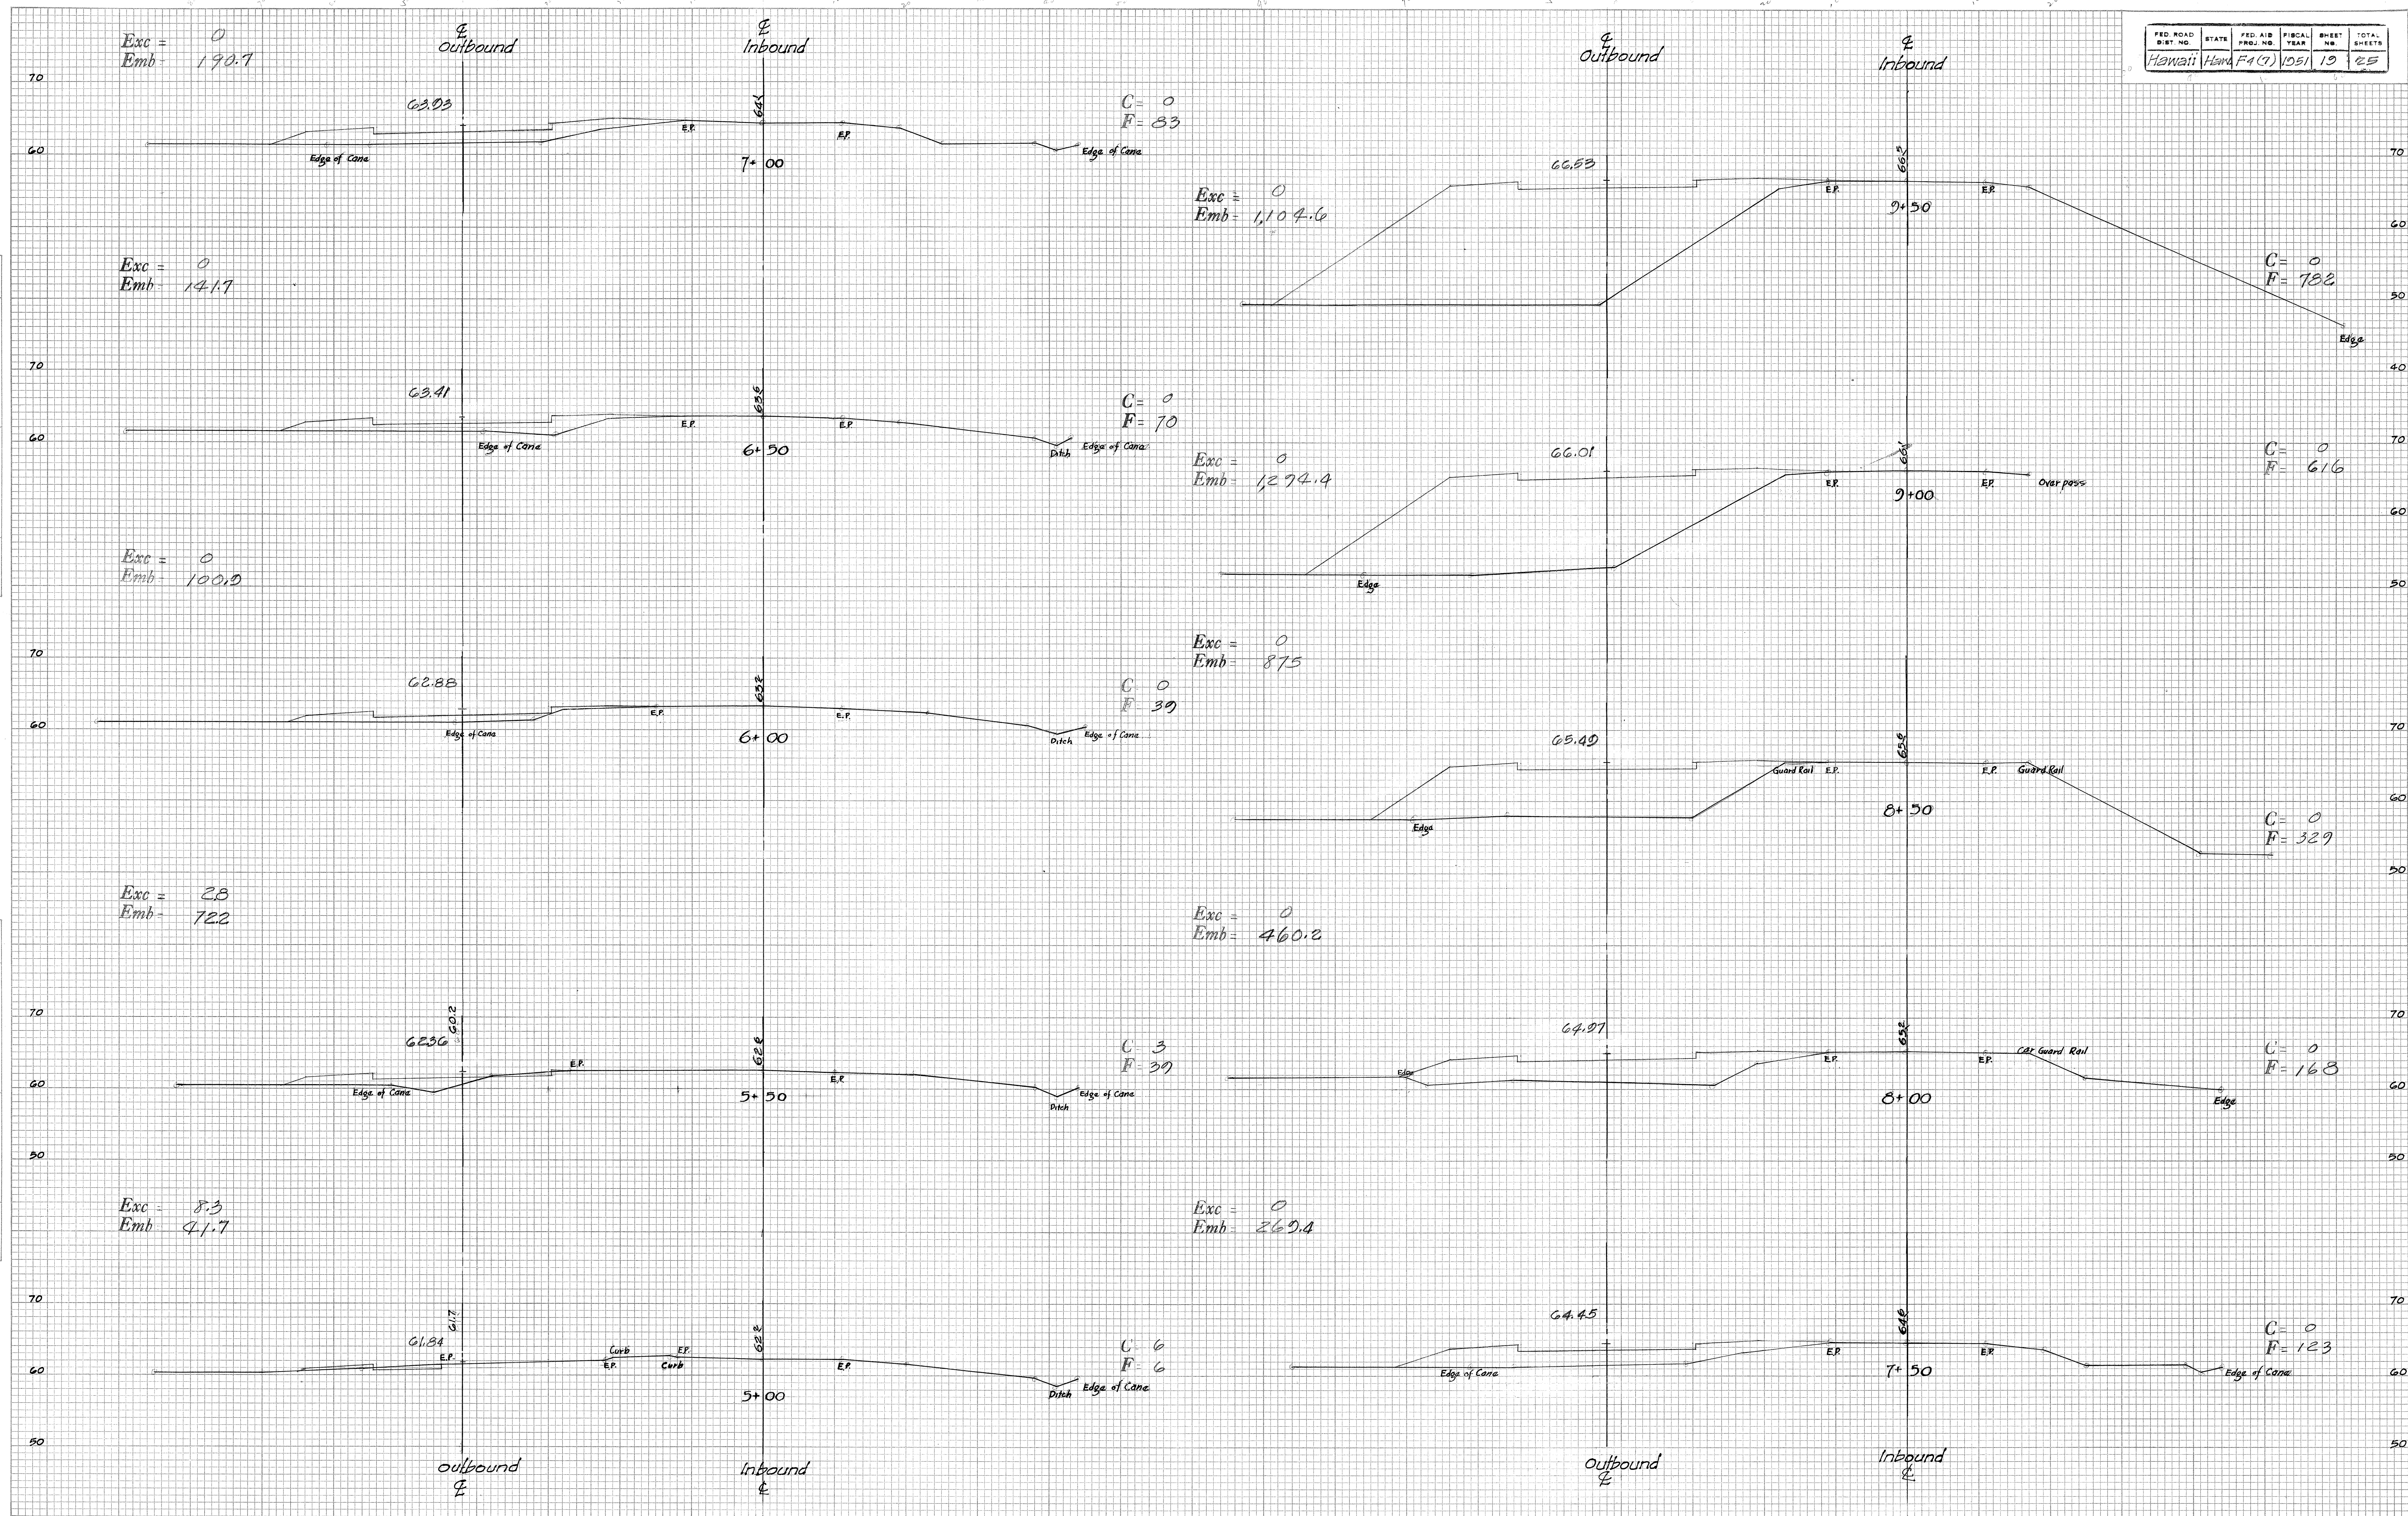


FINAL SURVEY	DATE
	BY
	SURVEYED PLOTTER NOTE BOOK AREAS CHECKED
	NO.

ORIGINAL SURVEY	DATE
	BY
	SURVEYED PLOTTER NOTE BOOK AREAS CHECKED
	NO.


FED. ROAD DIST. NO.	STATE	FED. AID PROJ. NO.	FISCAL YEAR	SHEET NO.	TOTAL SHEETS
Hawaii	Haw.	F471	1951	20	25

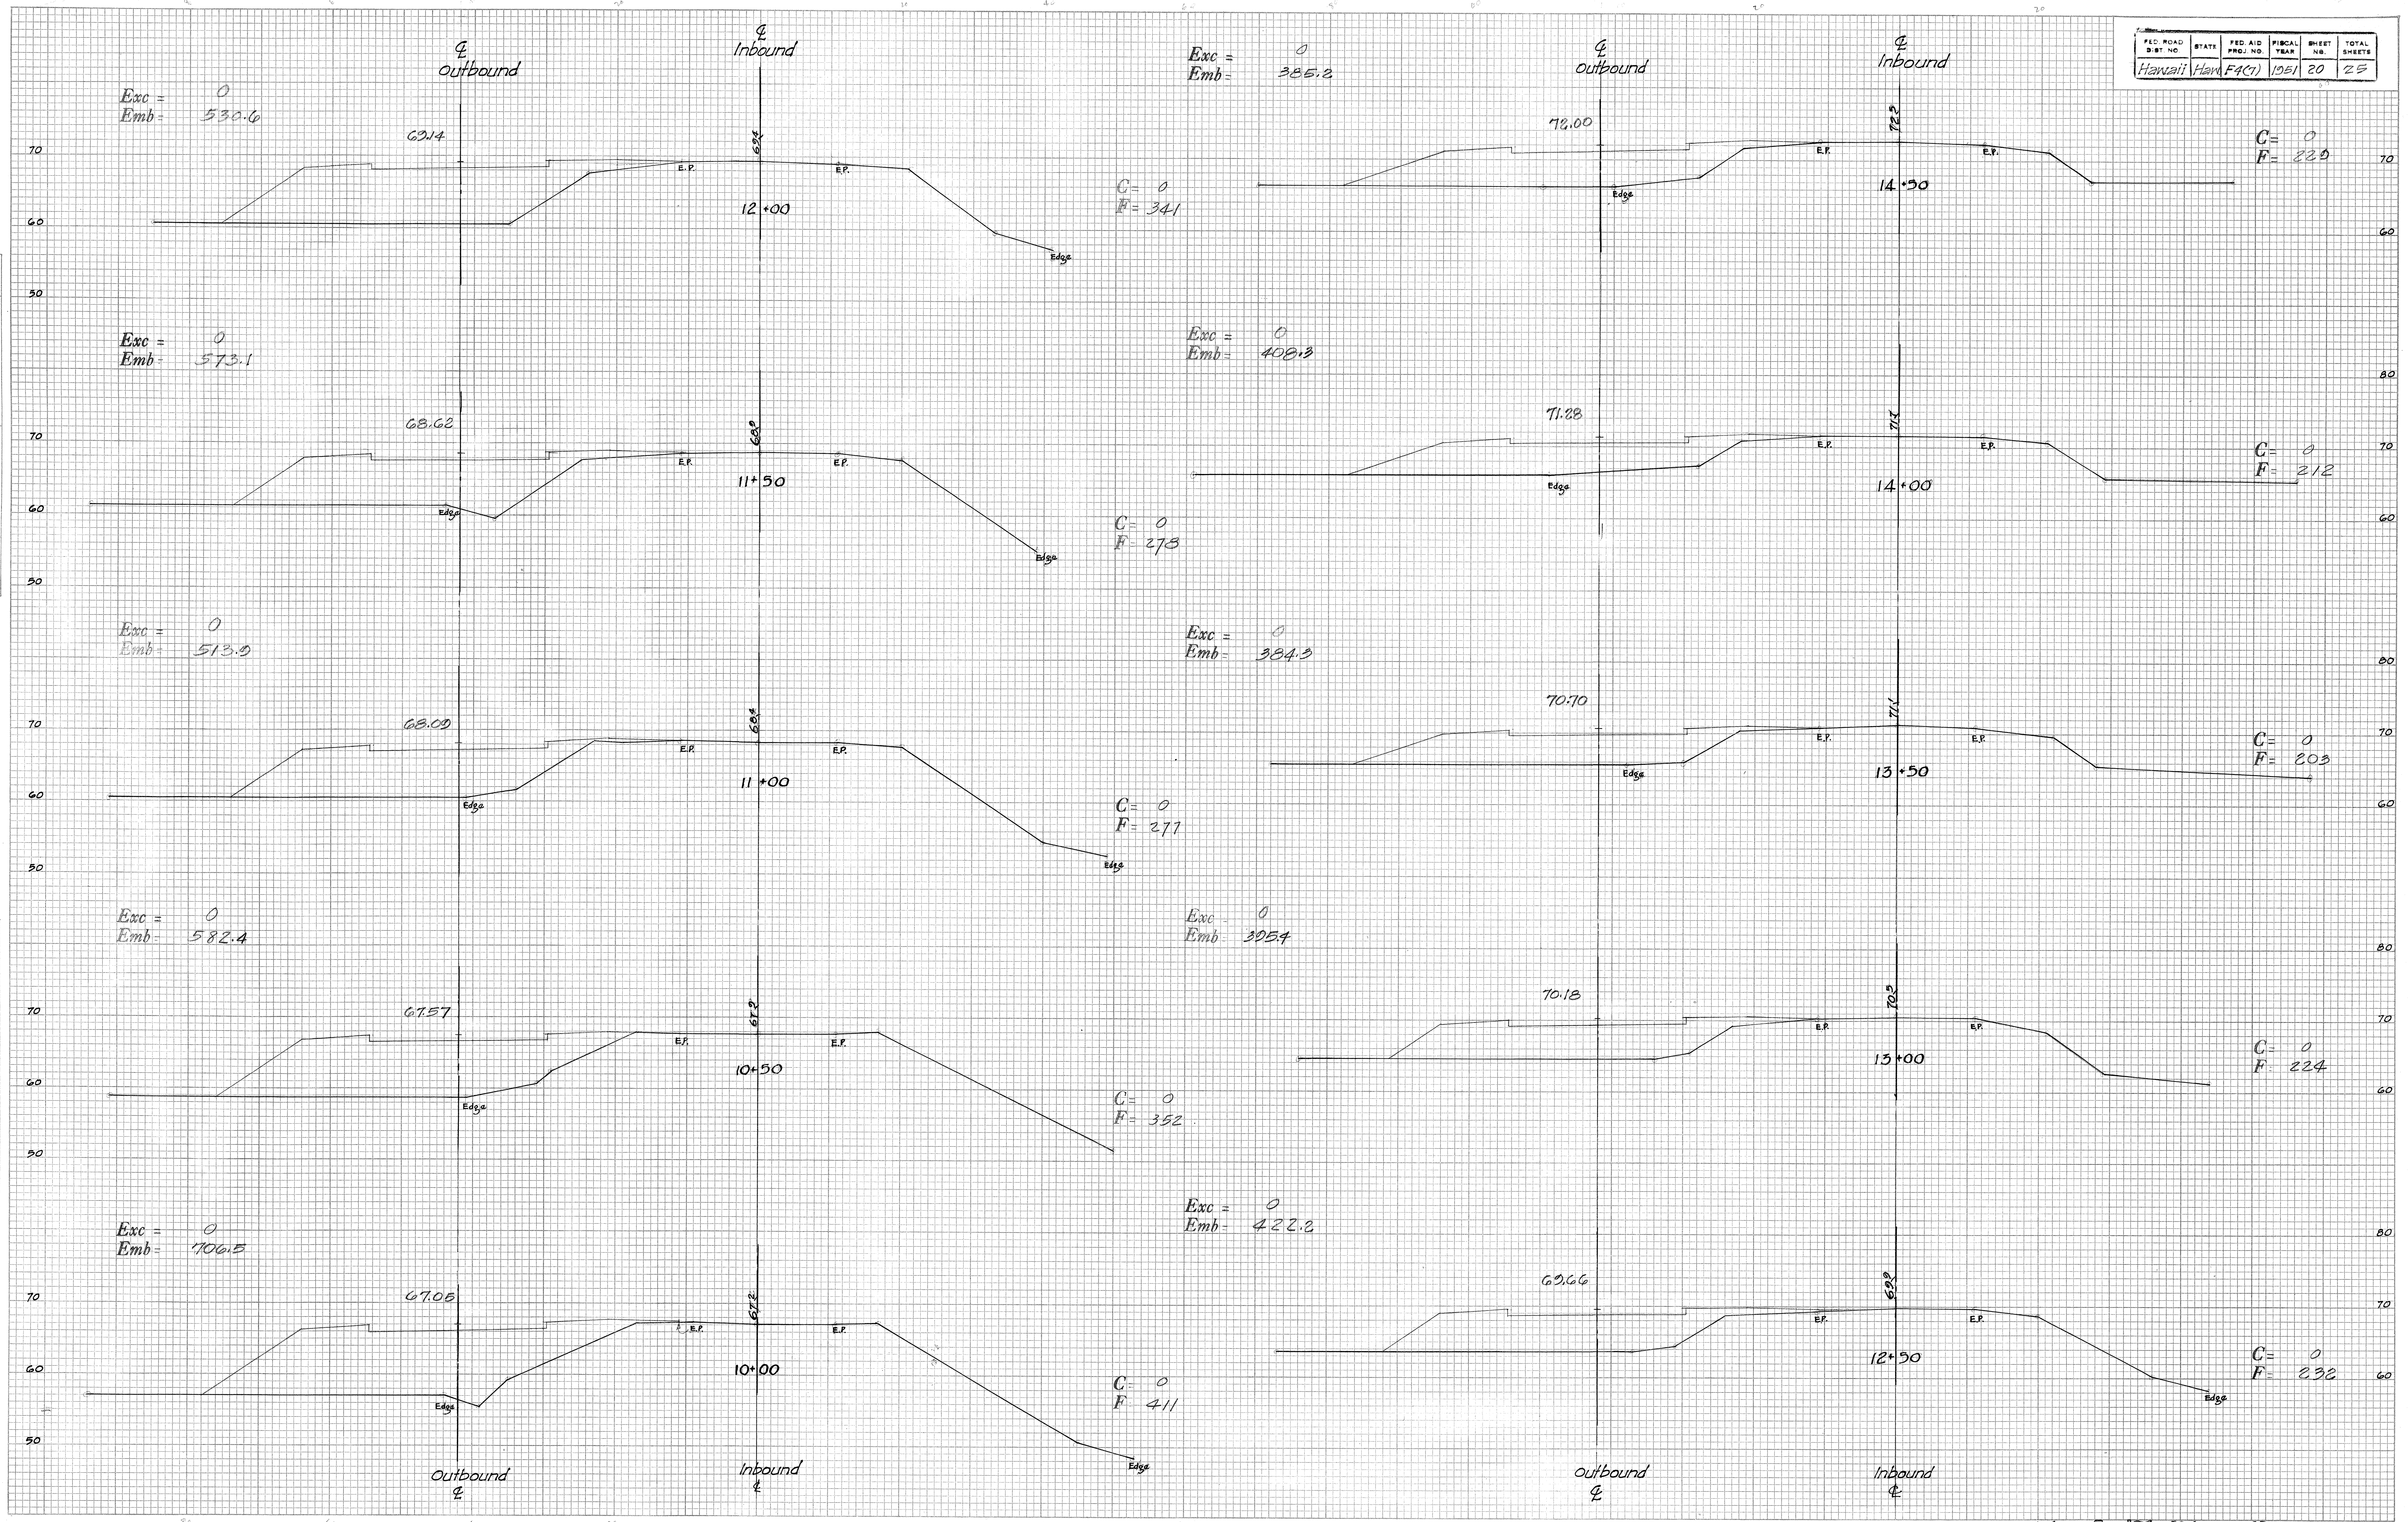

FED. ROAD DIST. NO.	STATE	FED. AID PROJ. NO.	FISCAL YEAR	SHEET NO.	TOTAL SHEETS
Hawaii	Hawaii	F4(7)	1951	21	25

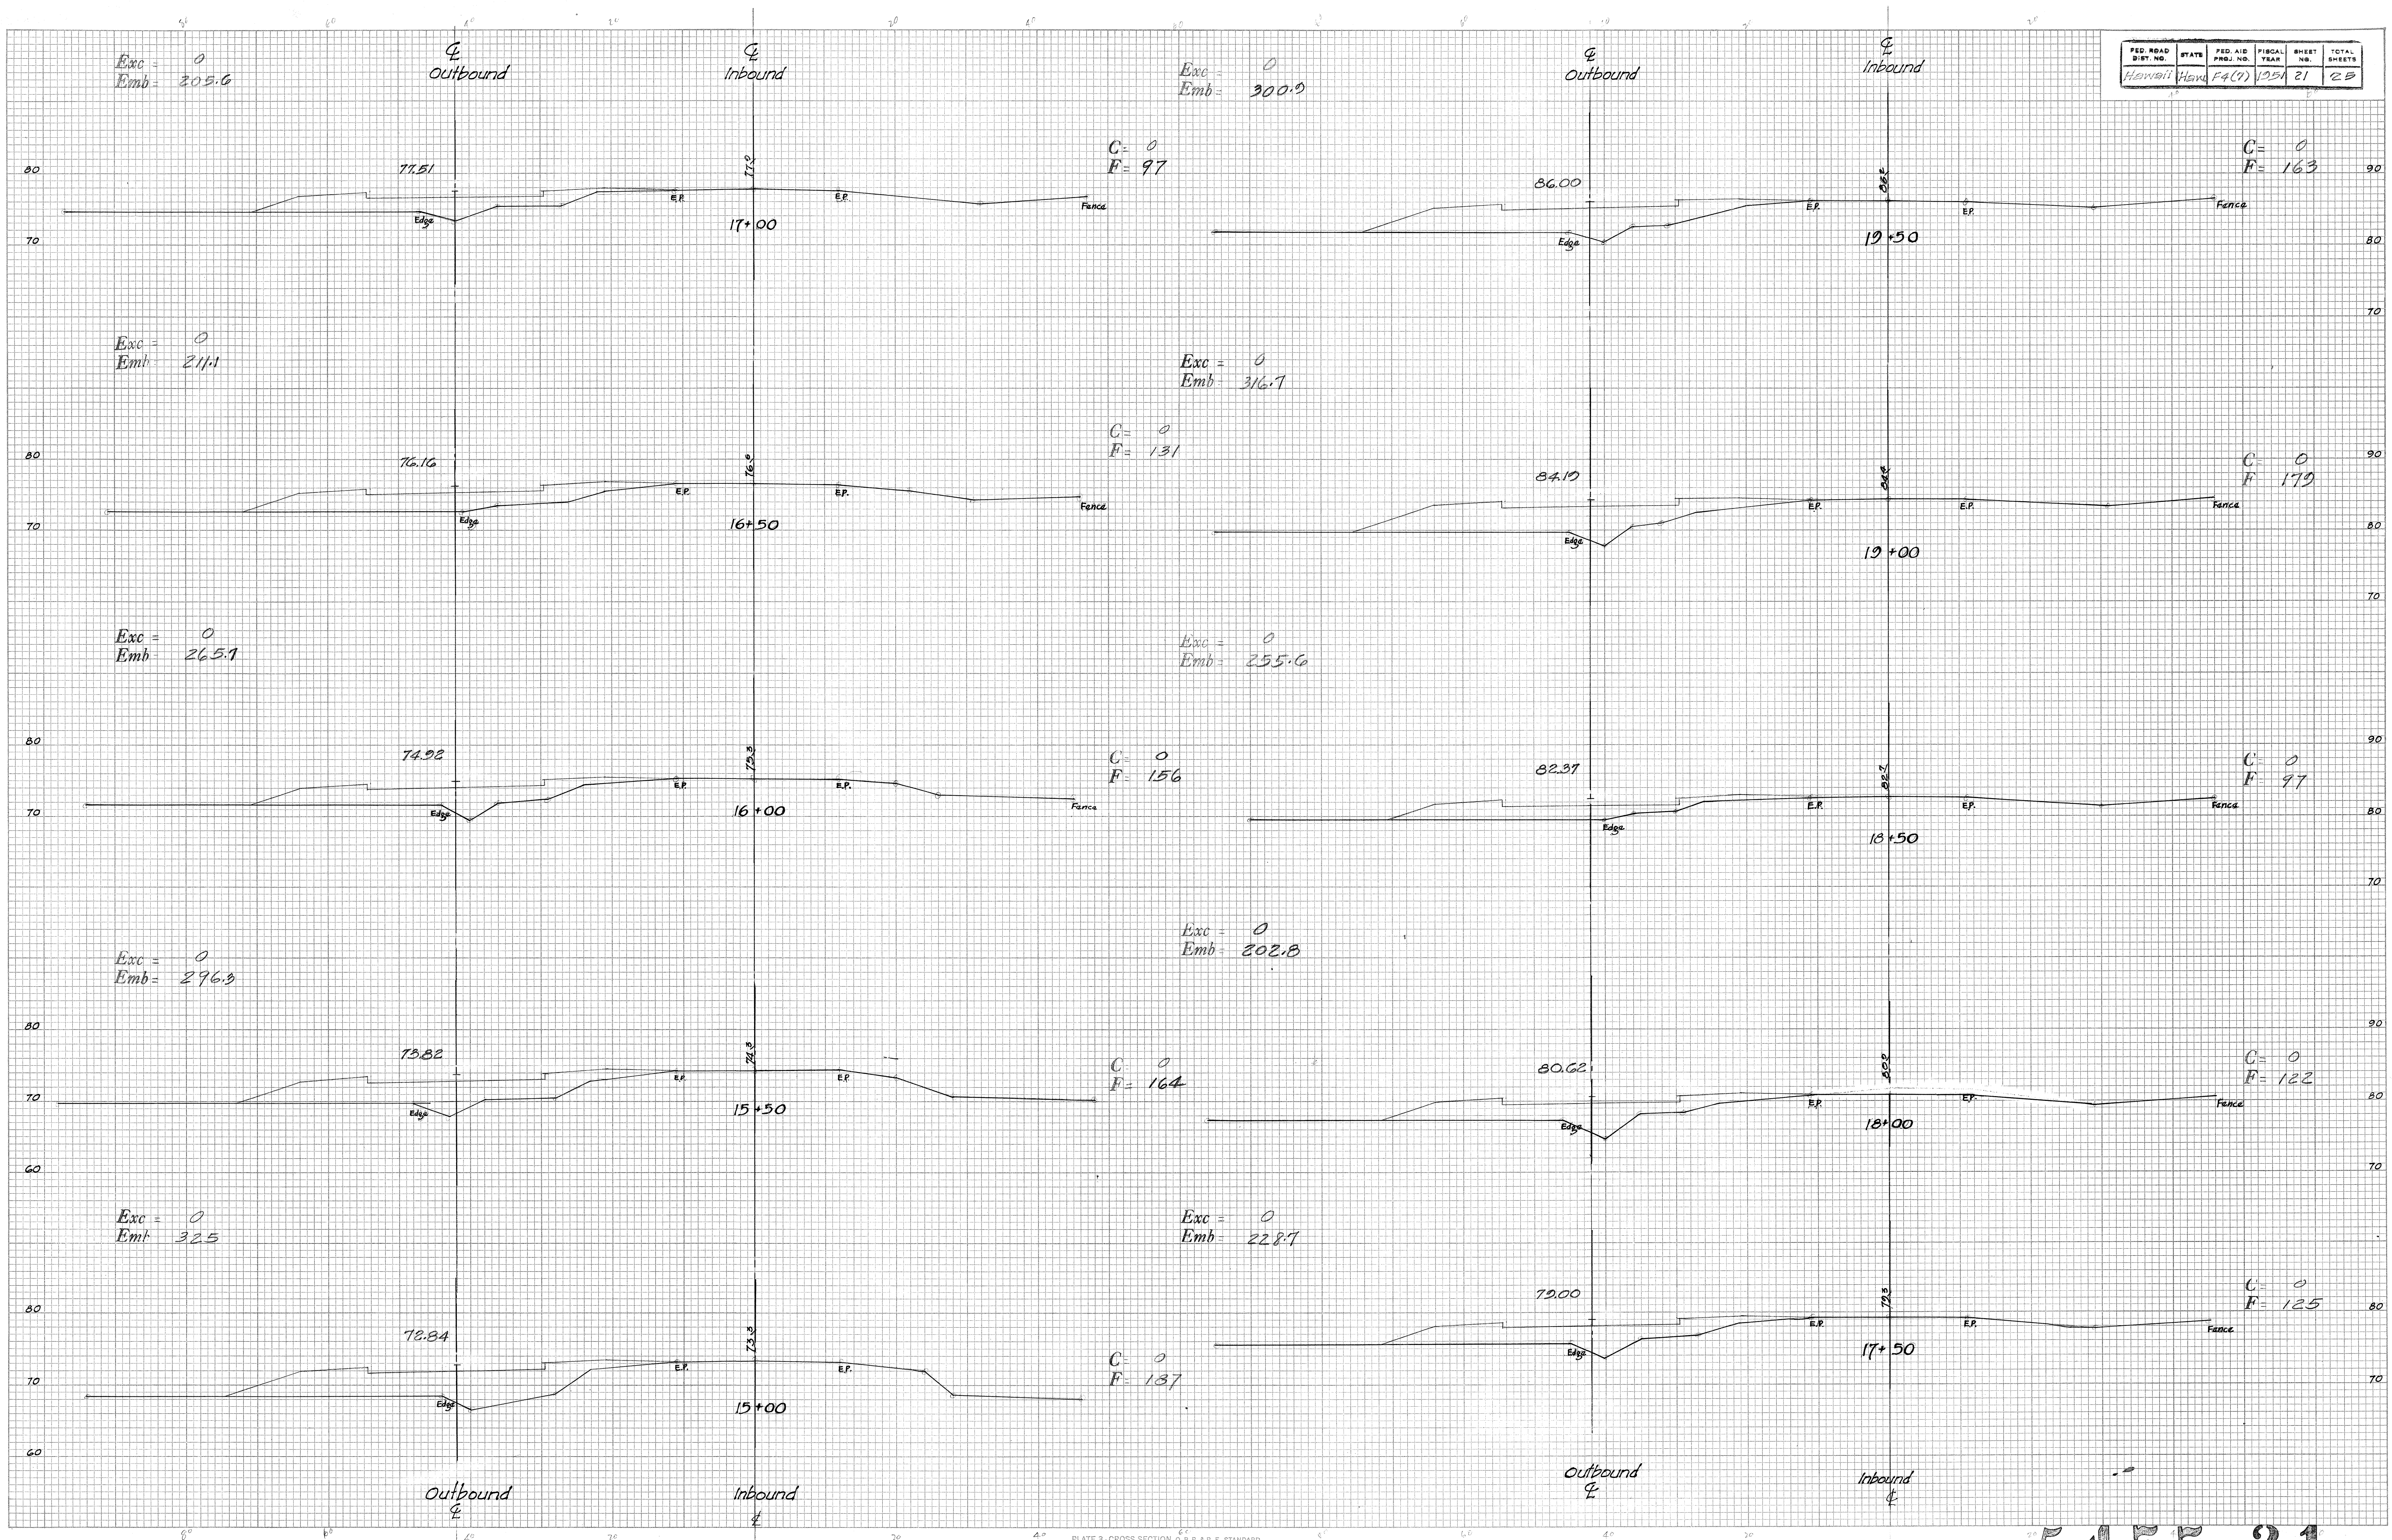


FED. ROAD DIST. NO.	STATE	FED. AID PROJ. NO.	FISCAL YEAR	SHEET NO.	TOTAL SHEETS
Hawaii	Haw.	F4(7)	1951	22	25

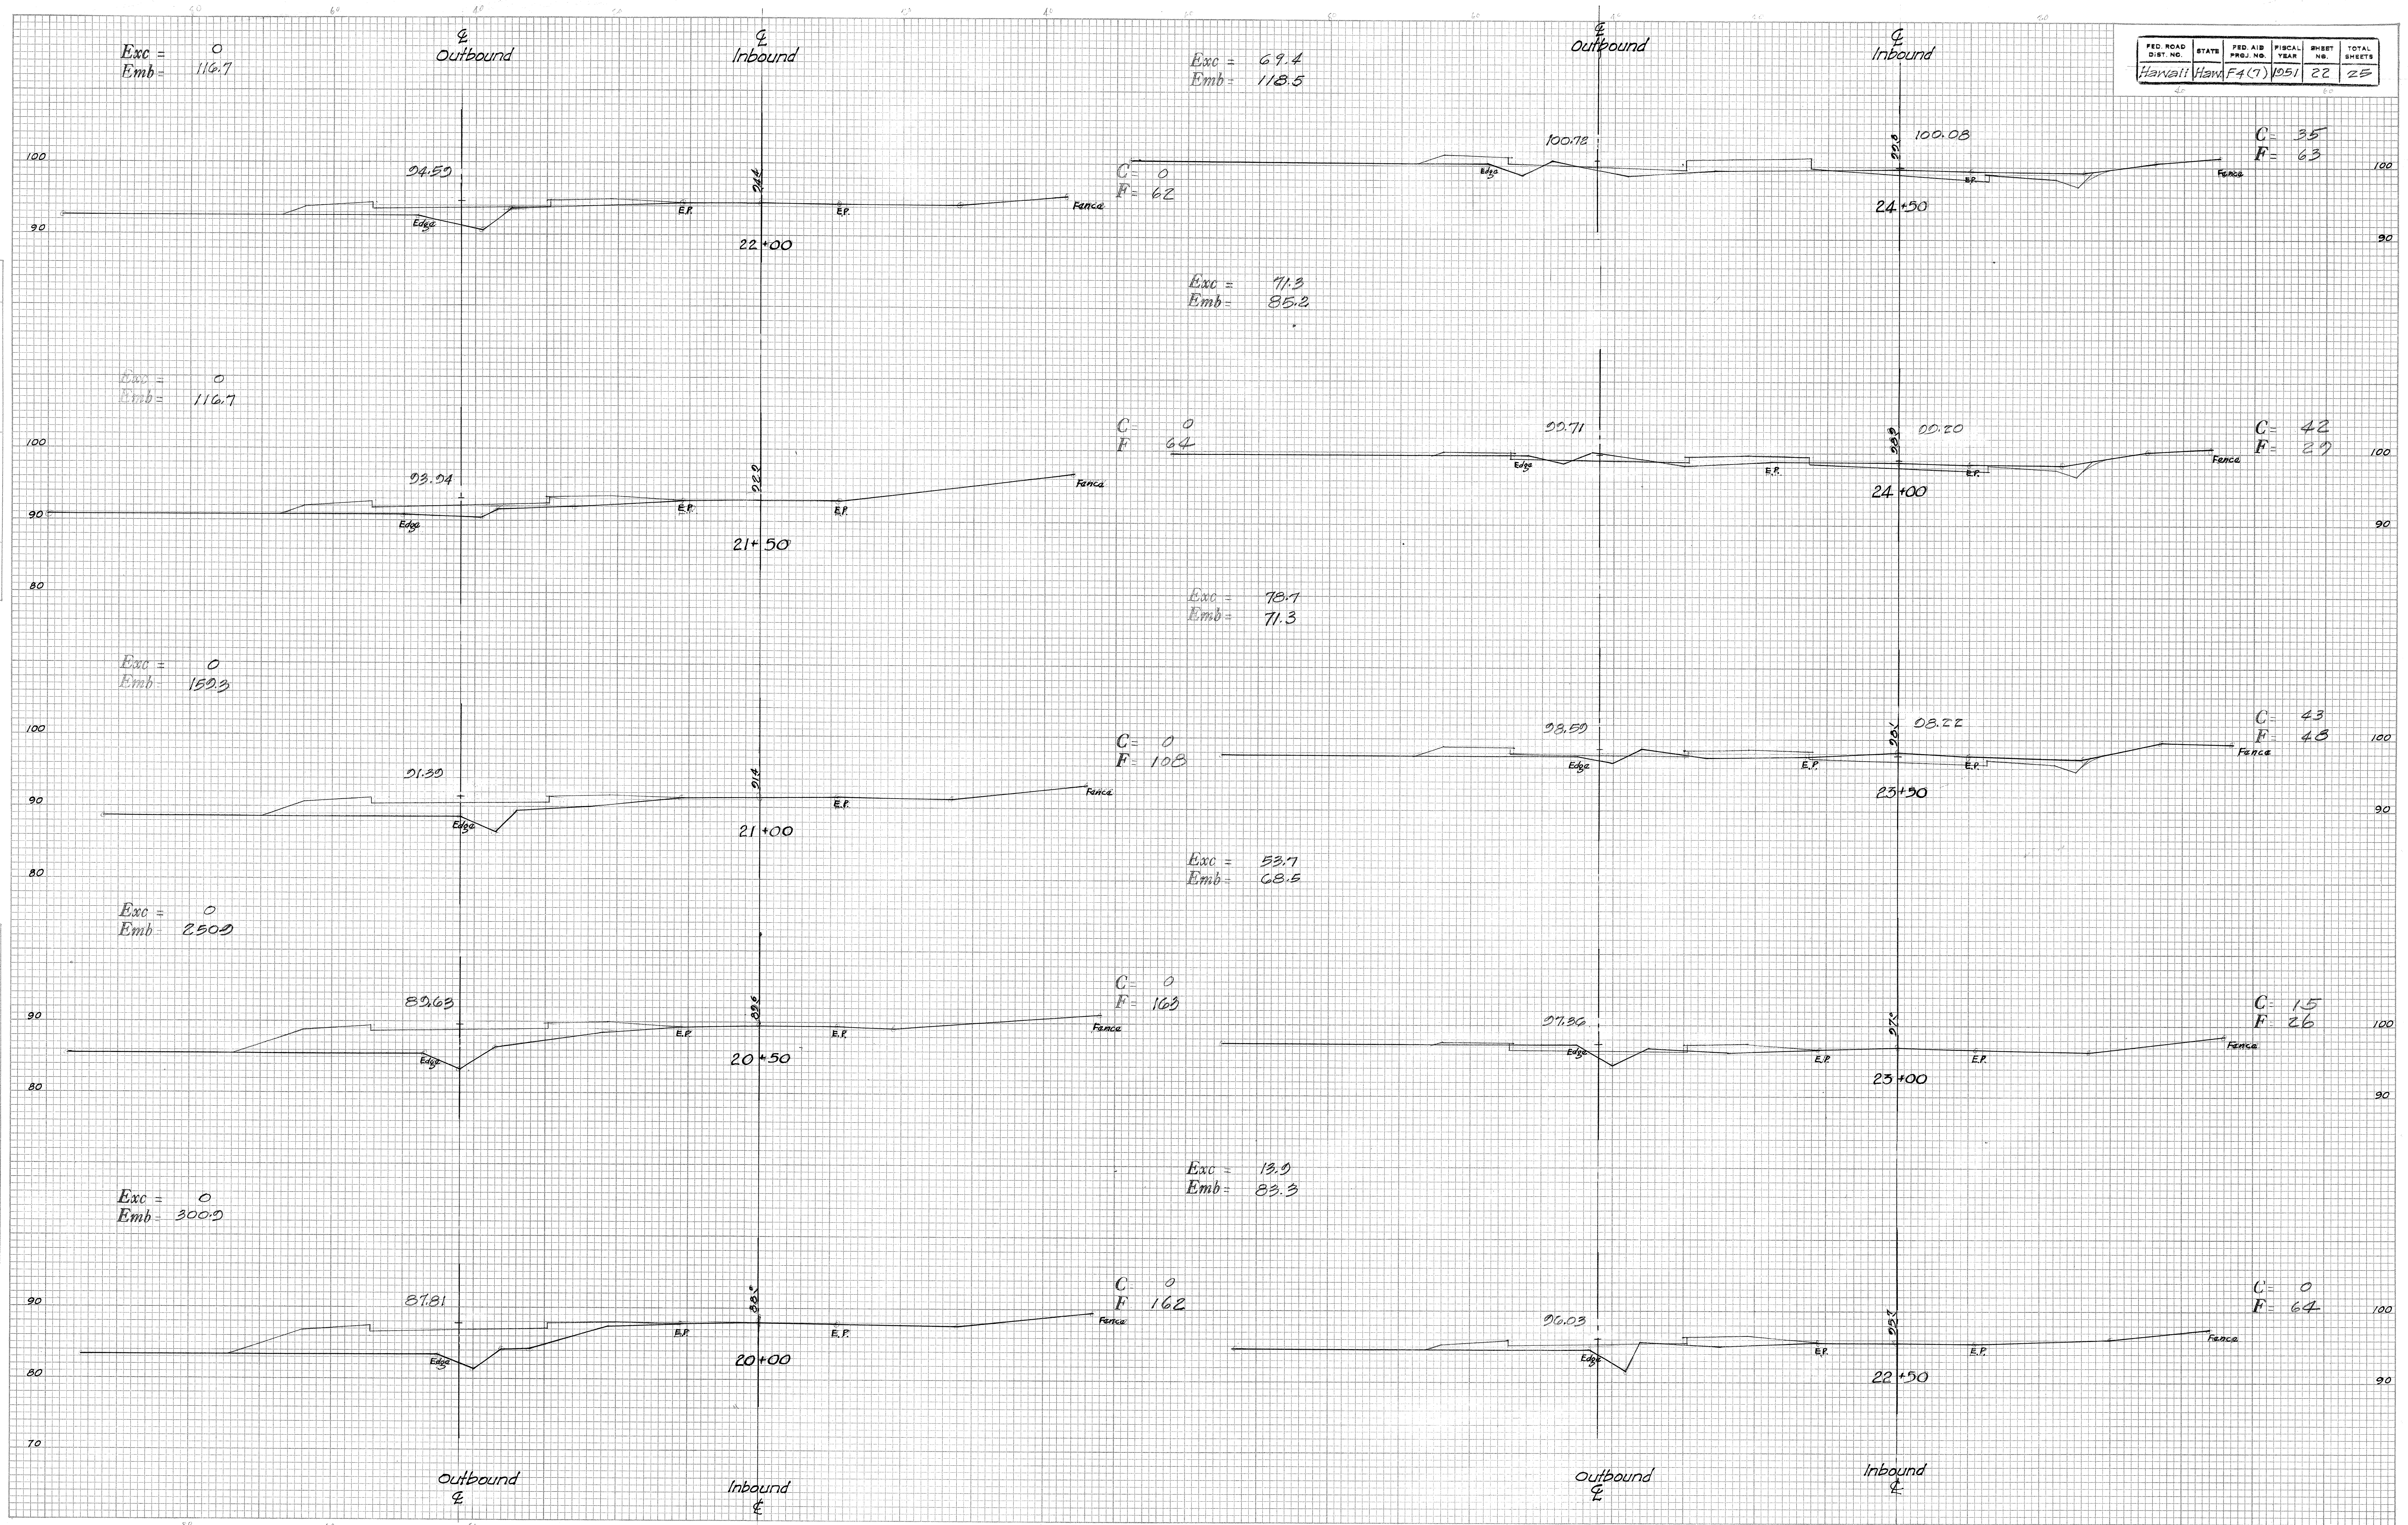

5477.22

FINAL SURVEY	SURVEYED		BY	DATE
	PLOTTED			
NOTE BOOK	TEMPLATE			
NO.	AREAS			
	AREAS CHECKED			

ORIGINAL		BY	DATE
SURVEY			
PLOTTED			
TEMPLE			
AREAS			
AREAS CHECKED			
NO.			

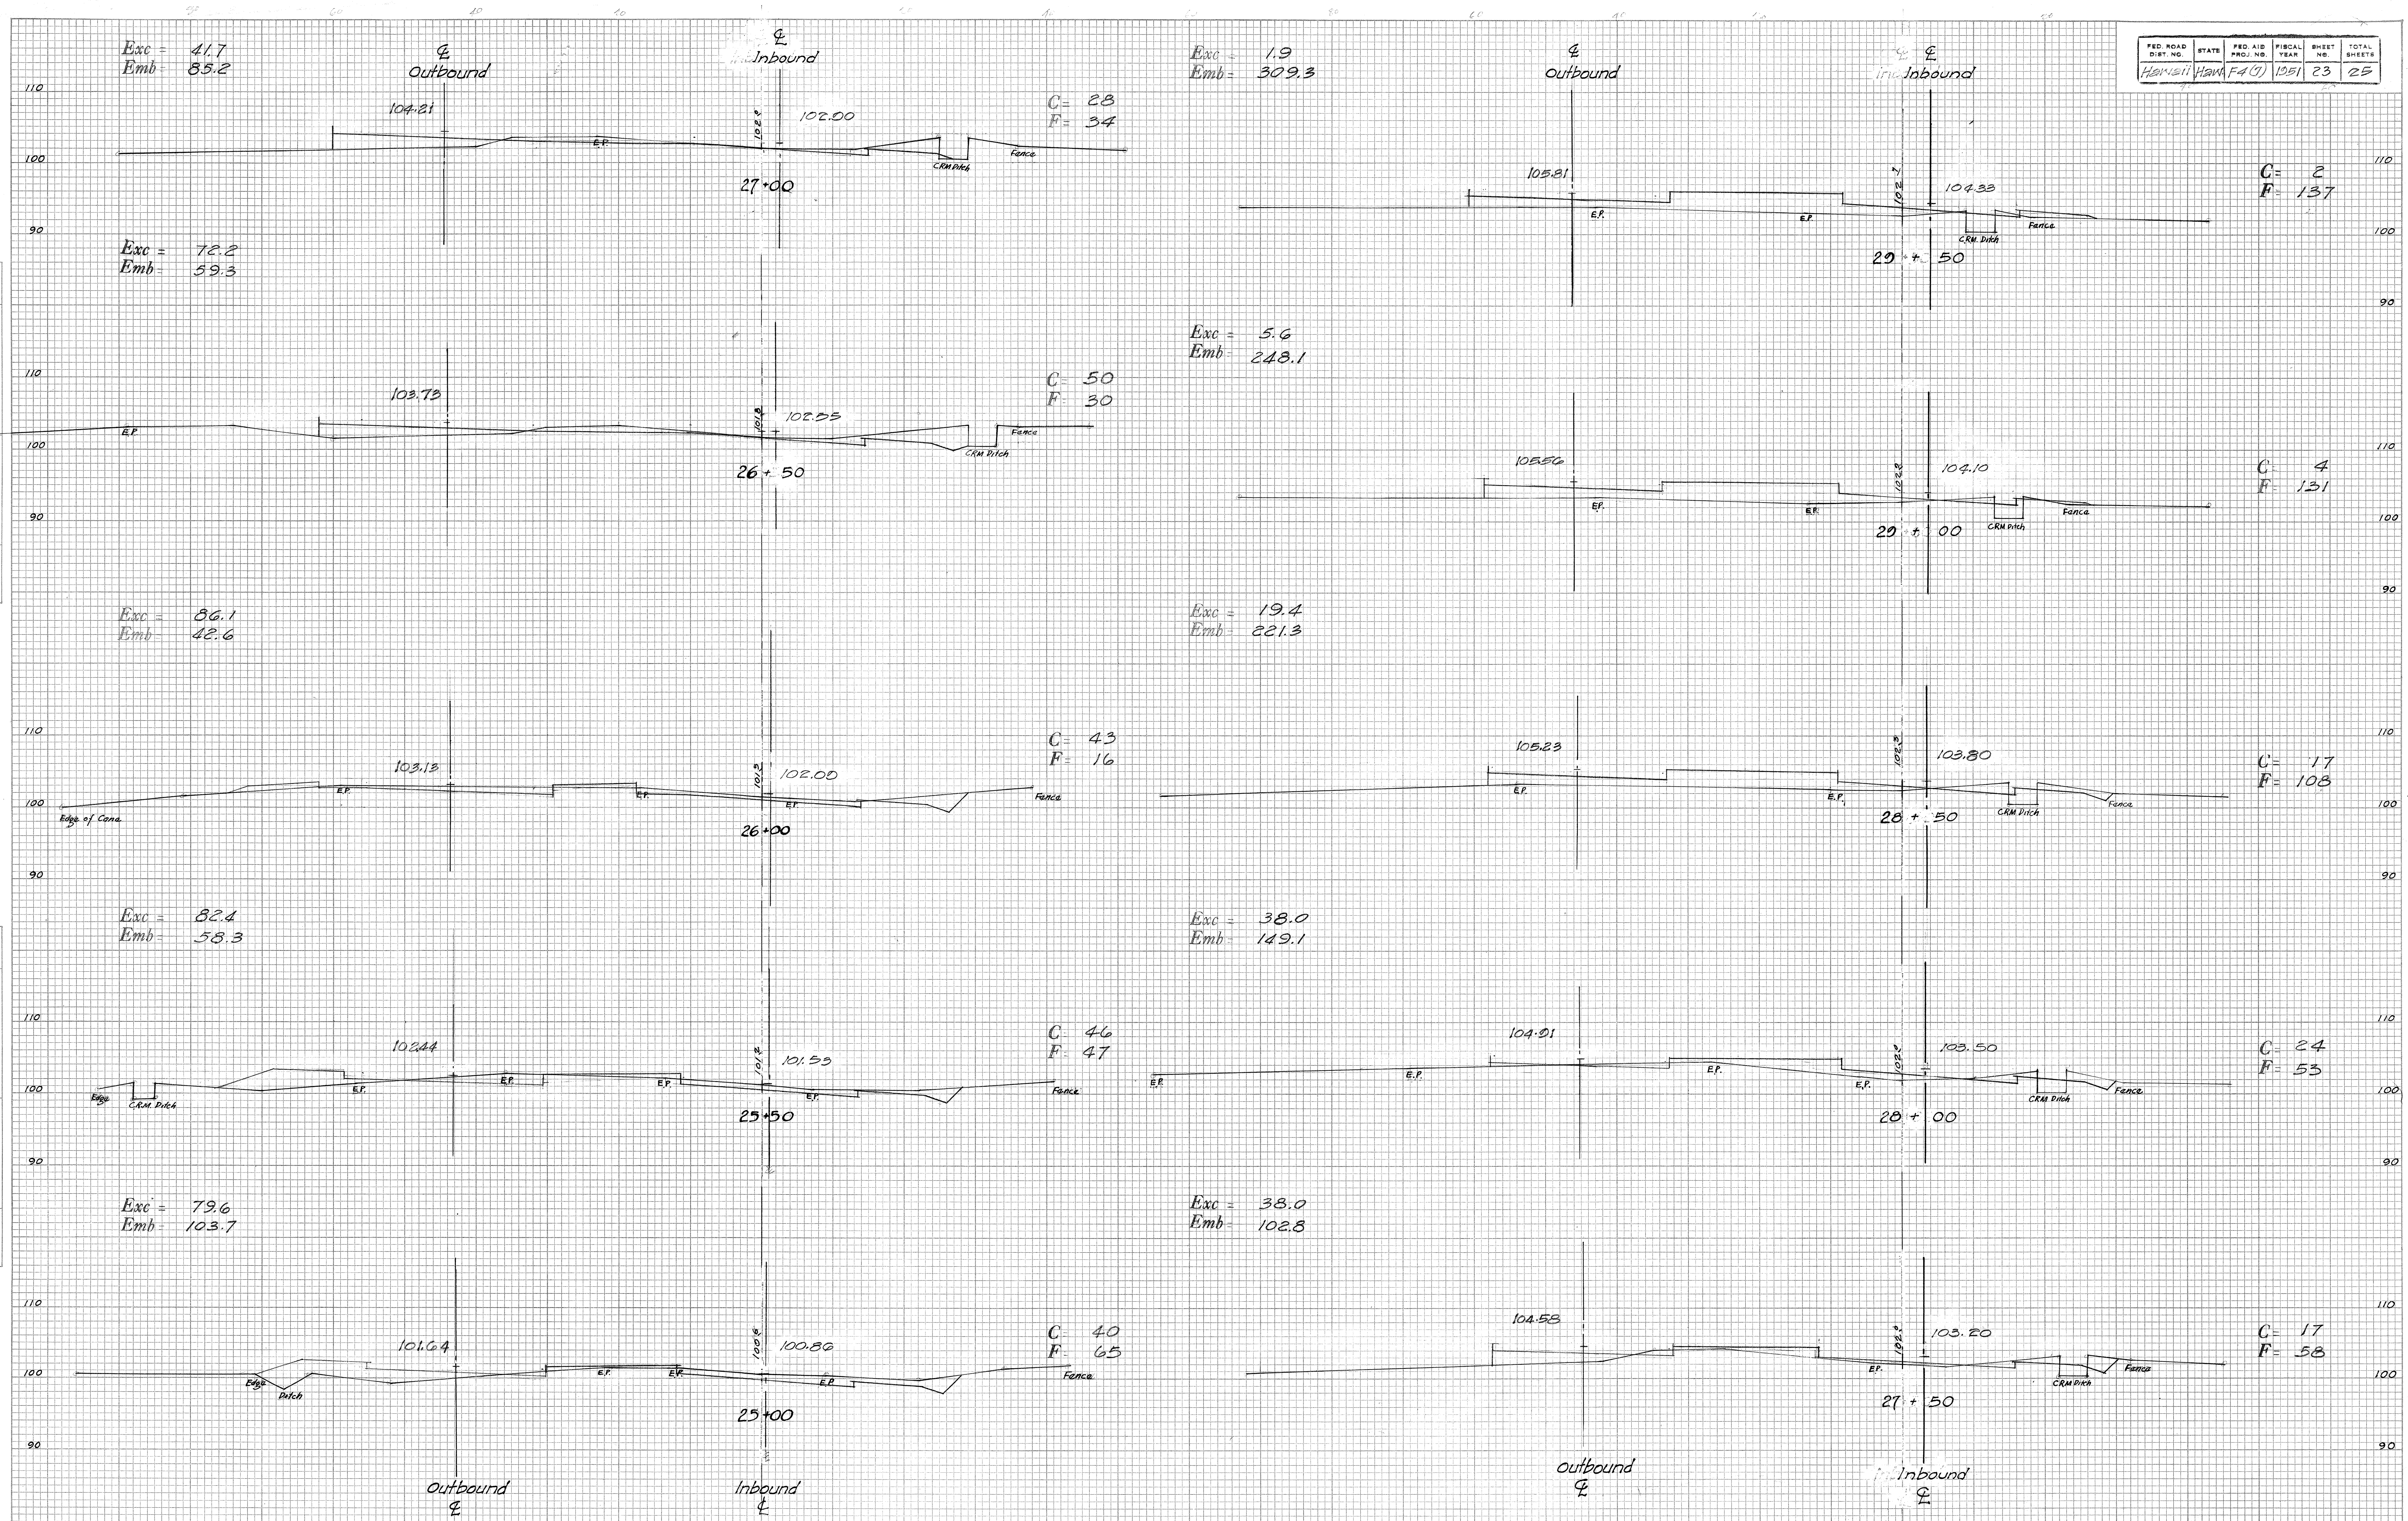


5 4 7⁴ 7 . 2 3

FED. ROAD DIST. NO.	STATE	FED. AID PROJ. NO.	FISCAL YEAR	SHEET NO.	TOTAL SHEETS
Hawaii	Hon.	F4(7)	1951	24	25

FINAL SURVEY	DATE
SURVEYED	BY
NOTED	
TEMP. DATE	
NOTE BOOK	
AREAS	
CHECKED	
NO.	


ORIGINAL SURVEY	DATE
SURVEYED	BY
NOTED	
TEMP. DATE	
NOTE BOOK	
AREAS	
CHECKED	
NO.	

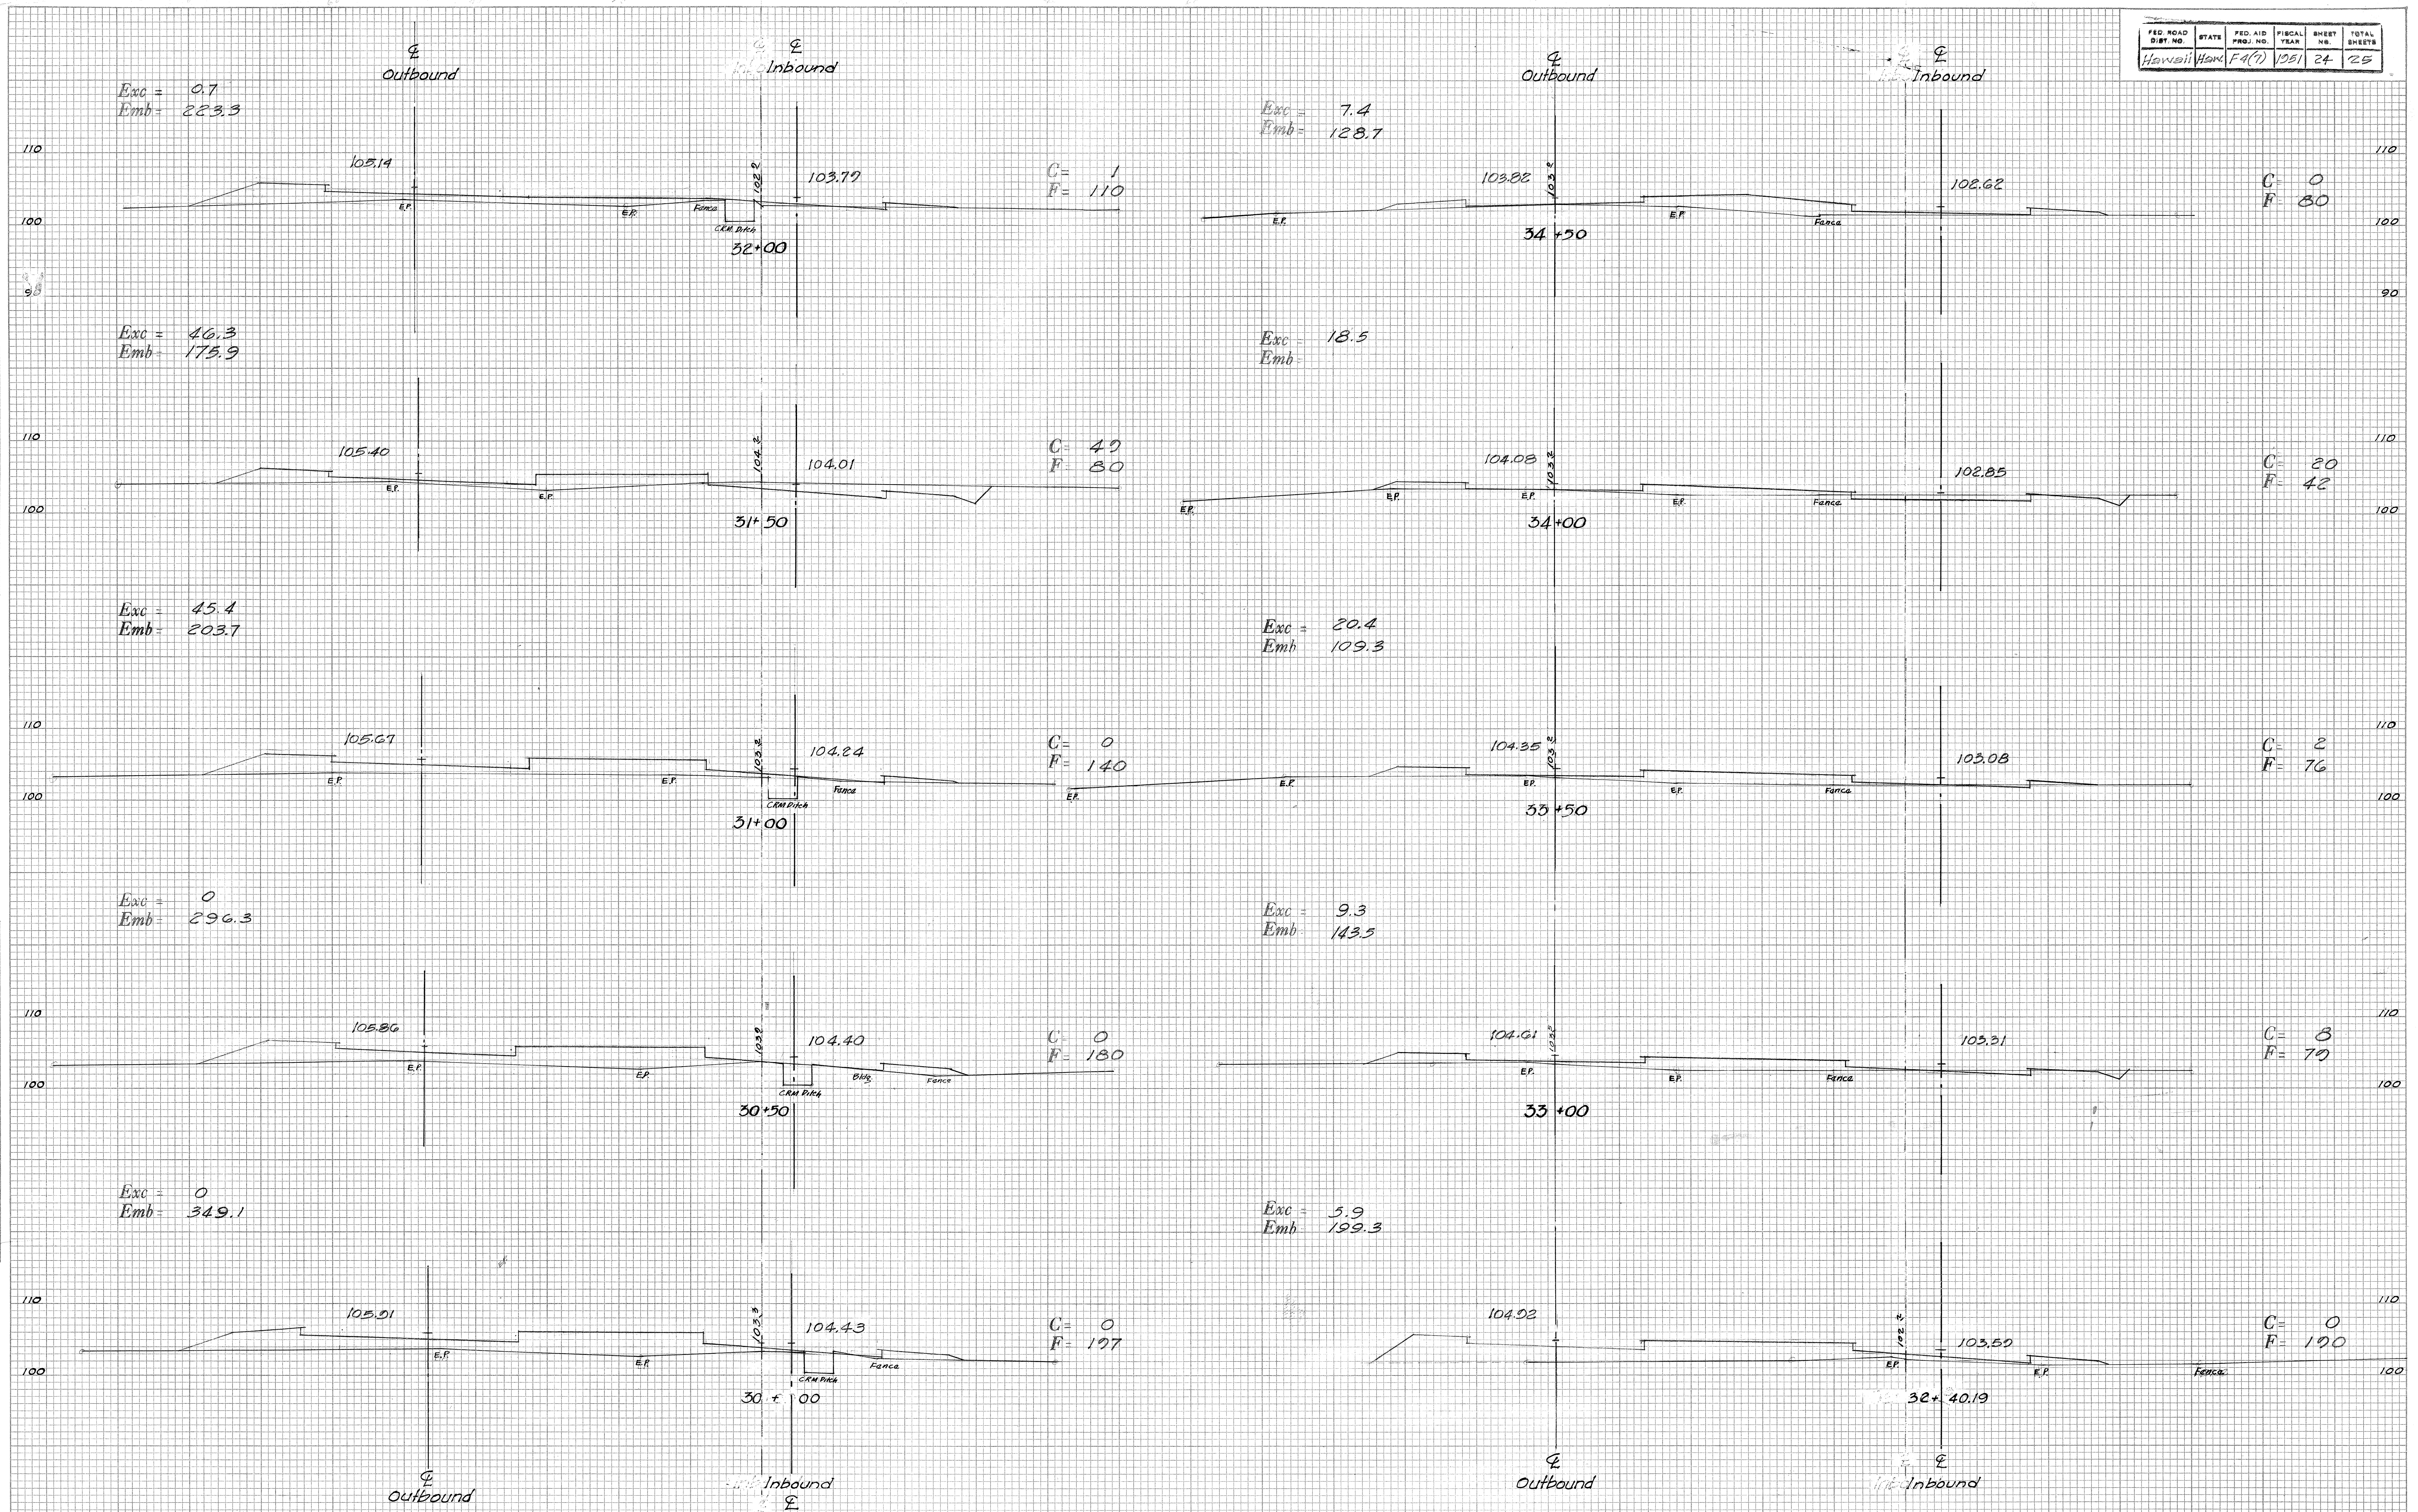

FED. ROAD DIST. NO.	STATE	FED. AID PROJ. NO.	FISCAL YEAR	SHEET NO.	TOTAL SHEETS
HAWAII	HAWAII	F-4(1)	1951	25	25

FINAL SURVEY NO.	SURVEYED BY	DATE

ORIGINAL SURVEY NO.	SURVEYED BY	DATE

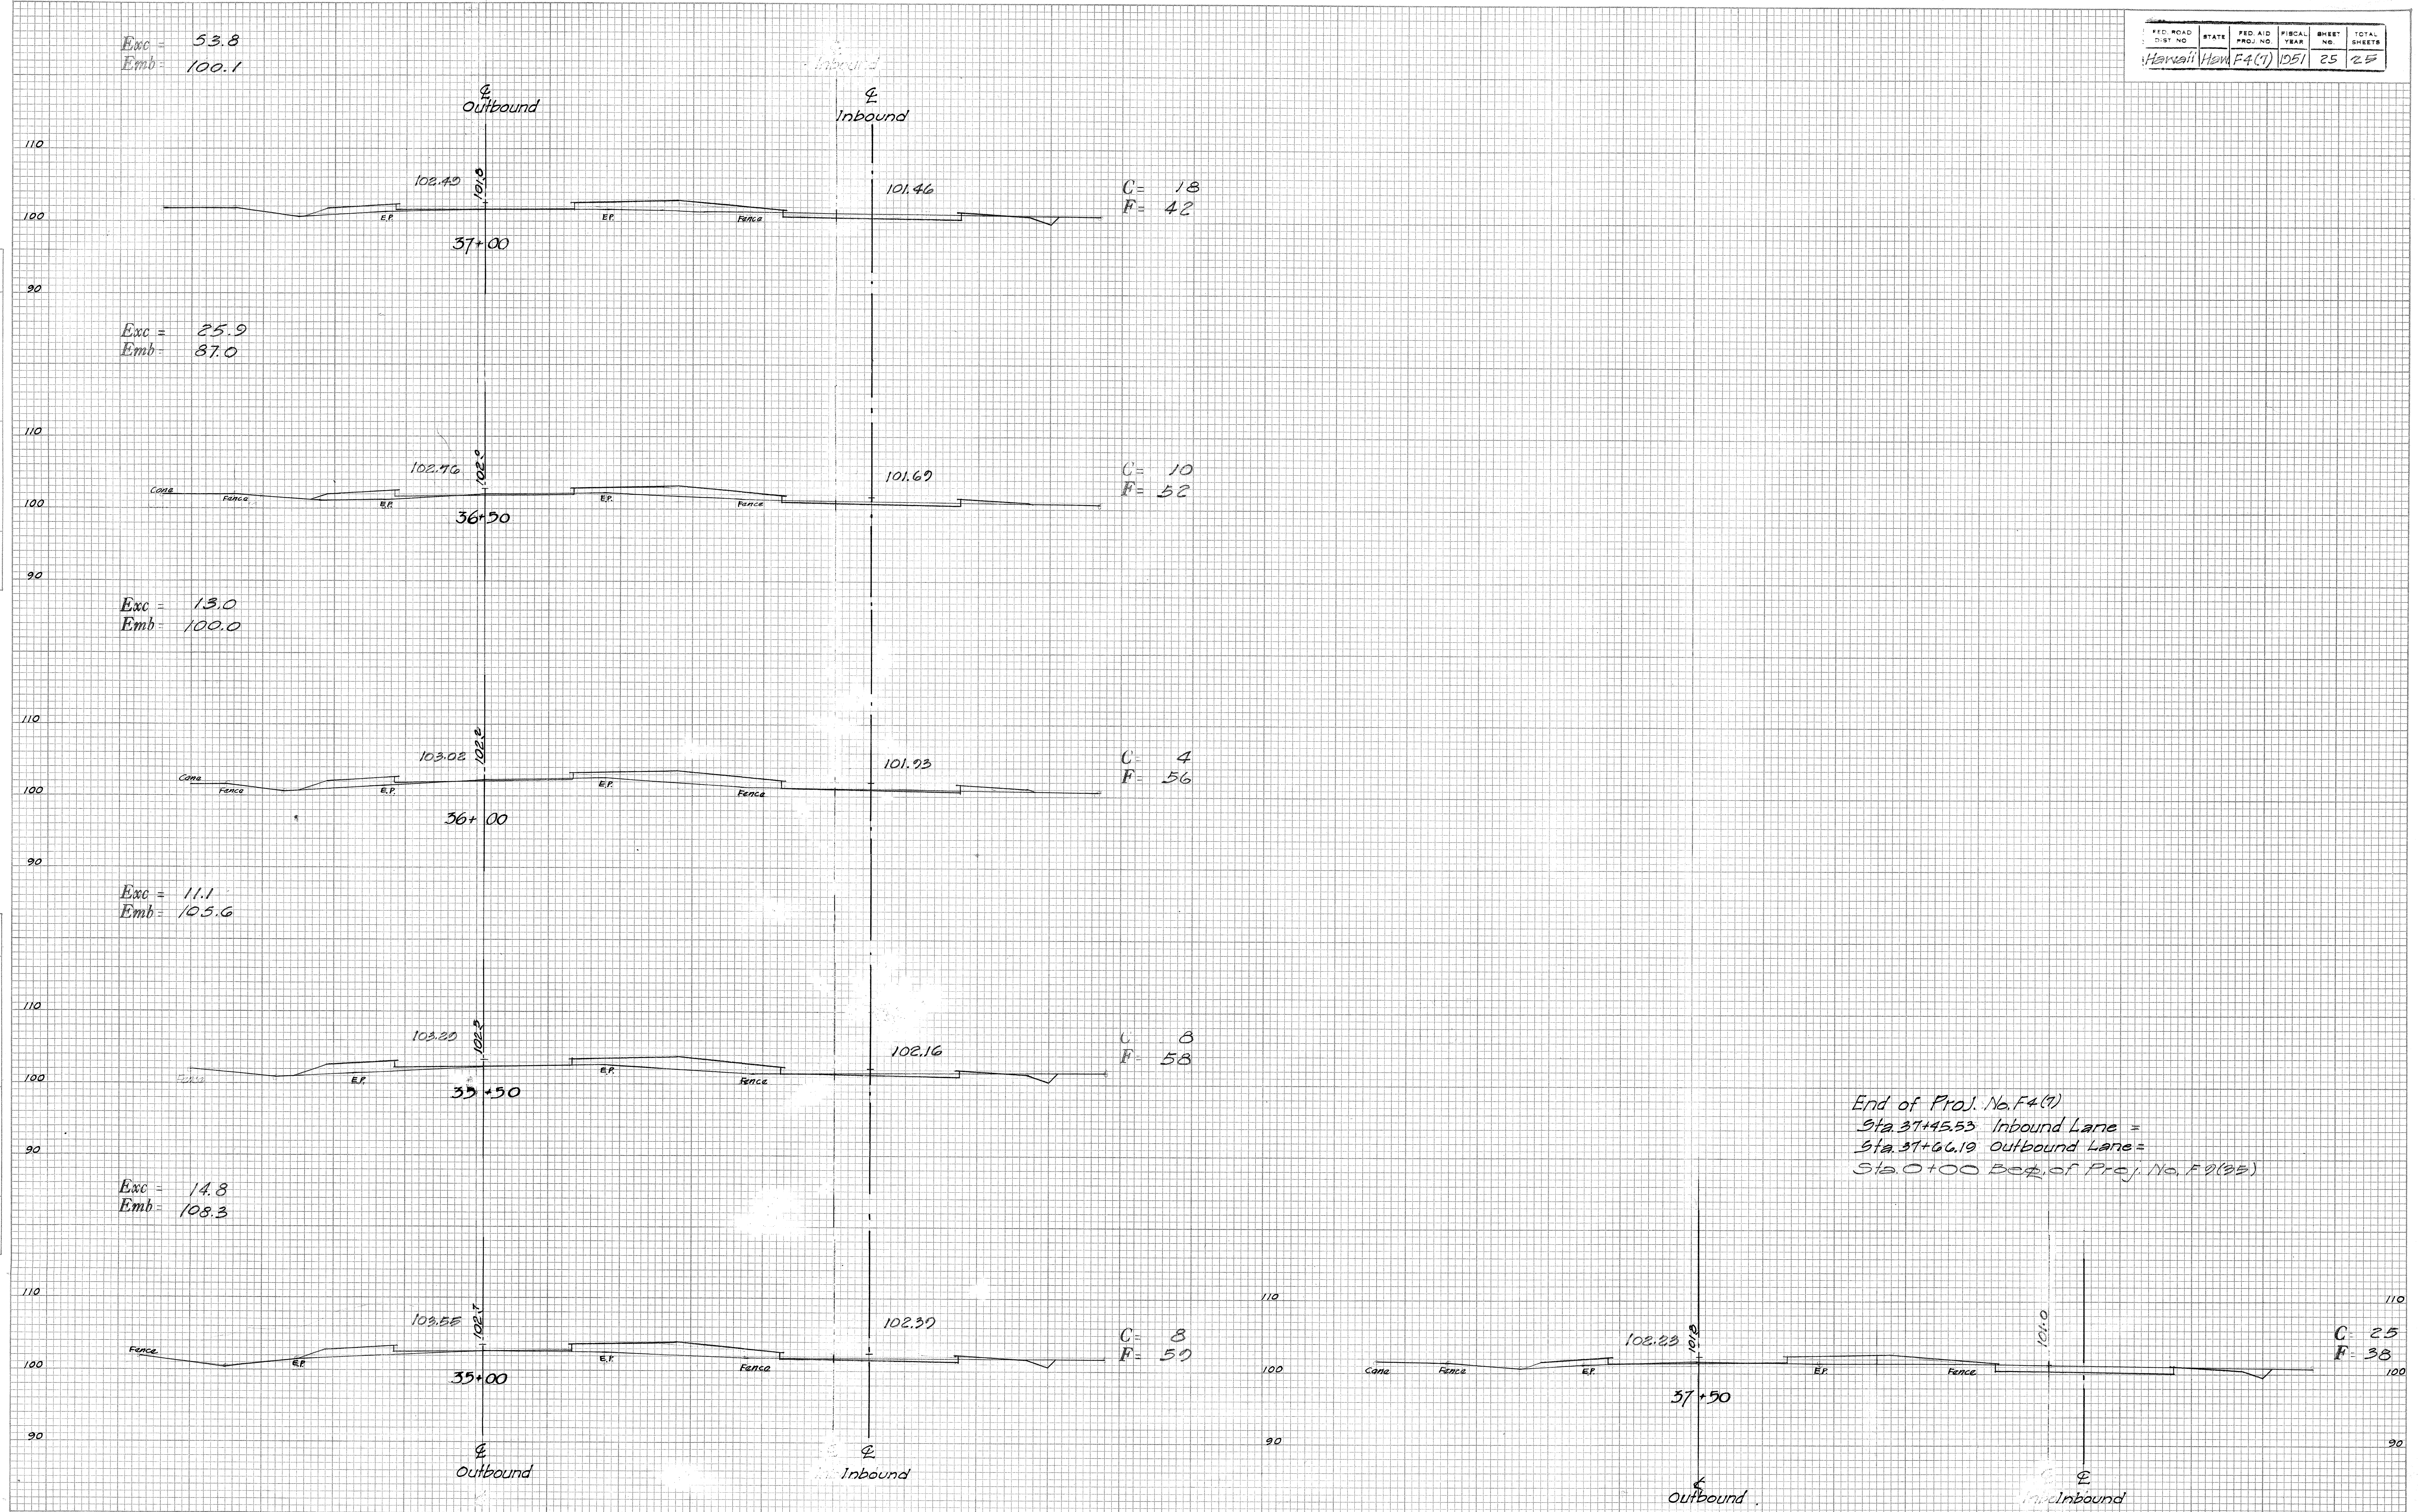

End of Proj. No. F-4(1)
Sta. 37+45.53 Inbound Lane =
Sta. 37+46.19 Outbound Lane =
Sta. 0+00 Beg. of Proj. No. F-2(2B)