


TYPICAL SECTION ON TANGENT

STA. 4+00 TO STA 24+18±

Scale: 1/4" = 1'-0"

GENERAL NOTES ON PAVEMENT AND BASE COURSE


- (1) Pavement shall be Asphalt Concrete 2 1/2" thick when fully compacted, laid in Two Courses. A 1 1/2" Leveling Course using Mix No. III, and a 1" Surface Course using Mix No. I.
- (2) Base Course shall be Waterbound Macadam Base Course of 8" compacted thickness, laid in 2 layers of 4" compacted thickness each and consisting of Coarse Rock and Filler (1/2" to No. 100). Both above Courses subject to Specifications and Special Provisions.
- (3) Slow Curing Liquid Asphalt for Prime Coat shall be applied to the surface of the Base Course at the rate of 0.35 gal. per sq. yd. before placing the Leveling Course.
- (4) The Reconstructed Rock Base Course shall be built up to 8" minimum, using Crushed Rock, size No. 3 and size No. 8.

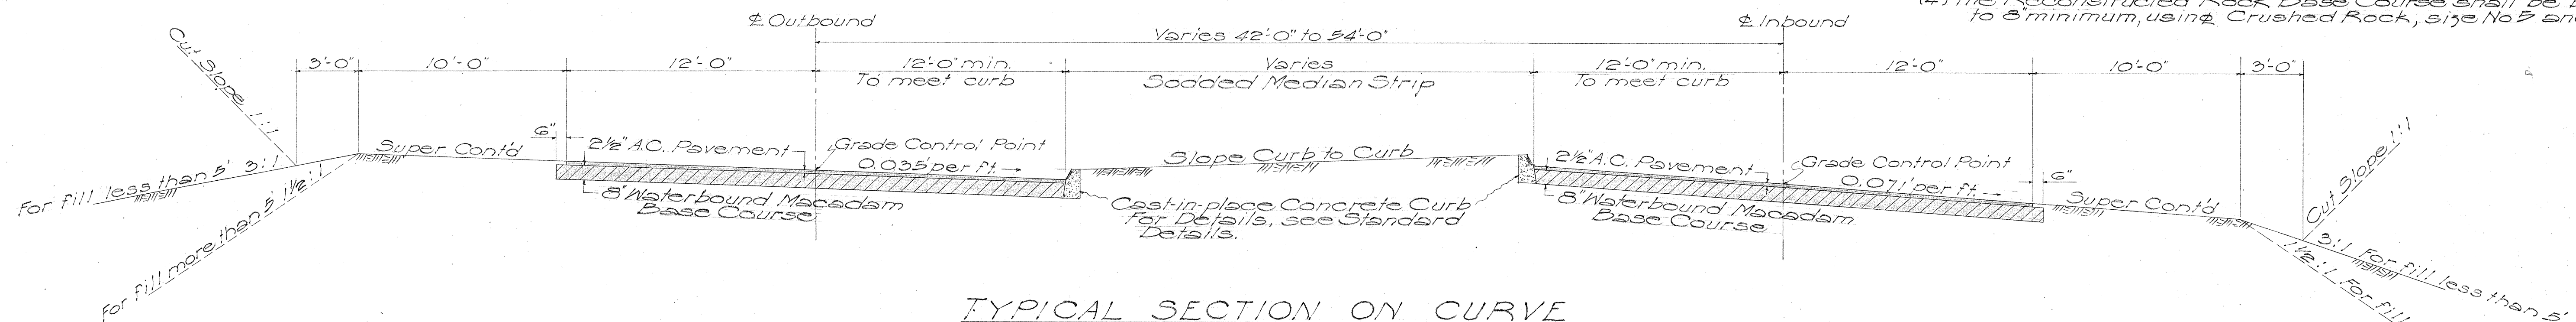

TYPICAL SECTION ON CURVE

STA 24+18± TO STA 32+67±

Scale: 1/4" = 1'-0"

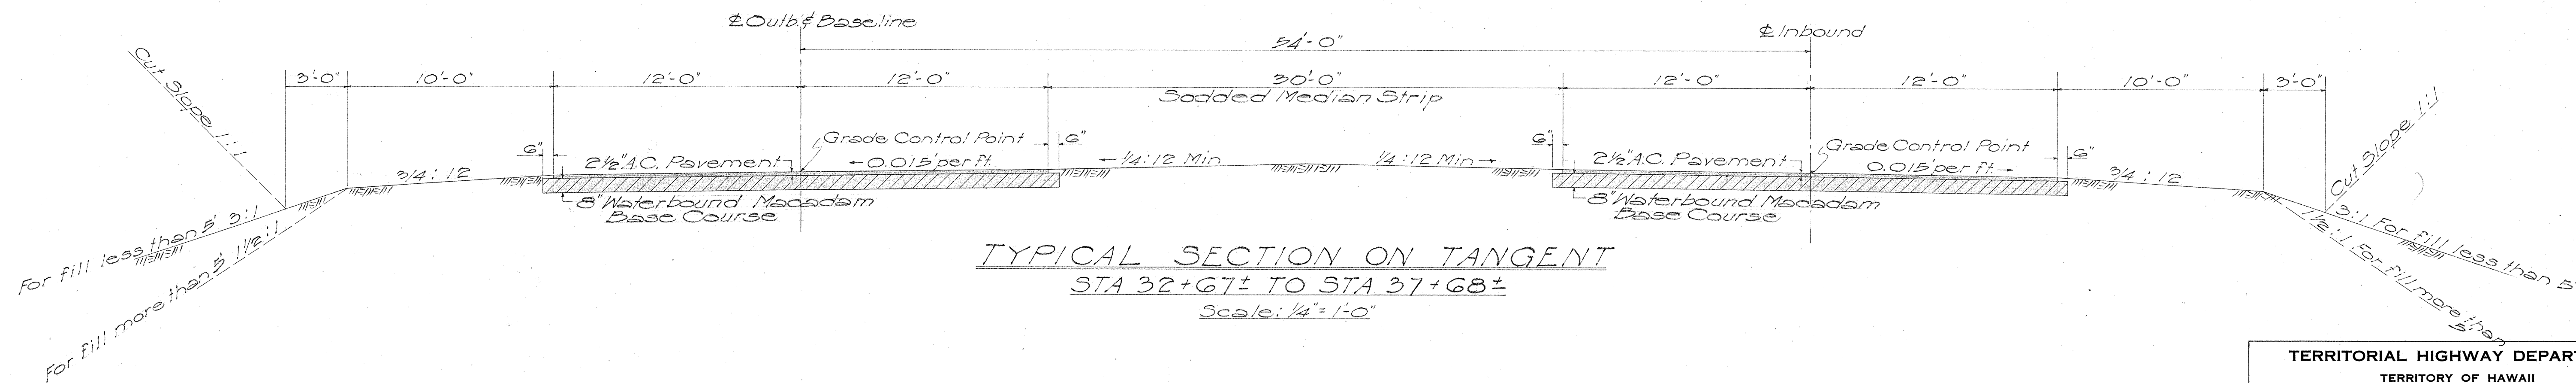

TYPICAL SECTION ON TANGENT

STA 32+67± TO STA 37+68±

Scale: 1/4" = 1'-0"

TERRITORIAL HIGHWAY DEPARTMENT
TERRITORY OF HAWAII

TYPICAL SECTIONS
WAIANAE ROAD
PROJECT NO. F 4(7)

Scale: 1/4" = 1'-0"

May 1950

SHEET NO. OF SHEETS

5477.2

DATE	
SURVEY PLOTTED BY	
DESIGNED BY	
TRACED BY	
NOTE BOOK	
QUANTITIES CHECKED BY	
CHECKED BY	
NO.	