
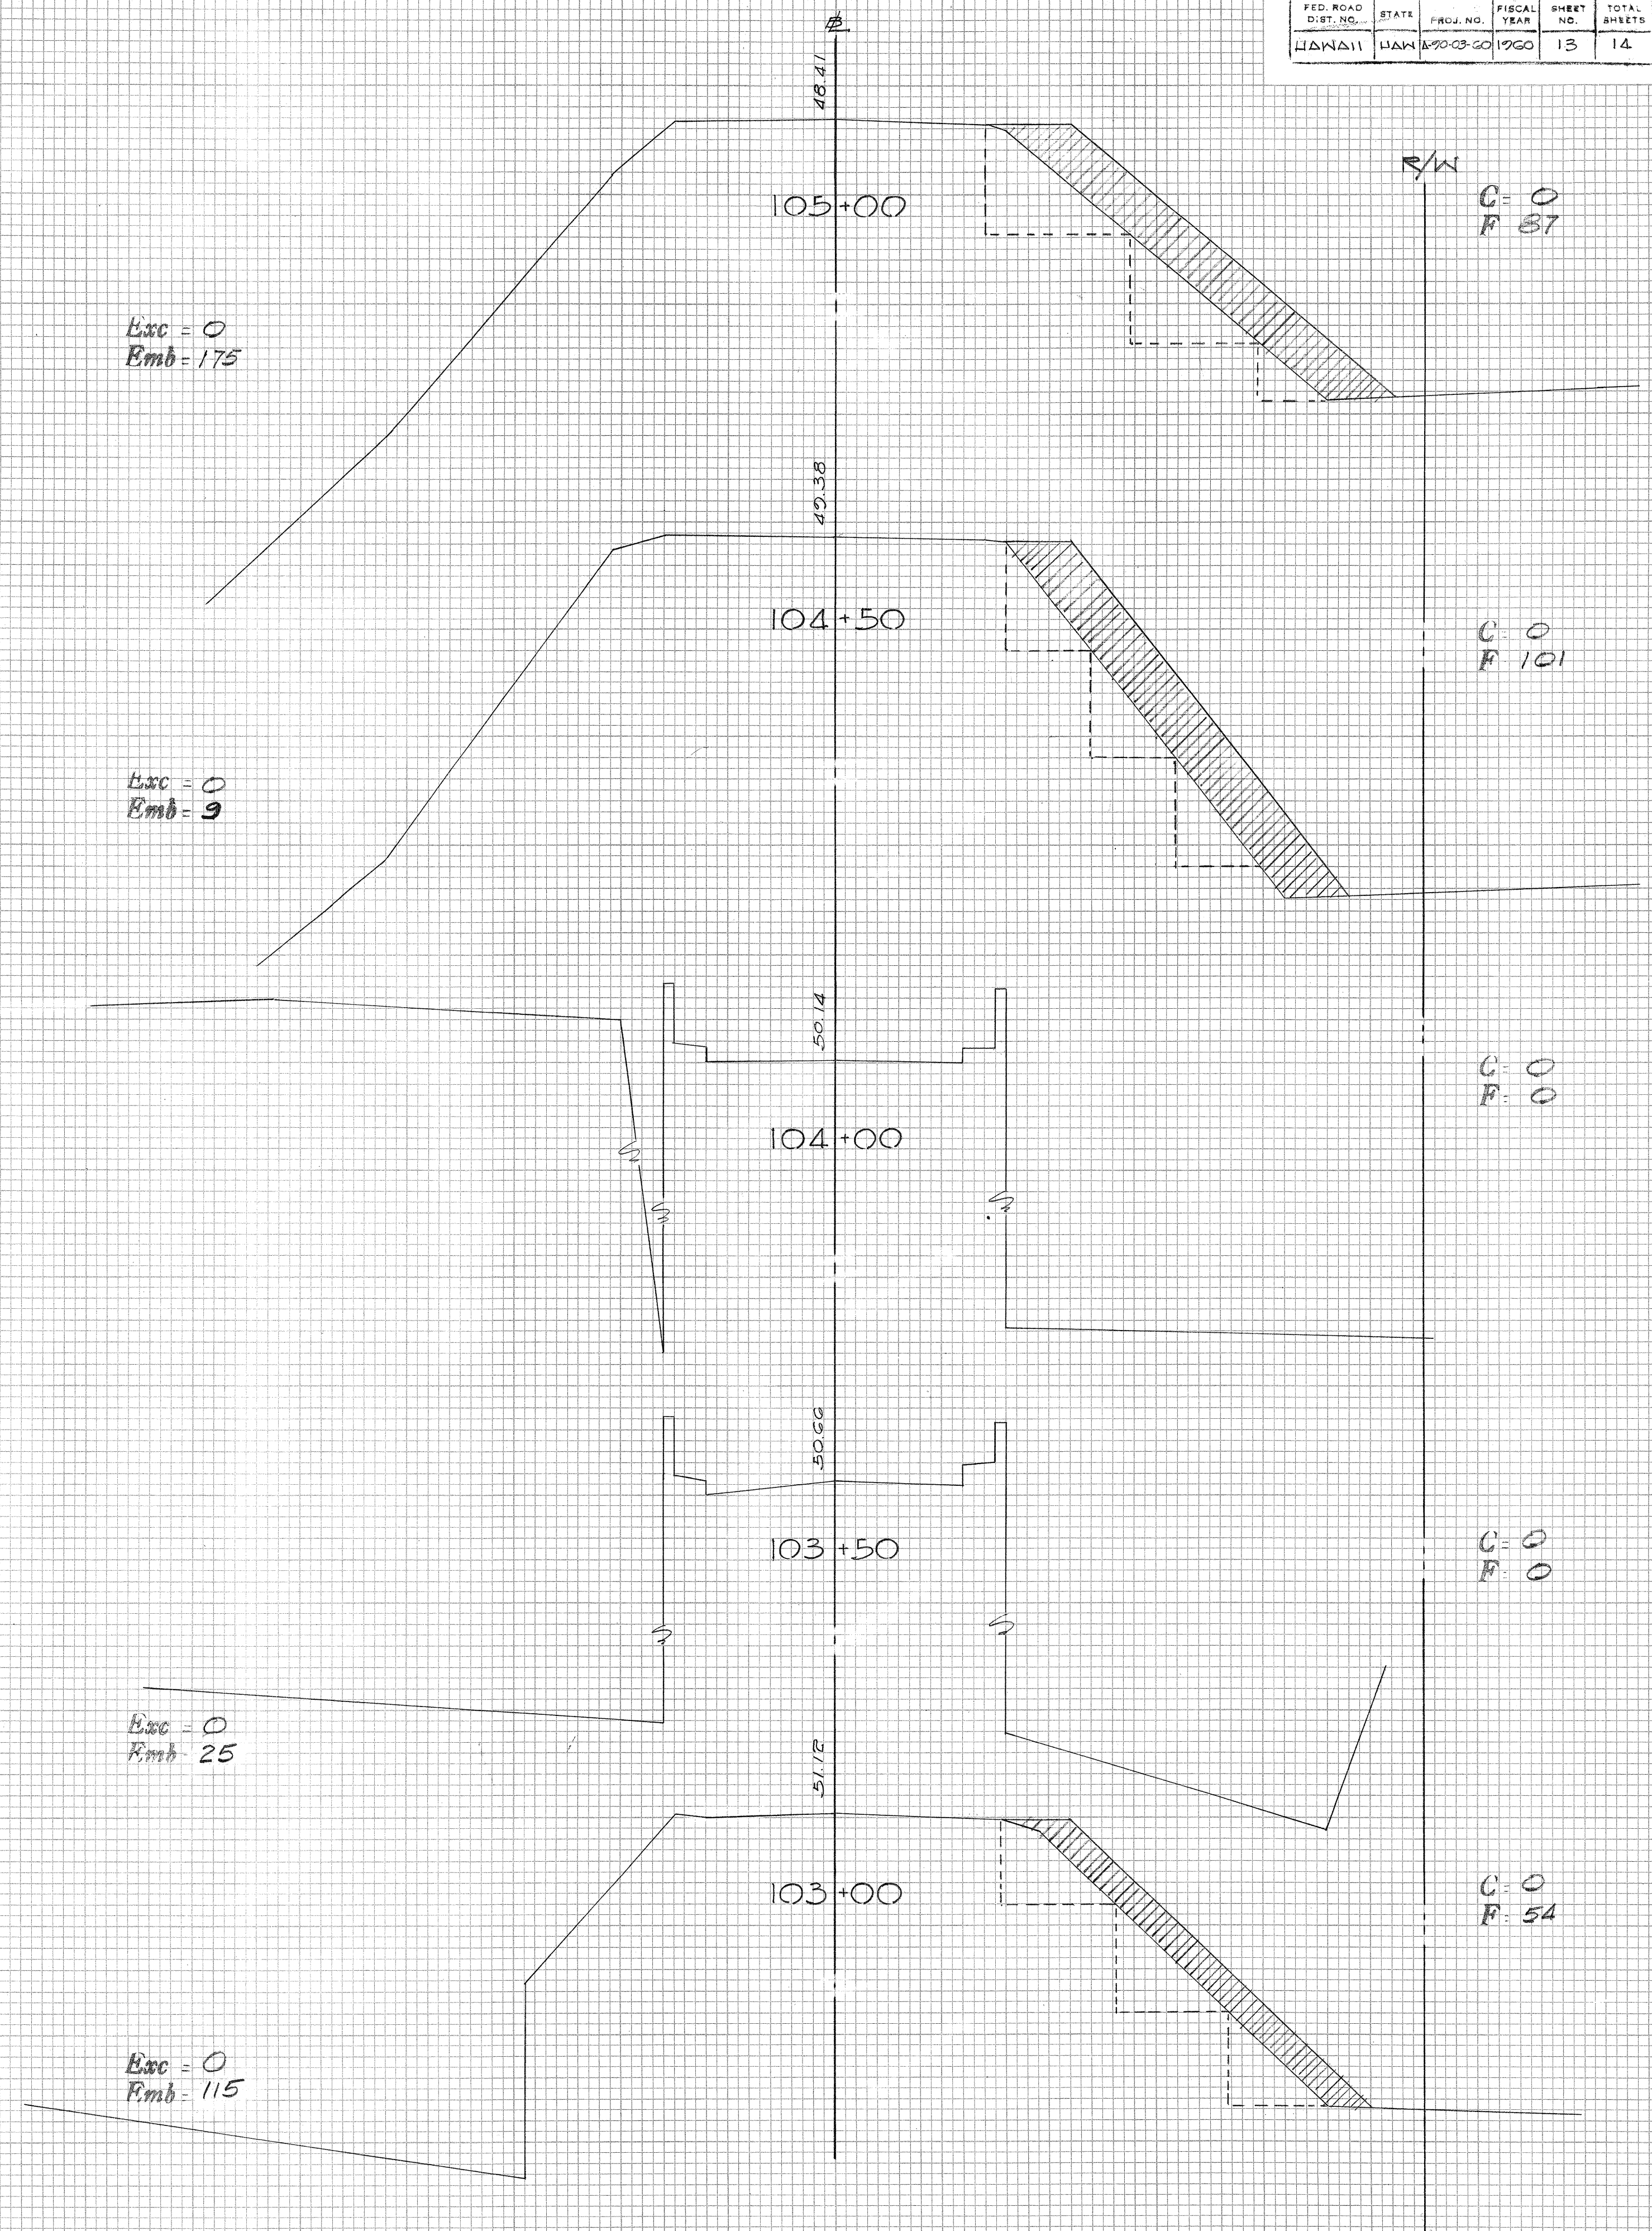


QUANTITIES SHOWN APPLIES TO CROSS-HATCHED
AREAS ONLY

FED. ROAD DIST. NO.	STATE	PROJ. NO.	FISCAL YEAR	SHEET NO.	TOTAL SHEETS
HAWAII	WAM	190-3-50	1960	13	14

FINAL SURVEY	DATE	BY
SURVEYED		
PLOTTED		
TEMPLATE		
NOTE BOOK		
NO.		
AREAS CHECKED		

ORIGINAL SURVEY	DATE	BY
SURVEYED		
PLOTTED		
TEMPLATE		
NOTE BOOK		
NO.		
AREAS CHECKED		

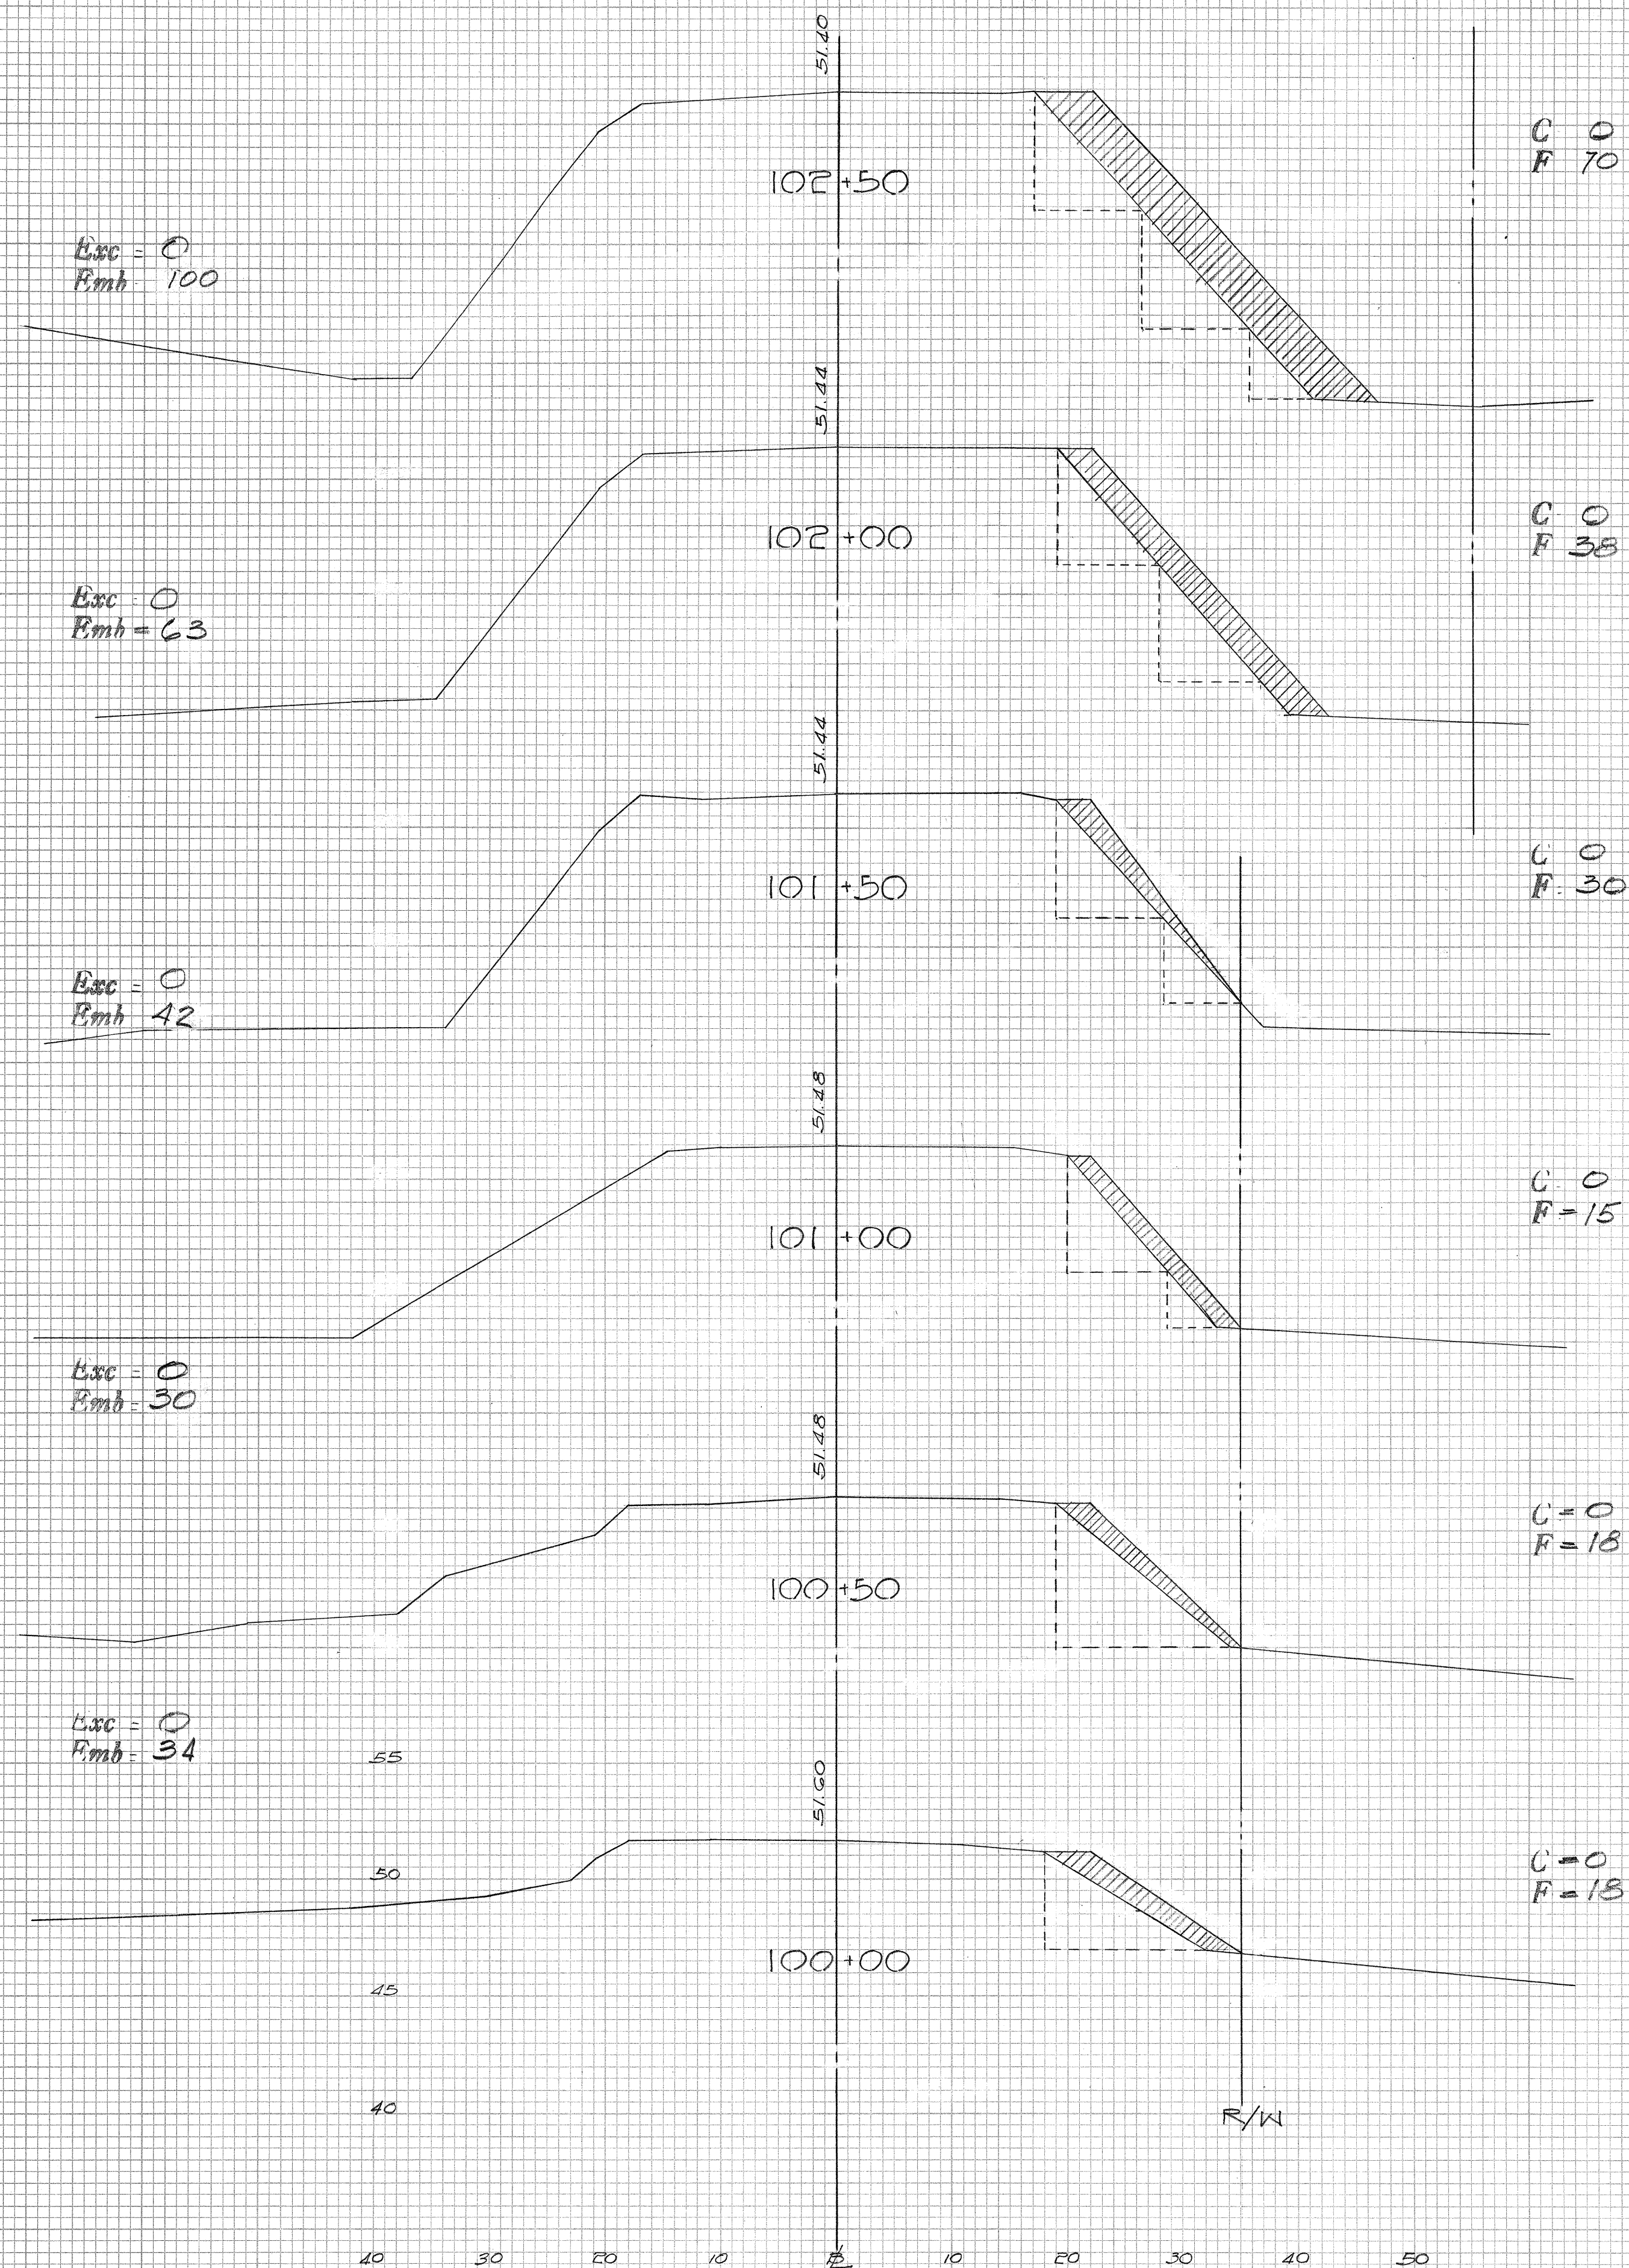

FINAL SURVEY	DATE
NO.	
BY	
SURVEYED	
TEMPLATE	
AREAS	
CHECKED	

ORIGINAL SURVEY	DATE
NO.	
BY	
SURVEYED	
TEMPLATE	
AREAS	
CHECKED	

