


INDEX TO DRAWINGS	
SHEET NO.	DESCRIPTION
1	TITLE SHEET
2-5	PLAN-(A-90-03-60)
6-11	PLAN-(B-90-04-60)
12	DETAILS-GUARD RAILS
13-14	CROSS SECTIONS

NOTE: All Changes Made During Construction Have Been Noted In Red On These Tracings And Checked By:

C. H. Patton
for DISTRICT ENGINEER

Dec. 29, 1960
DATE

LAYOUT OF PROJECT
Scale: 1" = 2000'

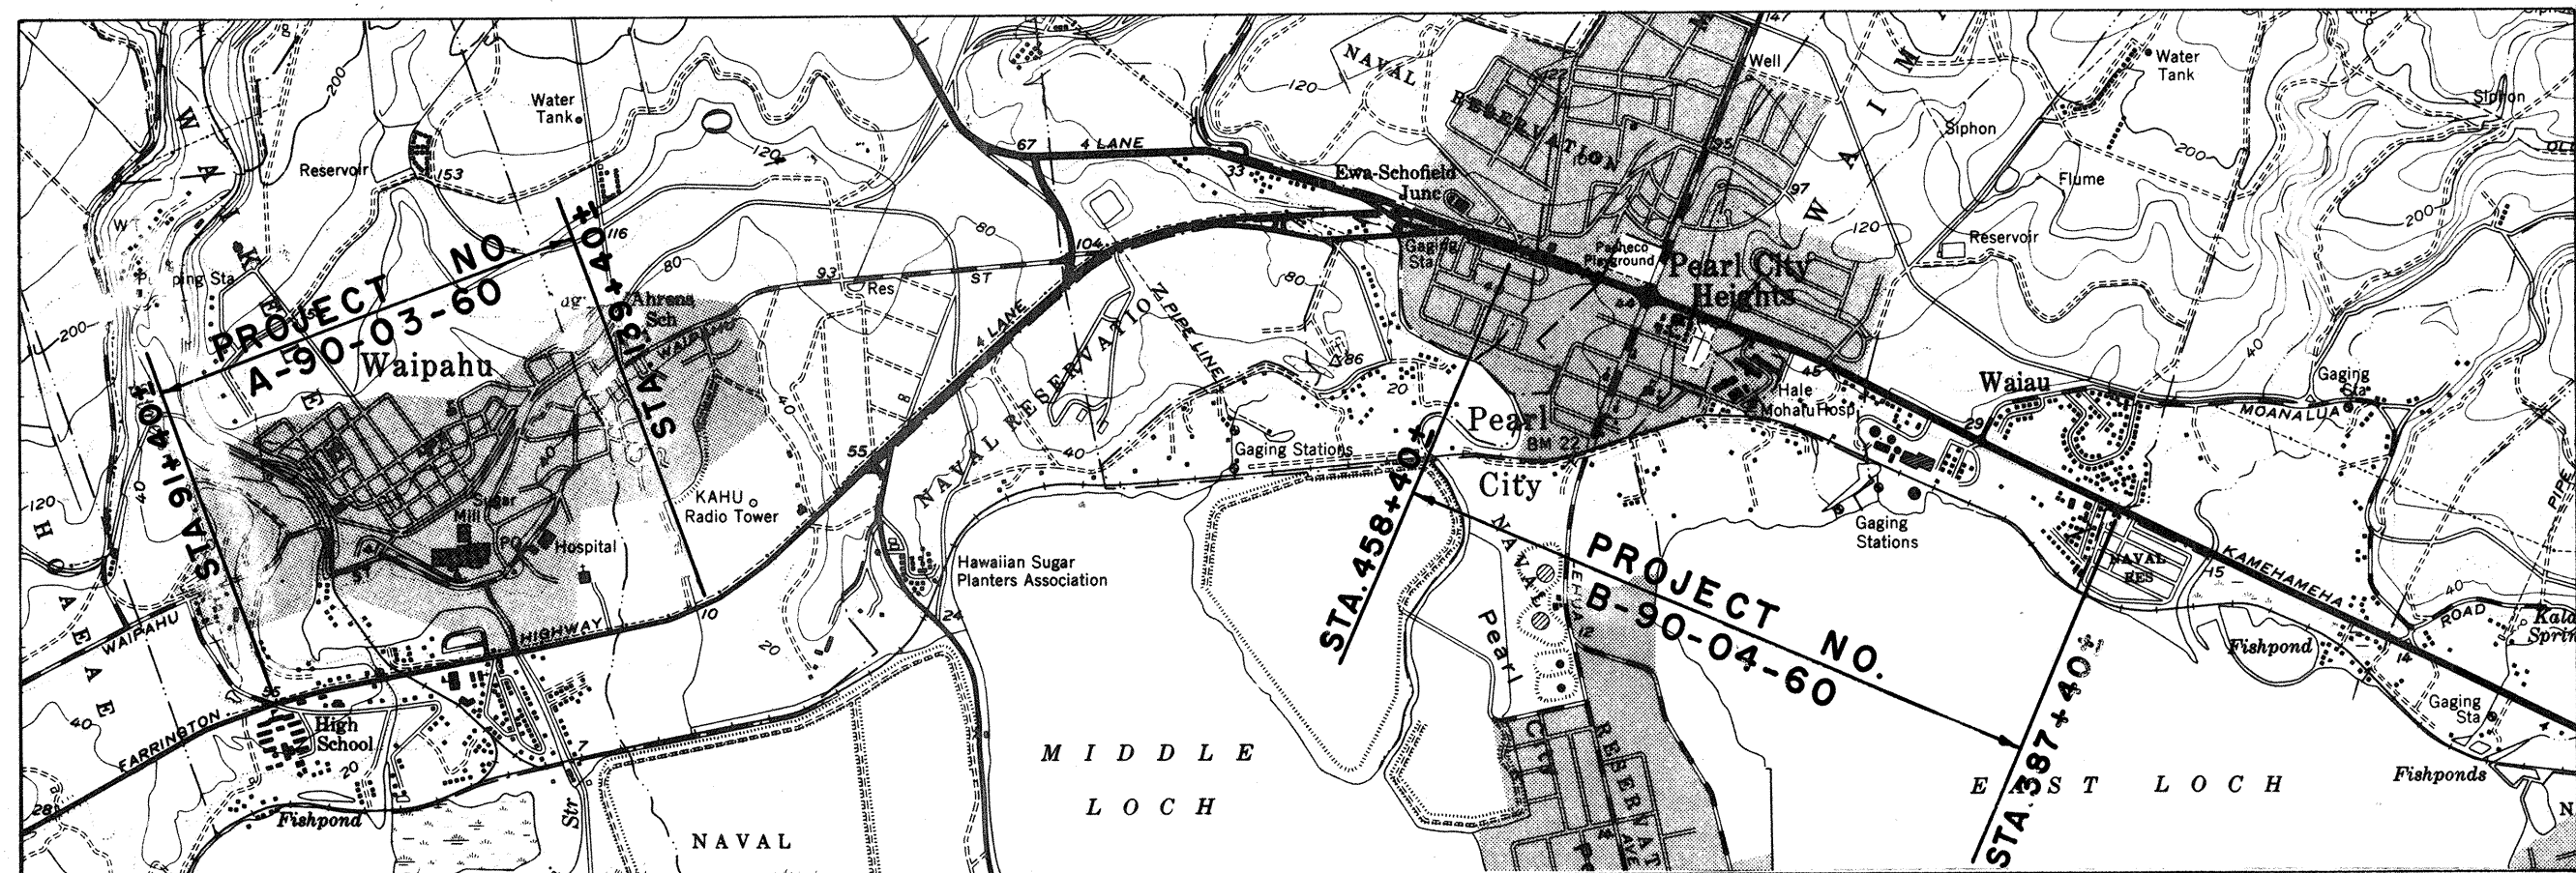


STATE OF HAWAII DEPARTMENT OF TRANSPORTATION BUREAU OF HIGHWAYS HONOLULU, HAWAII

AS BUILT PLANS FOR THE CONSTRUCTION OF PEDESTRIAN ASPHALT FOOTPATH AT CERTAIN LOCATIONS ON FARRINGTON HIGHWAY PROJ. NO. A-90-03-60

AND ON KAMEHAMEHA HIGHWAY PROJ. NO. B-90-04-60

DISTRICT OF EWA
ISLAND OF OAHU
1960

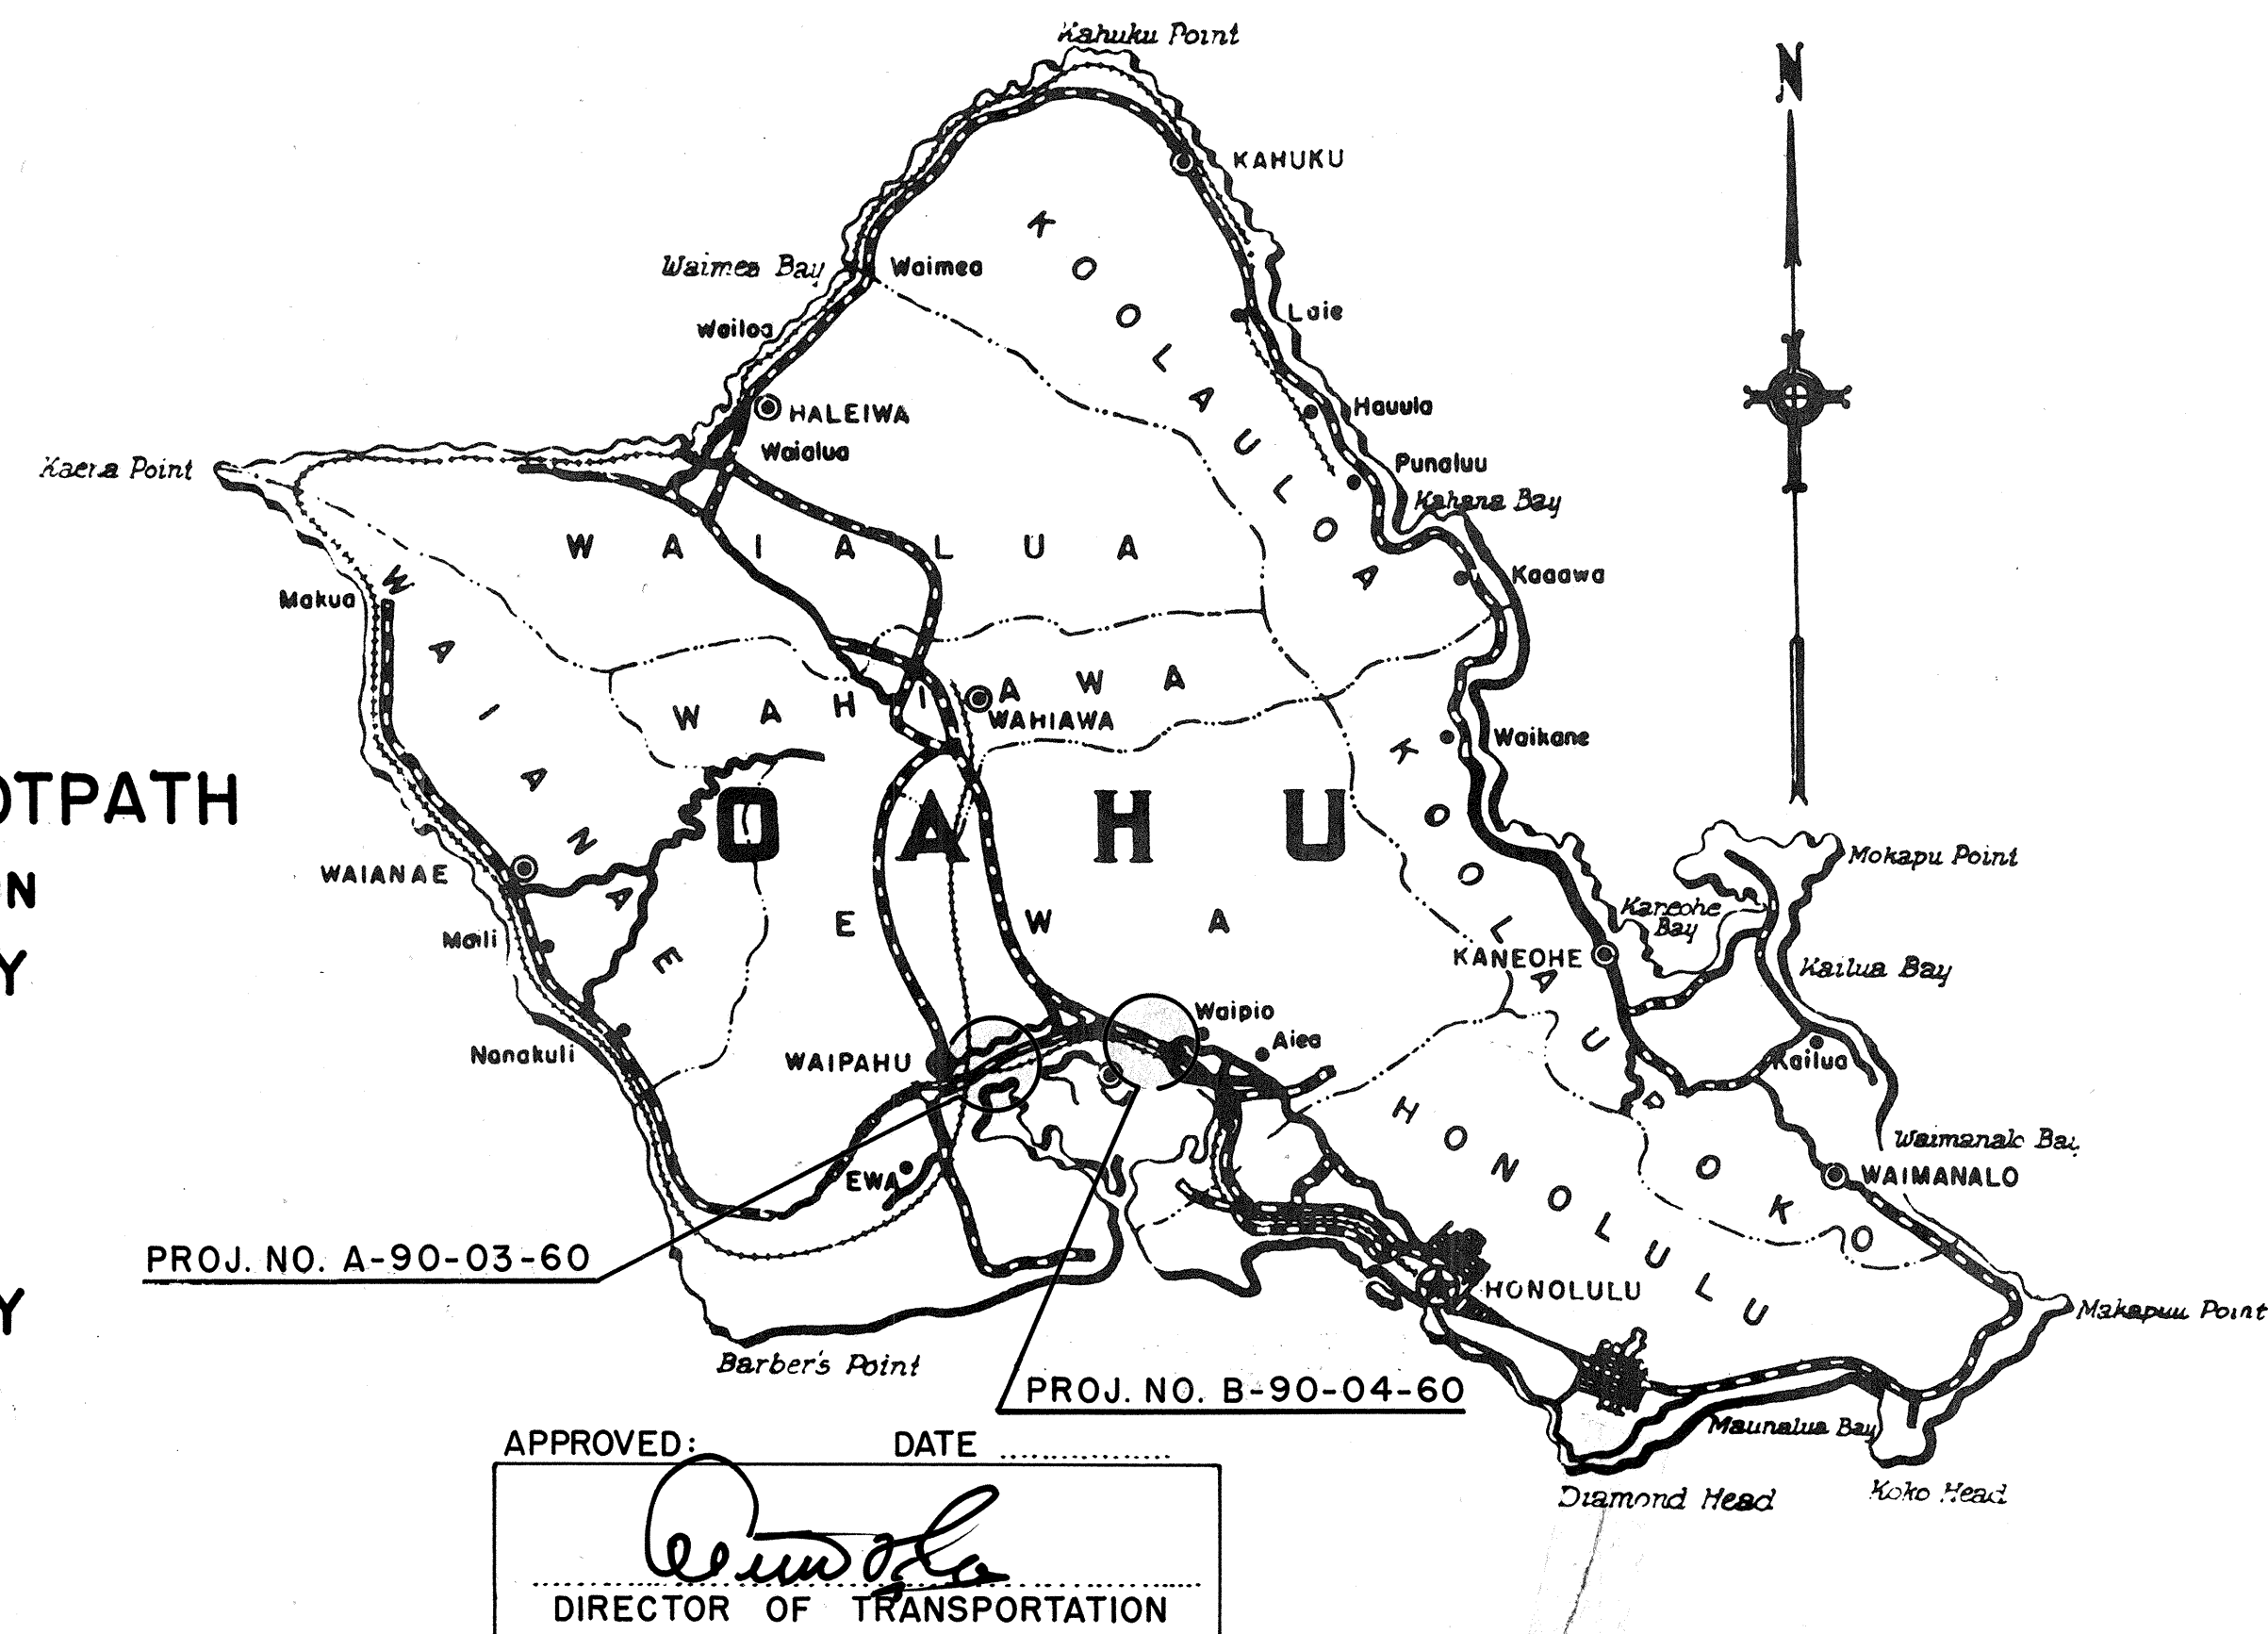

APPROVED: *[Signature]* DATE _____
DIRECTOR OF TRANSPORTATION