



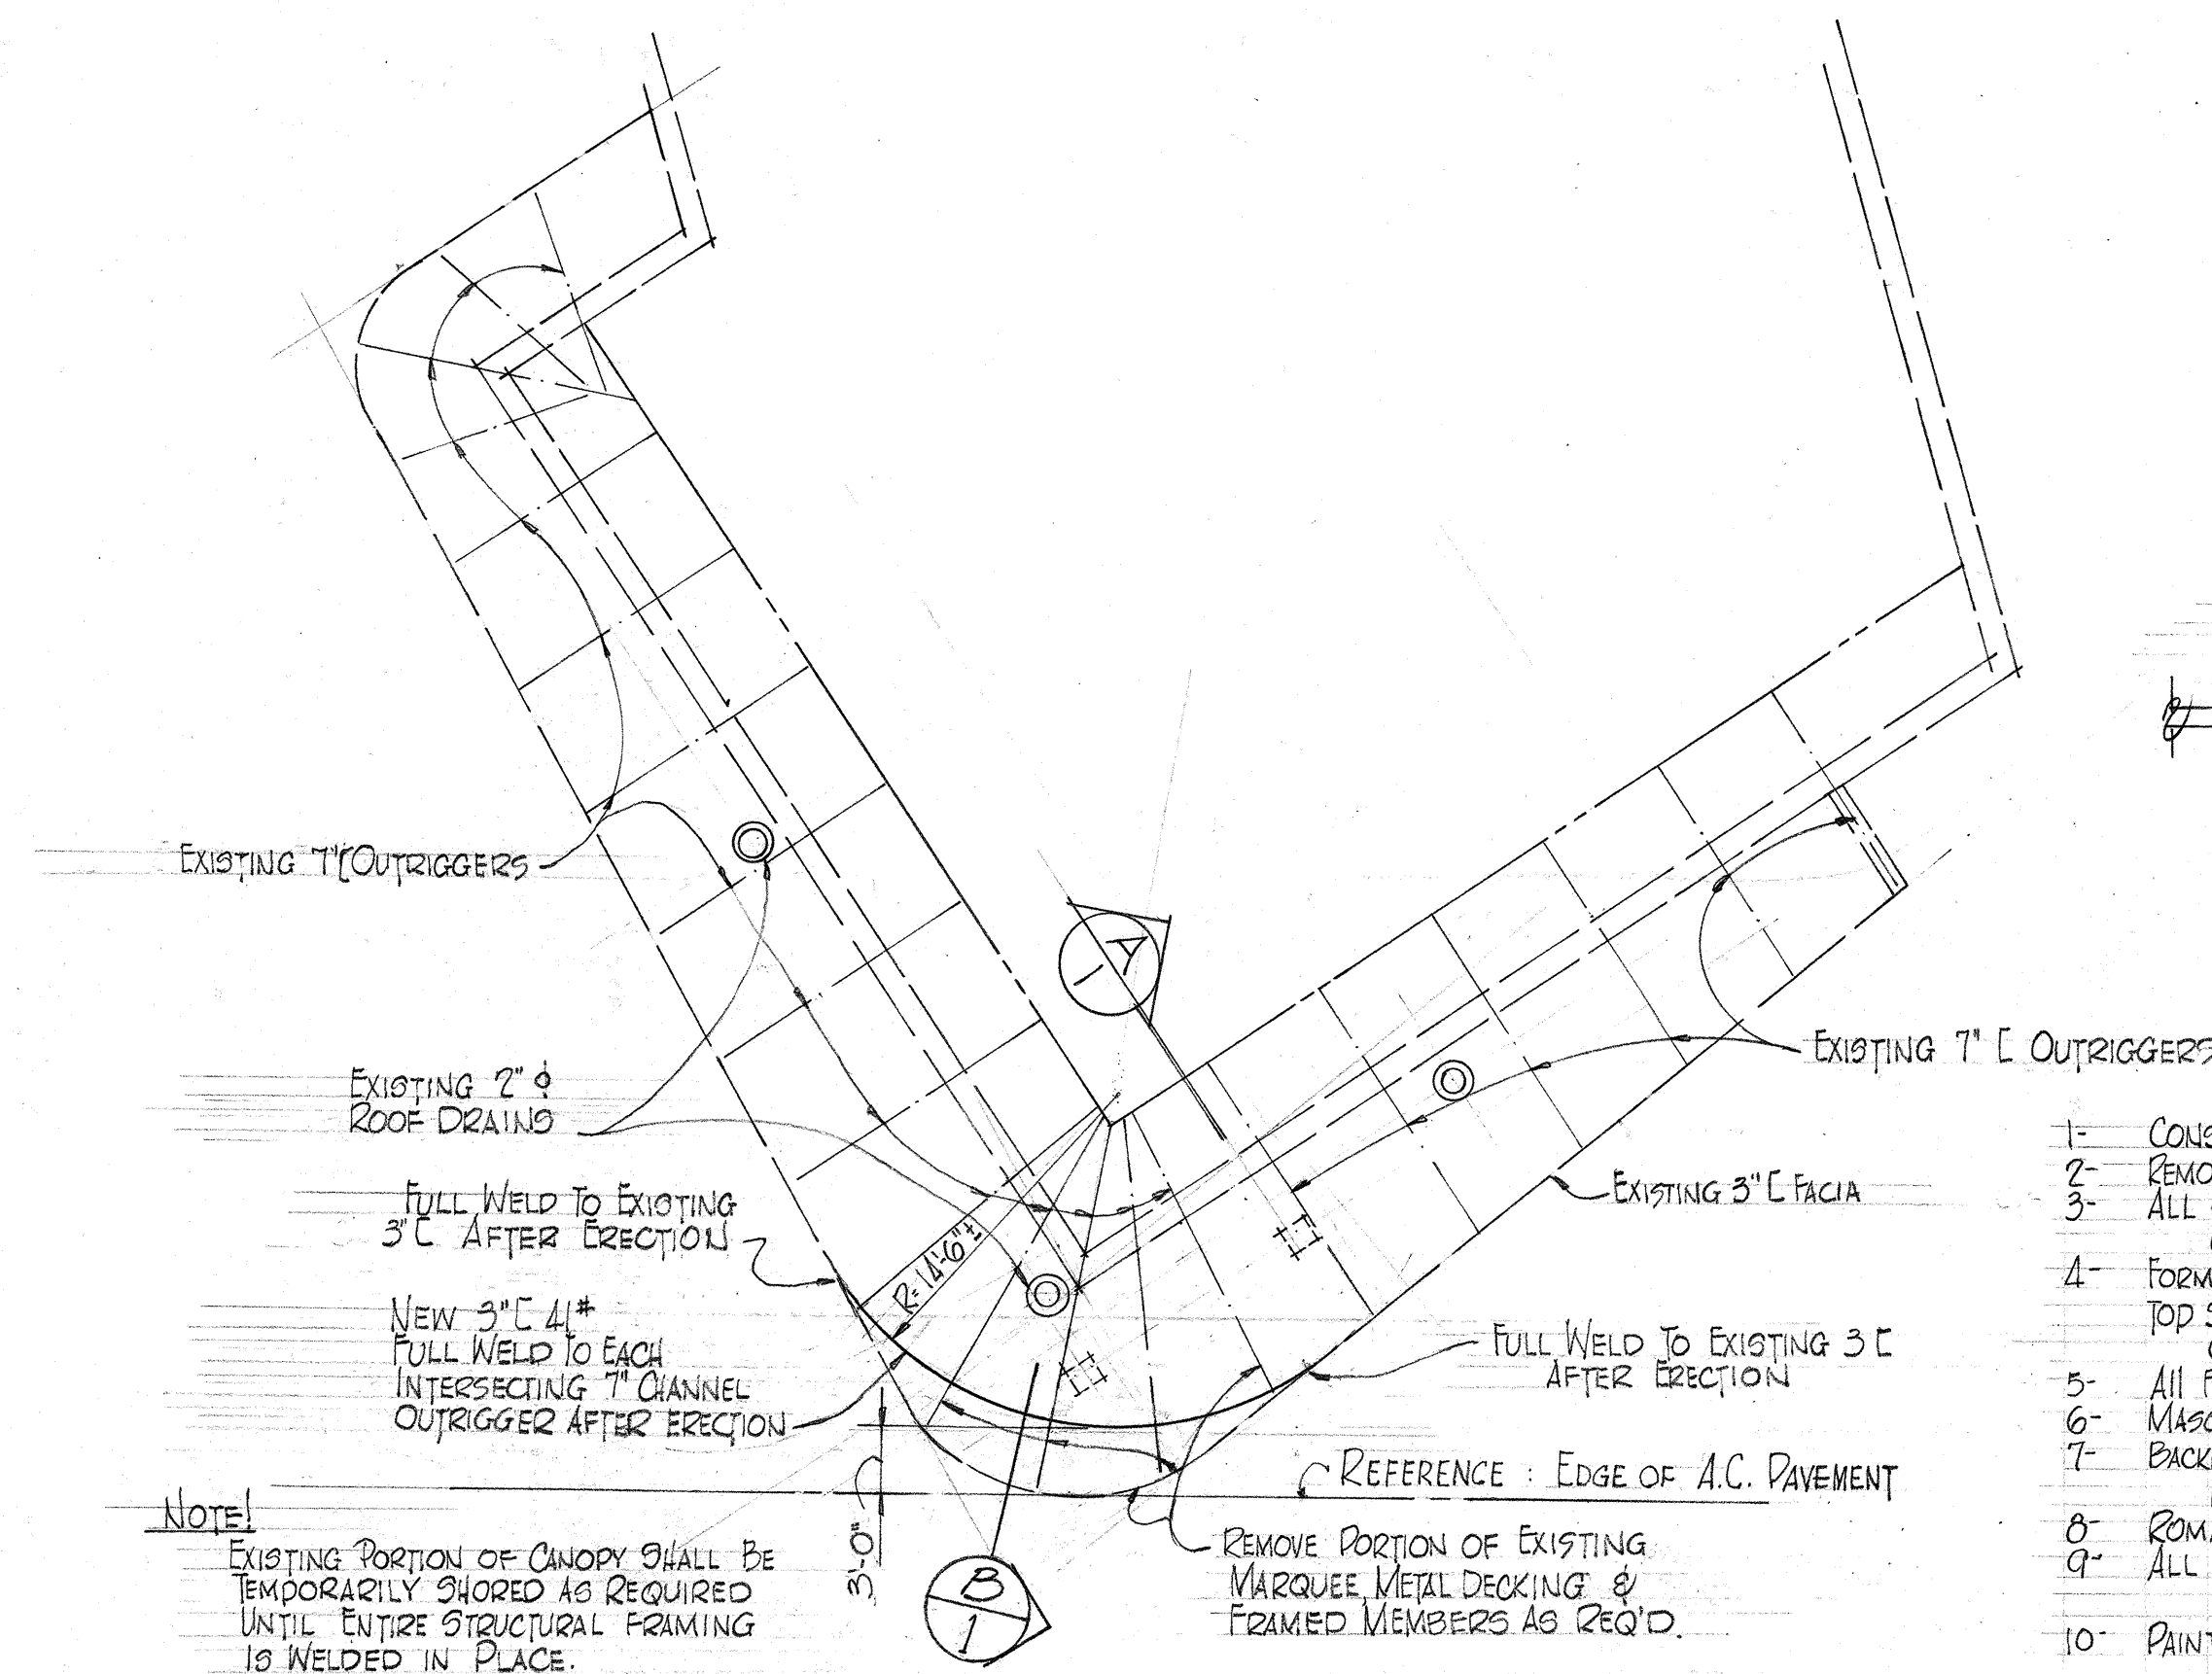

PART PLAN - MARQUEE FRAMING

SCALE: 1/8" = 1'-0"

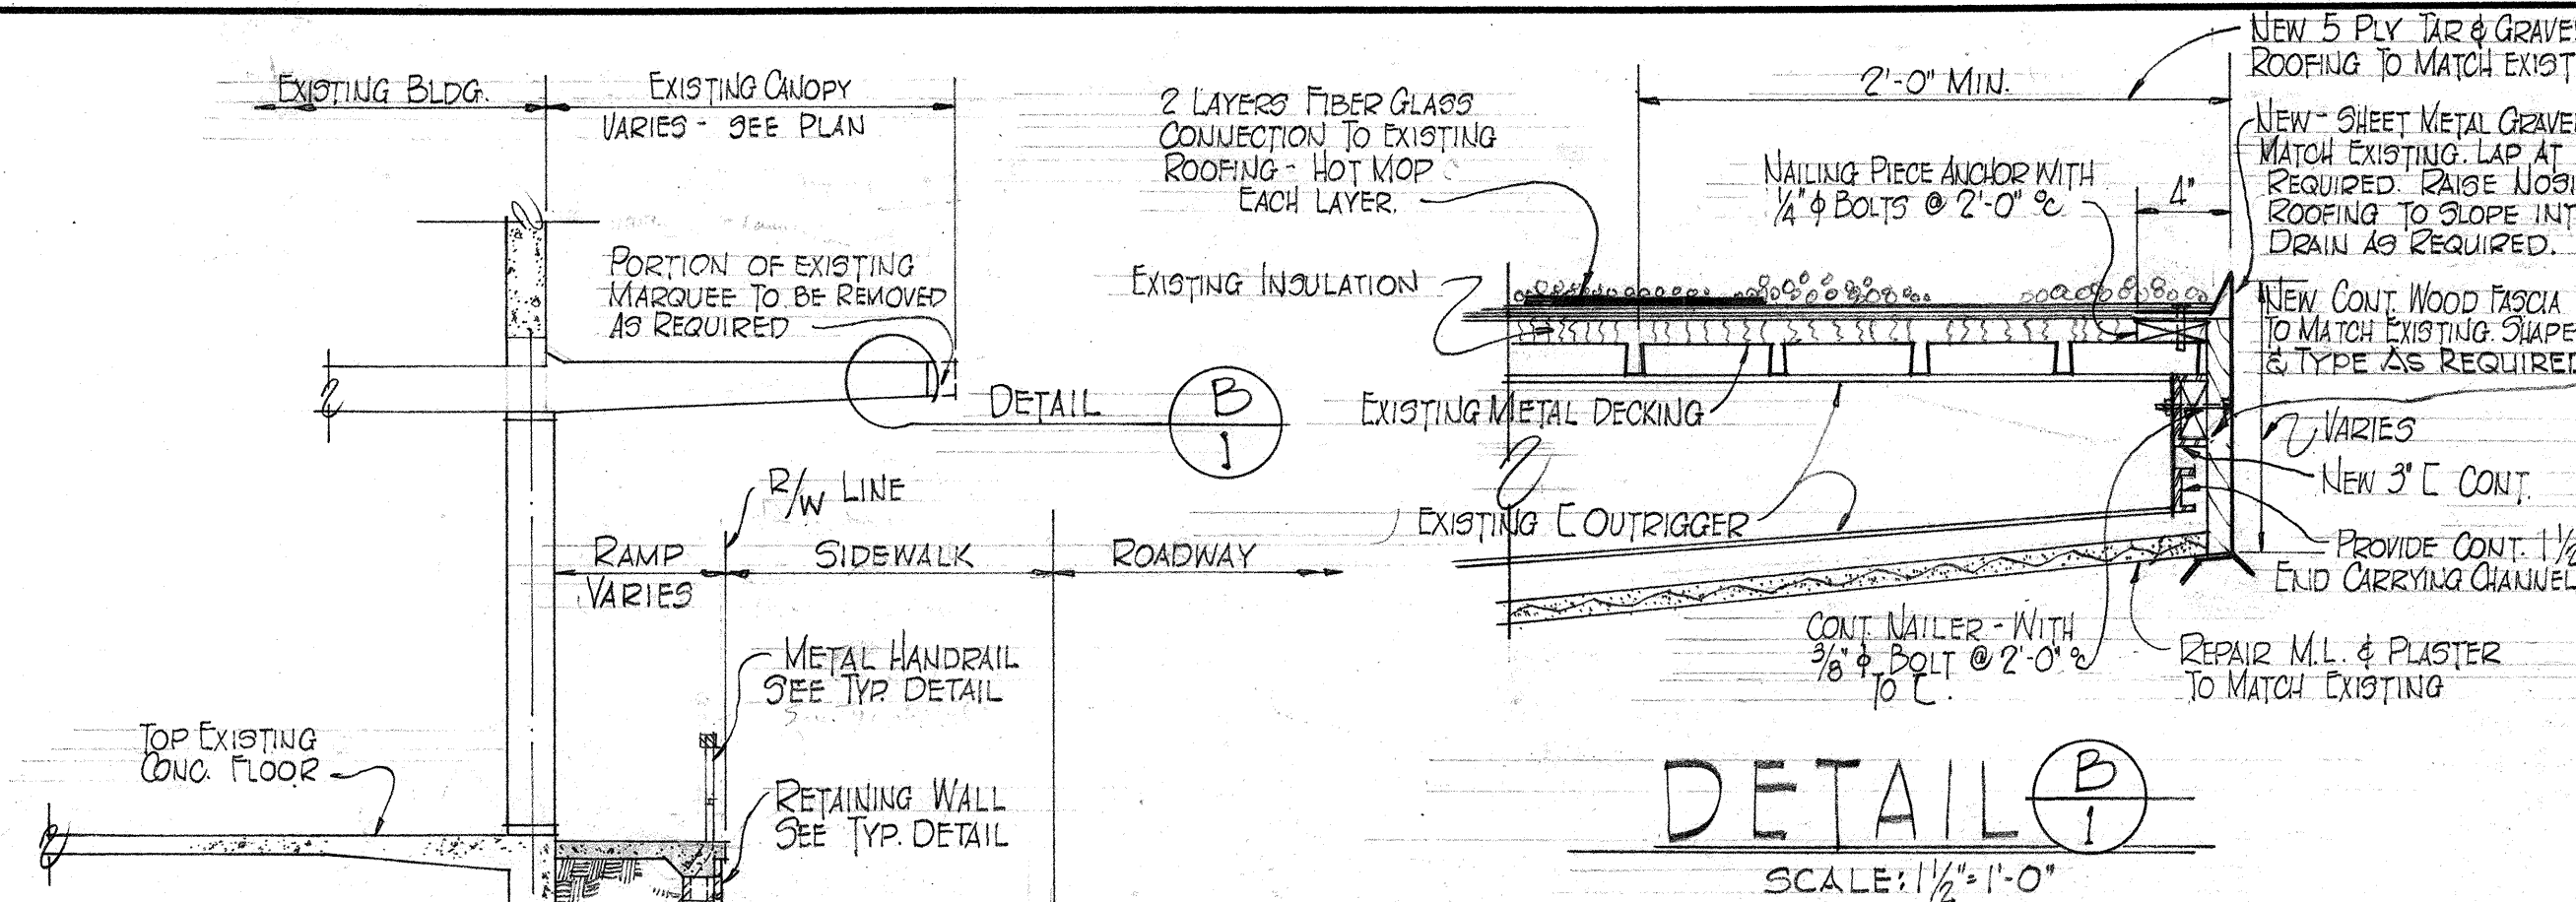


SECTION A-A

SCALE: 1/4" = 1'-0"


GENERAL NOTES





- 1- CONSTRUCTION METHODS - SEE SPECIAL PROVISIONS & STANDARD SPECIFICATIONS.
- 2- REMOVE EXISTING SIDEWALK SLAB, CURBS, & A.C. PAVEMENT AS DIRECTED BY THE ENGINEER FOR NEW CONSTRUCTION OF RAMP & RETAINING WALLS.
- 3- ALL CONCRETE TO BE CLASS A-1 EXCEPT FOR CELL FILL CONCRETE IN MASONRY BLOCK. CONCRETE IN CELL FILL MASONRY BLOCK TO BE PEA GRAVEL CONCRETE WITH A COMPRESSIVE STRENGTH OF 2500 P.S.I. AT 28 DAYS.
- 4- FORMS FOR ALL EXPOSED EDGES OF CONCRETE SHALL BE PLYWOOD, AND CONCRETE SHALL RECEIVE A CLASS 2 SURFACE FINISH. TOP SURFACE OF SLAB SHALL HAVE A ROUGH WEARING SURFACE PRODUCED BY SPRINKLING 1/4" / 30 FT. OF #8 / 16 ABRASIVE AGGREGATE ON FRESH CONCRETE AND FINISHING IT WITH A WOOD TROWEL. SEE SPECIAL PROVISIONS.
- 5- ALL FOOTING SHALL BE EXCAVATED & POURED TO NEAT LINES.
- 6- MASONRY BLOCK WALLS TO BE 2 CELL 8" X 8" X 16" TYPE SEE SPECIAL PROVISIONS.
- 7- BACKFILL SHALL BE COMPACTED TO 90% OF MAX. DENSITY AT OPTIMUM MOISTURE CONTENT AS DETERMINED BY THE LATEST AASHTO METHOD T-99. BACKFILL SHALL BE PLACED IN 12" LAYERS.
- 8- ROMAN BRICK VENEER TO MATCH EXISTING.
- 9- ALL WELDING SHALL CONFORM TO THE LATEST SPECIFICATIONS FOR WELDED HIGHWAY & RAILWAY BRIDGES, DESIGN CONSTRUCTION & REPAIR OF THE AMERICAN WELDING SOCIETY.
- 10- PAINTING - FOR HANDRAIL, SEE SPECIAL PROVISIONS.

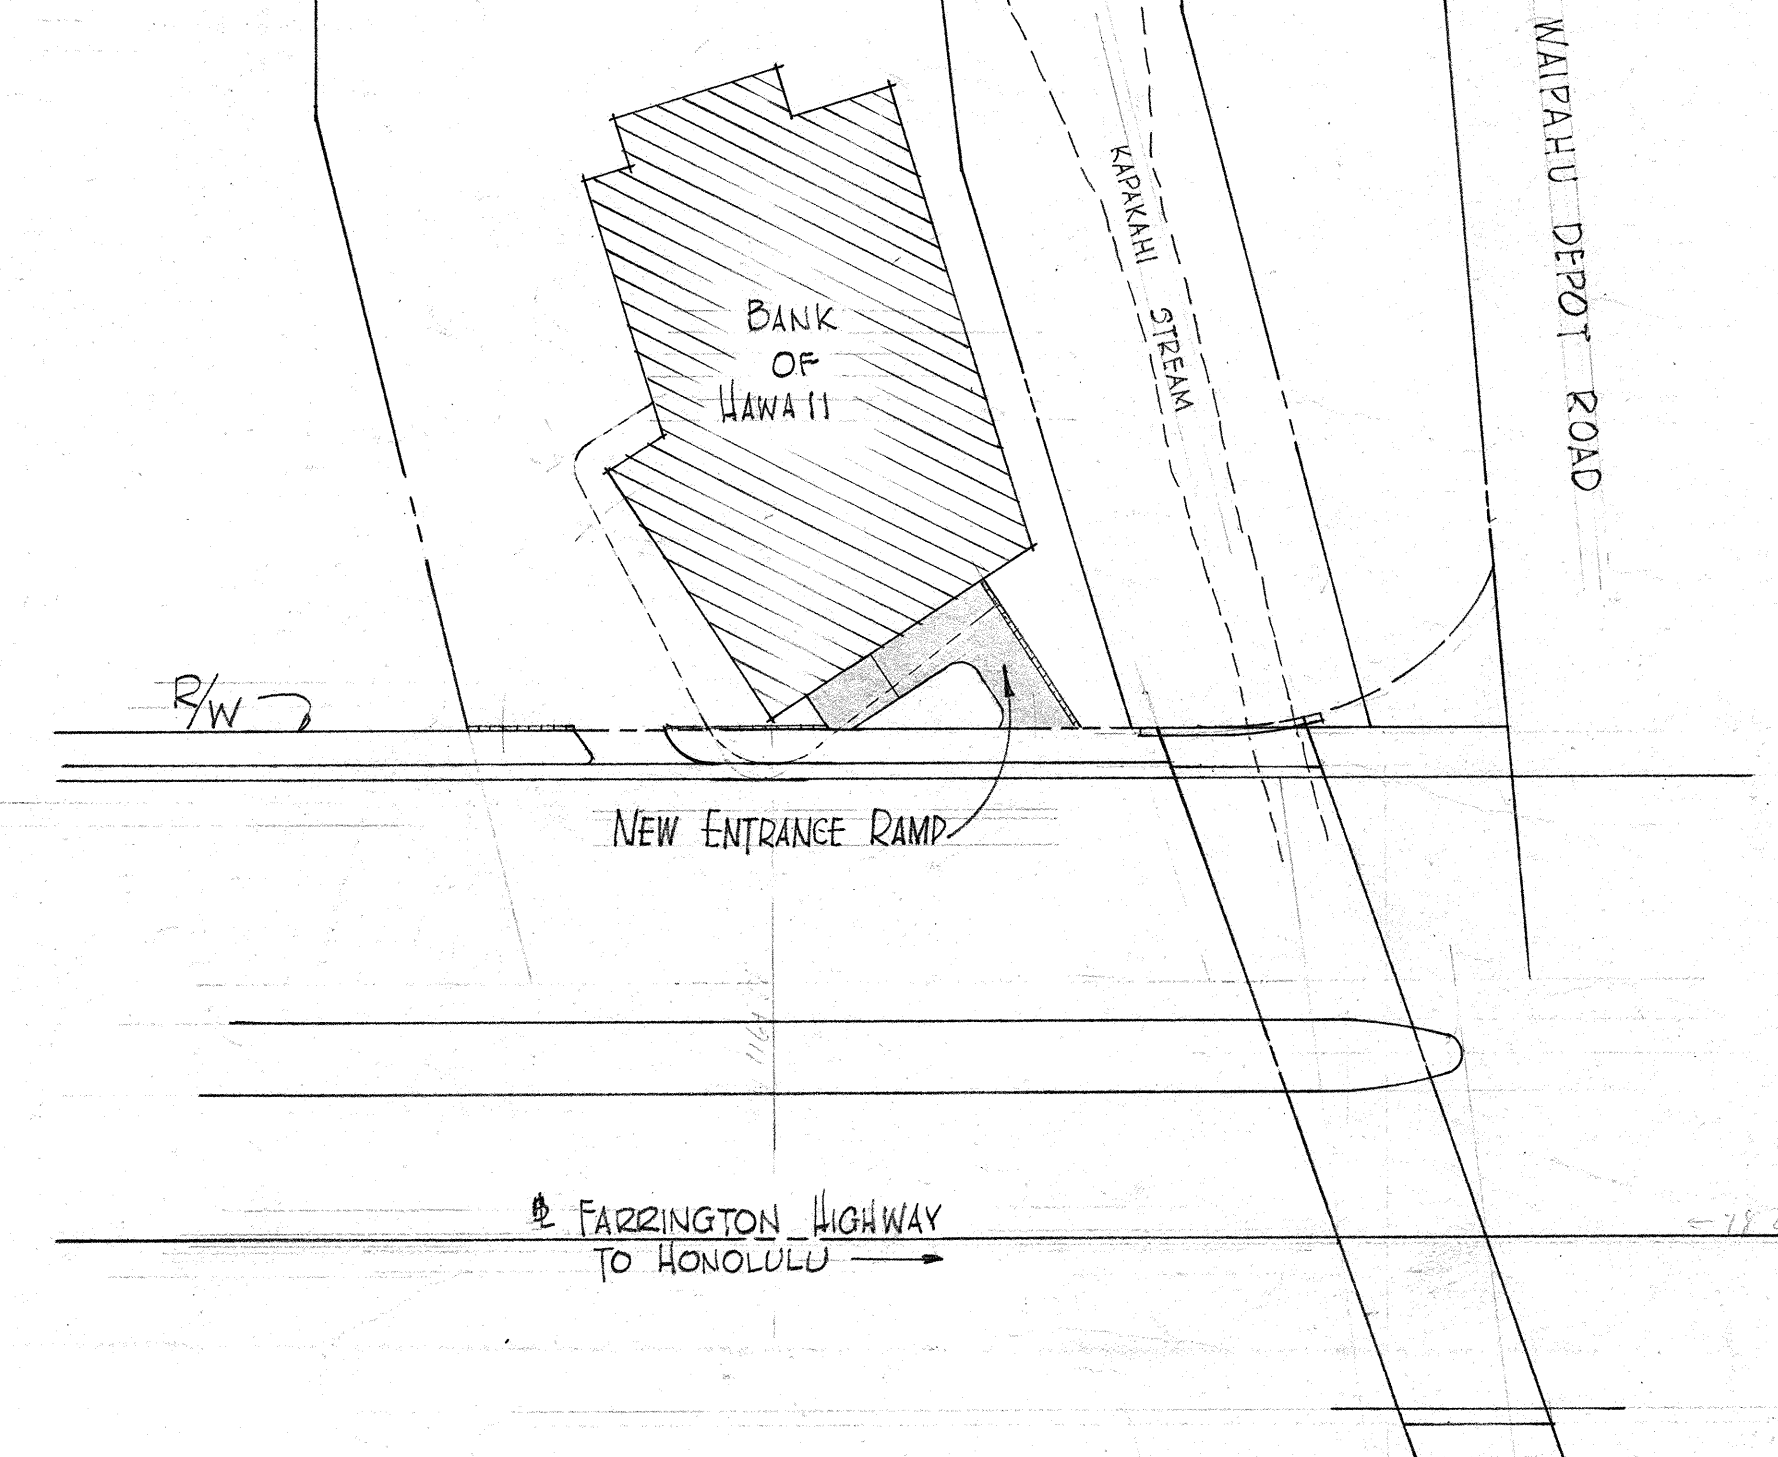

SITE PLAN

SCALE: 1" = 30'-0"

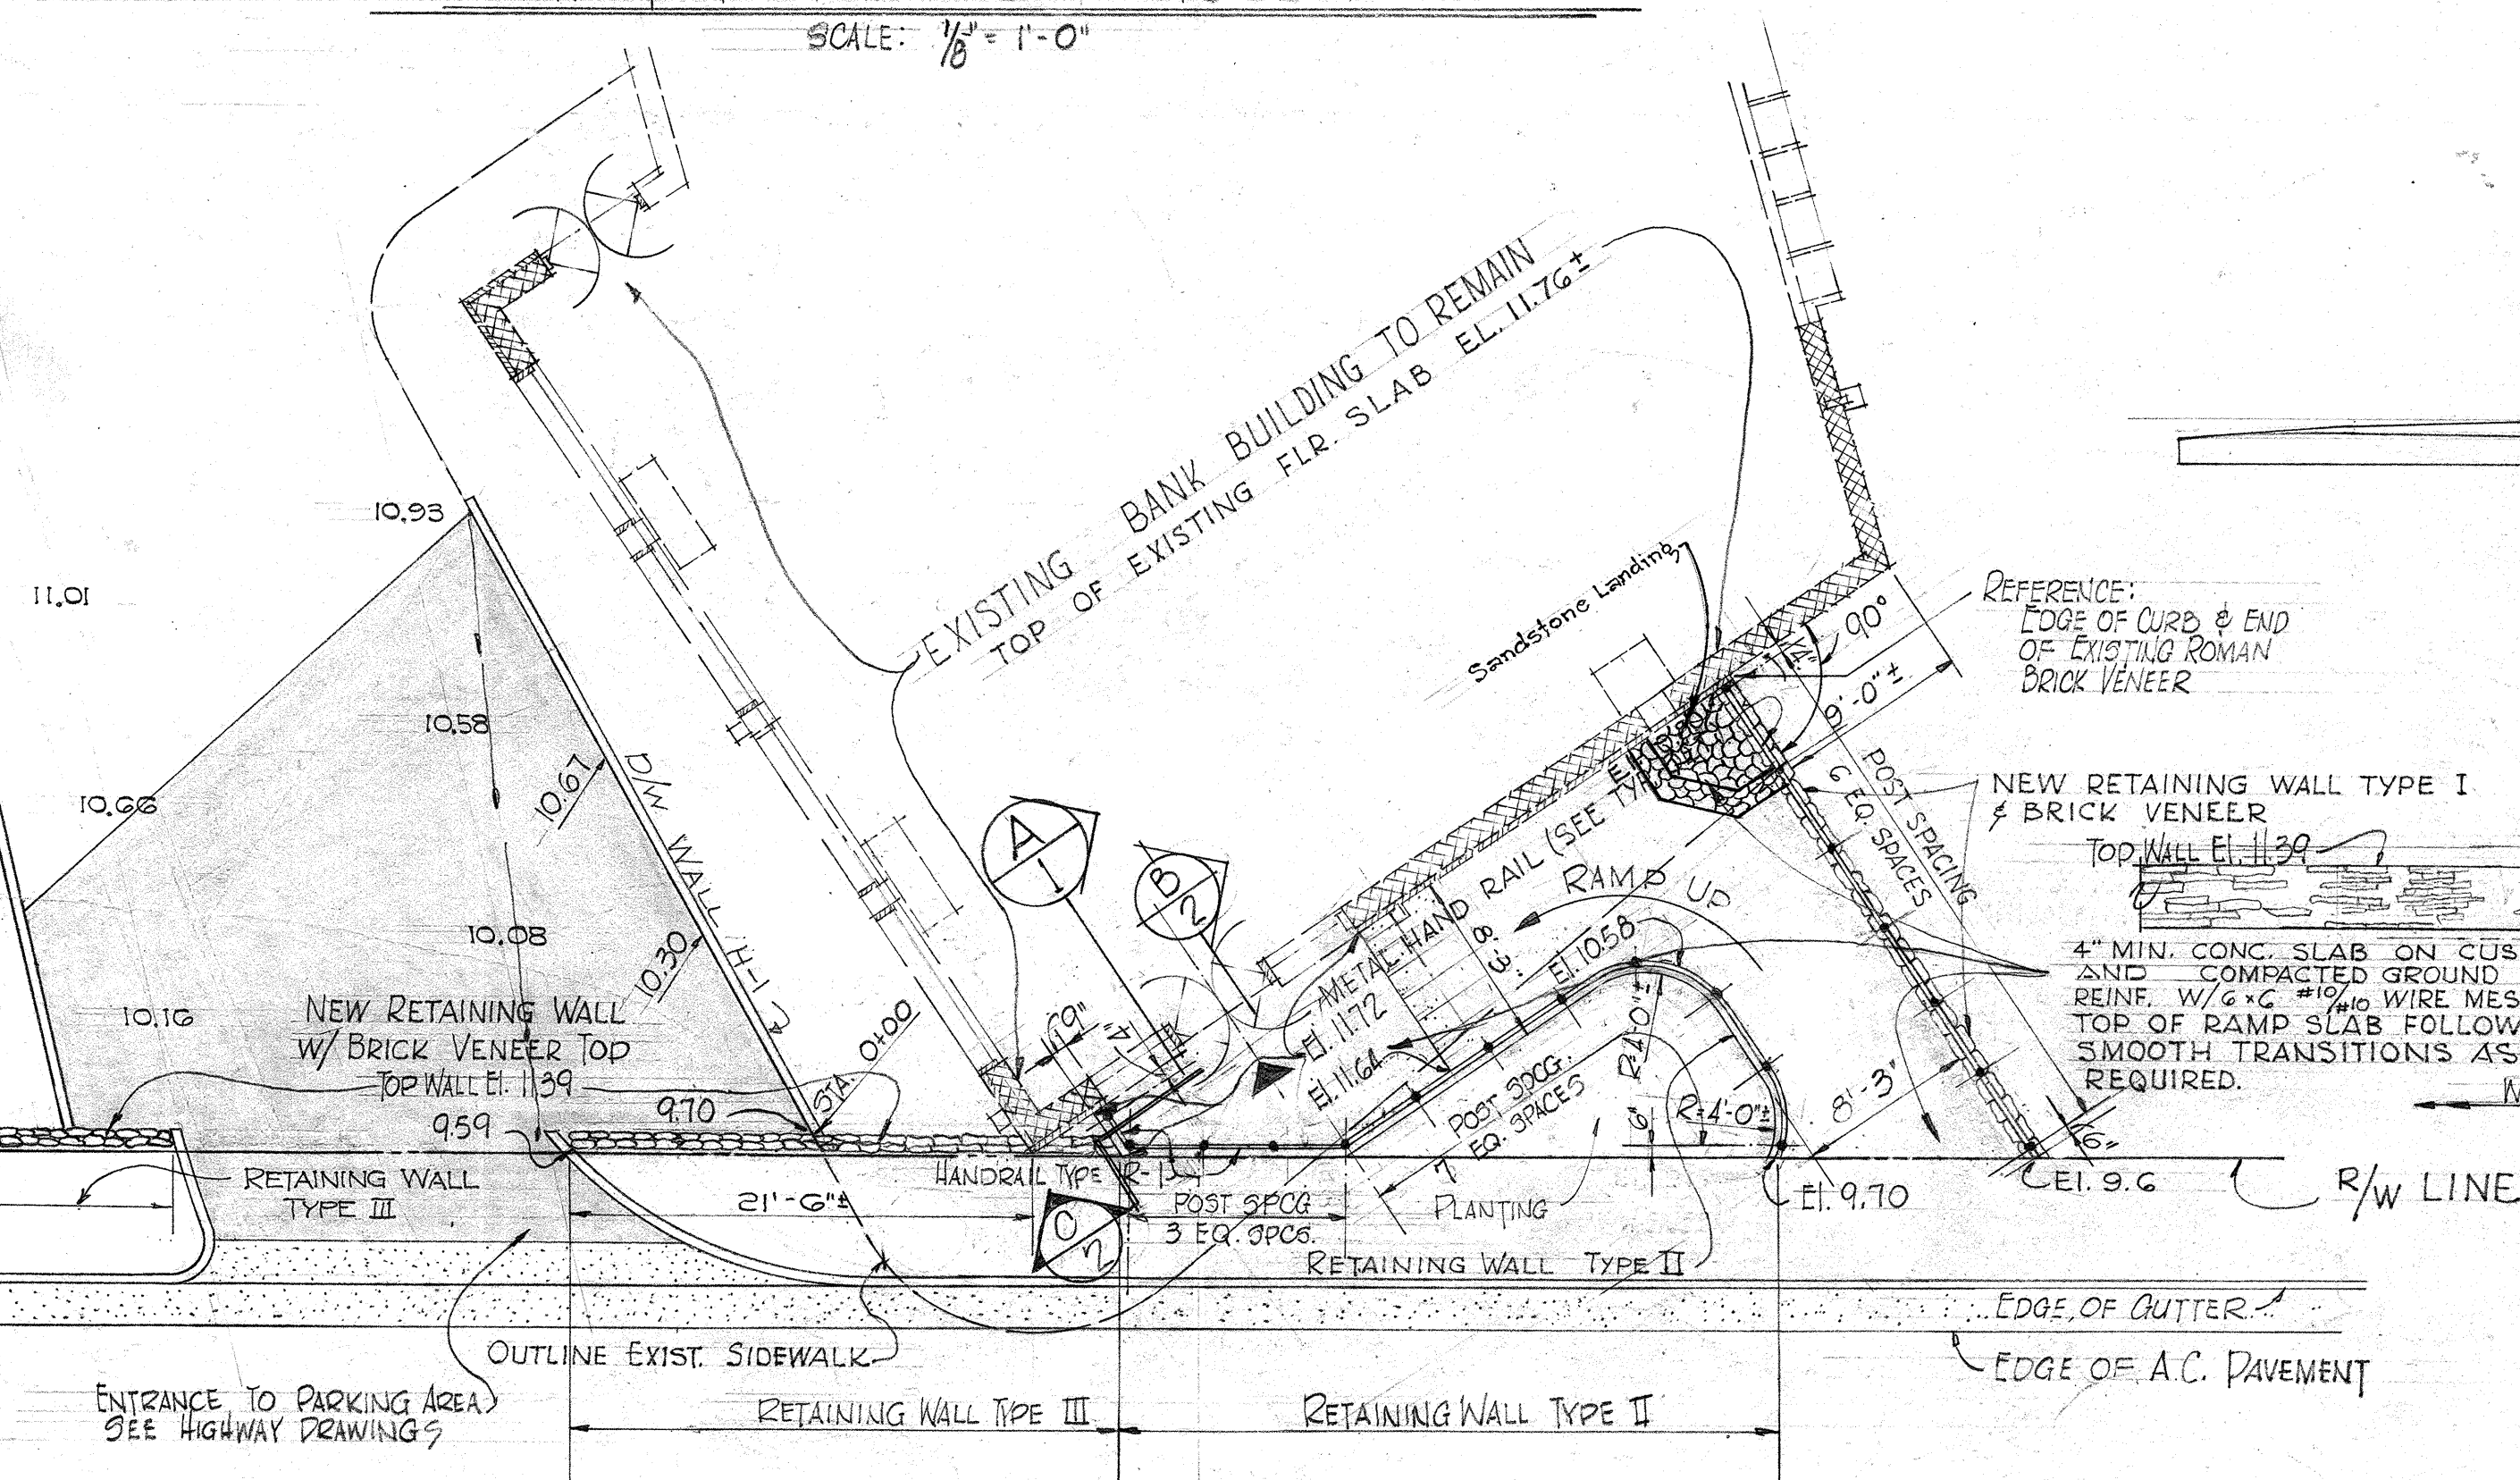

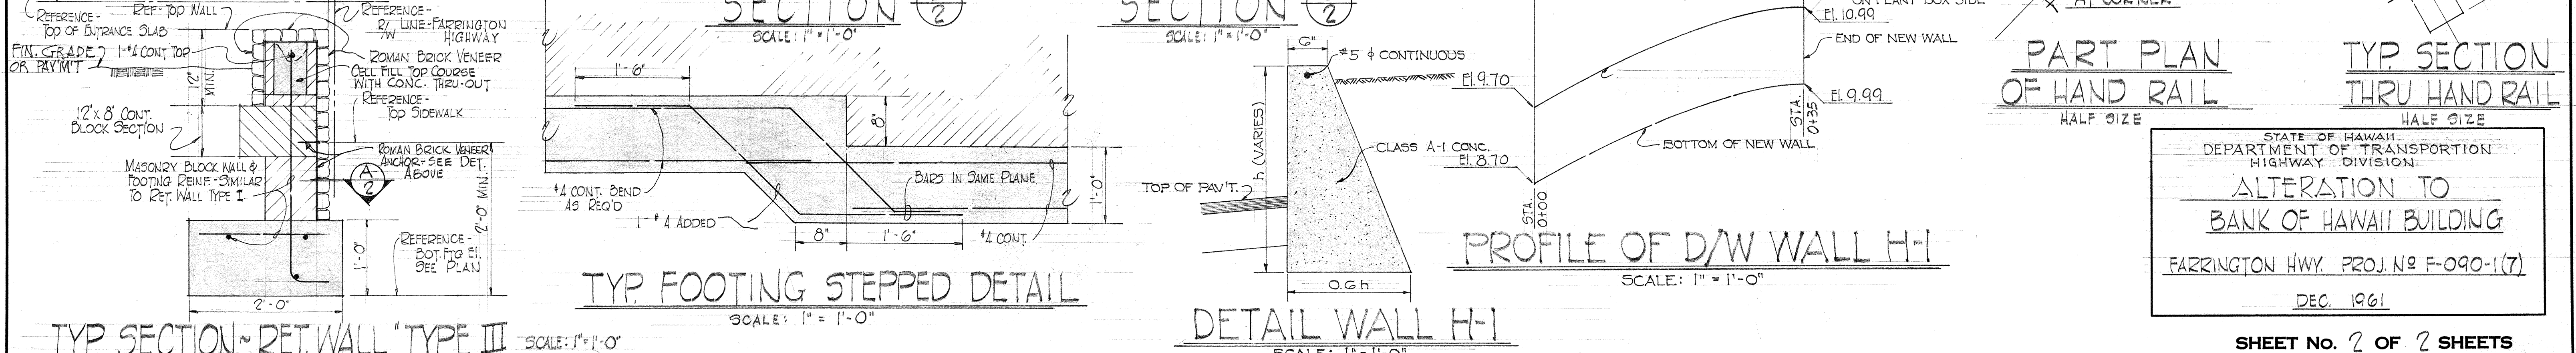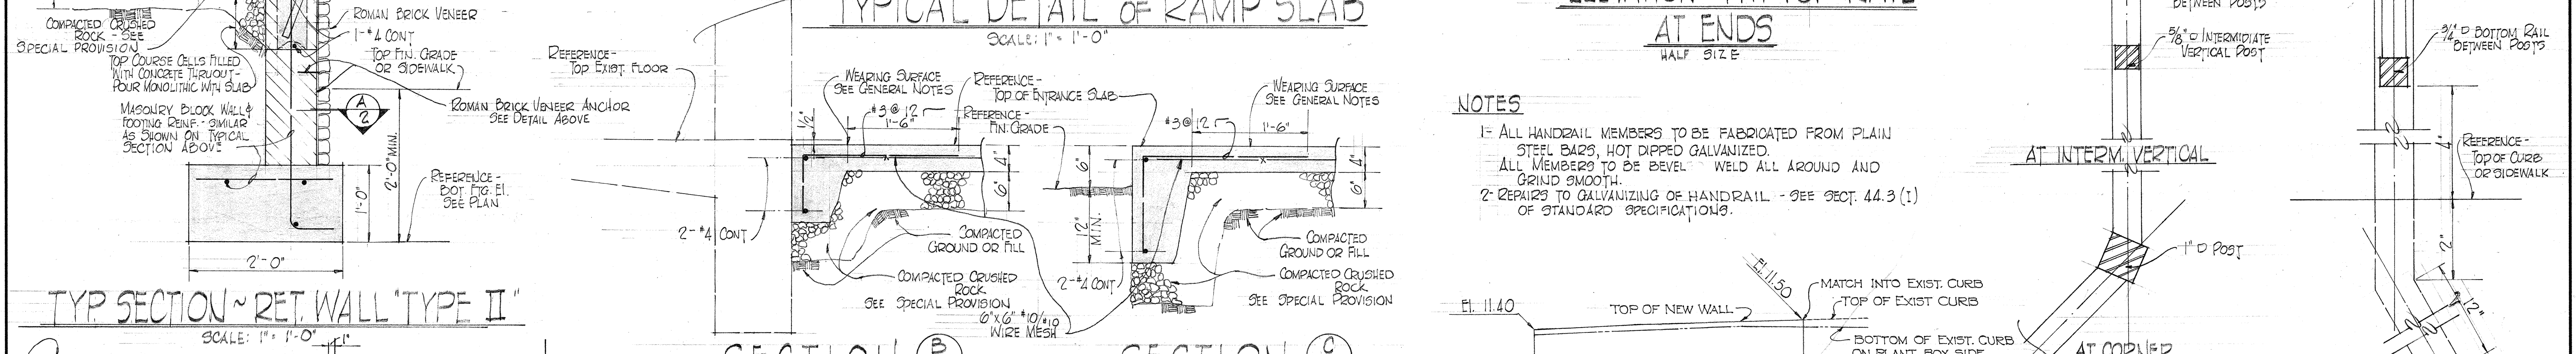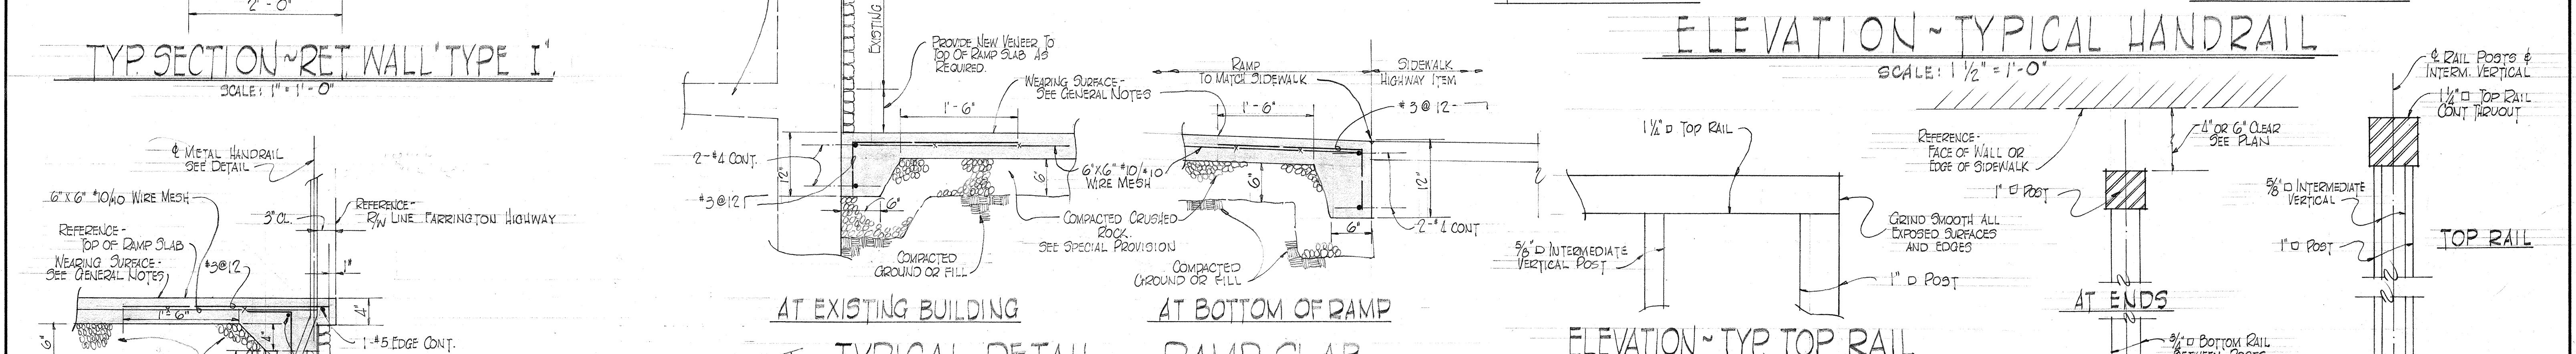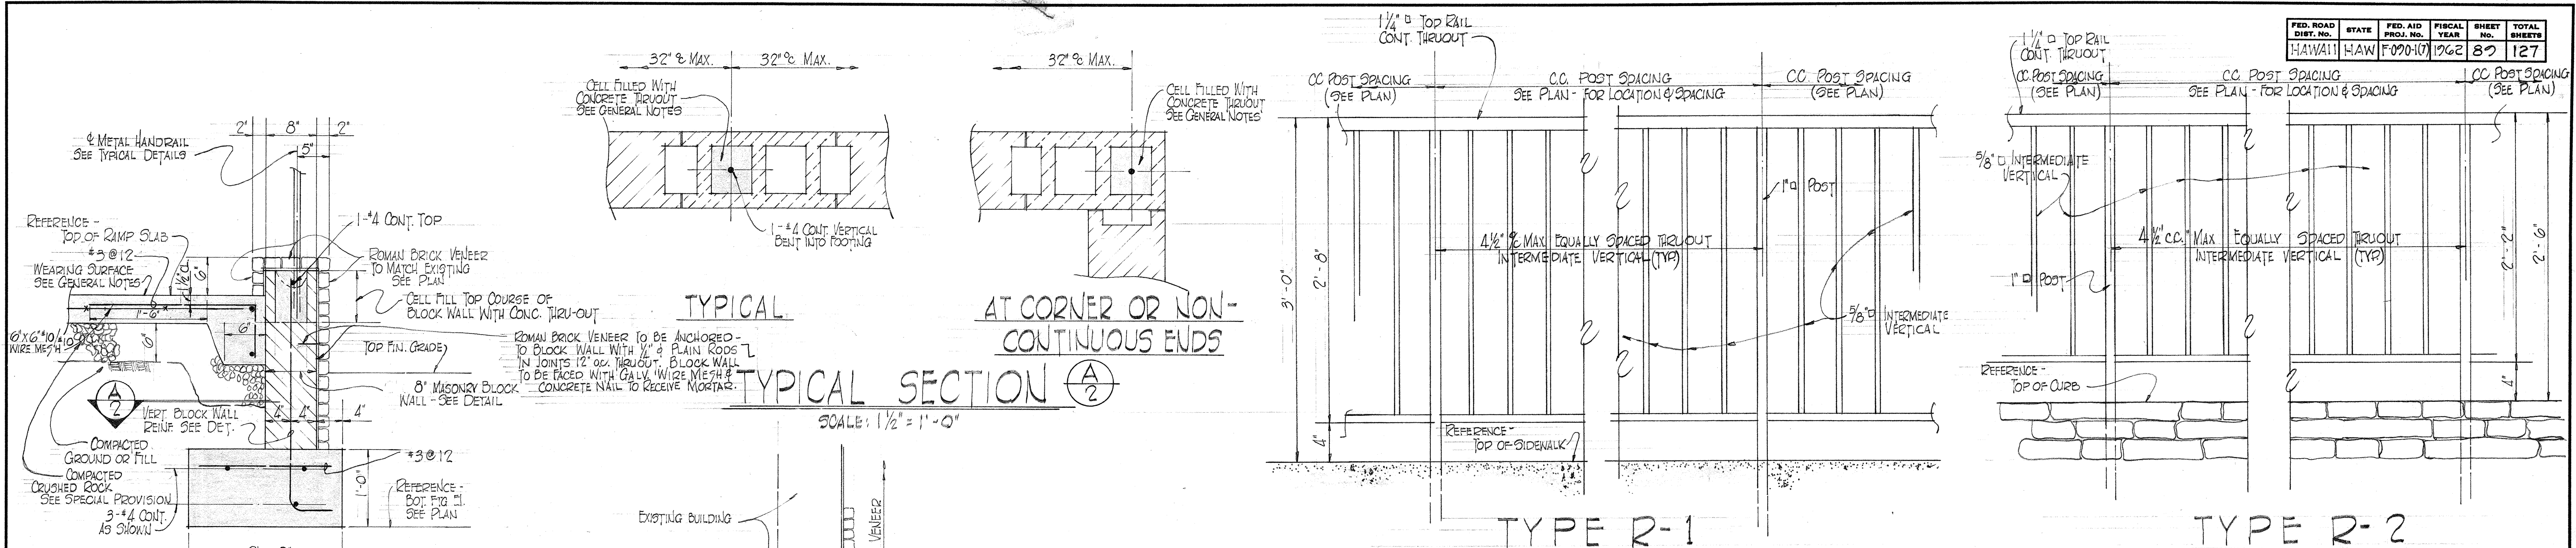

NOTES

- 1- ALL HANDRAIL MEMBERS TO BE FABRICATED FROM PLAIN STEEL BARS, HOT DIPPED GALVANIZED. ALL MEMBERS TO BE BEVEL WELD ALL AROUND AND GRIND SMOOTH.
- 2- REPAIRS TO GALVANIZING OF HANDRAIL - SEE SECT. 44.3 (1) OF STANDARD SPECIFICATIONS.

PART PLAN OF HAND RAIL
HALF SIZE

TYP SECTION THRU HAND RAIL
HALF SIZE

STATE OF HAWAII
DEPARTMENT OF TRANSPORTATION
HIGHWAY DIVISION
ALTERATION TO
BANK OF HAWAII BUILDING
FARRINGTON HWY. PROJ. NO. F-090-1(7)
DEC. 1961