



ORIGINAL PLAN	SURVEY PLOTTED BY _____	DATE _____
	DRAWN BY _____	_____
NOTE BOOK No. _____	TRACED BY _____	_____
	QUANTITIES BY _____	_____
	QUANTITIES CHECKED BY _____	_____
	CHECKED BY _____	_____



SHEET No. 2 OF 4 SHEETS

FED. ROAD DIST. NO.	STATE	FED. AID PROJ. NO.	FISCAL YEAR	SHEET NO.	TOTAL SHEETS
HAWAII	HAW	F-070-1(7)	1962	27	127

SURVEY PLOTTED BY	DATE
DESIGNED BY	
DRAWN BY	
QUANTITIES CHECKED BY	
CHECKED BY	
ORIGINAL PLAN	
NOTE BOOK	
No.	

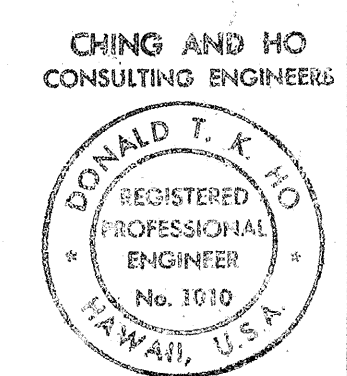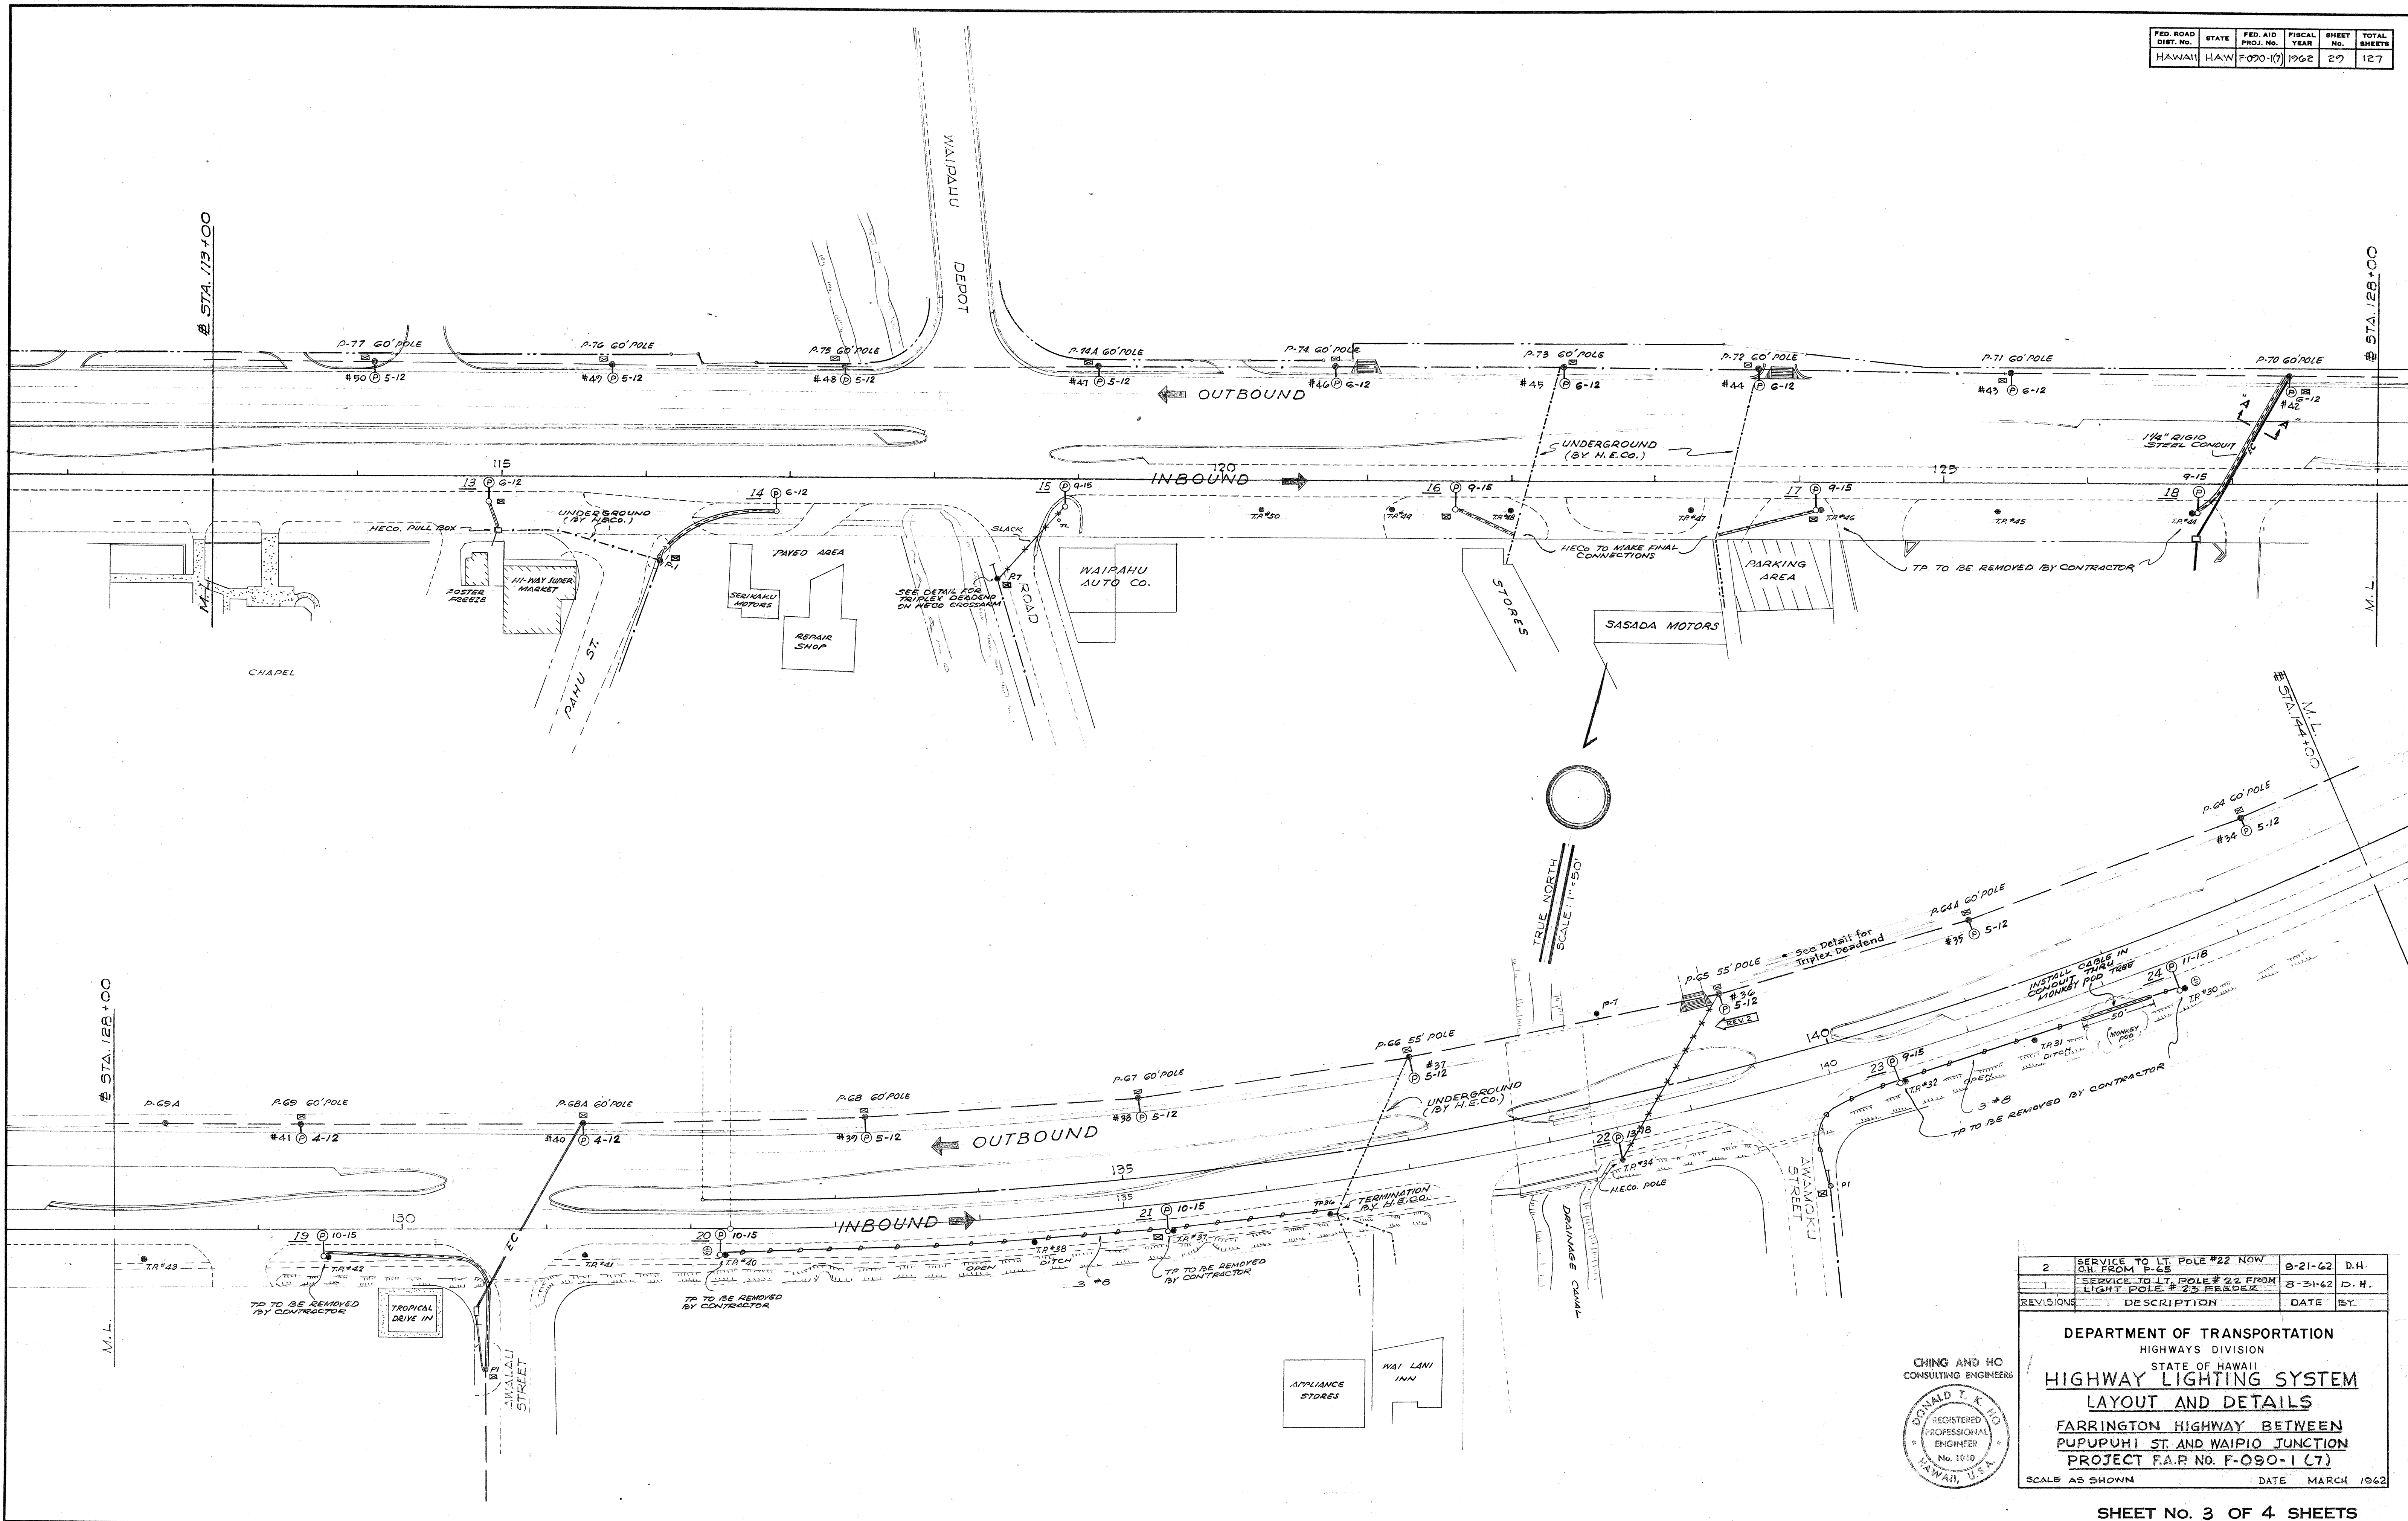

2	SERVICE TO LT. POLE #22 NOW O.H. FROM P-65	8-21-62	D.H.
1	SERVICE TO LT. POLE #23 FROM LIGHT POLE #23 FROM P-65	8-31-62	D.H.
REVISIONS	DESCRIPTION	DATE	BY
DEPARTMENT OF TRANSPORTATION HIGHWAYS DIVISION STATE OF HAWAII HIGHWAY LIGHTING SYSTEM LAYOUT AND DETAILS FARRINGTON HIGHWAY BETWEEN PUPUPUHI ST. AND WAIPIU JUNCTION PROJECT F.A.P. NO. F-090-1 (7) SCALE AS SHOWN DATE MARCH 1962			

SHEET NO. 3 OF 4 SHEETS

