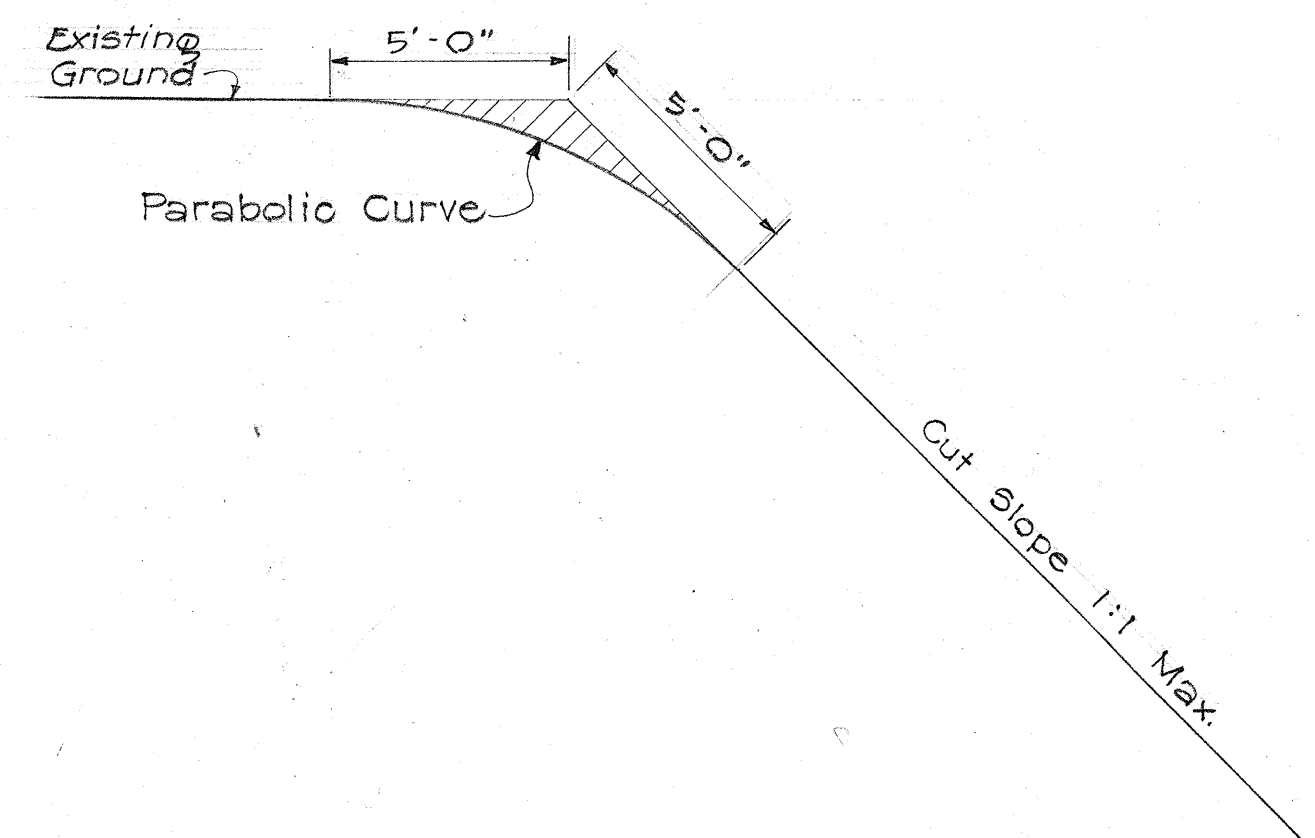
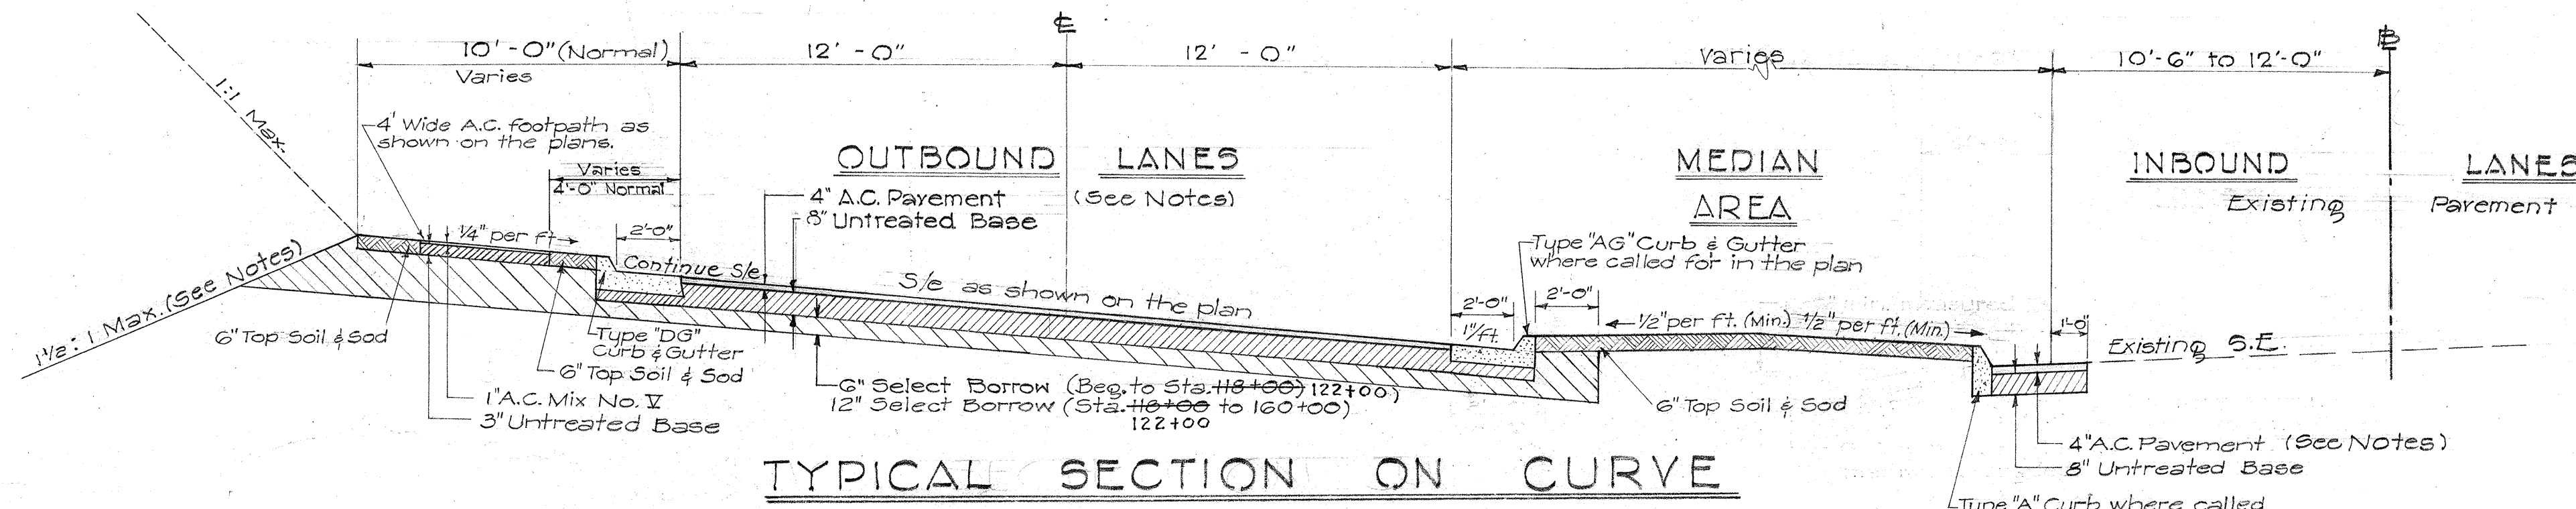




DETAIL OF ROUNDING CUT SLOPE

GENERAL NOTES

1. If slope of existing ground from existing edge of pavement is 1/2" per ft. or greater, to a maximum slope of 4:1, no grading or excavation shall be done in the median area except as required for scarifying and removal of exist. pavt.
2. 4" A.C. Pavement shall consist of 1 1/2" A.C. Mix No. V and 2 1/2" A.C. Mix No. III.
3. Fill slope.

TABLE OF FILL SLOPES	
Height of Fill	Slopes
0' - 4'	4:1
4' - 10'	3:1 to 2:1
Over 10'	1 1/2:1

4. Transition from one fill slope to another, should be made gradually over a distance of at least 25 feet.
5. Scarify and remove all existing pavement in new median area and fill. (Incidental to Roadway Exc.)
6. Limit of sodding should be the new outbound roadway R/W line.

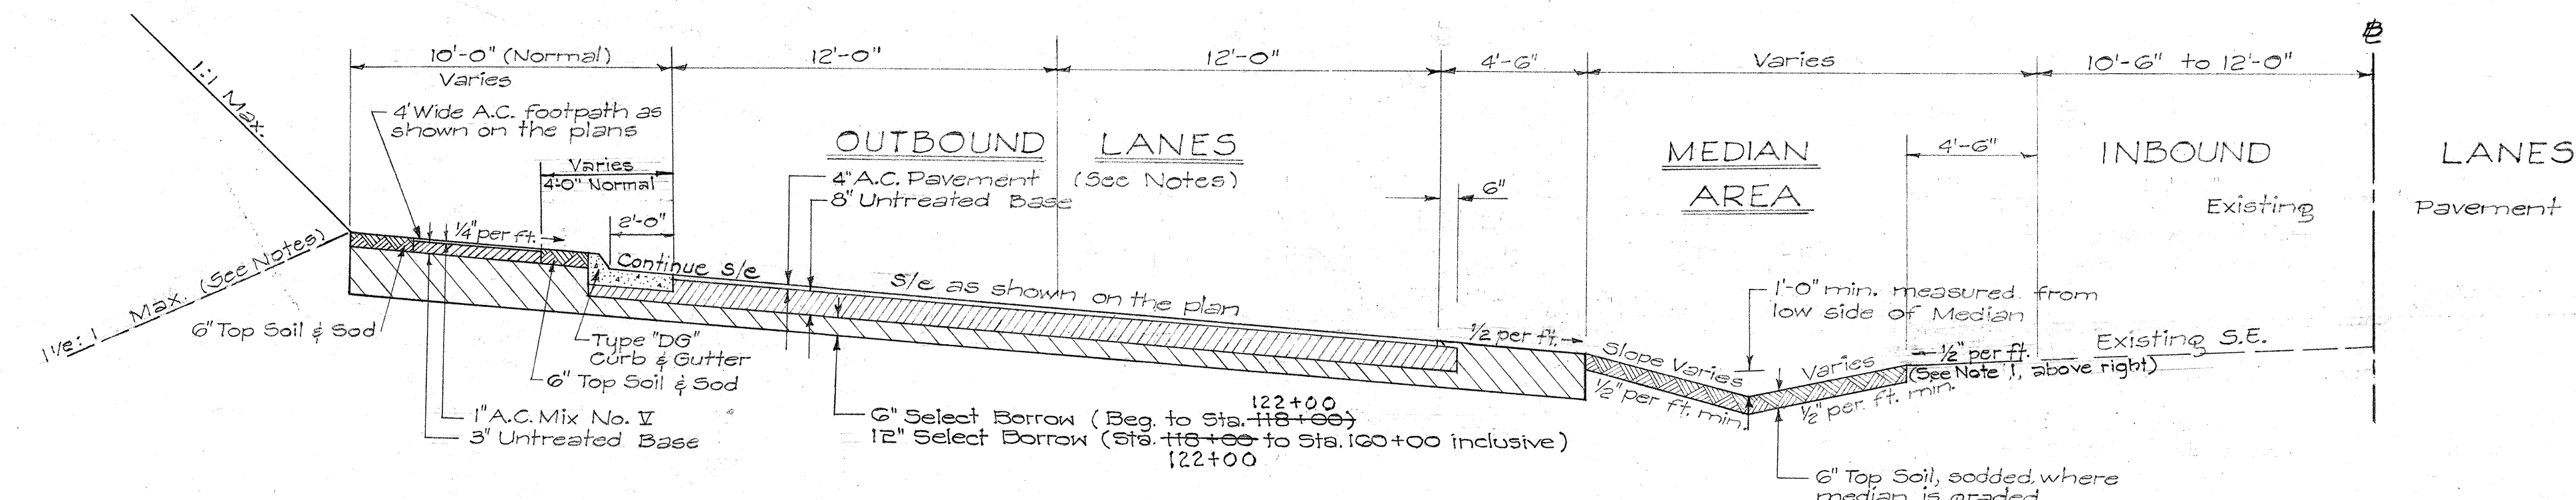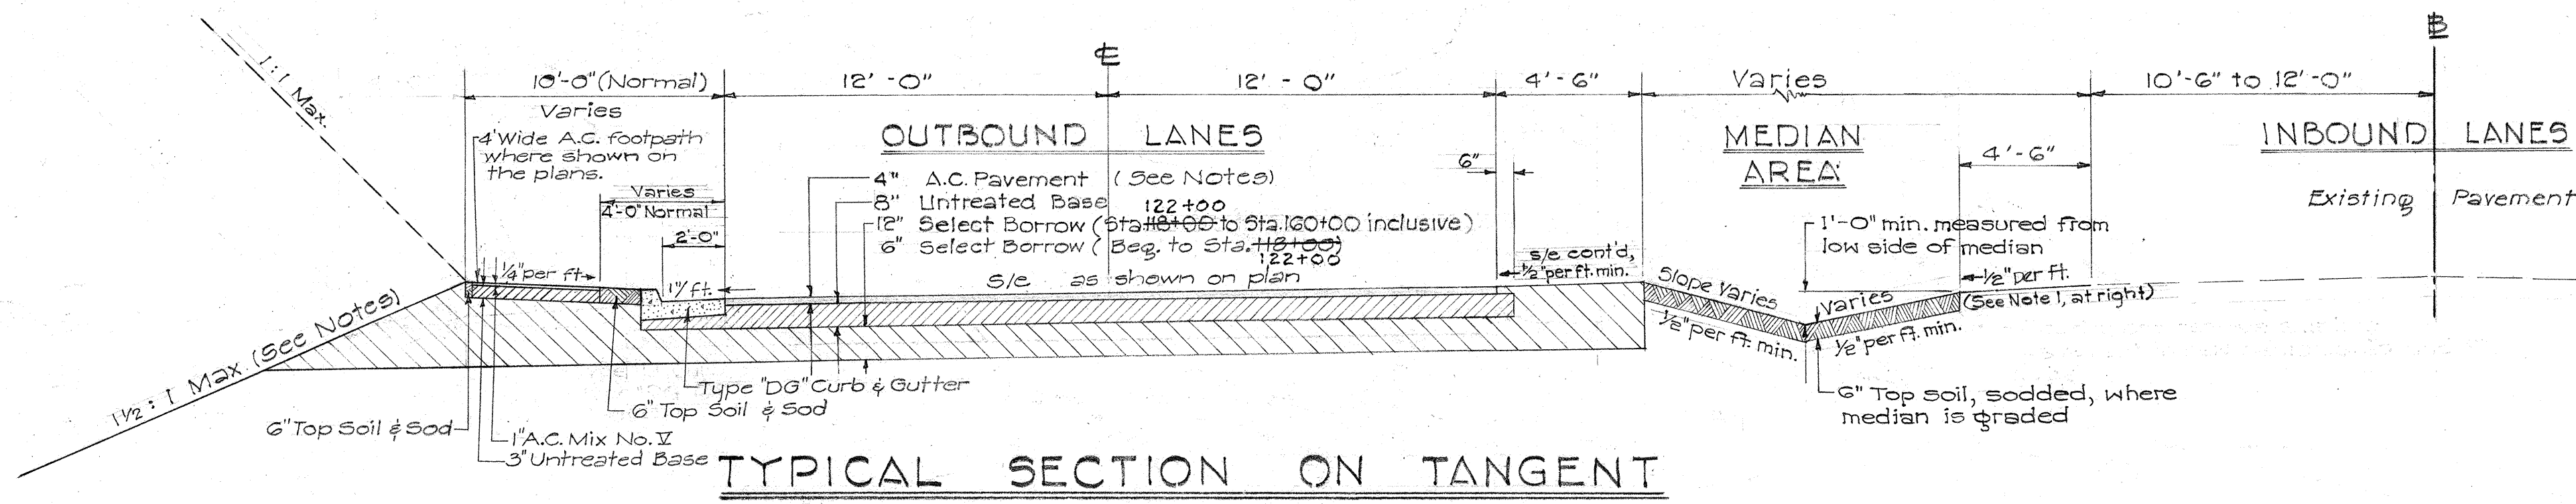

TYPICAL SECTION ON CURVE

DATE	DESIGNED BY	CHECKED BY
PLANNED BY	TRACED BY	QUANTITIES BY
NOTED BY	NOTED BY	CHECKED BY
ORIGINAL PLAN	NOTE BOOK	No.


DEPARTMENT OF TRANSPORTATION
HIGHWAYS DIVISION
STATE OF HAWAII

TYPICAL ROAD SECTIONS


FARRINGTON HIGHWAY
PROJECT NO F-090-1(7)

Scale: 1/4" = 1'-0" Date: March, 1962


FED. ROAD DIST. NO.	STATE	FED. AID PROJ. NO.	FISCAL YEAR	SHEET NO.	TOTAL SHEETS
HAWAII	HAW.	F-090-1(7)	1962	3	127

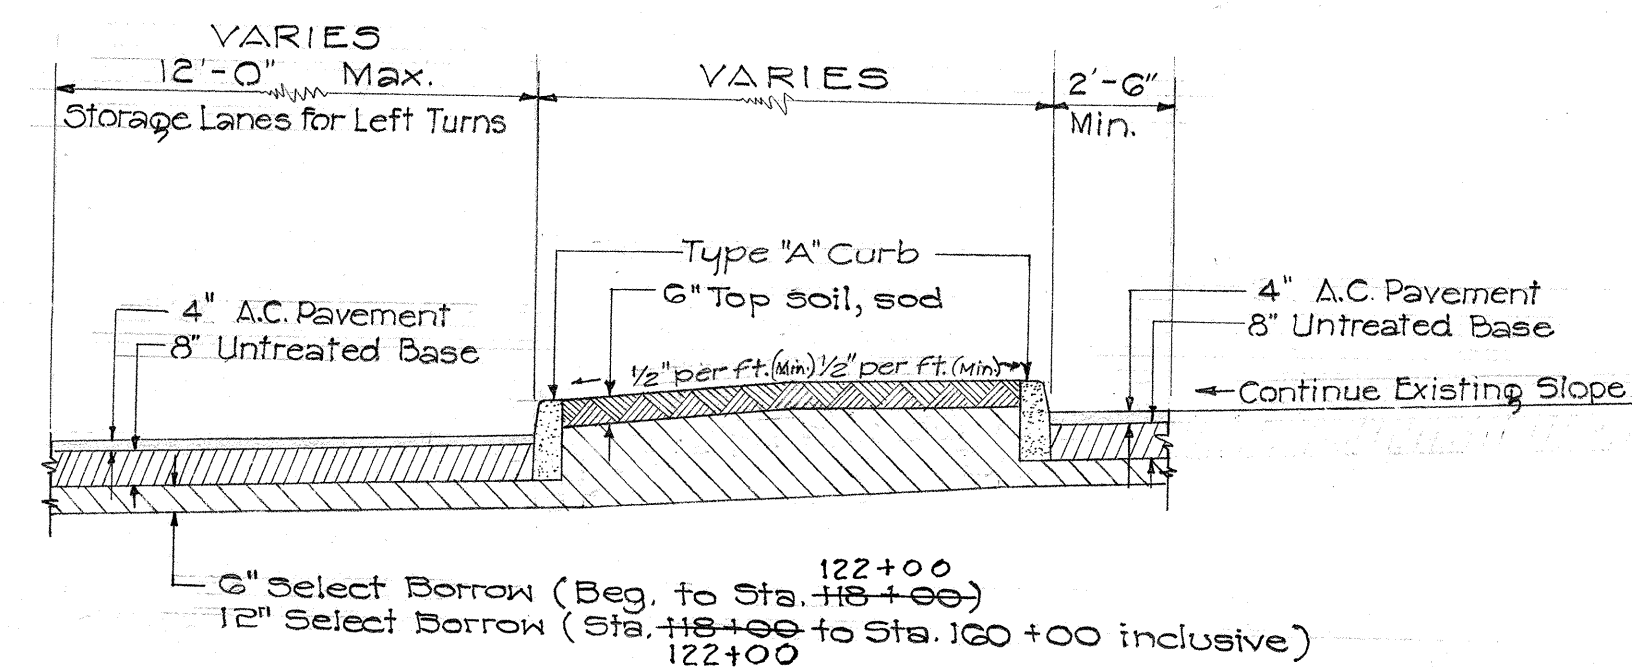


CURBS BOTH SIDES WITH STORAGE ON OUTBOUND

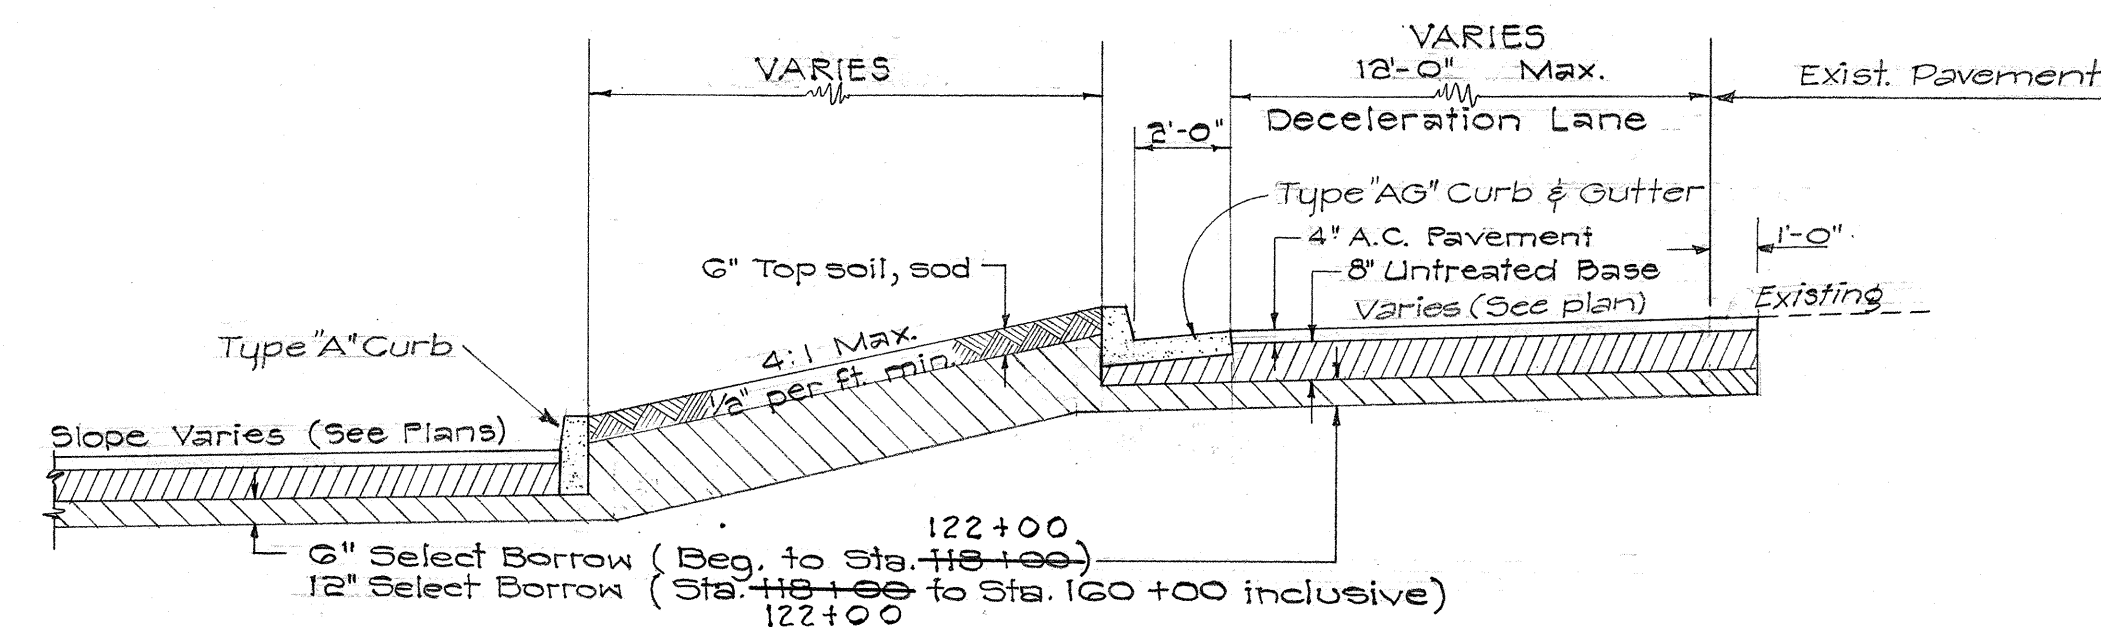


CURBS BOTH SIDES WITH DECEL. LANE ON INBOUND

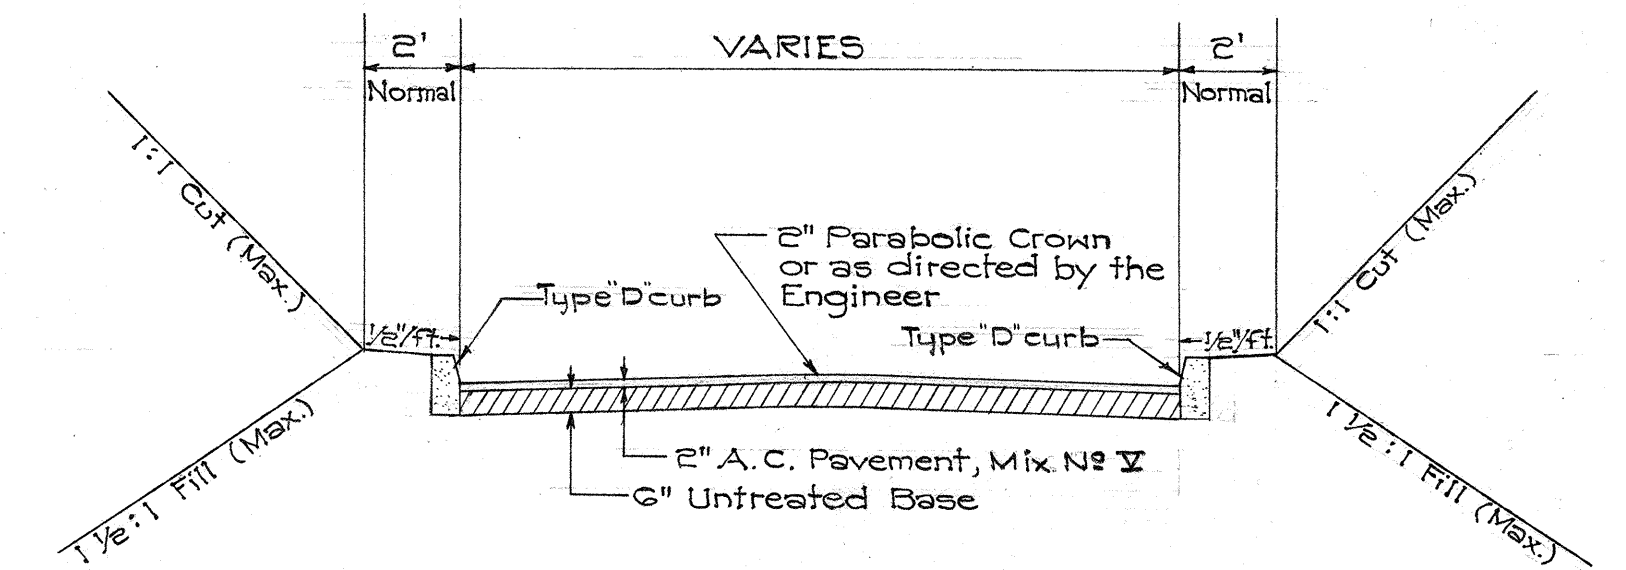


TYPICAL SECTION OF A.C. DRIVEWAY WITH CURBS

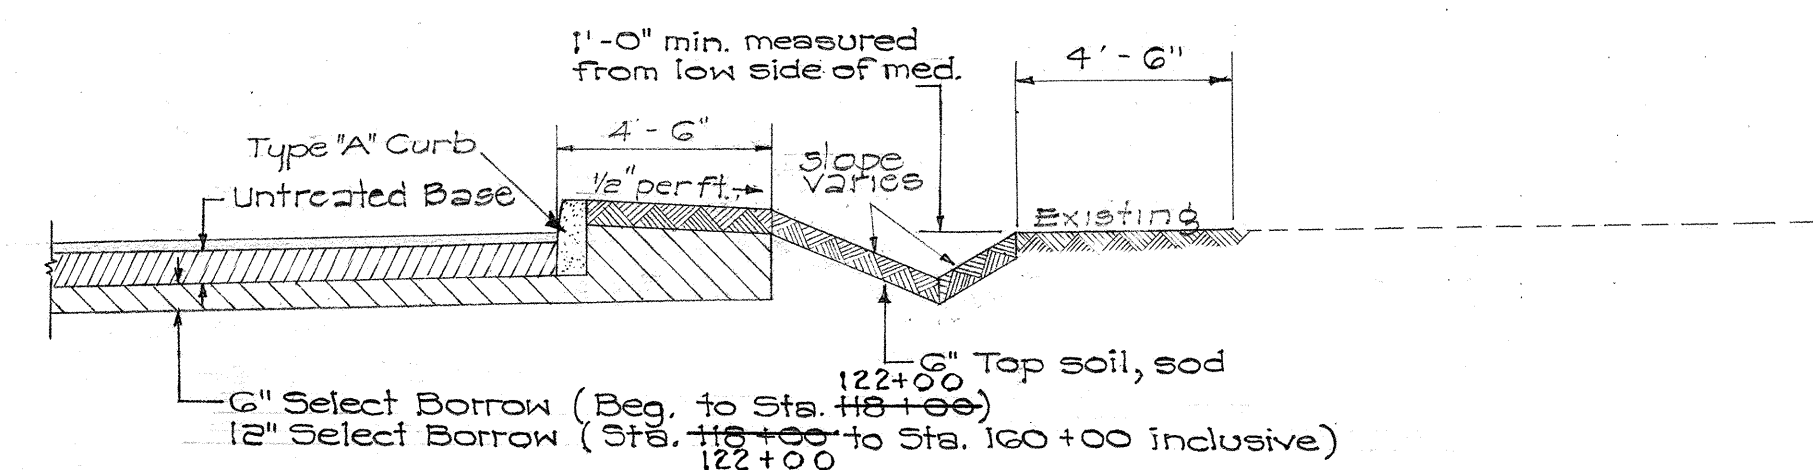


CURB ON OUTBOUND ONLY

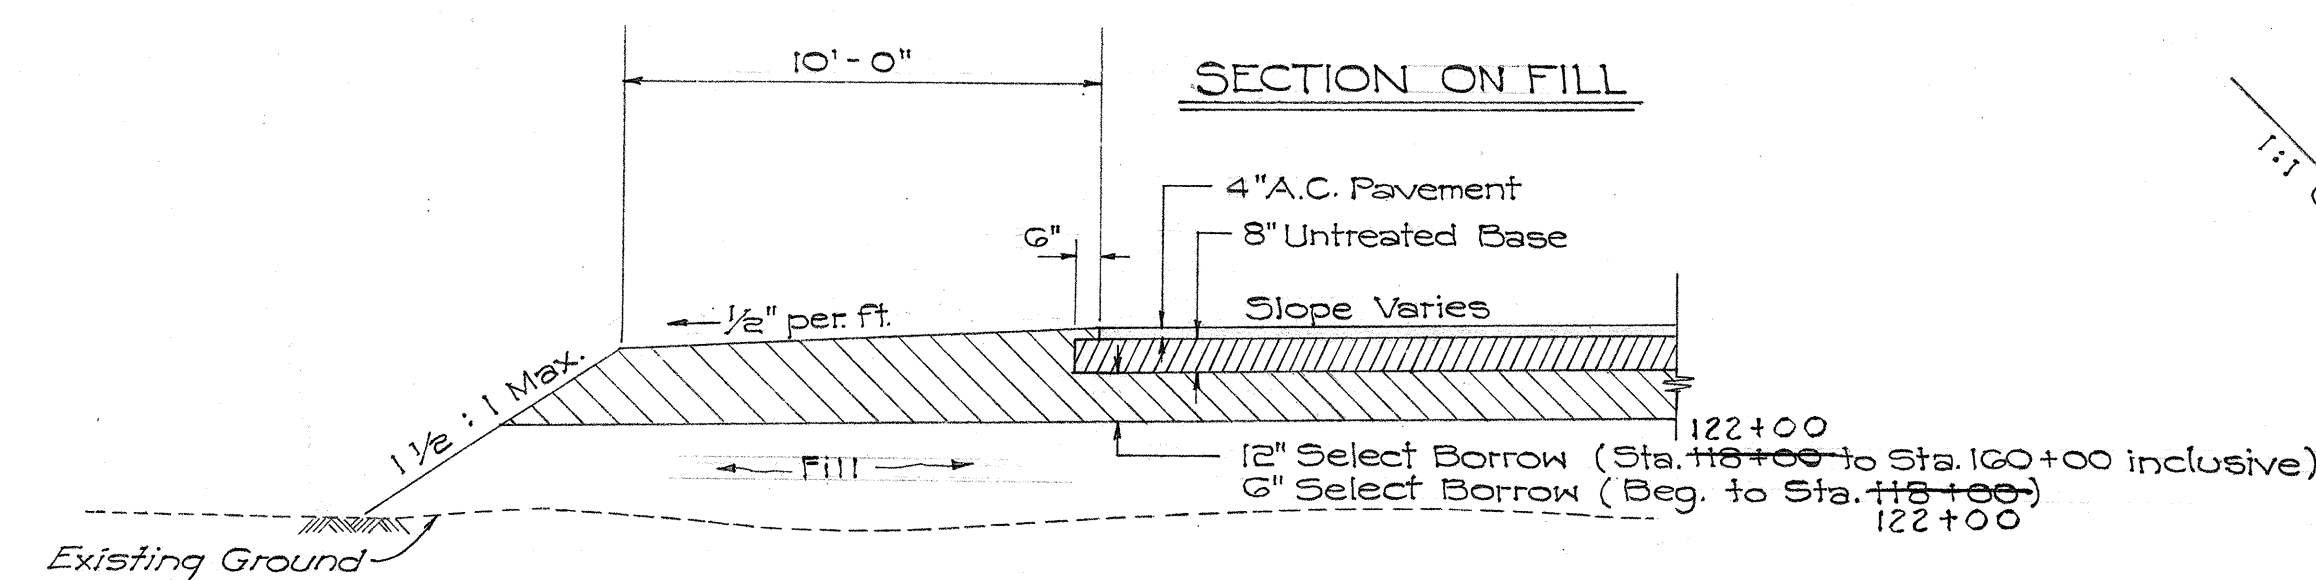


SECTION ON FILL

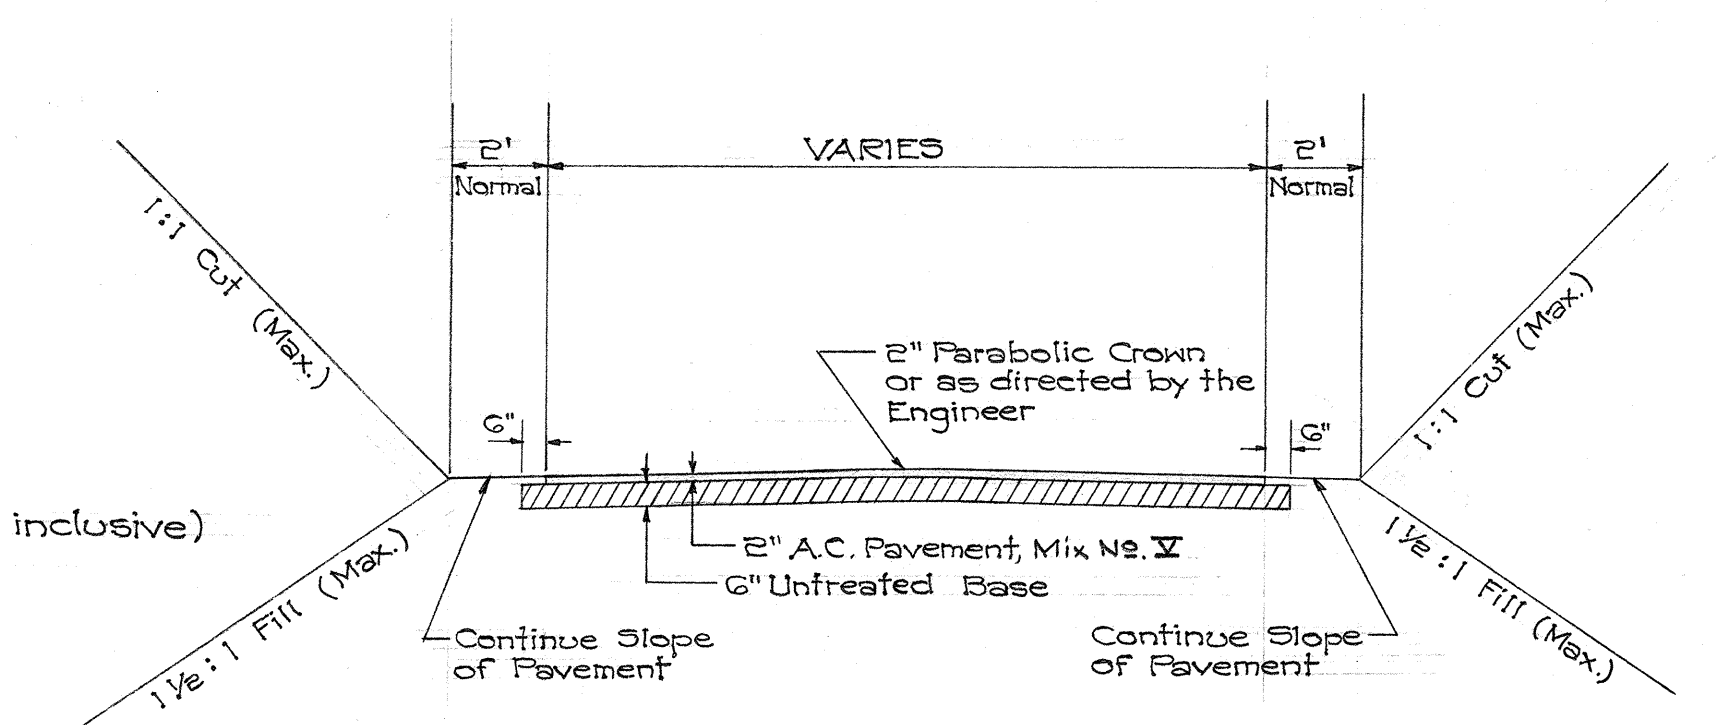

TYPICAL SECTION OF A.C. DRIVEWAY WITHOUT CURB

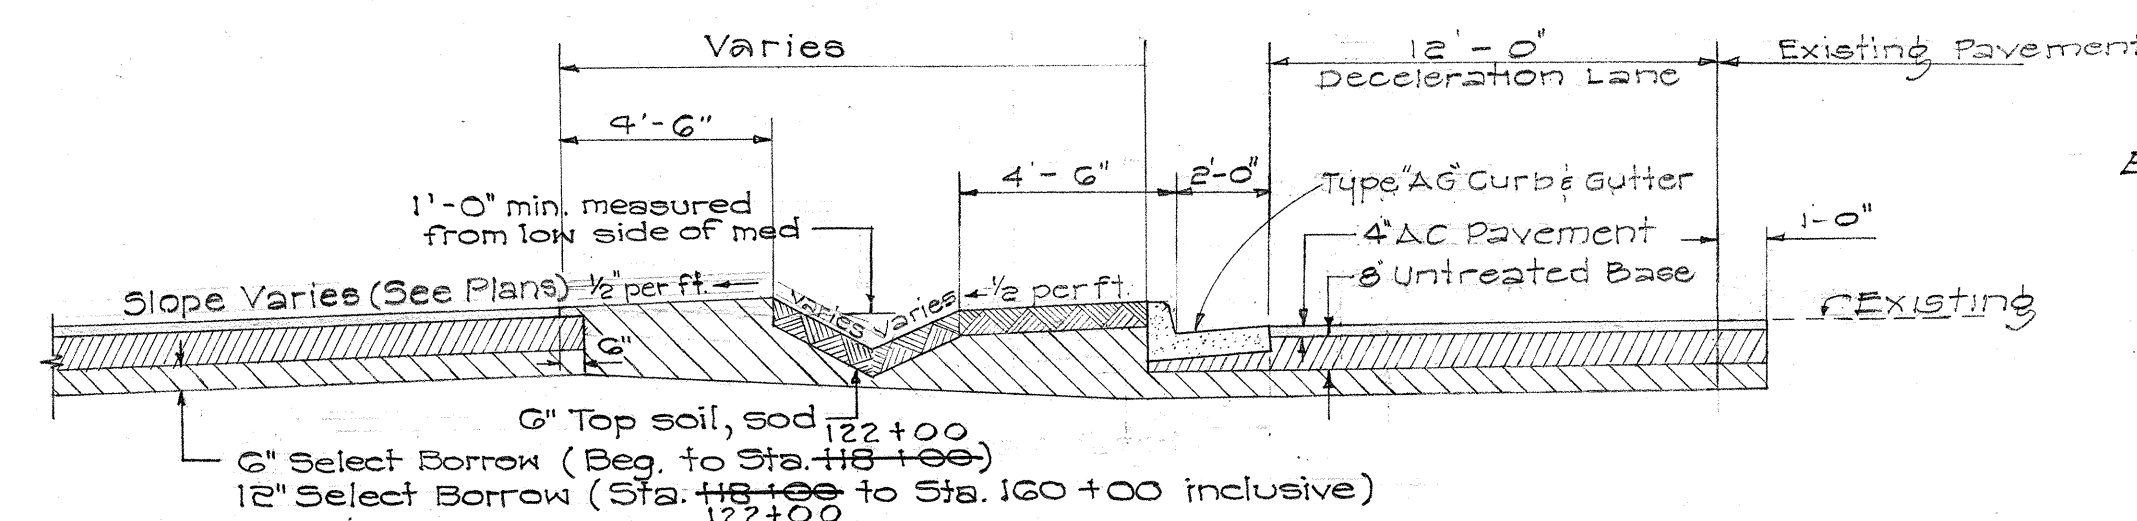


CURB ON INBOUND ONLY

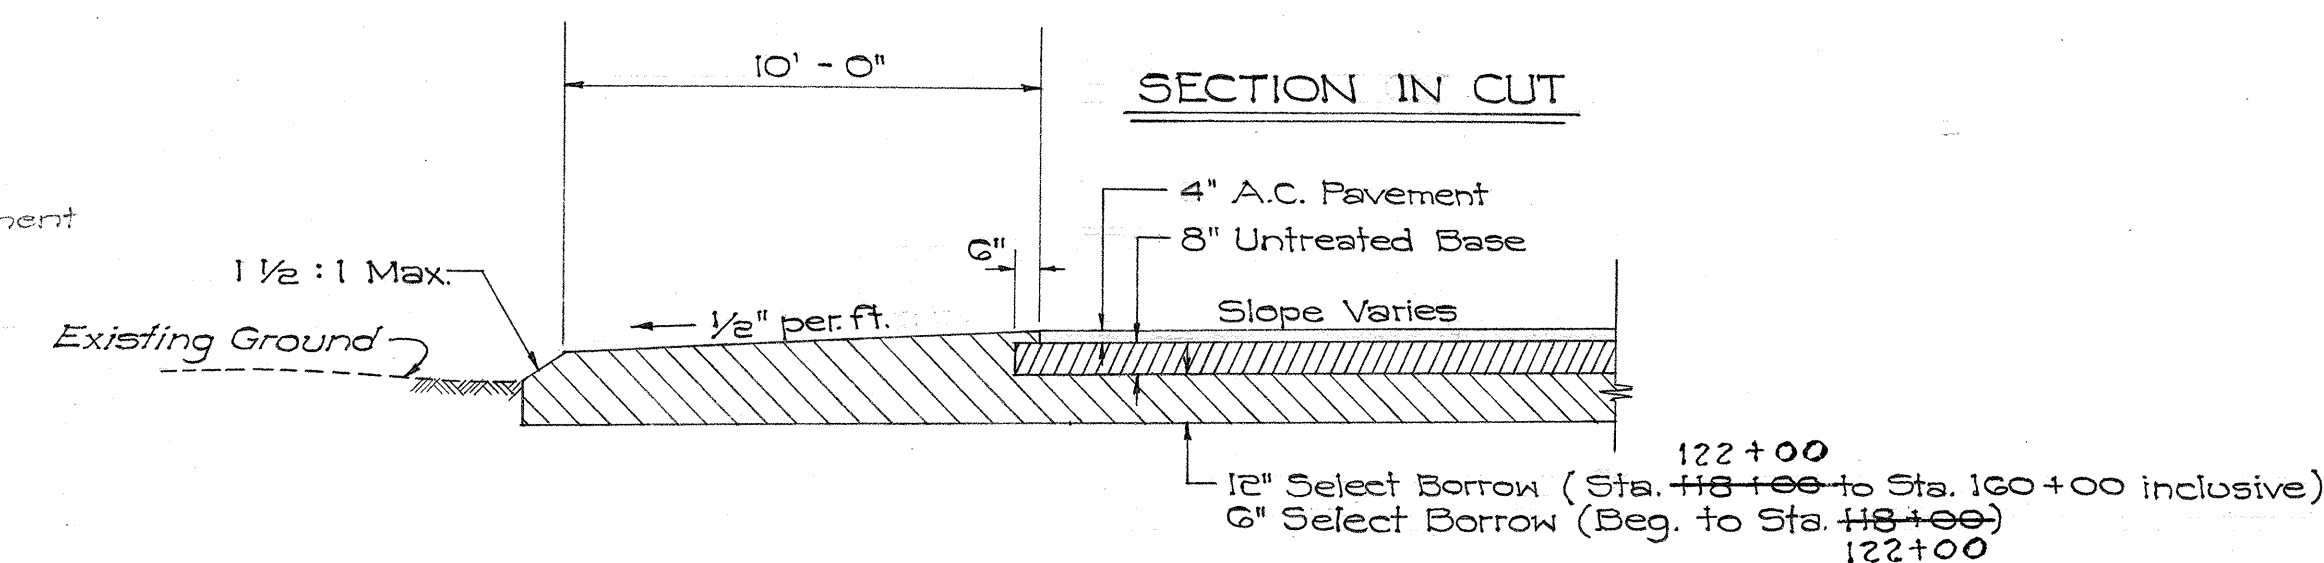

SECTION IN CUT

NO CURB ON OUTBOUND, LEFT EDGE OF PAVEMENT

TYPICAL SECTION AT INTERSECTION MEDIAN

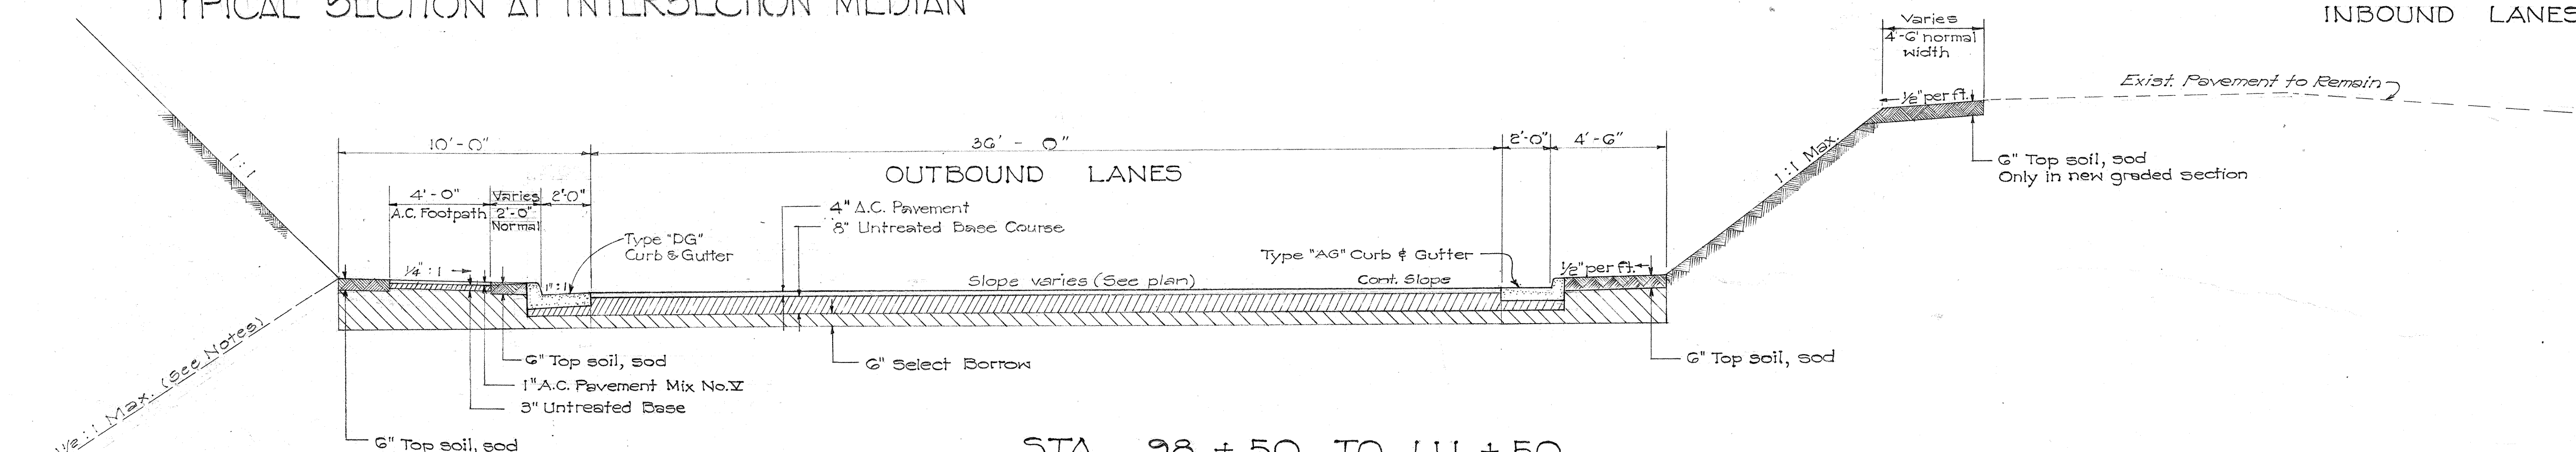

STA. 98 + 50 TO 111 + 50

DEPARTMENT OF TRANSPORTATION
HIGHWAYS DIVISION
STATE OF HAWAII
TYPICAL ROAD SECTIONS
FARRINGTON HIGHWAY
PROJECT NO. F-090-1(7)

Scale: 1/4" = 1'-0" Date: March, 1962

SHEET NO. 2 OF 2 SHEETS

SURVEY PLOTTED BY	DATE
DESIGNED BY	
DRAWN BY	
CHECKED BY	
QUANTITIES CHECKED BY	
NOTED BY	
NO.	