


STATE OF HAWAII  
DEPARTMENT OF TRANSPORTATION  
HIGHWAYS DIVISION  
HONOLULU, HAWAII

# INSTALLATION OF HIGHWAY LIGHTS

## ALONG FARRINGTON HIGHWAY

## FROM WAIKAWA OVERPASS TO KAHU RADIO STATION

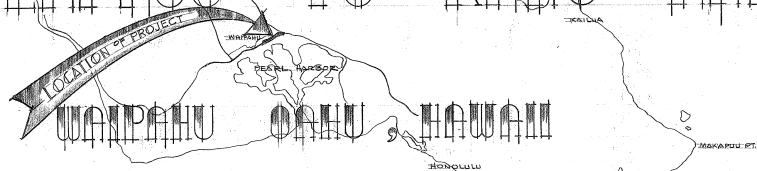

PROJECT NO. A - 90-01-63

"AS BUILT"

WYNN MAKAMURA LTD. CONSULTING ELECTRICAL ENGINEERS


INDEX OF DRAWINGS	
SHEET NUMBER	TITLE
1	TITLE SHEET & VICINITY PLAN MAP
2	HIGHWAY LIGHTING PLAN - STA. 184+10 TO 190+00
3	HIGHWAY LIGHTING PLAN - STA. 190+00 TO 212+50
4	HIGHWAY LIGHTING PLAN - STA. 212+50 TO 300+90
5	POLE & MISCELLANEOUS DETAILS

NOTE:

ALL CHANGES MADE DURING CONSTRUCTION  
HAVE BEEN NOTED ON THESE TRACINGS  
IN RED AND CHECKED BY:

Ray T. Kaula  
PROJECT ENGINEER

9/7/69  
DATE:

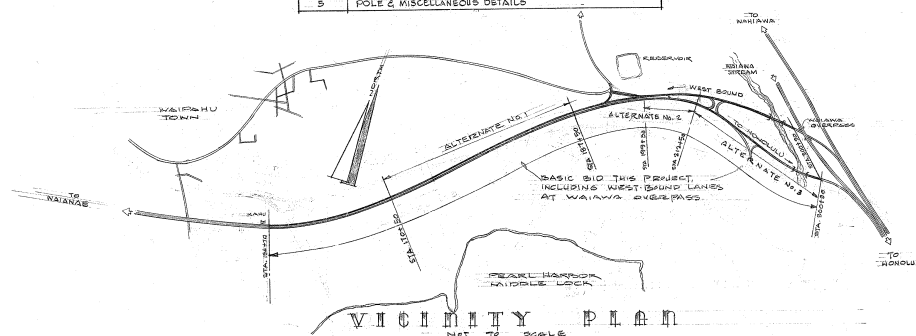

VICINITY PLAN  
NOT TO SCALE

APPROVED: DATE: 6 Apr 69  
John A. Hart  
DIRECTOR OF TRANSPORTATION

A 90 01 63 (1)