INDEX TO DRAWINGS			
SHEET NO.	DESCRIPTION		
. 1	Title Sheet and Layout Plan		

STATE OF HAWAII

DEPARTMENT OF TRANSPORTATION

HIGHWAYS DIVISION

HONOLULU, HAWAII
"AS BUILT"

THE RESURFACING OF A PORTION OF FARRINGTON HIGHWAY (INBOUND)

PLAN OF

WAIPAHU HIGH SCHOOL TO WAIPIO ACCESS ROAD

PROJECT NO. A-90-01-65

DISTRICT OF EWA ISLAND OF OAHU


NOTE:


ALL CHANGES MADE DURING CONSTRUCTION
HAVE BEEN NOTED IN RED ON THESE TRACINGS
AND CHECKED BY:

Fredrick J. Jokakann RESIDENT ENGINEER

1/19/66 DATE

LAYOUT PLAN

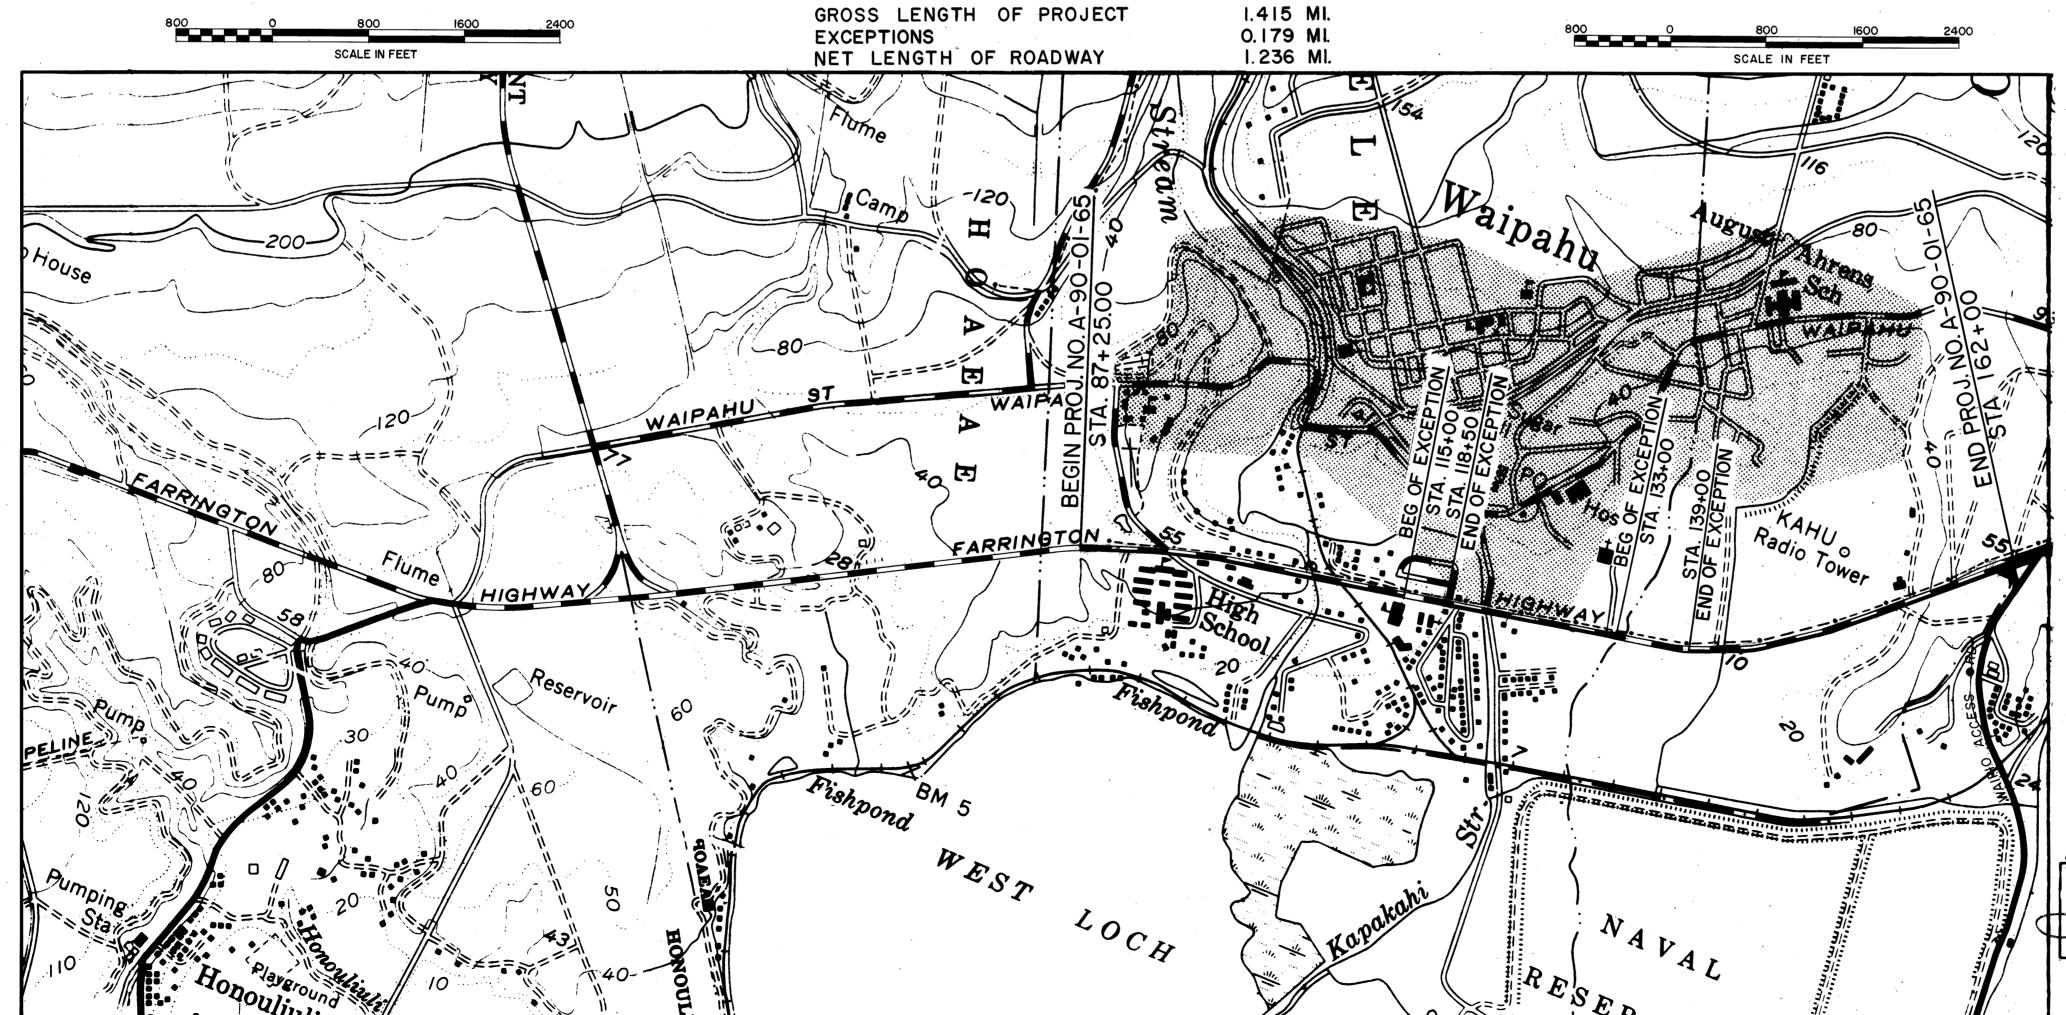

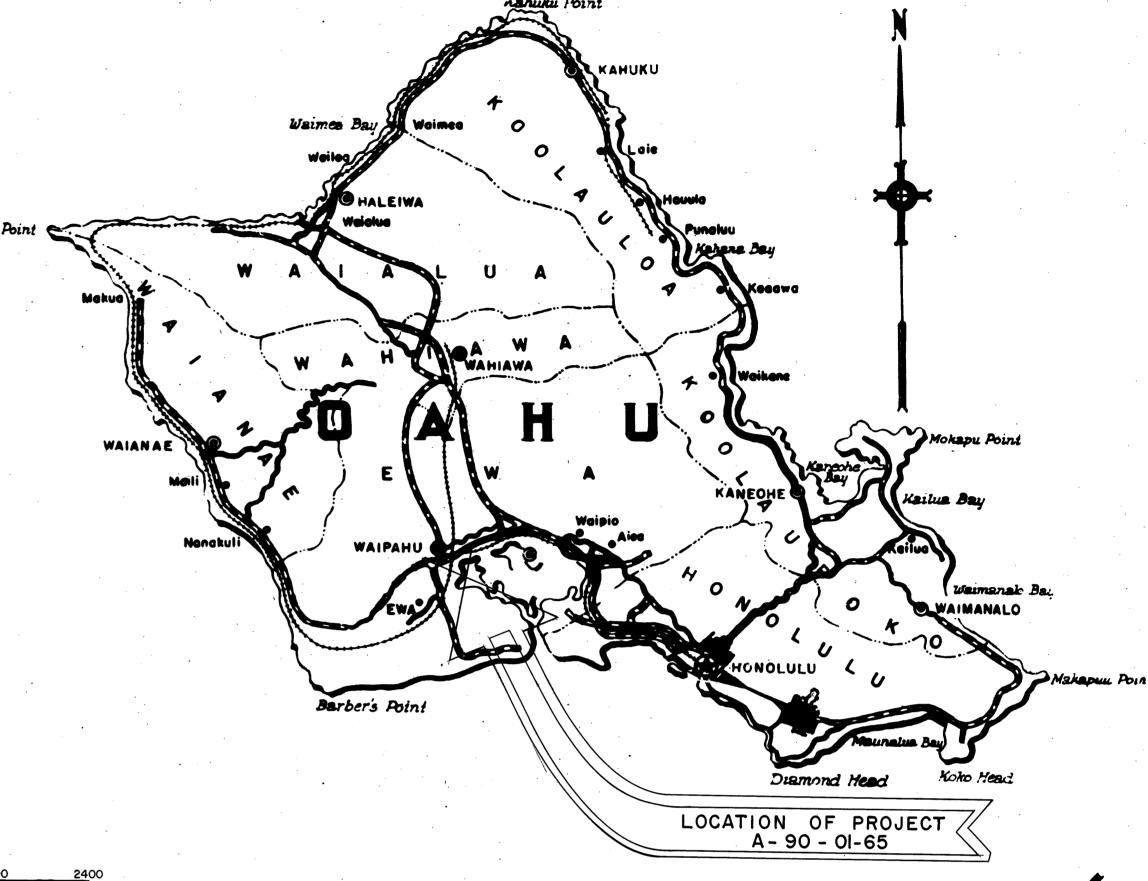

Federal Aid Projects Previously Constructed Or Under Construction

GENERAL NOTES:

I. Resurfaced Pavement thicknesses vary as follows:


INBOUND LANES	WIDTH	A.C. PAV'T. THICKNESS
		MIX NO. III MIX NO. I
Sta. 87 + 25 to S	Sta. 115 + 00 22'	1"
Sta. 115 +00 to 5	Sta. 118 + 50	Exception
Sta. 118 + 50 to 3	Sta. 133+ 00 22'	 /2 " /4" " 3/4"
Sta. 133 + 00 to 5	Sta. 139 + 00	Exception
Sta. 139 + 00 to 5	Sta. 162+ 00 22'	1 1/2" 11/4"

- Provide smooth transition between varying resurfaced pavement thicknesses.
 Auxiliary roads shall be resurfaced 10 feet from edge of the through pavement to conform to new pavement thickness.
- 4. Medial openings shall be resurfaced to conform with new pavement thickness.

 5. Existing Pavement shall be broomed-off and tack coated before laying the
- 6. Pot holes, cracks and crevices in the existing pavement shall be cleaned and paved with A.C. Mix No. I as ordered by the Engineer. No compensation will be made to the Contractor for this work other than the actual quantity of the material incorporated into the work and for which an item is listed in the proposal.
- 7. All existing Centerline Monuments shall be exposed after resurfacing. Payments to be incidental to Asphalt Concrete Payement.
- 8. After paving, the Contractor shall locate all existing manholes in a manner satisfactory to the Engineer. Payments to be incidental to Asphalt Concrete Payement.
- 9. Paving shall be limited to the hours of 8:00 A.M. to 3:30 P.M. on a working day unless otherwise authorized in writing by the Engineer.

TO During hours of paving inbound traffic shall be diverted to outbound lanes.

10. Waikele Canal Bridge & highway overpass was not paved.

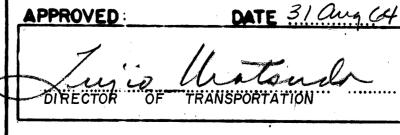

SURVEY PLOTTED BY
DRAWN BY
TRACED BY
OUANTITIES BY
OUANTITIES CHECKED BY

/ - - B