

INDEX	
SHEET NO.	DESCRIPTION
1	TITLE SHEET
2	TRAFFIC SIGNAL SYSTEM
3-5	MISCELLANEOUS DETAILS

STATE OF HAWAII

DEPARTMENT OF TRANSPORTATION

HIGHWAYS DIVISION

HONOLULU, HAWAII

"AS BUILT"

PLANS FOR

INSTALLATION OF TRAFFIC SIGNALS

ON

FARRINGTON HIGHWAY

AT


PAIWA STREET AND AWANUI STREET

FEDERAL AID PROJECT NO.

F-090-1(12), Unit I

DISTRICT OF EWA

ISLAND OF OAHU

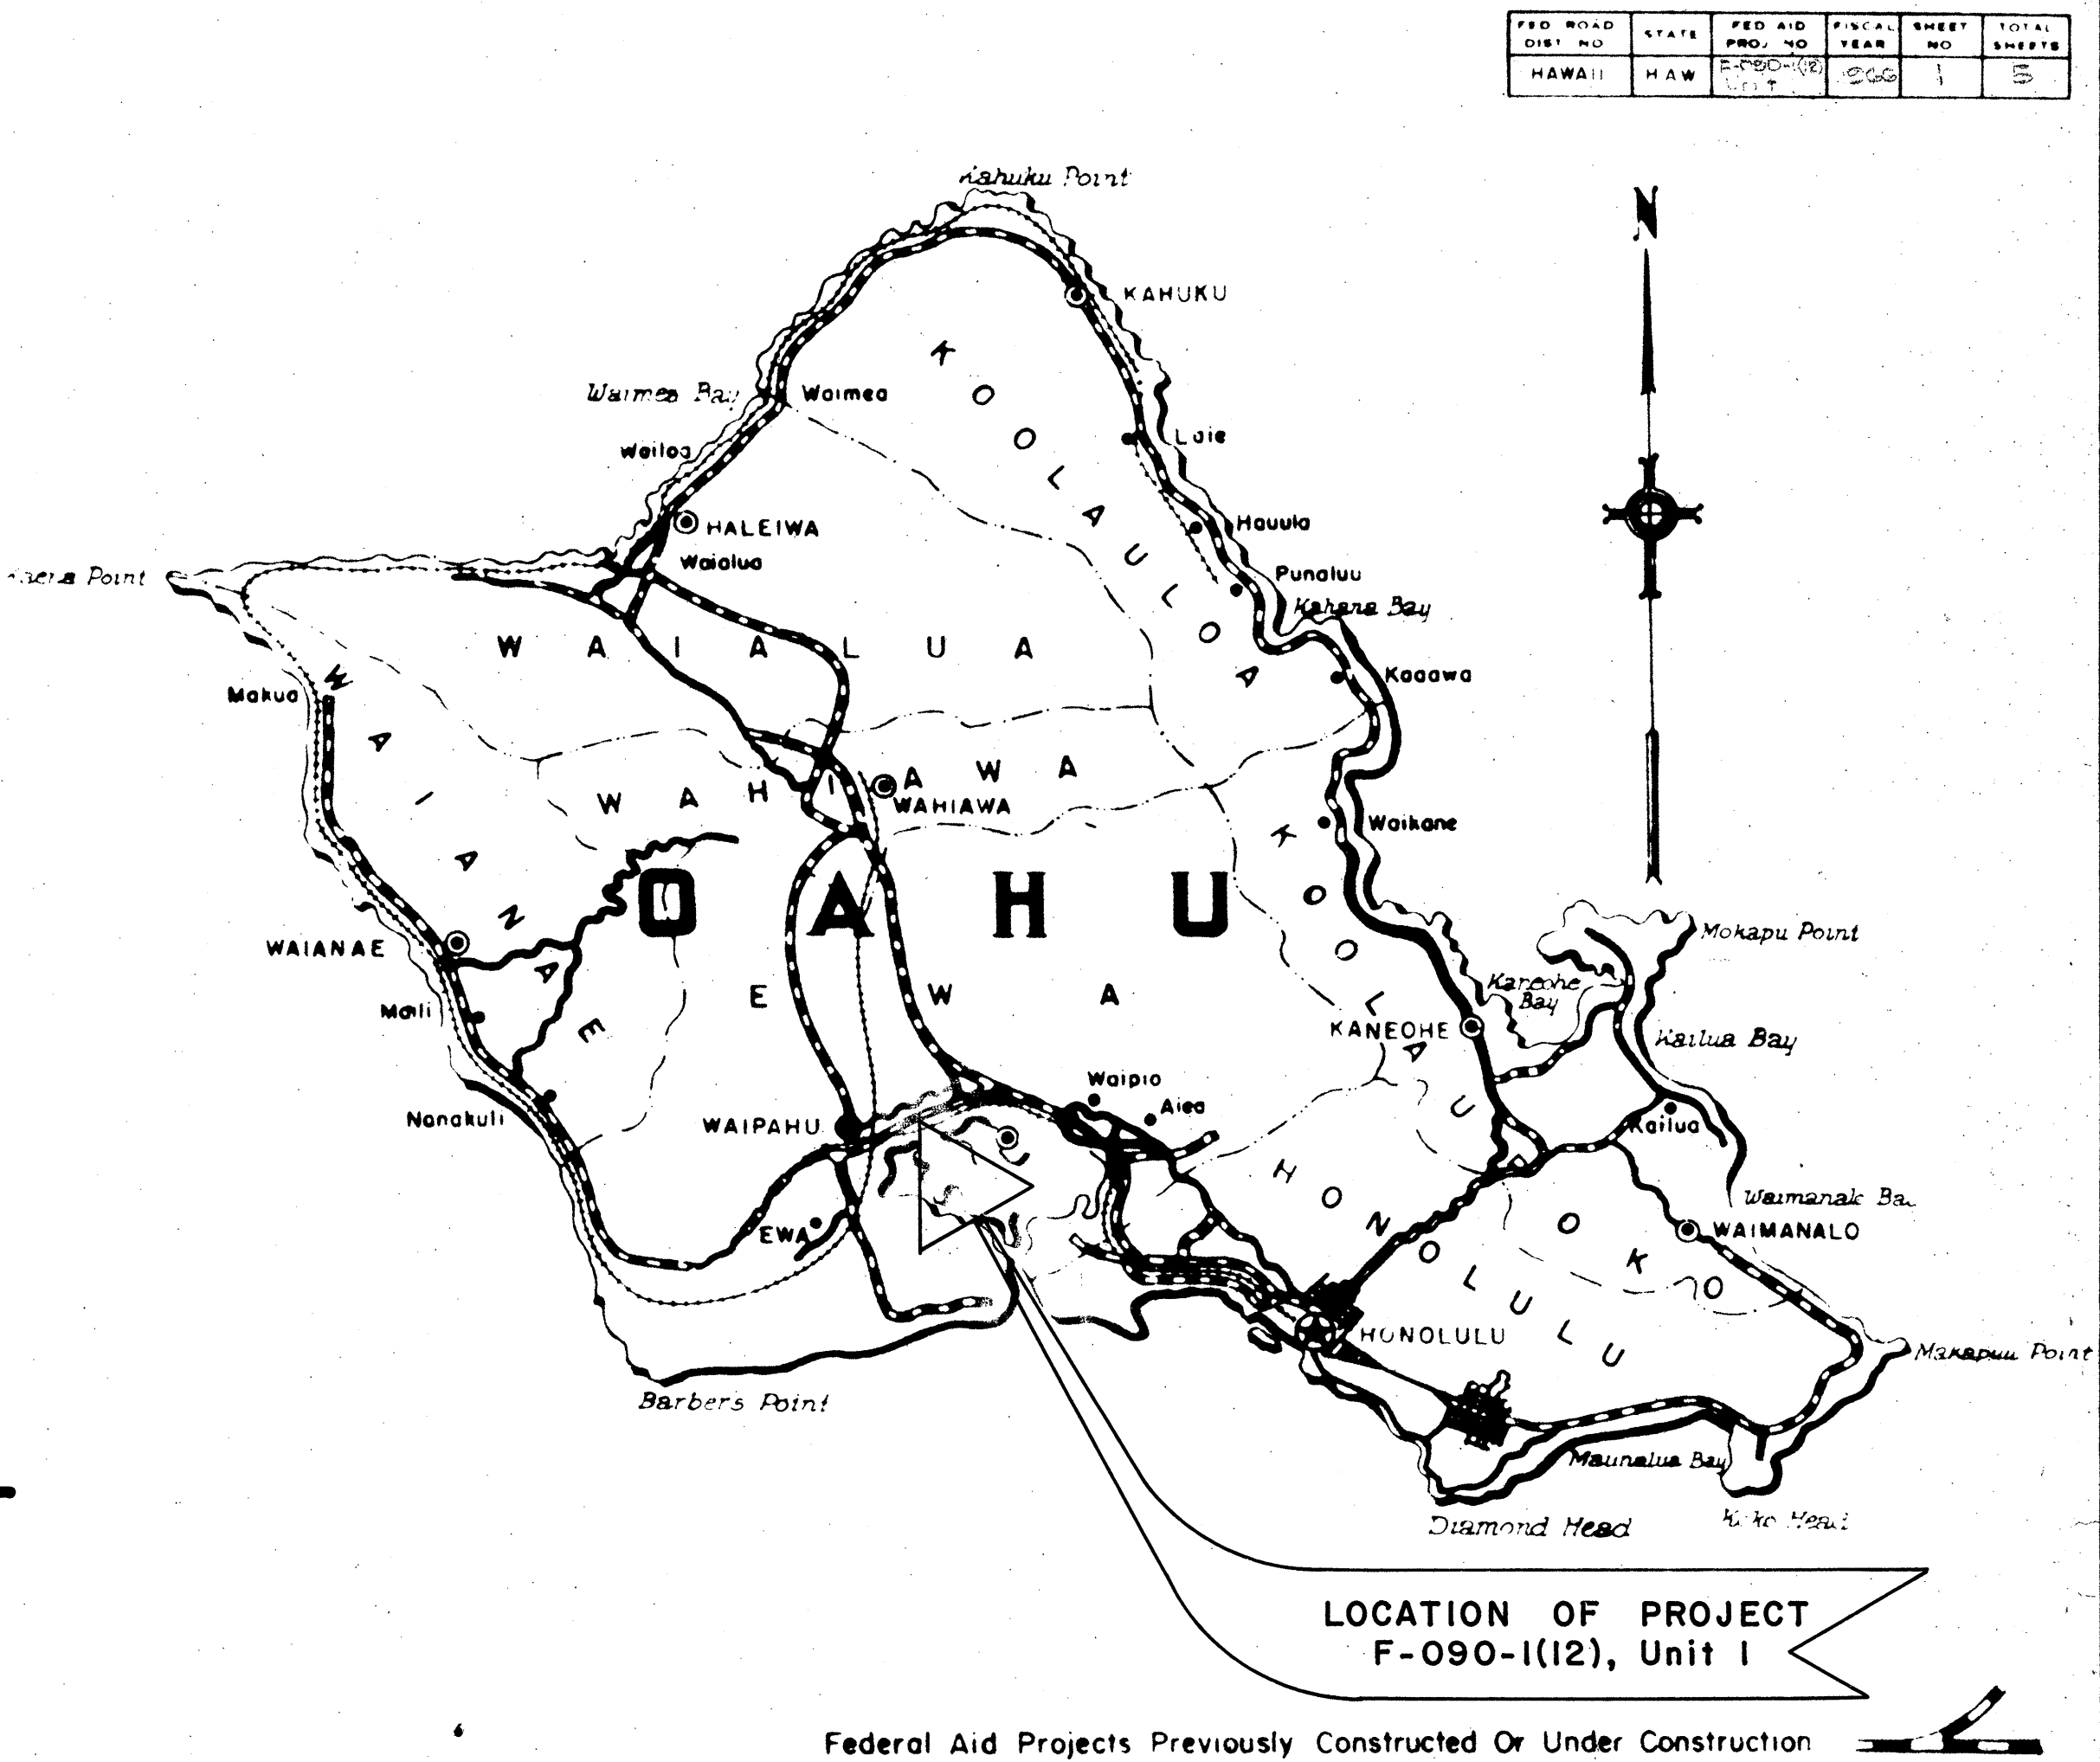

NOTE :

ALL CHANGES MADE DURING CONSTRUCTION

HAVE BEEN NOTED ON THESE TRACINGS IN

RED AND CHECKED BY :

PROJECT ENGINEER

DATE

DEPARTMENT OF TRANSPORTATION

STATE OF HAWAII

APPROVED:

*Leopoldo B. ...*

DIRECTOR

DATE

DEPARTMENT OF COMMERCE


BUREAU OF PUBLIC ROADS

APPROVED:


*John B. ...*

DIVISION ENGINEER

DATE

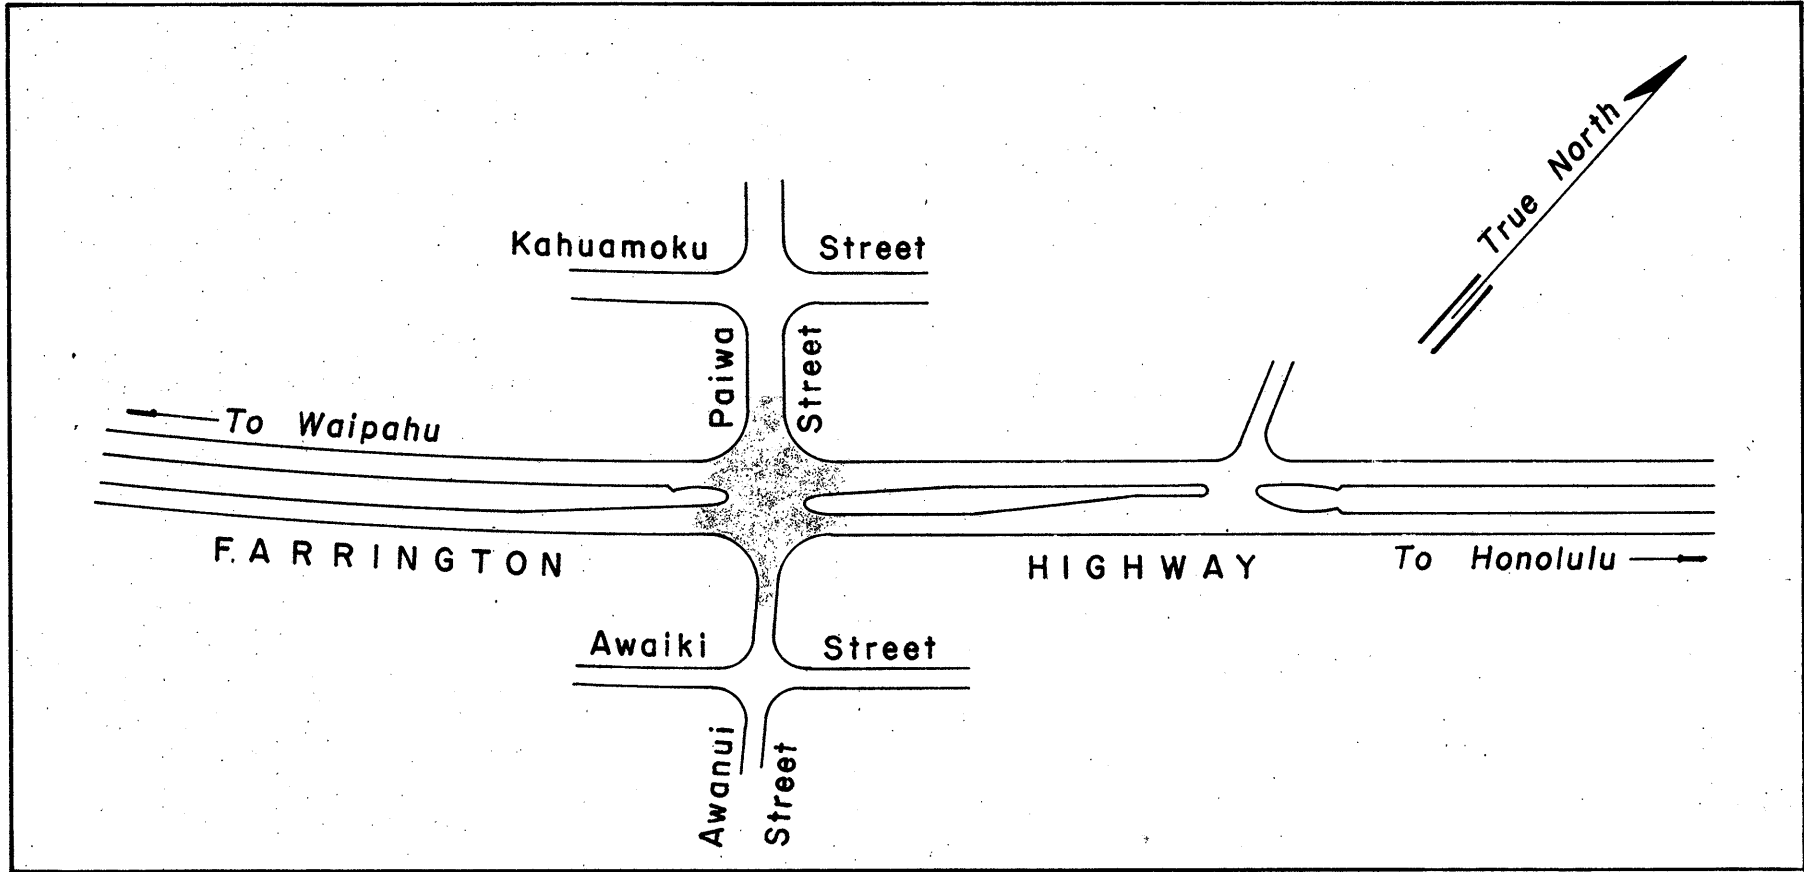

LAYOUT PLAN

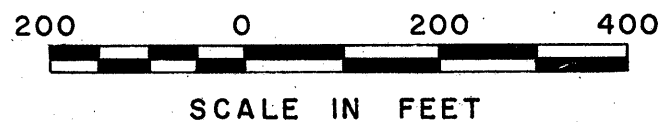

DATE

SURVEY PLATTED BY

DESIGNED BY

TRACED BY

OF ANTITIES BY

OF ANTITIES CHECKED BY

CREATED BY

NOTE BOOK

No.