INDEX TO DRAWINGS	
SHEET NO.	DESCRIPTION
	TITLE .
12 ¹² . 12 ¹²	PLAN (1997)
3	PLAN a said and a said and a said and a said
4	PLAN
, 5	PLAN
	PLAN AND SPECIAL DETAILS
7 7	SPRINKLER DETAILS
Sale-Times A Committee and Times and Times A Committee and Times A	SPECIAL DETAILS
	SPRINKLER SUMMARY
,	
-	
,	

STATE OF HAWAII

DEPARTMENT OF TRANSPORTATION
HIGHWAYS DIVISION

HONOLULU, HAWAII


"AS BUILT PLANS FOR

FARRINGTON HIGHWAY BEAUTIFICATION

KUNIA ROAD TO VICINITY OF KAHU RADIO STATION

FED. AID PROJ. No. LSF 090-1 (1)

DISTRICT OF EWA

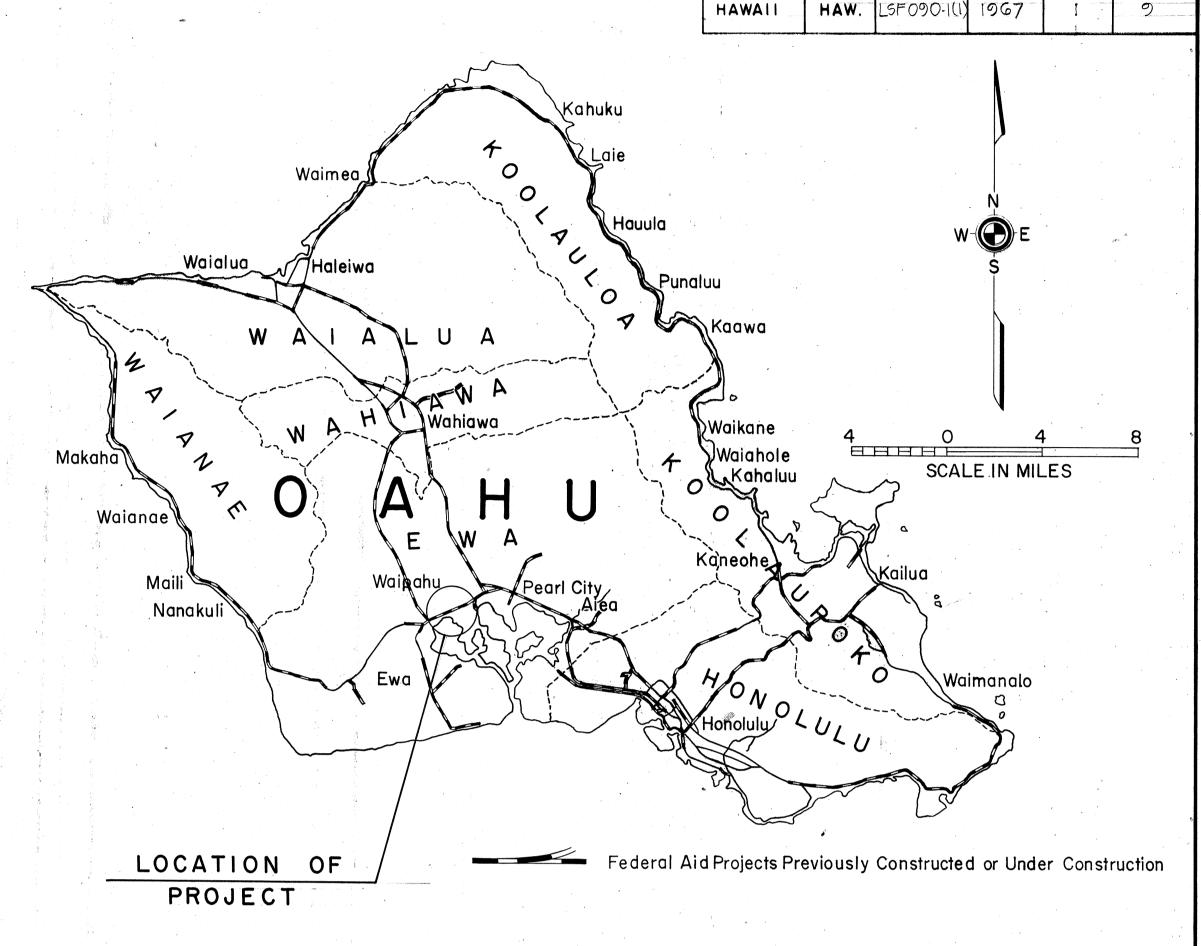

NOTE:

ALL CHANGES MADE DURING COSTRUCTION HAVE BEEN INCORPORATED ON THESE PLAN IN RED.

Leong J. Kau
PROJECT ENGINEER

12/4/72
DATE

DEPARTMENT OF TRANSPORTATION
BUREAU OF PUBLIC ROADS

APPROVED:

| John Signe | 6-30-67 |
| DIVISION ENGINEER | DATE

DEPARTMENT OF TRANSPORTATION
STATE OF HAWAII

APPROVED:

6-19-67

NDIR. OF TRANSPORTATION DATE

5

FED. AID FISCAL SHEET TOTAL PROJ. NO. YEAR NO. SHEETS