

INDEX TO DRAWINGS	
SHEET NO.	DESCRIPTION
1	TITLE SHEET
2	TRAFFIC SIGNAL SYSTEM
3-5	MISCELLANEOUS DETAILS

STATE OF HAWAII

DEPARTMENT OF TRANSPORTATION

HIGHWAYS DIVISION

HONOLULU, HAWAII

"AS BUILT"

PLANS FOR

INSTALLATION OF TRAFFIC SIGNALS

ON

FARRINGTON HIGHWAY

AT

PUPUKAHI STREET


FEDERAL AID PROJECT NO.

F-090-1(12), Unit 2

DISTRICT OF EWA

ISLAND OF OAHU

FED. ROAD DIST. NO.	STATE	FED. AID PROJ. NO.	FISCAL YEAR	SHEET NO.	TOTAL SHEETS
HAWAII	HAW.	F-090-1(12) Unit 2	1968	1	5

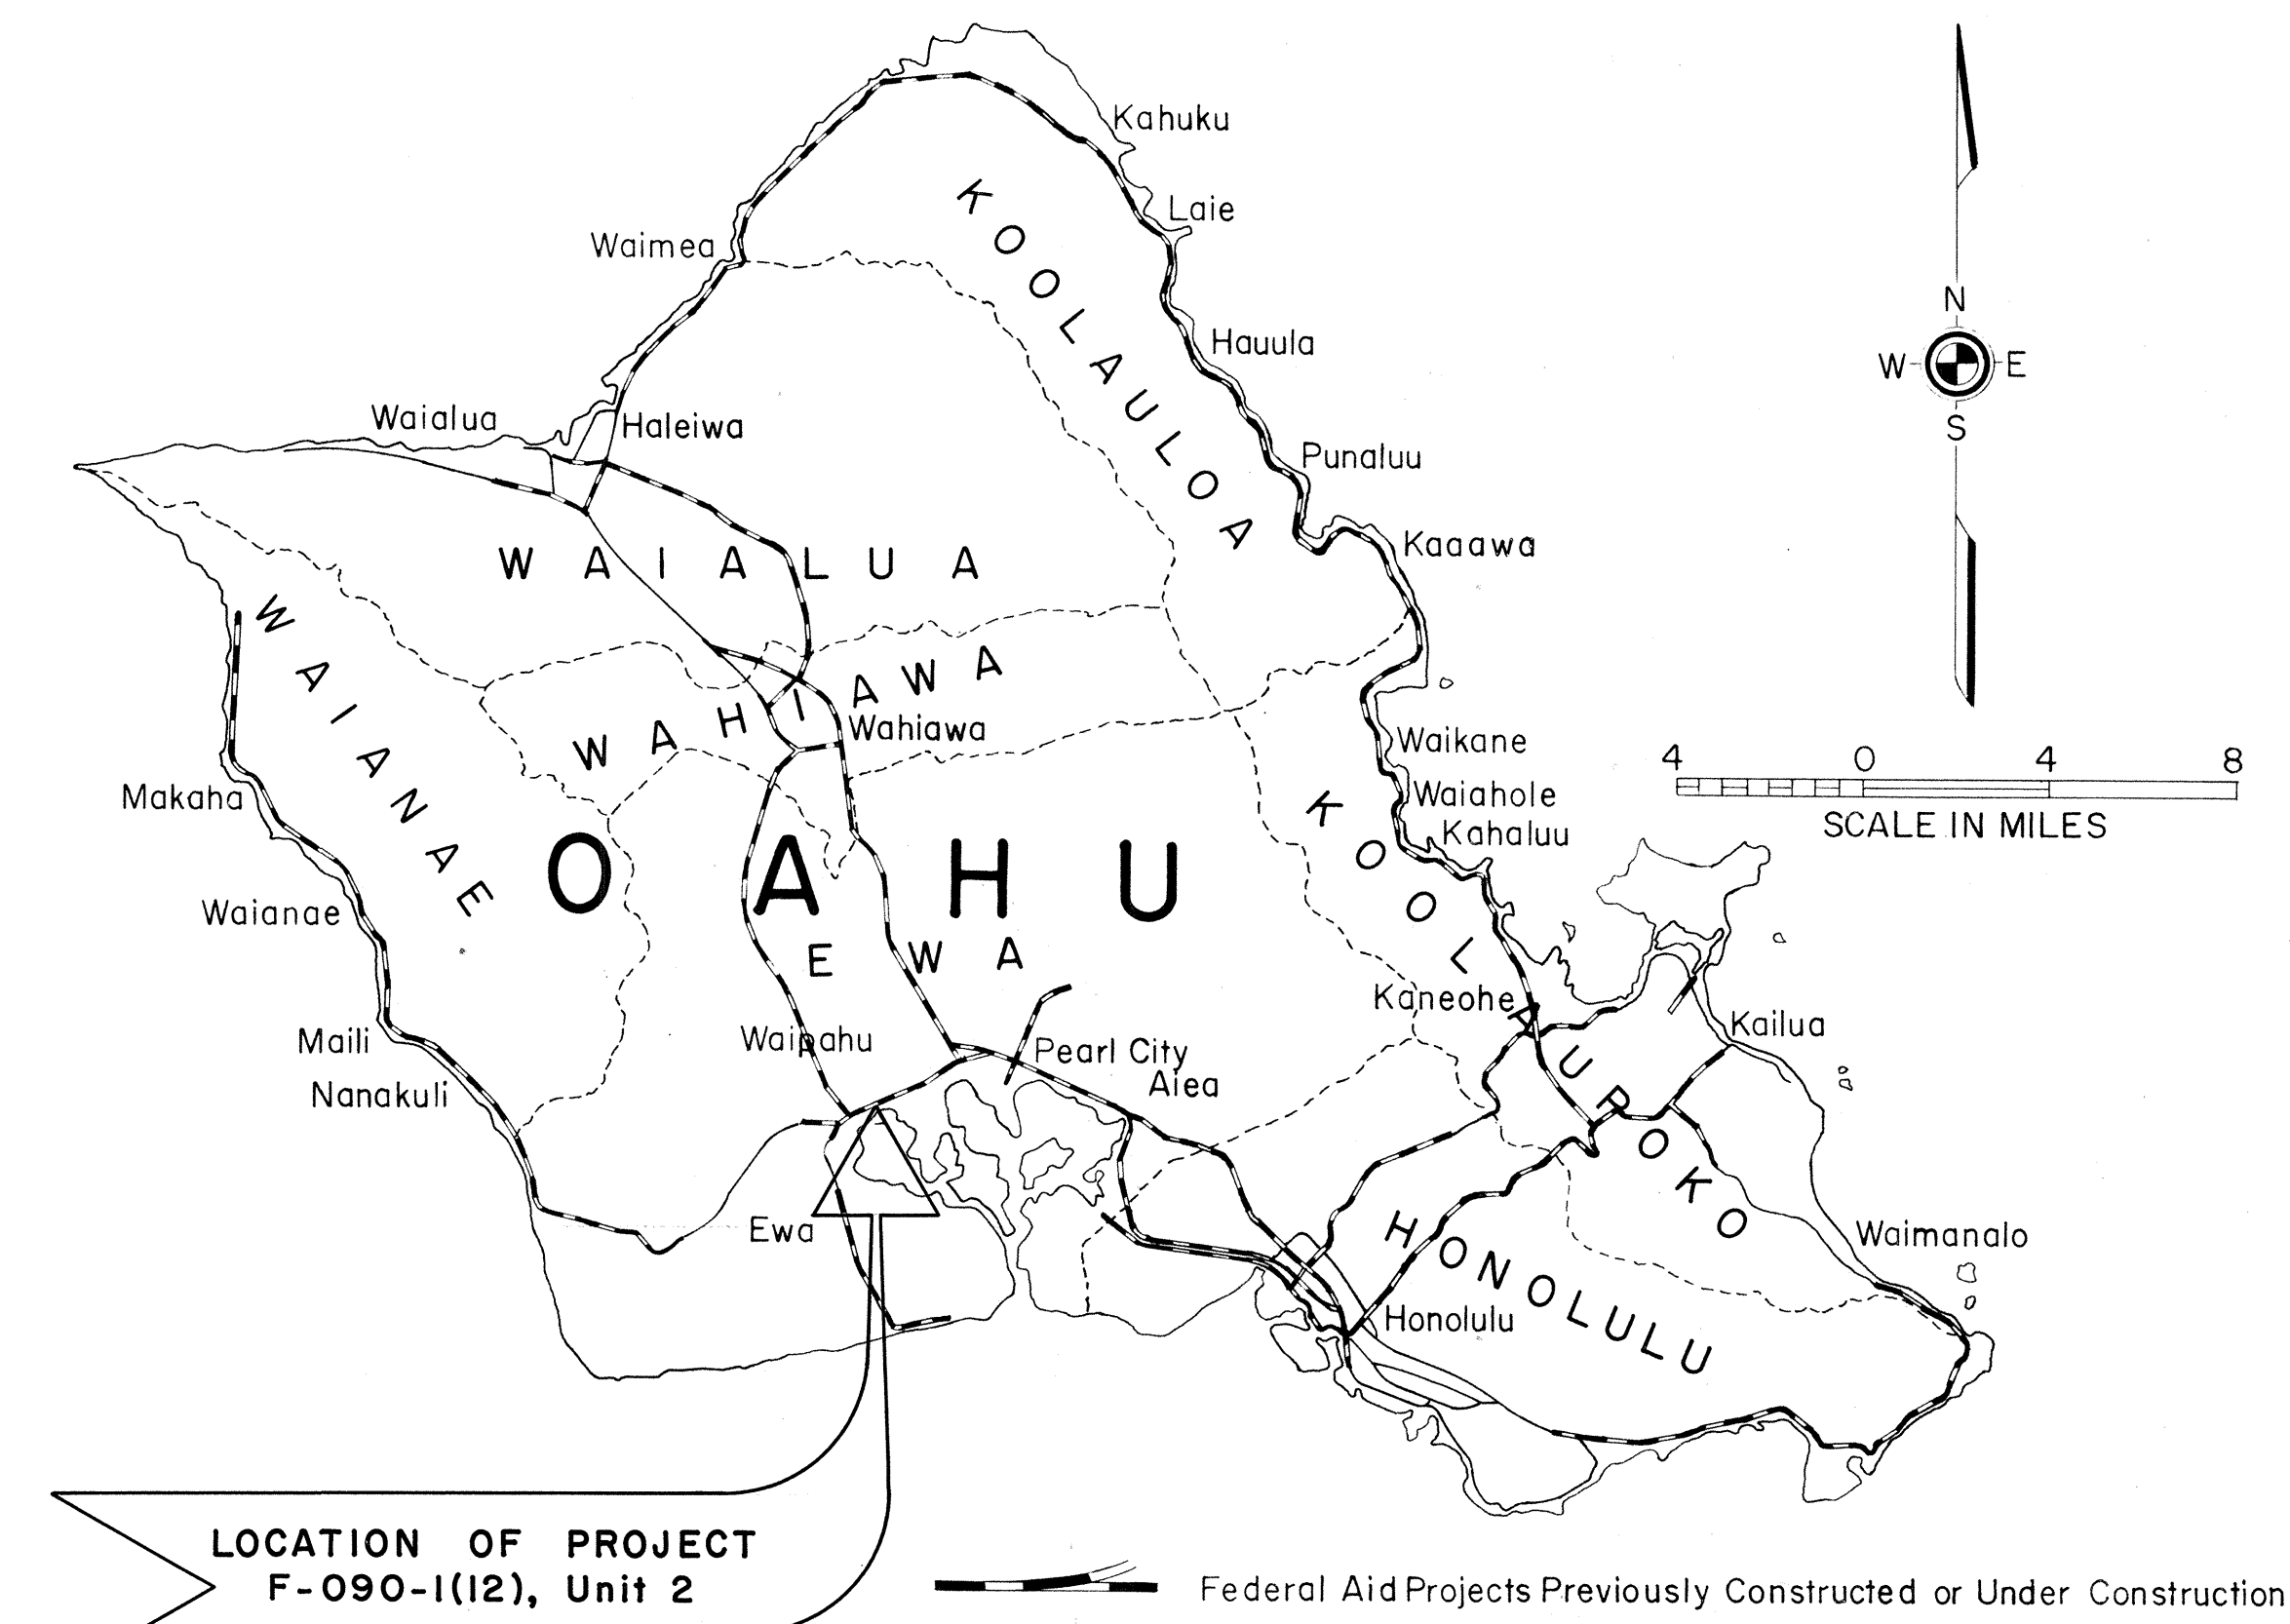

NOTE:

ALL CHANGES MADE DURING CONSTRUCTION HAVE BEEN

NOTED ON THESE TRACINGS IN RED AND CHECKED BY:

Honorio Basua 5/15/69

PROJECT ENGINEER DATE

DESIGN CLASSIFICATION

ADT (1967) 29,600

DESIGN ADT (1988) . . . 16,500


DHV 11.0 %

D 55/45

T 5.5%

T₂₄ 6.5 %

V 50 MPH.

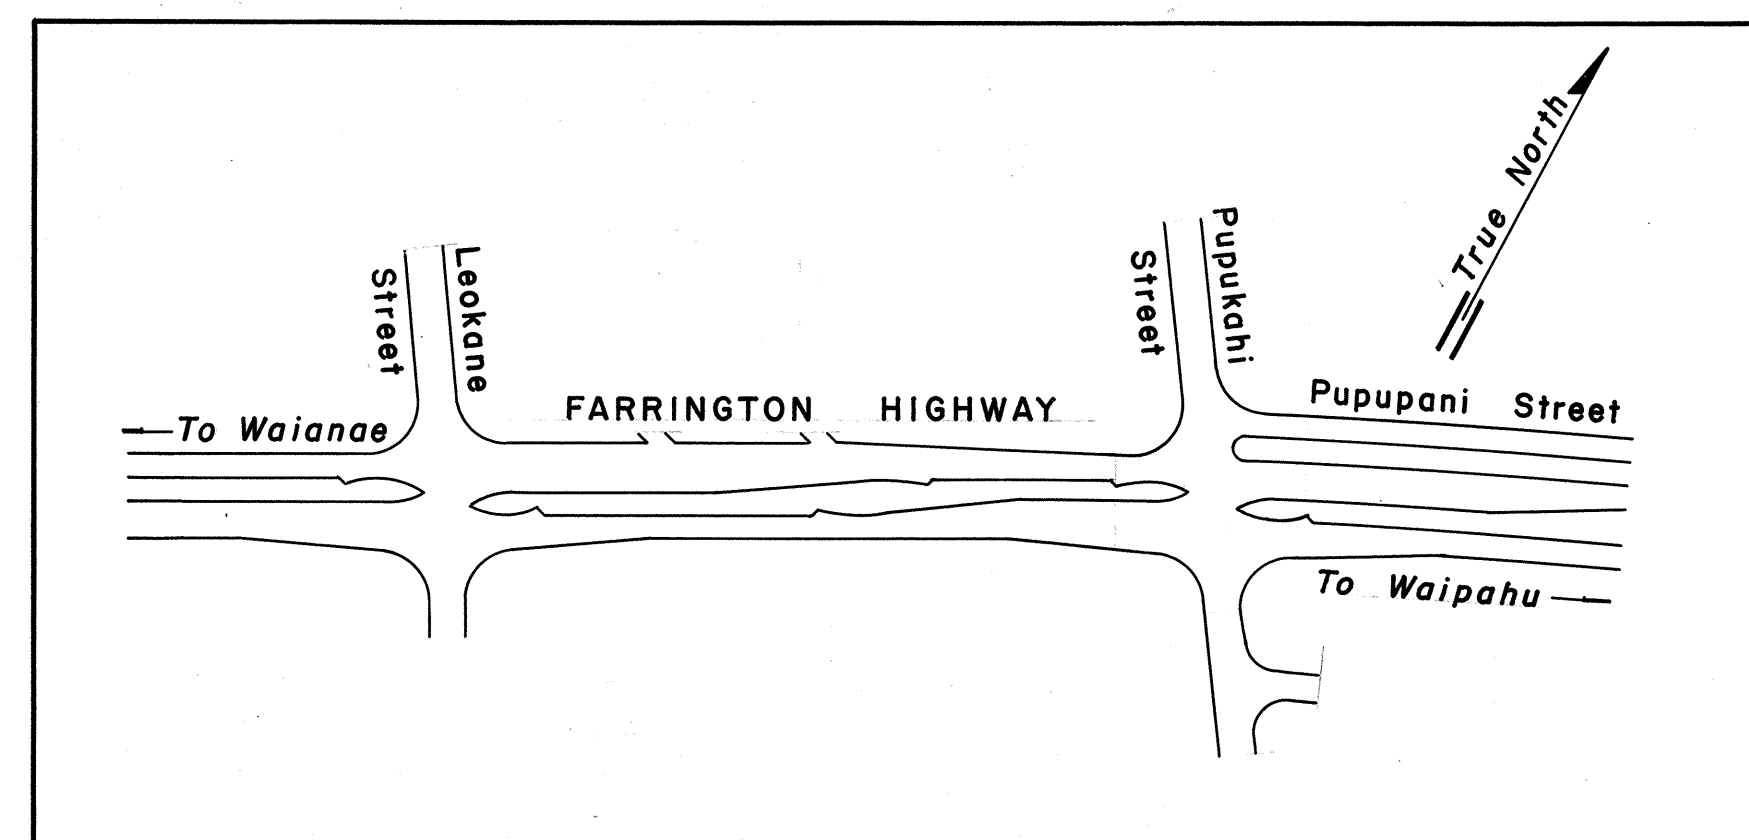

LAYOUT PLAN



DEPARTMENT OF TRANSPORTATION

BUREAU OF PUBLIC ROADS

APPROVED: *John B. Dalhouse* 3-13-68

DIVISION ENGINEER DATE

DEPARTMENT OF TRANSPORTATION

STATE OF HAWAII

APPROVED: *John W. Auliffe* 2-19-68

DIR. OF TRANSPORTATION DATE