
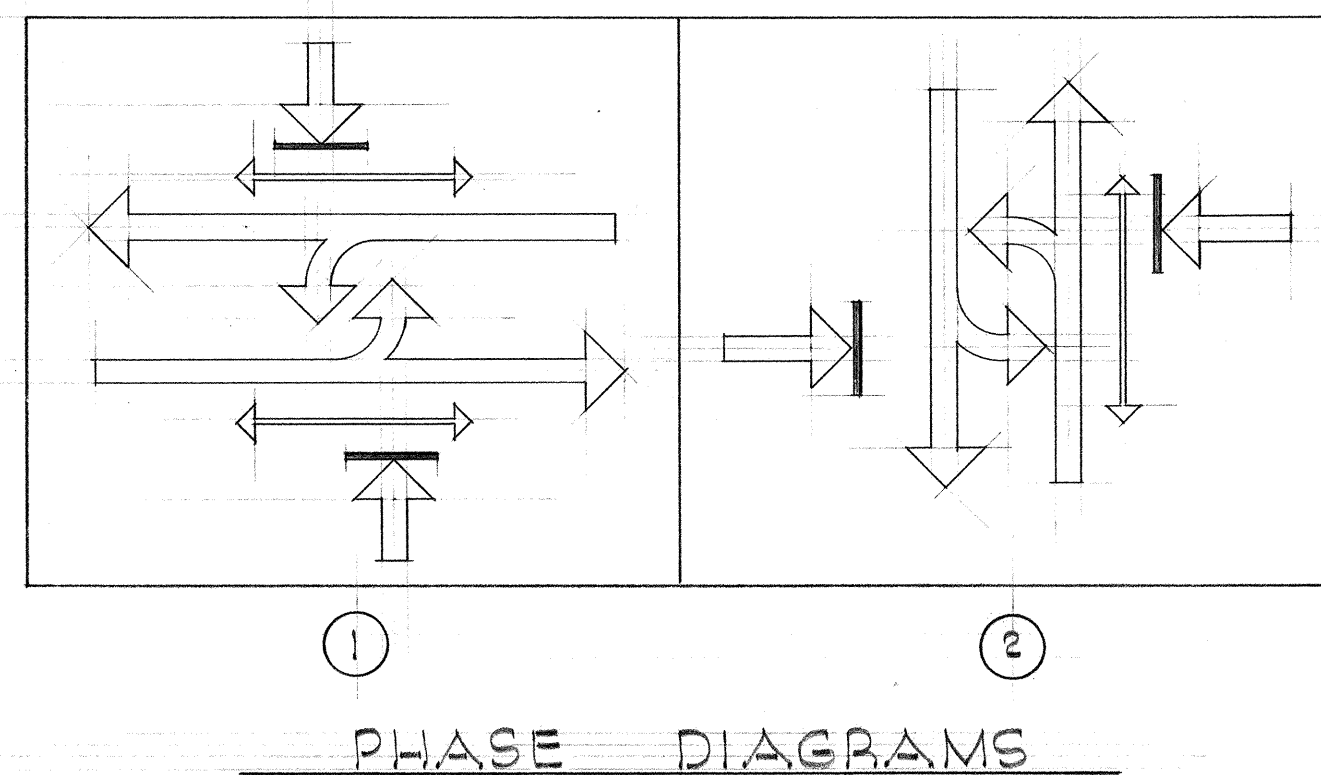


FED. ROAD DIST. NO.	STATE	FED. AID PROJ. NO.	FISCAL YEAR	SHEET NO.	TOTAL SHEETS
HAWAII	HAW.	F-090-1(12) Unit 2	1968	2	5

NOTE:

There are existing sprinkler heads and lines in the Farrington Highway medians on both sides of the intersection. The Contractor shall excavate carefully to avoid damage to the sprinkler system. Damage to the sprinkler system caused by the Contractor shall be repaired at the Contractor's expense.

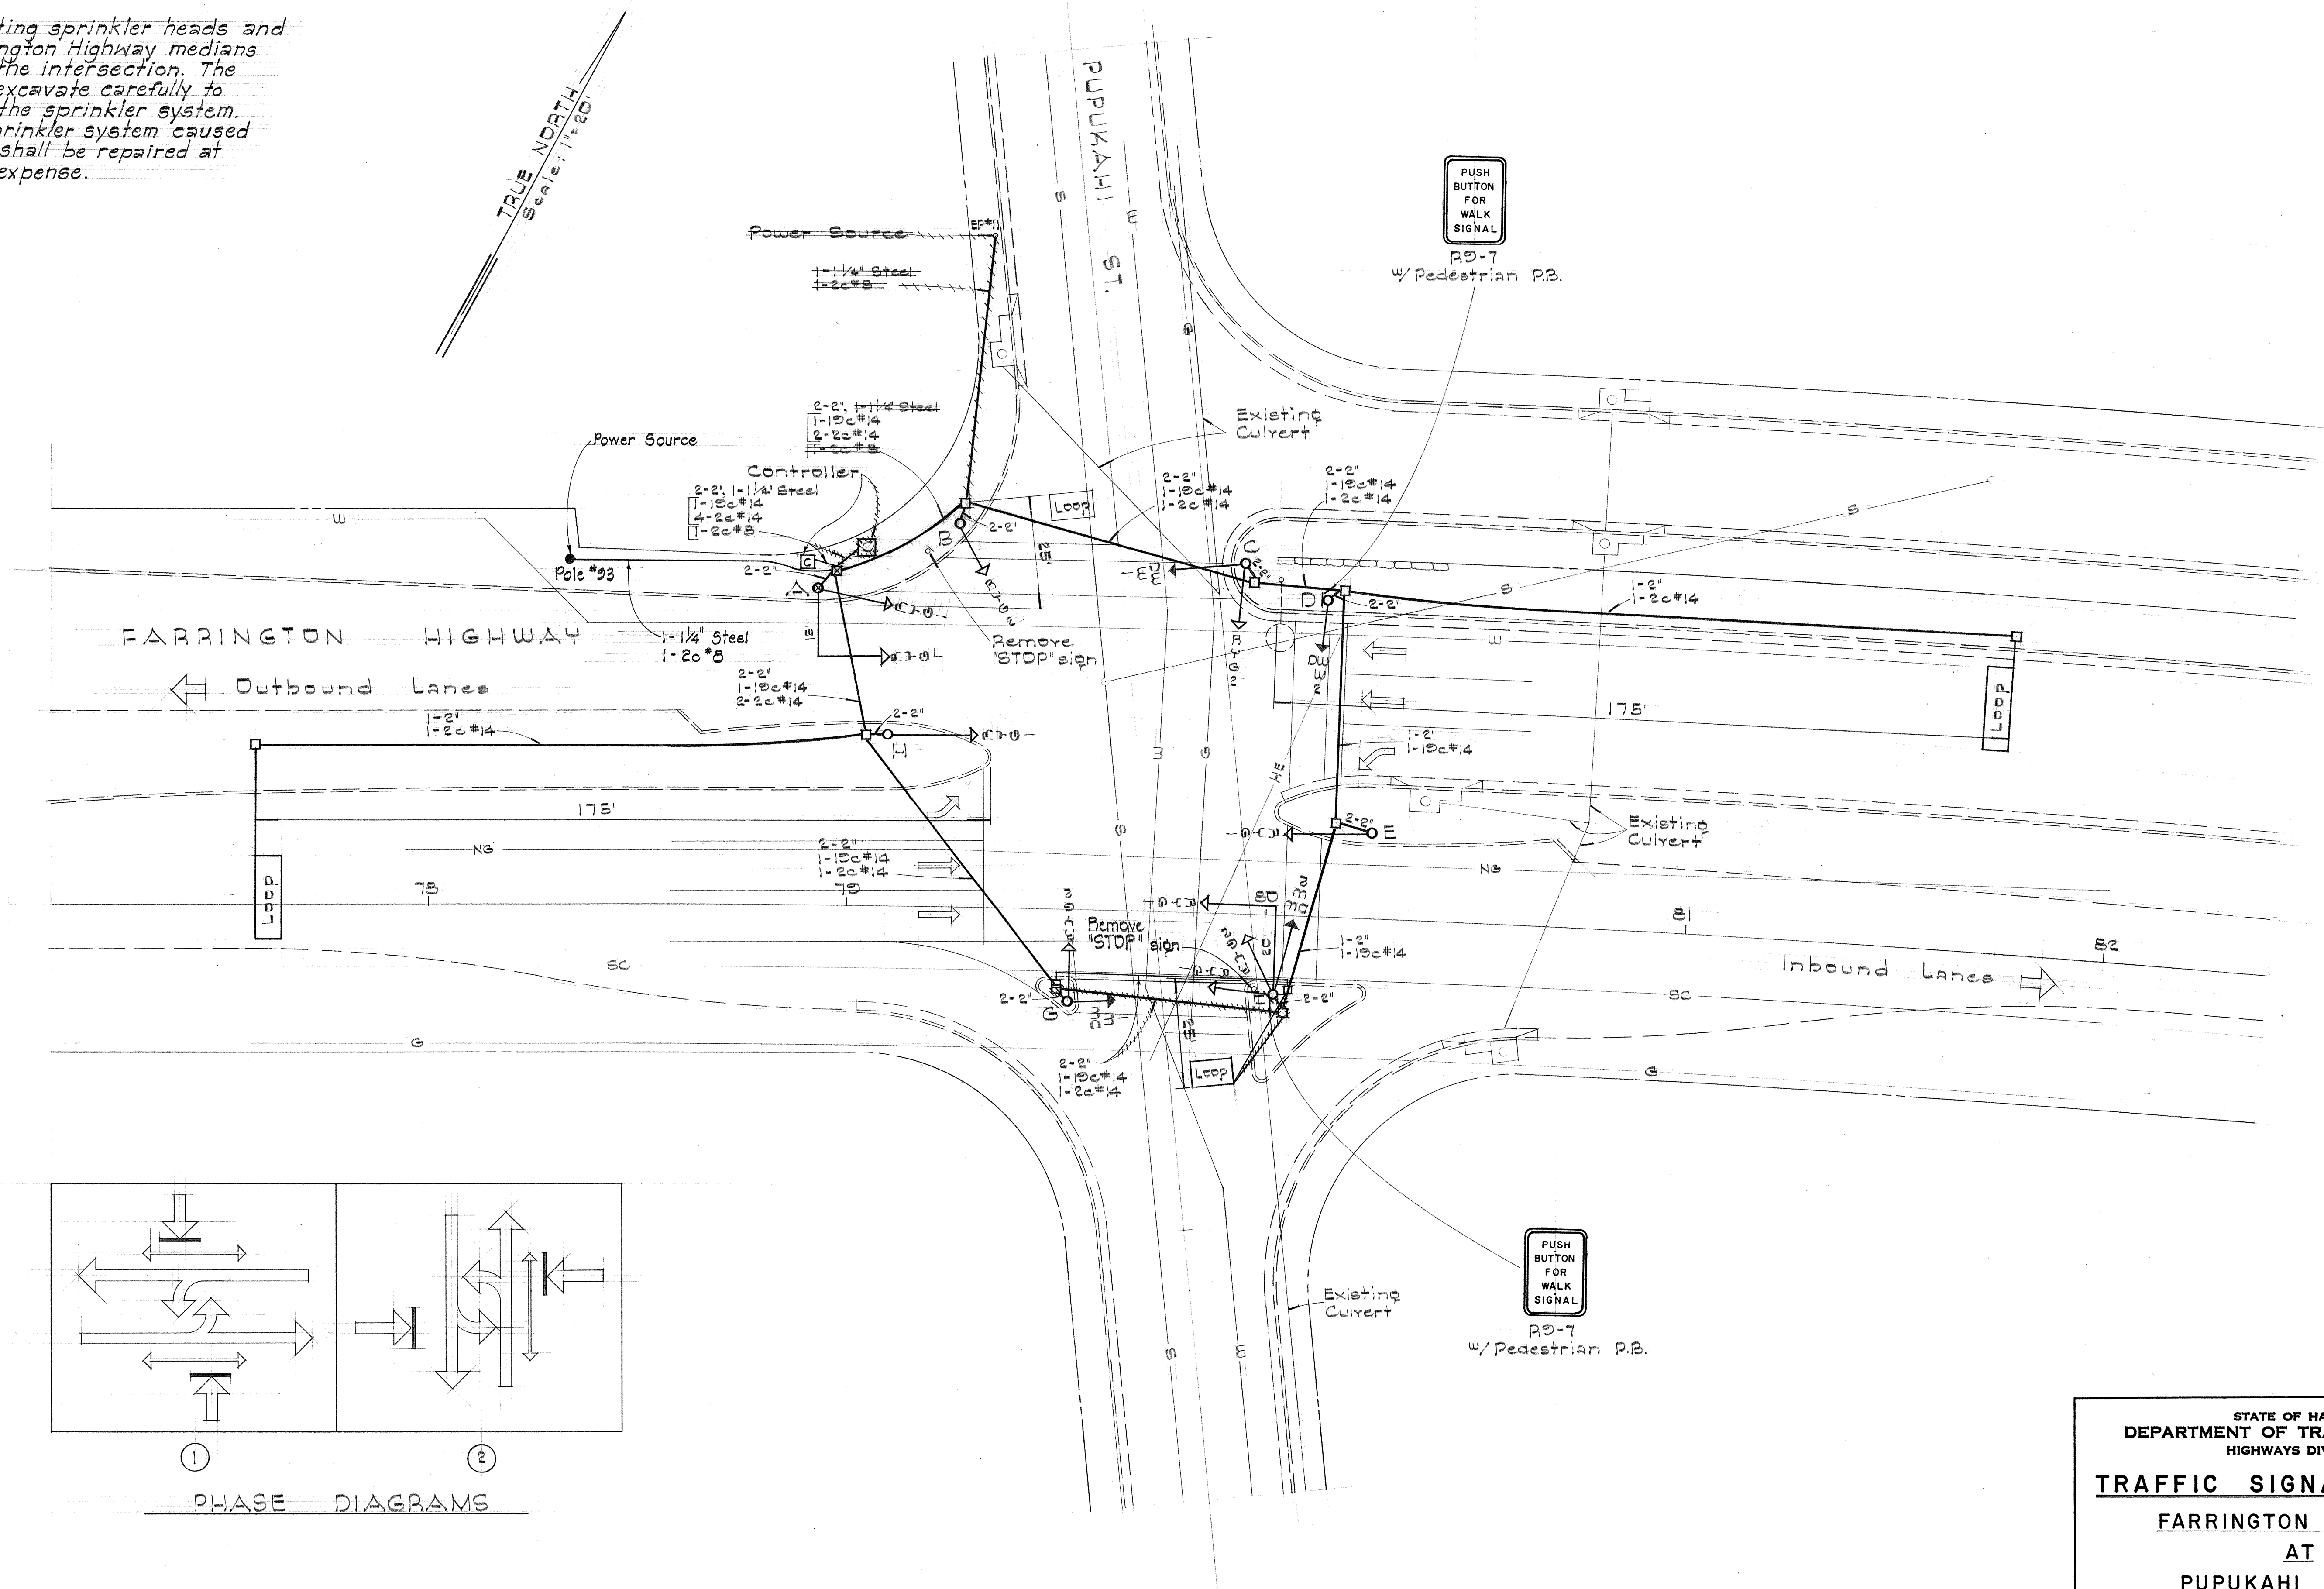

SURVEY PLANNED BY	DATE
DRAWN BY	
TRACED BY	
NOTED BY	
CHECKED BY	
ORIGINAL PLAN	
NOTE BOOK	
No.	

STATE OF HAWAII
DEPARTMENT OF TRANSPORTATION
HIGHWAYS DIVISION

TRAFFIC SIGNAL SYSTEM

FARRINGTON HIGHWAY
AT
PUPUKAHI STREET

Project No. F-090-1(12), Unit 2
Scale: 1" = 20' February 1968

SHEET No. 2 OF 5 SHEETS