	NDEX TO	DRAWIN	IGS	, , , , , , , , , , , , , , , , , , ,	
SHEET NO.	DESCRIPTION				
	TITLE SHEET				
2-3	TRAFFIC	AFFIC SIGNAL SYSTE		EM	è
4-8	MISCELLANEOUS		DETAILS		
			and an artist of the second		
			. 64		
	100		3		
		e			
			**		
3					
h		,			
	,	4	a kayayayiya dalar aray sarayiyaya daliisiid dayada dadada dalada dalada dalada dalada dalada dalada dalada da		
	3				
			plant and transcription and an extensive state of the Adal Adal Adal Adal Adal Adal Adal Adal		,
				engaannepathemenen ar fattilden hanssal	
			*.		

STATE OF HAWAII

DEPARTMENT OF TRANSPORTATION HIGHWAYS DIVISION

HONOLULU, HAWAII

"AS BUILT"


PLANS FOR INSTALLATION OF TRAFFIC SIGNALS ON

FARRINGTON HWY. AT WAIAWA ACCESS RD. AND

FARRINGTON HWY. AT WAIPIO POINT ACCESS RD.

PROJ. No. 90A-01-71

DISTRICT OF EWA ISLAND OF OAHU

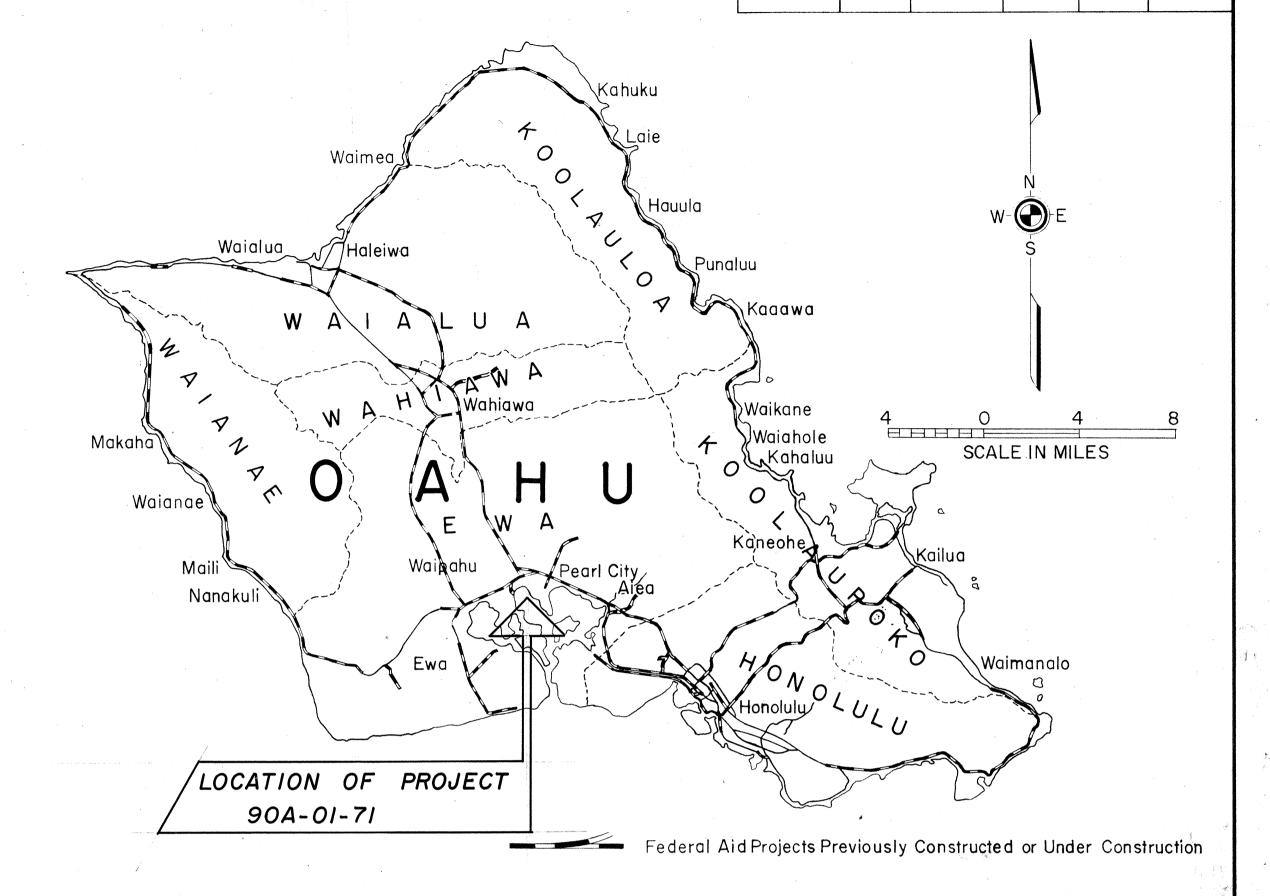


NOTE:

ALL CHANGES MADE DURING CONSTRUCTION HAVE BEEN NOTED IN RED ON THESE TRACINGS AND CHECKED BY

8/22/73

PROJ. NO. YEAR

DEPARTMENT OF TRANSPORTATION STATE OF HAWAII APPROVED: Por DIR. OF TRANSPORTATION

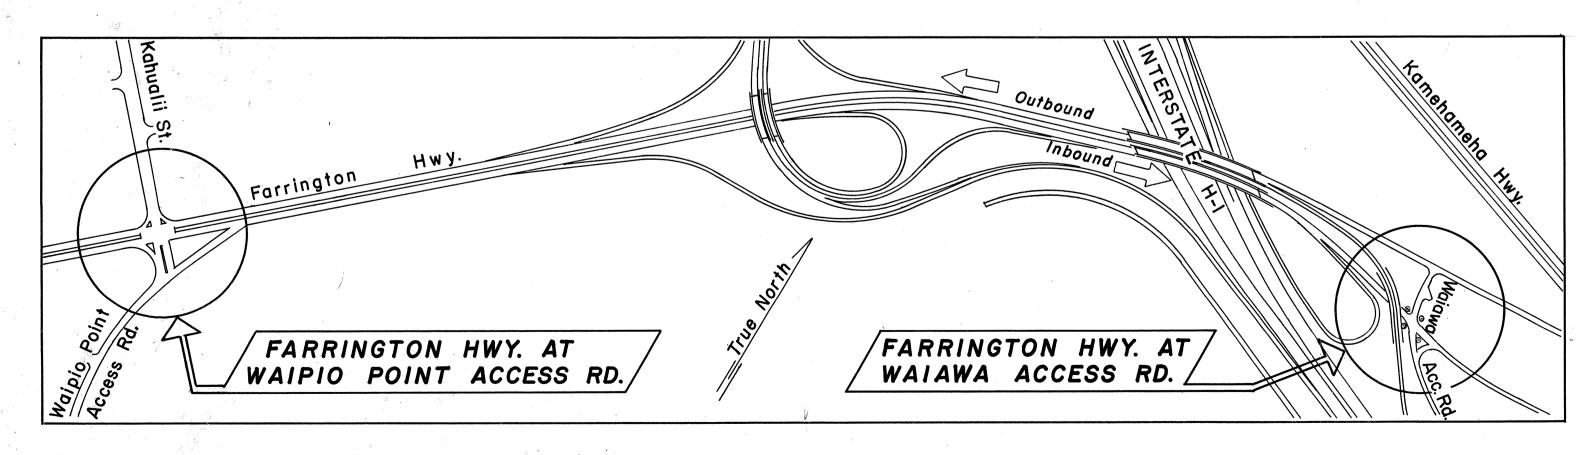

LAYOUT PLAN