


FED. ROAD DIST. NO.	STATE	FED. AID PROJ. NO.	FISCAL YEAR	SHEET NO.	TOTAL SHEETS
HAWAII	HAW.	EHS-T-9001(12)	1972	2	7

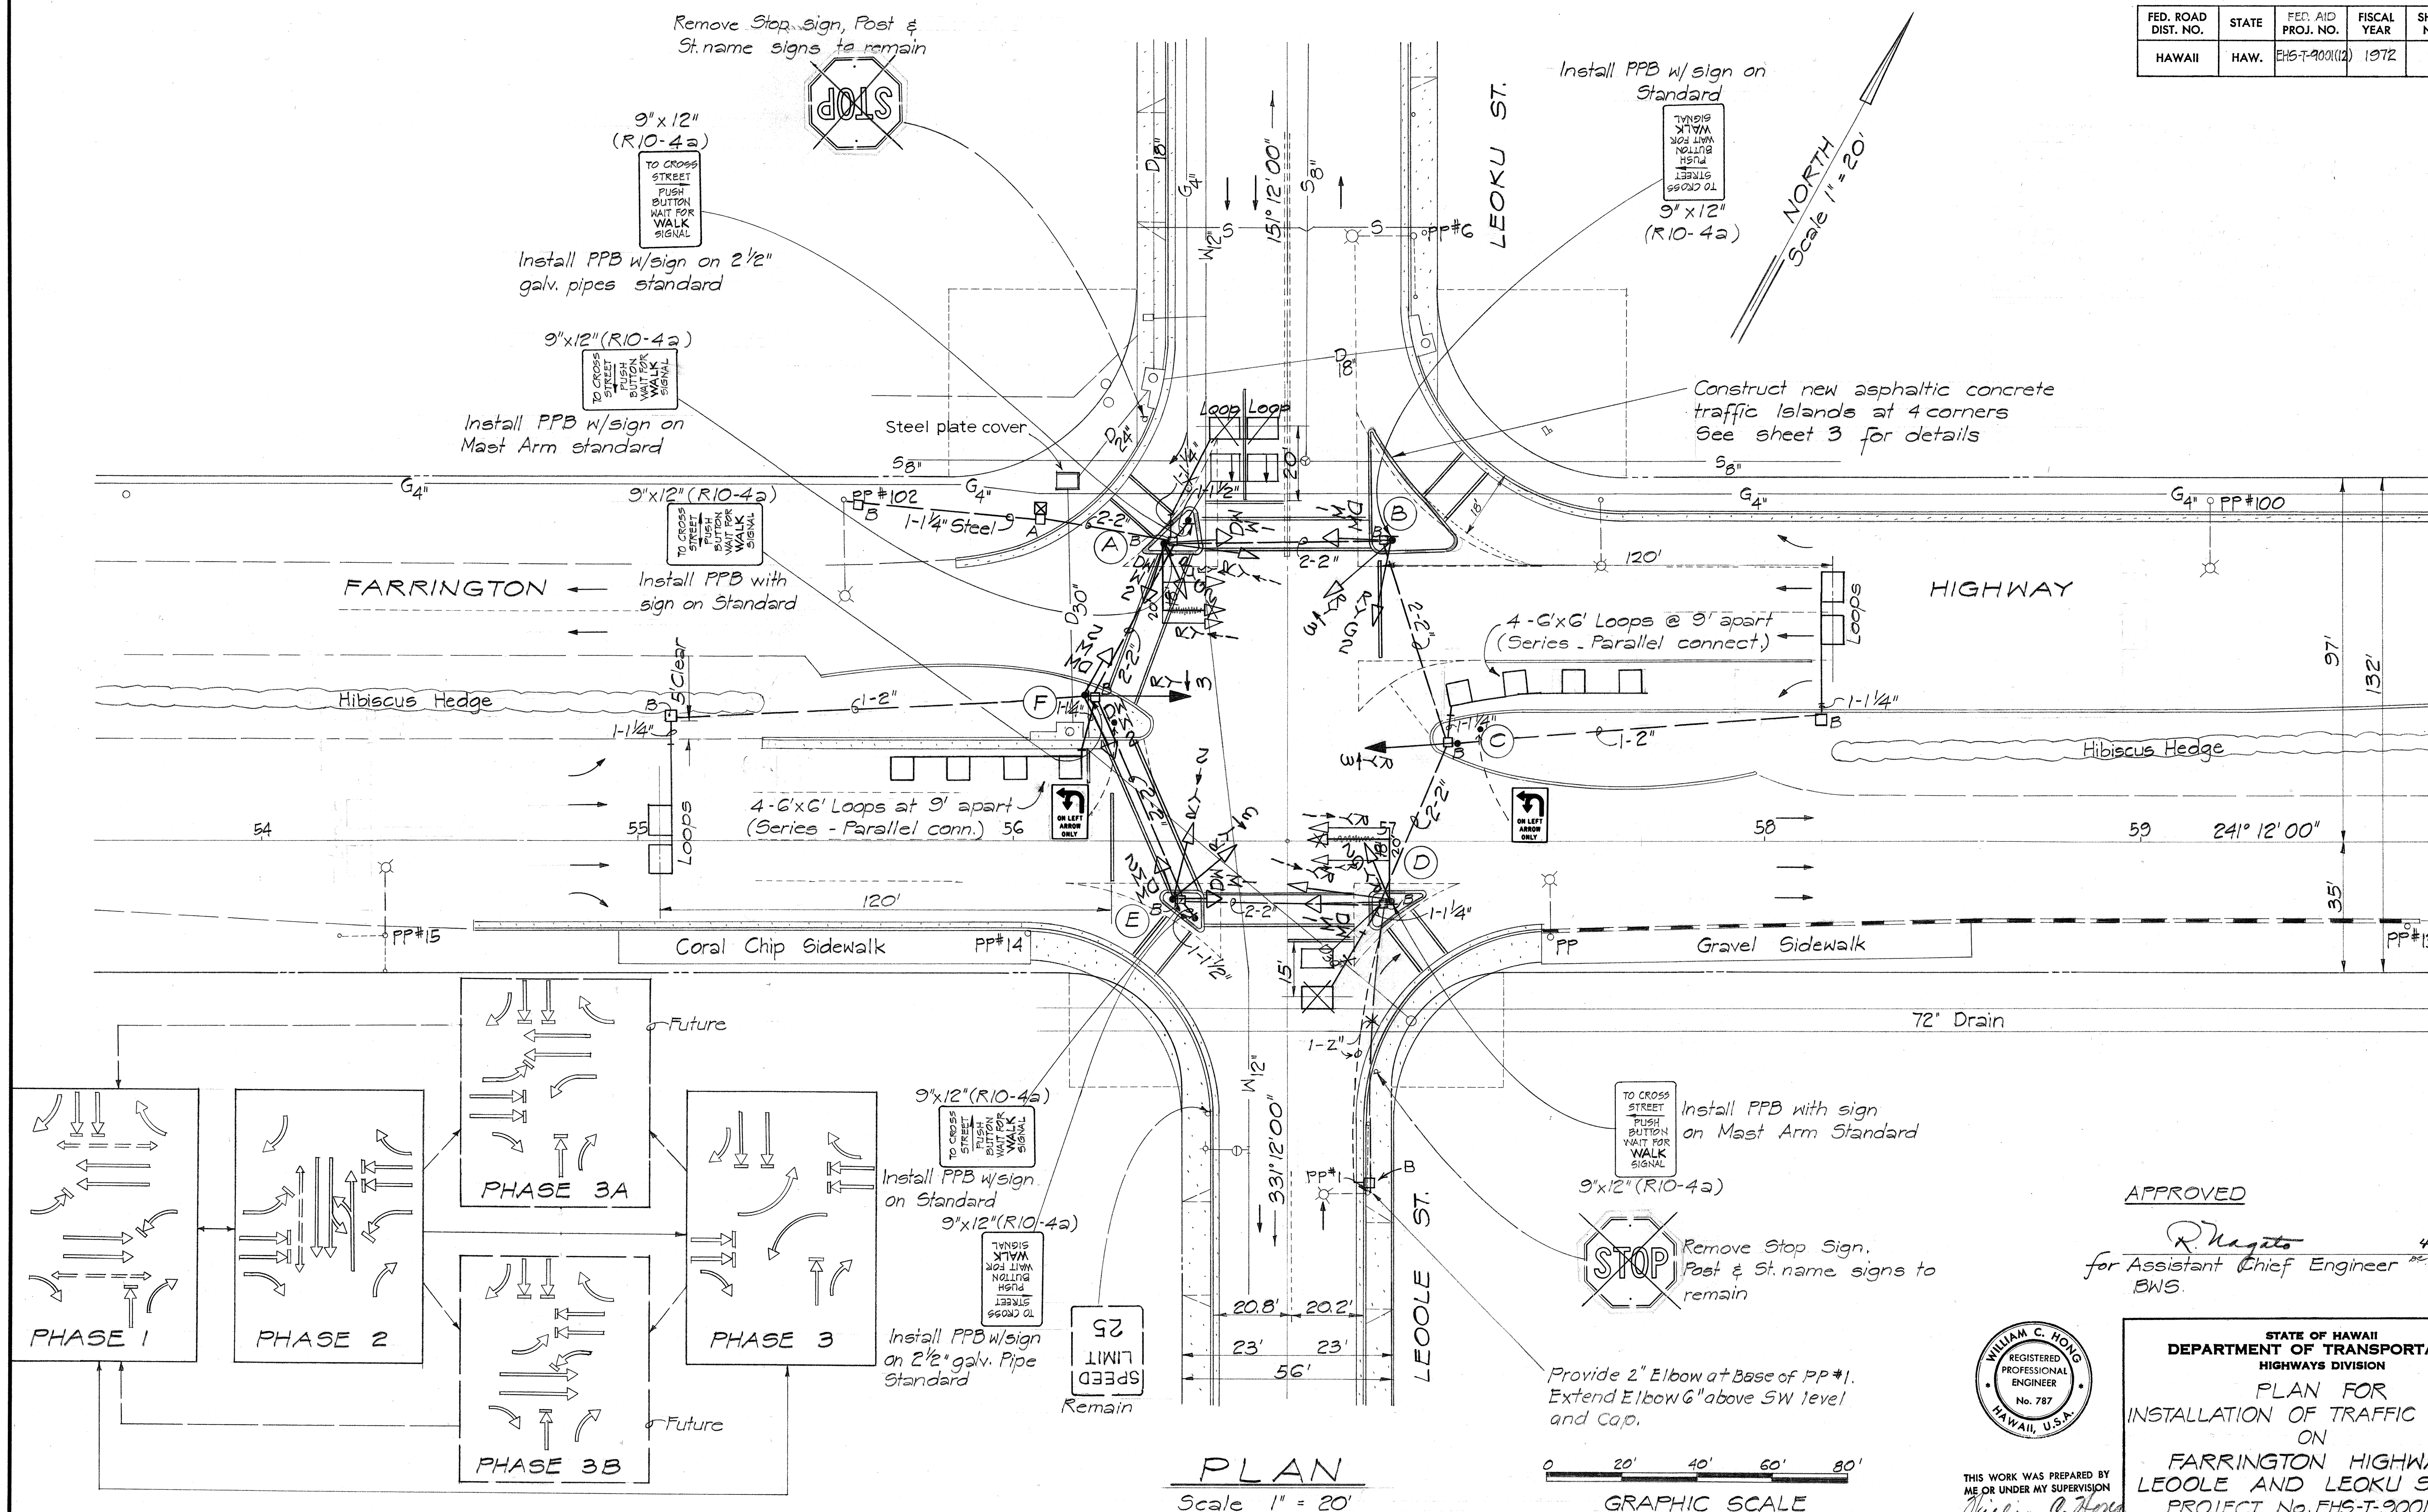


DATE	_____
SURVEY PLOTTED BY	_____
DRAWN BY	_____
CHECKED BY	_____
NOTE BOOK	_____
CHECKED BY	_____
No.	_____

PHASE DIAGRAMS

APPROVED

R. Magata 4-19-72
for Assistant Chief Engineer Date
BWS.

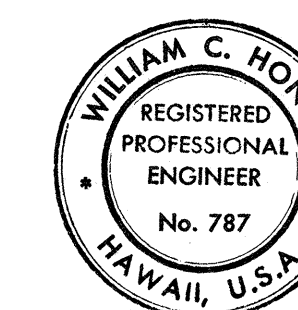

THIS WORK WAS PREPARED BY
ME OR UNDER MY SUPERVISION
William C. Hong

STATE OF HAWAII
DEPARTMENT OF TRANSPORTATION
HIGHWAYS DIVISION
PLAN FOR
INSTALLATION OF TRAFFIC SIGNALS
ON
FARRINGTON HIGHWAY AT
LEOLO AND LEOKU STREETS
PROJECT No. EHS-T-9001 (12)
Scale: As shown Date: June 9, 72
SHEET No. 1 OF 1 SHEETS