	1		
11	NDEX TO	DRAWINGS	
SHEET NO.		DESCRIPTION	
l	TITLE SH	EET · V 1 · 10	
2	PLAN		
3 - 4		EOUS DETAILS	
5-7	STANDARD	DETAILS	
		* ,	
	1		
, , , , , , , , , , , , , , , , , , ,			
	-V		
		encommendation of the contraction of the contractio	
	STANDARD .		
	or or on the state of the state	LEGEND	
	V 15 M AMMERICA I - A THE STREET AND AMMERICAN CONTINUES AND AMMERICAN	RIGHT OF WAY LINE	
		CENTER LINE	
		BASE LINE	
		EXISTING EDGE OF PAV	EMENT
	<u>,</u>	EXISTING CONCRETE CU	IRB AND GUTTER
		EXISTING BITUMINOUS	(A/C) CURB
		NEW BITUMINOUS (A/C	CURB, TYPE 6
Z		EXISTING TRAFFIC MAP	RKINGS
—(	8	EXISTING SEWER LINE	(8") AND MANHOLE
·	W <sub>12"</sub> ⊕	EXISTING WATER LINE	(12") AND MANHOLE
—[	30"	EXISTING DRAIN LINE	(30") AND MANHOLE
· .	— G <sub>4"</sub>	EXISTING GAS LINE (4	")
9-1-72 DATE	d	EXISTING TRAFFIC SIGN	AND POST
	LOOP	NEW VEHICLE DETECTO	R (LOOP INDICATED)
7532 E	<del></del> 1-2 <del>"</del>	NEW TRAFFIC SIGNAL I	PULL-BOX (TYPE "B")

 $\sqrt{\mathbb{Q} \times \mathbb{Z}}$ 

AUXILIARY EQUIPMENT ON CONCRETE BASE

VEHICULAR SIGNAL HEADS (R-Y-G)

ON 2 1/2" GALV. PIPE STANDARD

NEW TRAFFIC MARKINGS

ARM (ARM SPREAD INDICATED) AND STANDARD

INSTRUCTION SIGN (PPB) ARROW AS INDICATED

EXISTING POWER POLE (#23) WITH STREET LIGHT





## DEPARTMENT TRANSPORTATION OF HIGHWAYS DIVISION

HONOLULU, HAWAII


"AS BUILT" PLANS FOR


## THE INSTALLATION OF TRAFFIC SIGNALS

ON

## FARRINGTON HIGHWAY LEOOLE AND LEOKU STREETS

FEDERAL - AID TOPICS PROJECT NO. EHS -T- 9001(12) DISTRICT OF EWA ISLAND OF OAHU

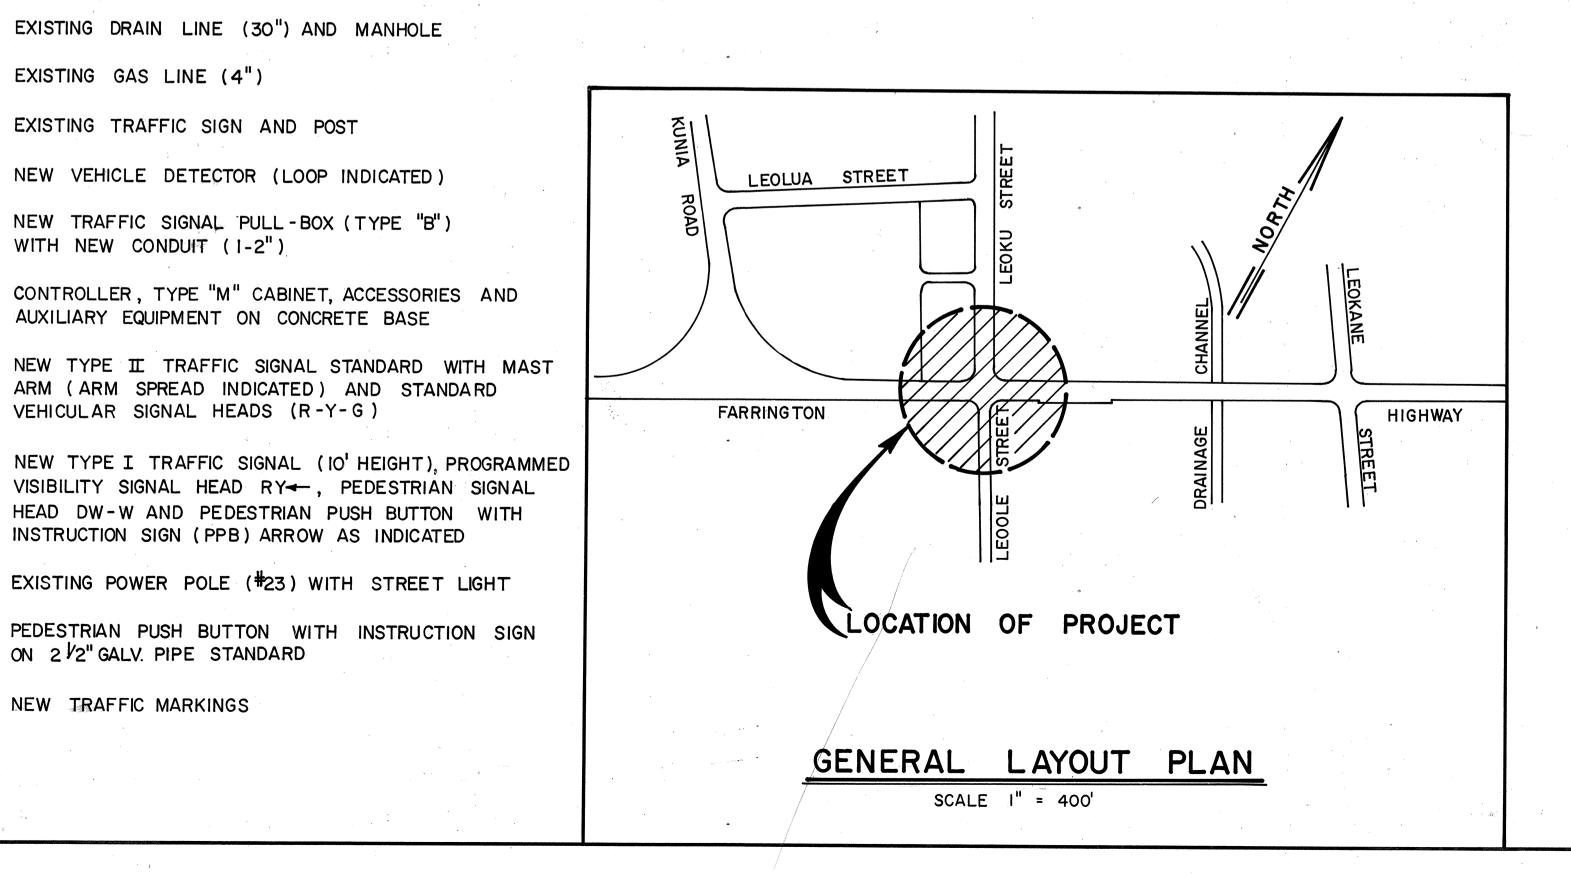

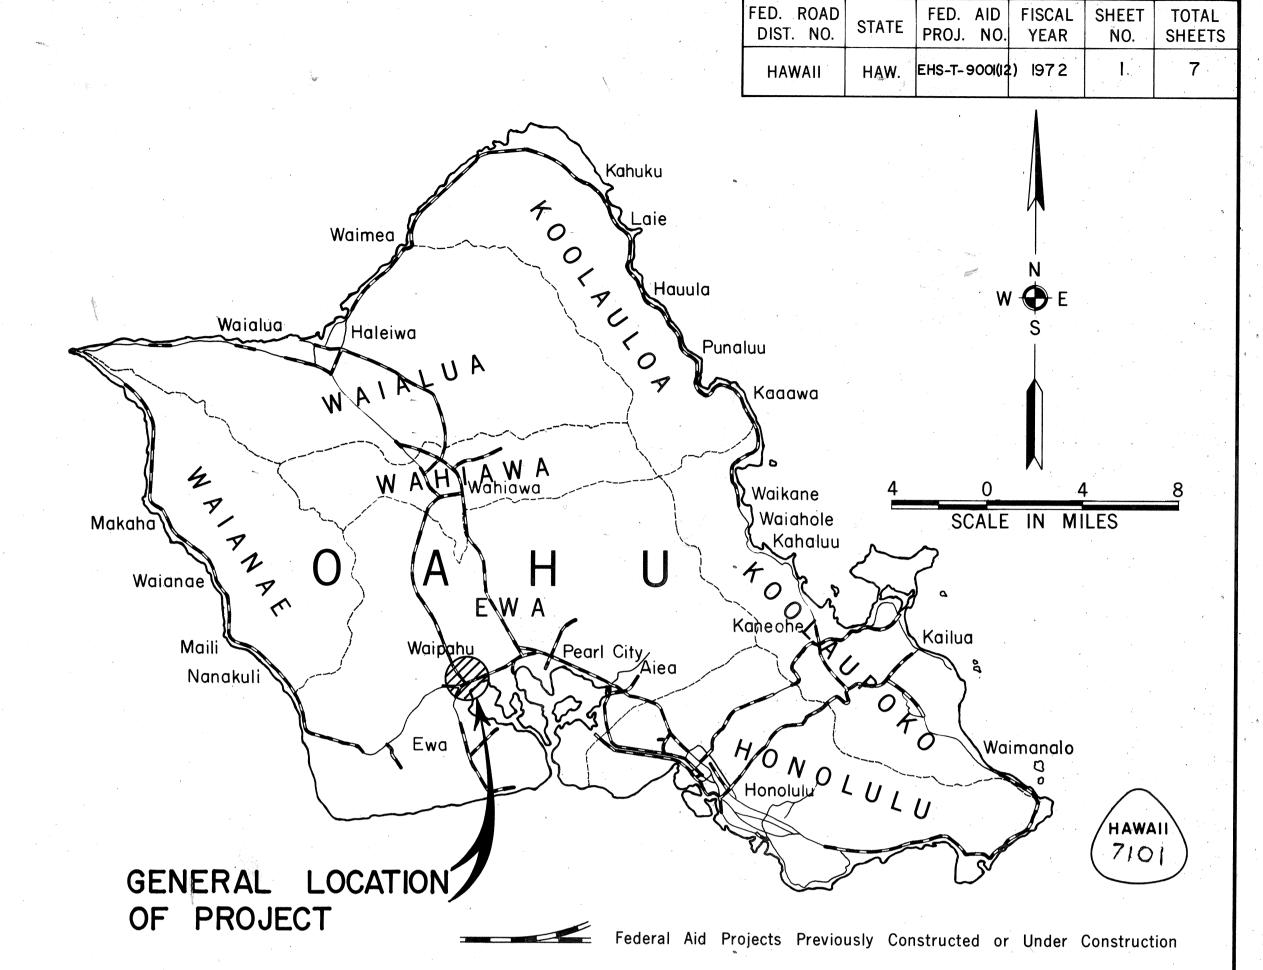



NOTE:

ALL CHANGES MADE DURING CONSTRUCTION HAVE BEEN NOTED IN RED ON THESE TRACINGS AND CHECKED BY

THIS WORK WAS PREPARED BY

DEPARTMENT OF TRANSPORTATION FEDERAL HIGHWAY ADMINISTRATION APPROVED. Karph Wegawa 12/20/72

DEPARTMENT OF TRANSPORTATION STATE OF HAWAII DIR. OF TRANSPORTATION

DIVISION ENGINEER