




FED. ROAD DIST. NO.	STATE	FED. AID PROJ. NO.	FISCAL YEAR	SHEET NO.	TOTAL SHEETS
HAWAII	HAW.	I-HI-1(102)8	1973	22	38

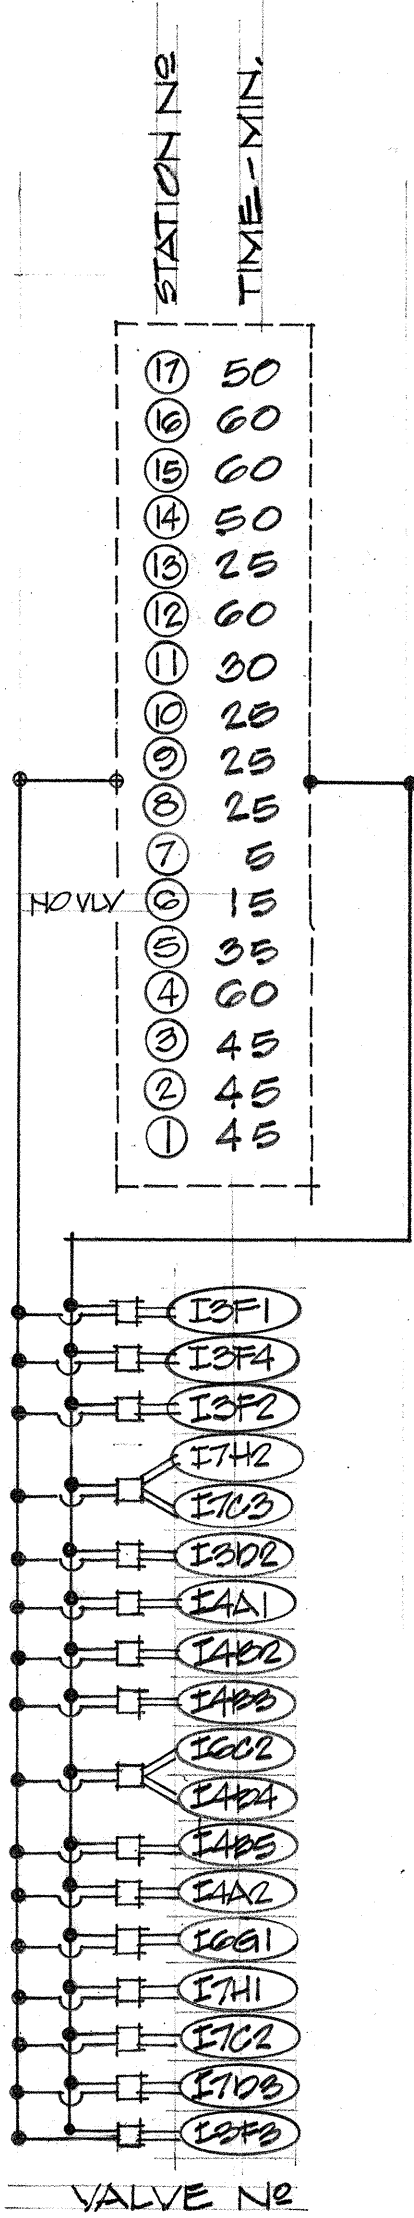


CONTROLLER A

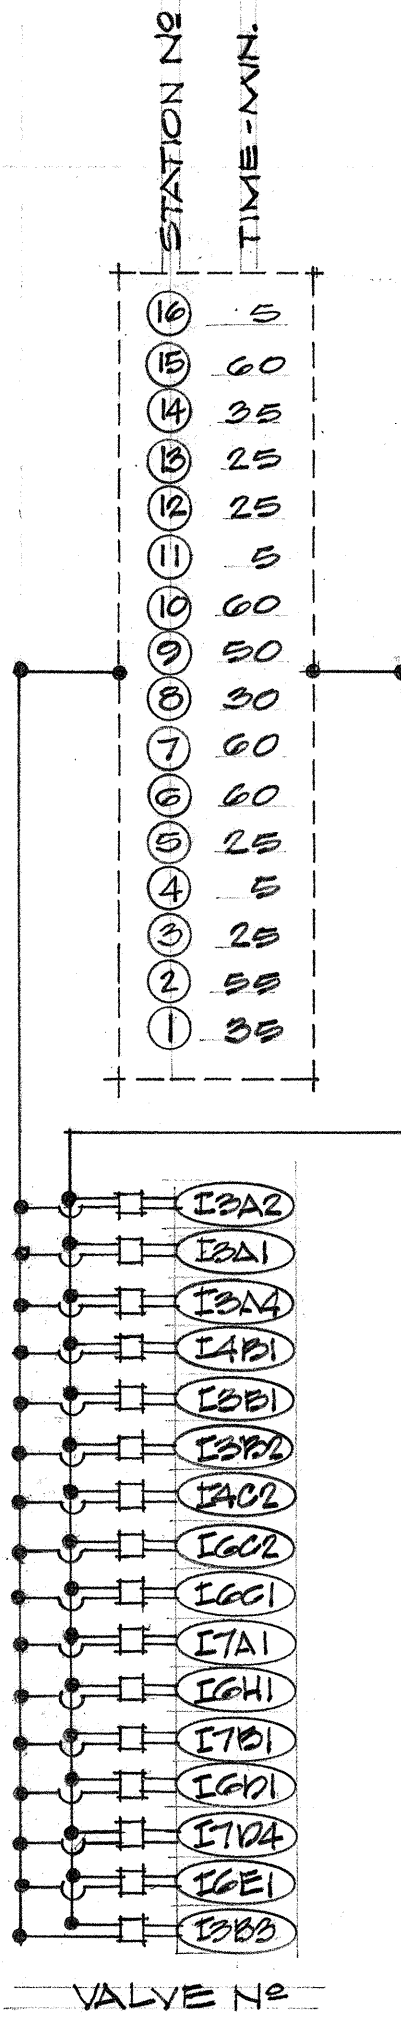


CONTROLLER B

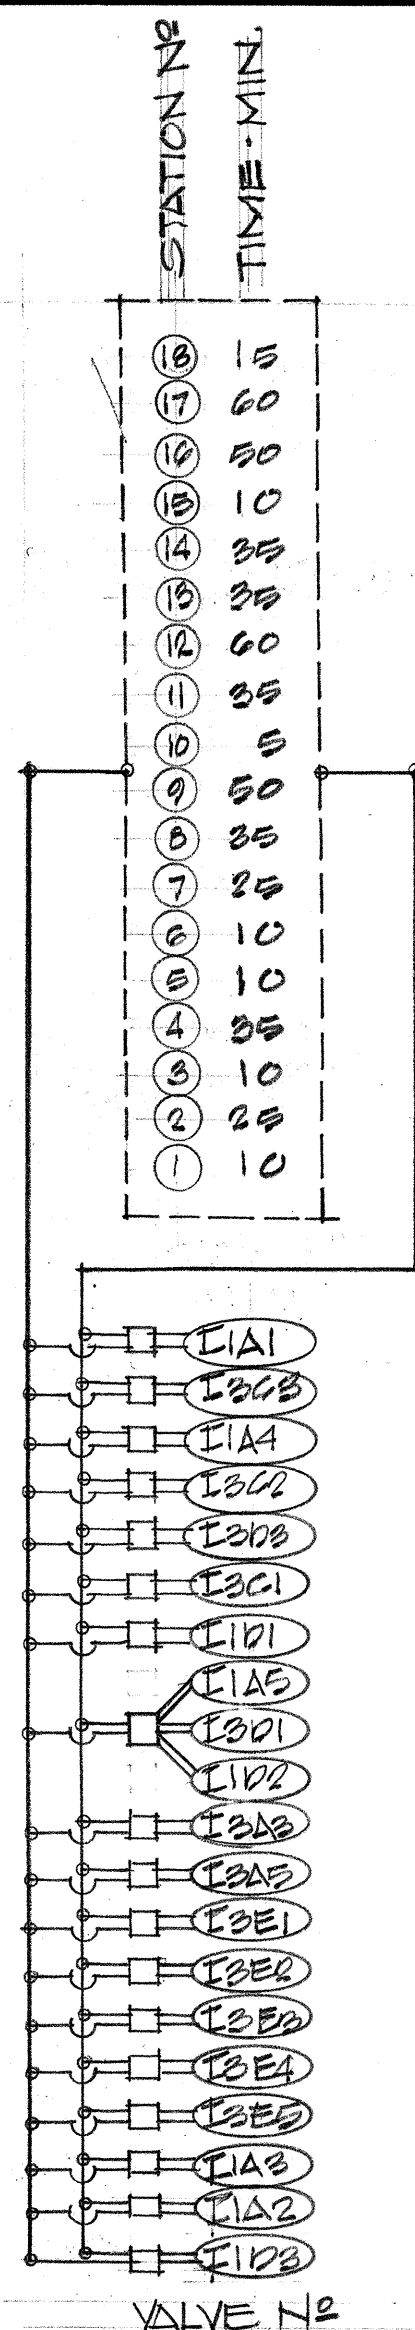


CONTROLLER C

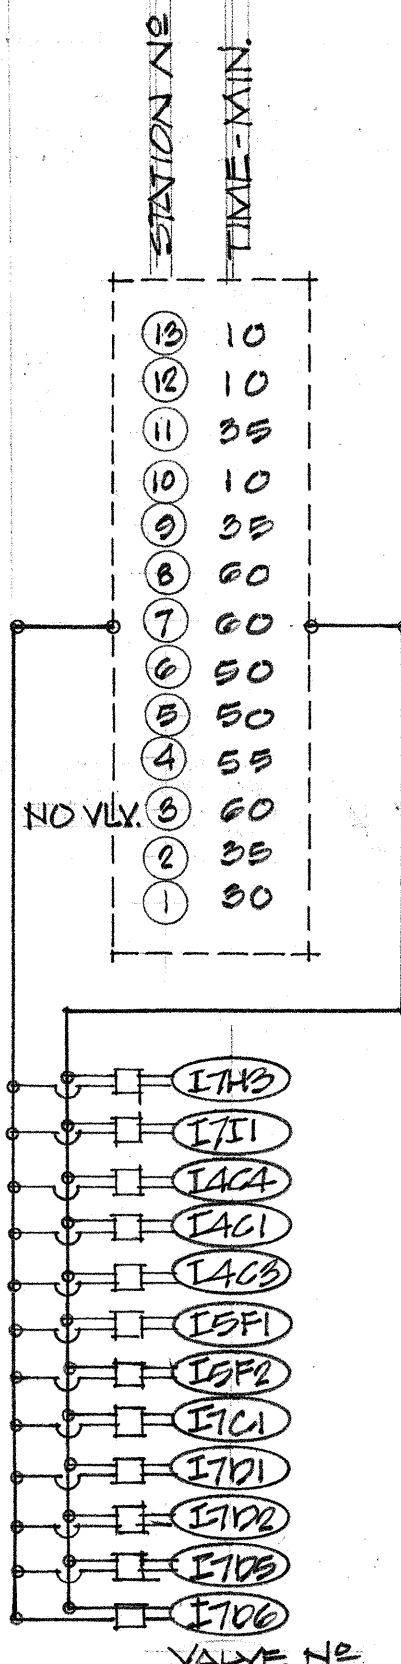


CONTROLLER D

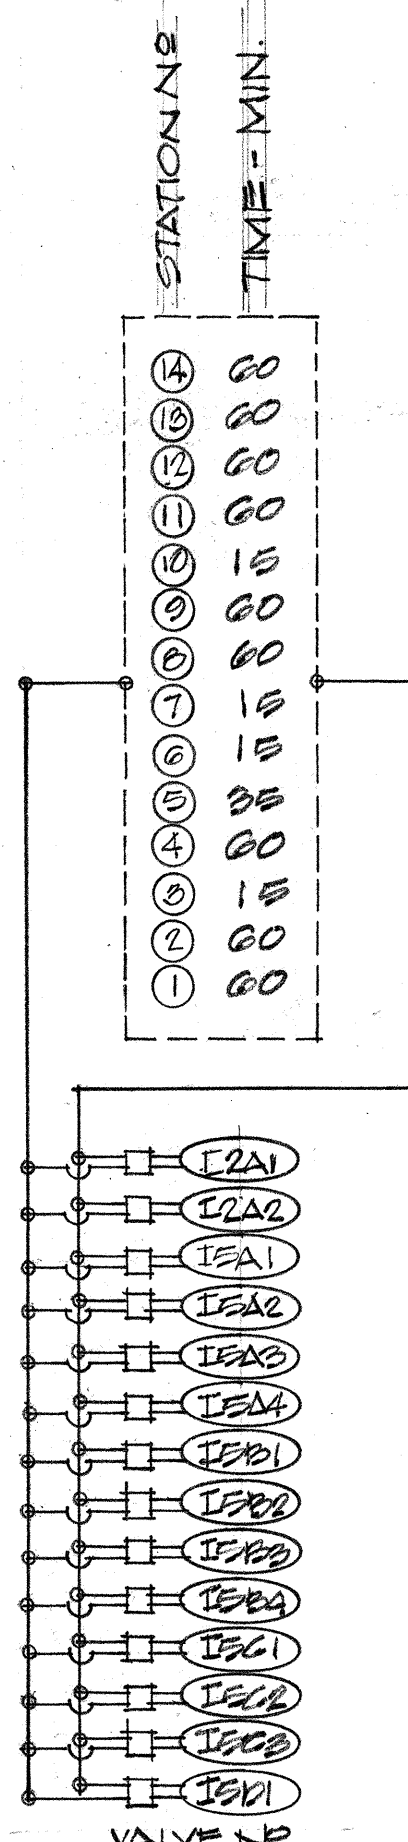


CONTROLLER E

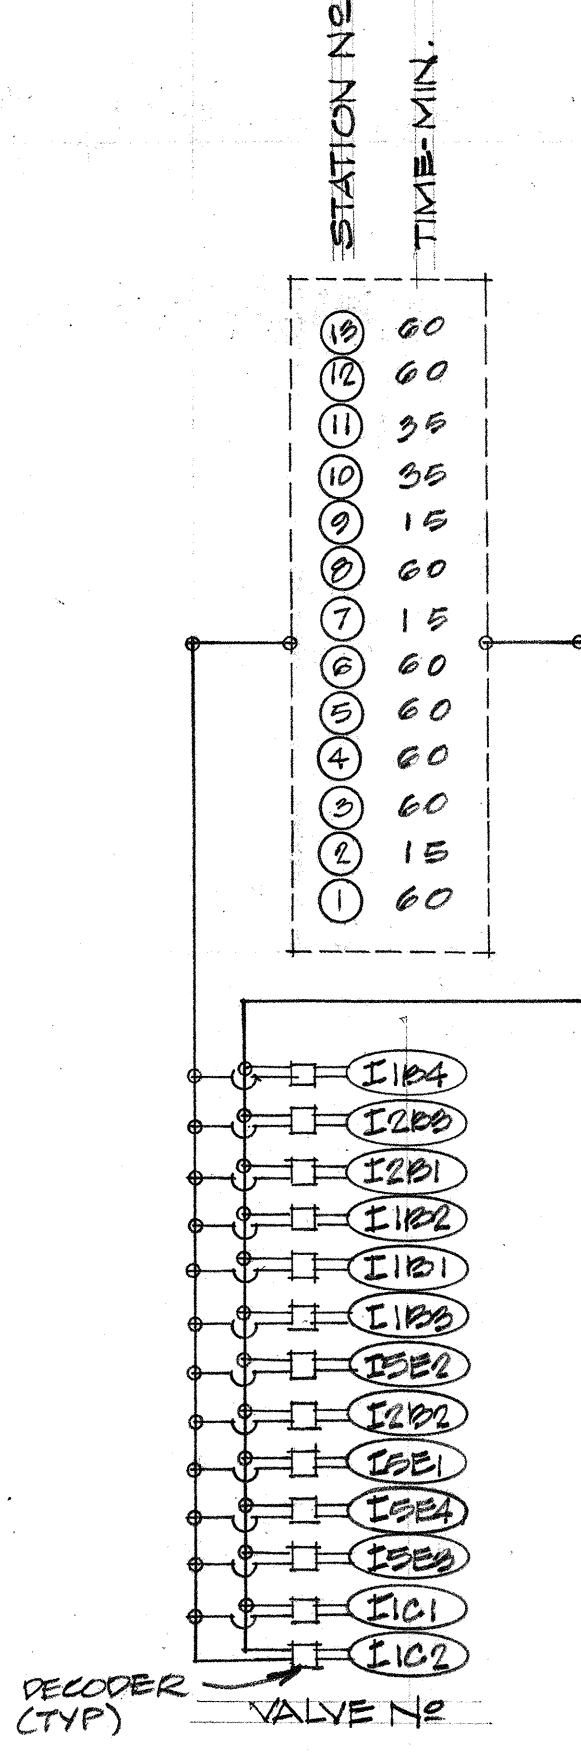

CONTROLLER F

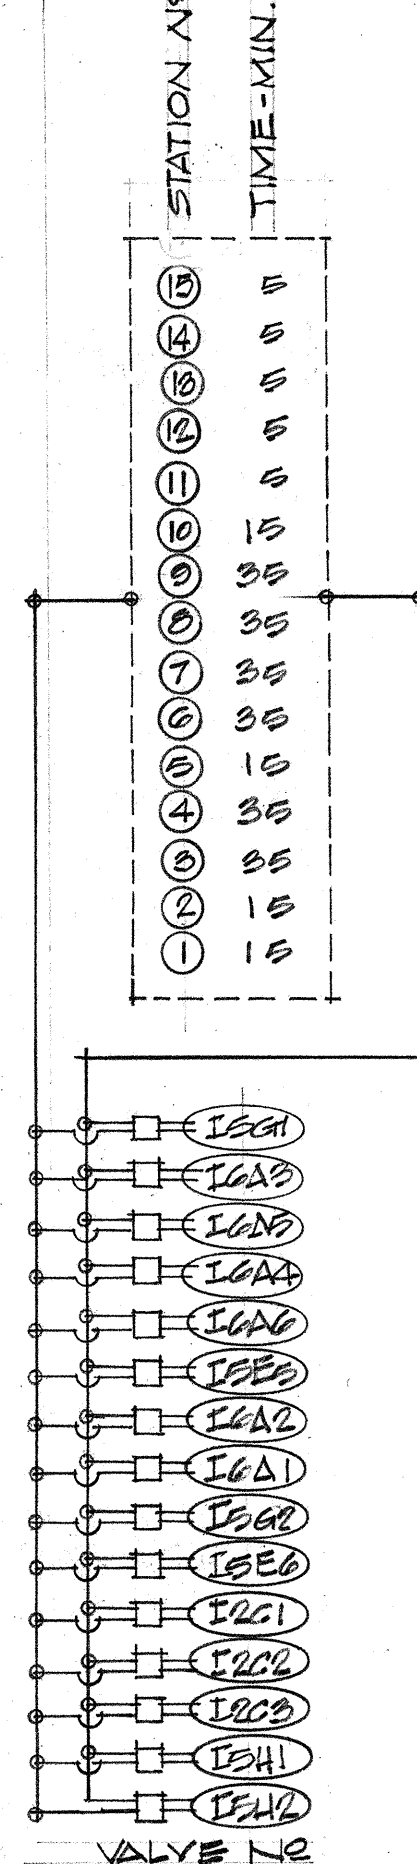

CONTROLLER G

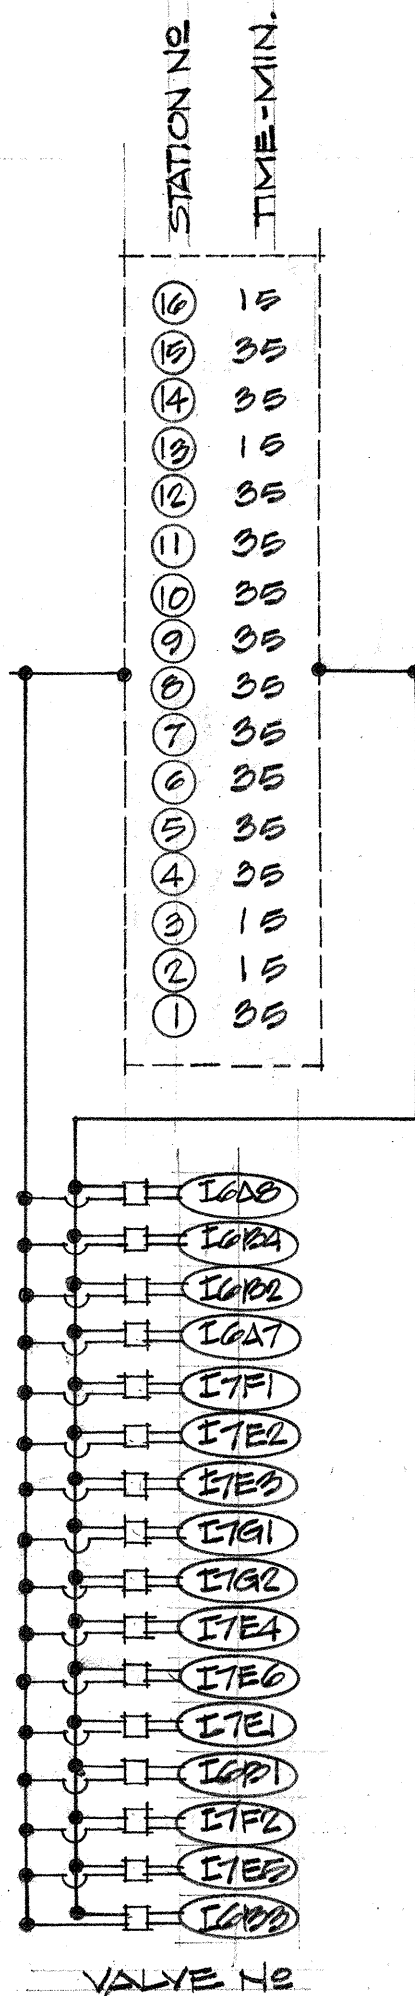

CONTROLLER H

HIGH PRESSURE SYSTEM

LOW PRESSURE SYSTEM

CONTROLLER DIAGRAMS

FOR TYPE "B" AND TYPE "C" CONTROLLERS

DELETE THIS SHEET SEE SHEET NO. 20 S-1 THRU 20 S-5 AND 21 S-1 THRU 21 S-3

DATE	
DESIGNED BY	
TRACED BY	
QUANTITIES BY	
CHECKED BY	
ORIGINAL PLAN	
NOTE BOOK	
No.	

PHILIP K. H. YEE & ASSOCIATES
CONSULTING ENGINEERS
243 Liliuokalani Ave., Rm. 101
Honolulu, Hawaii 96813

CURTIS Q. H. YEE
REGISTERED PROFESSIONAL ENGINEER
No. 26241-E
HAWAII, U.S.A.

THIS WORK WAS PREPARED BY ME
OR UNDER MY SUPERVISION.

STATE OF HAWAII
DEPARTMENT OF TRANSPORTATION
HIGHWAYS DIVISION

WAIAWA INTERCHANGE
WATER SPRINKLER SYSTEM
PROJ # I-HI-1(102)-8

CONTROLLER DIAGRAMS
TYPE "B" & TYPE "C" CONTROLLERS