
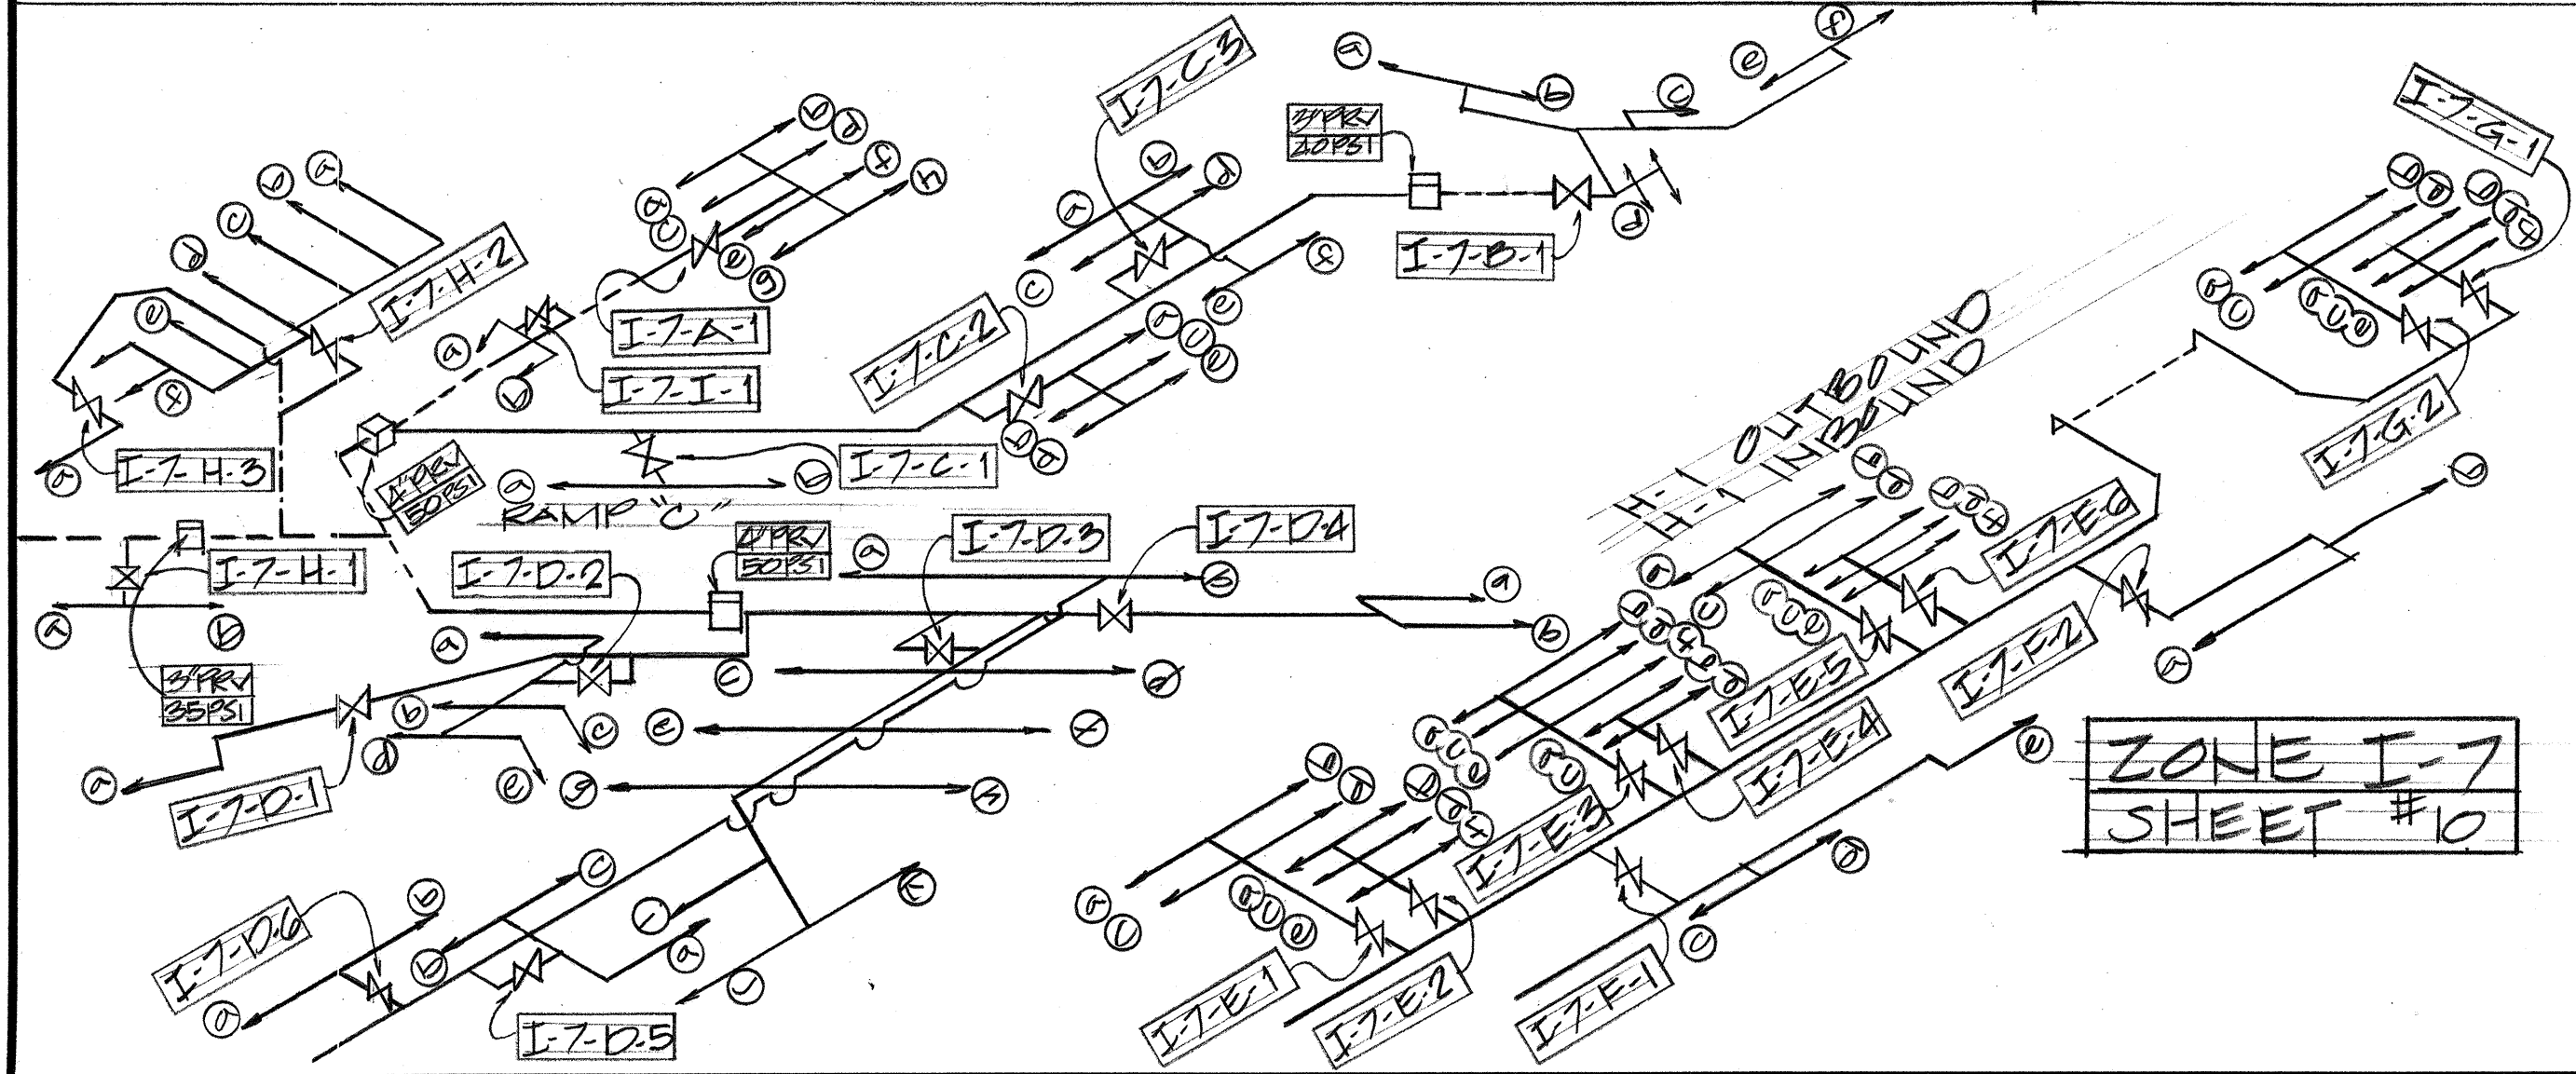
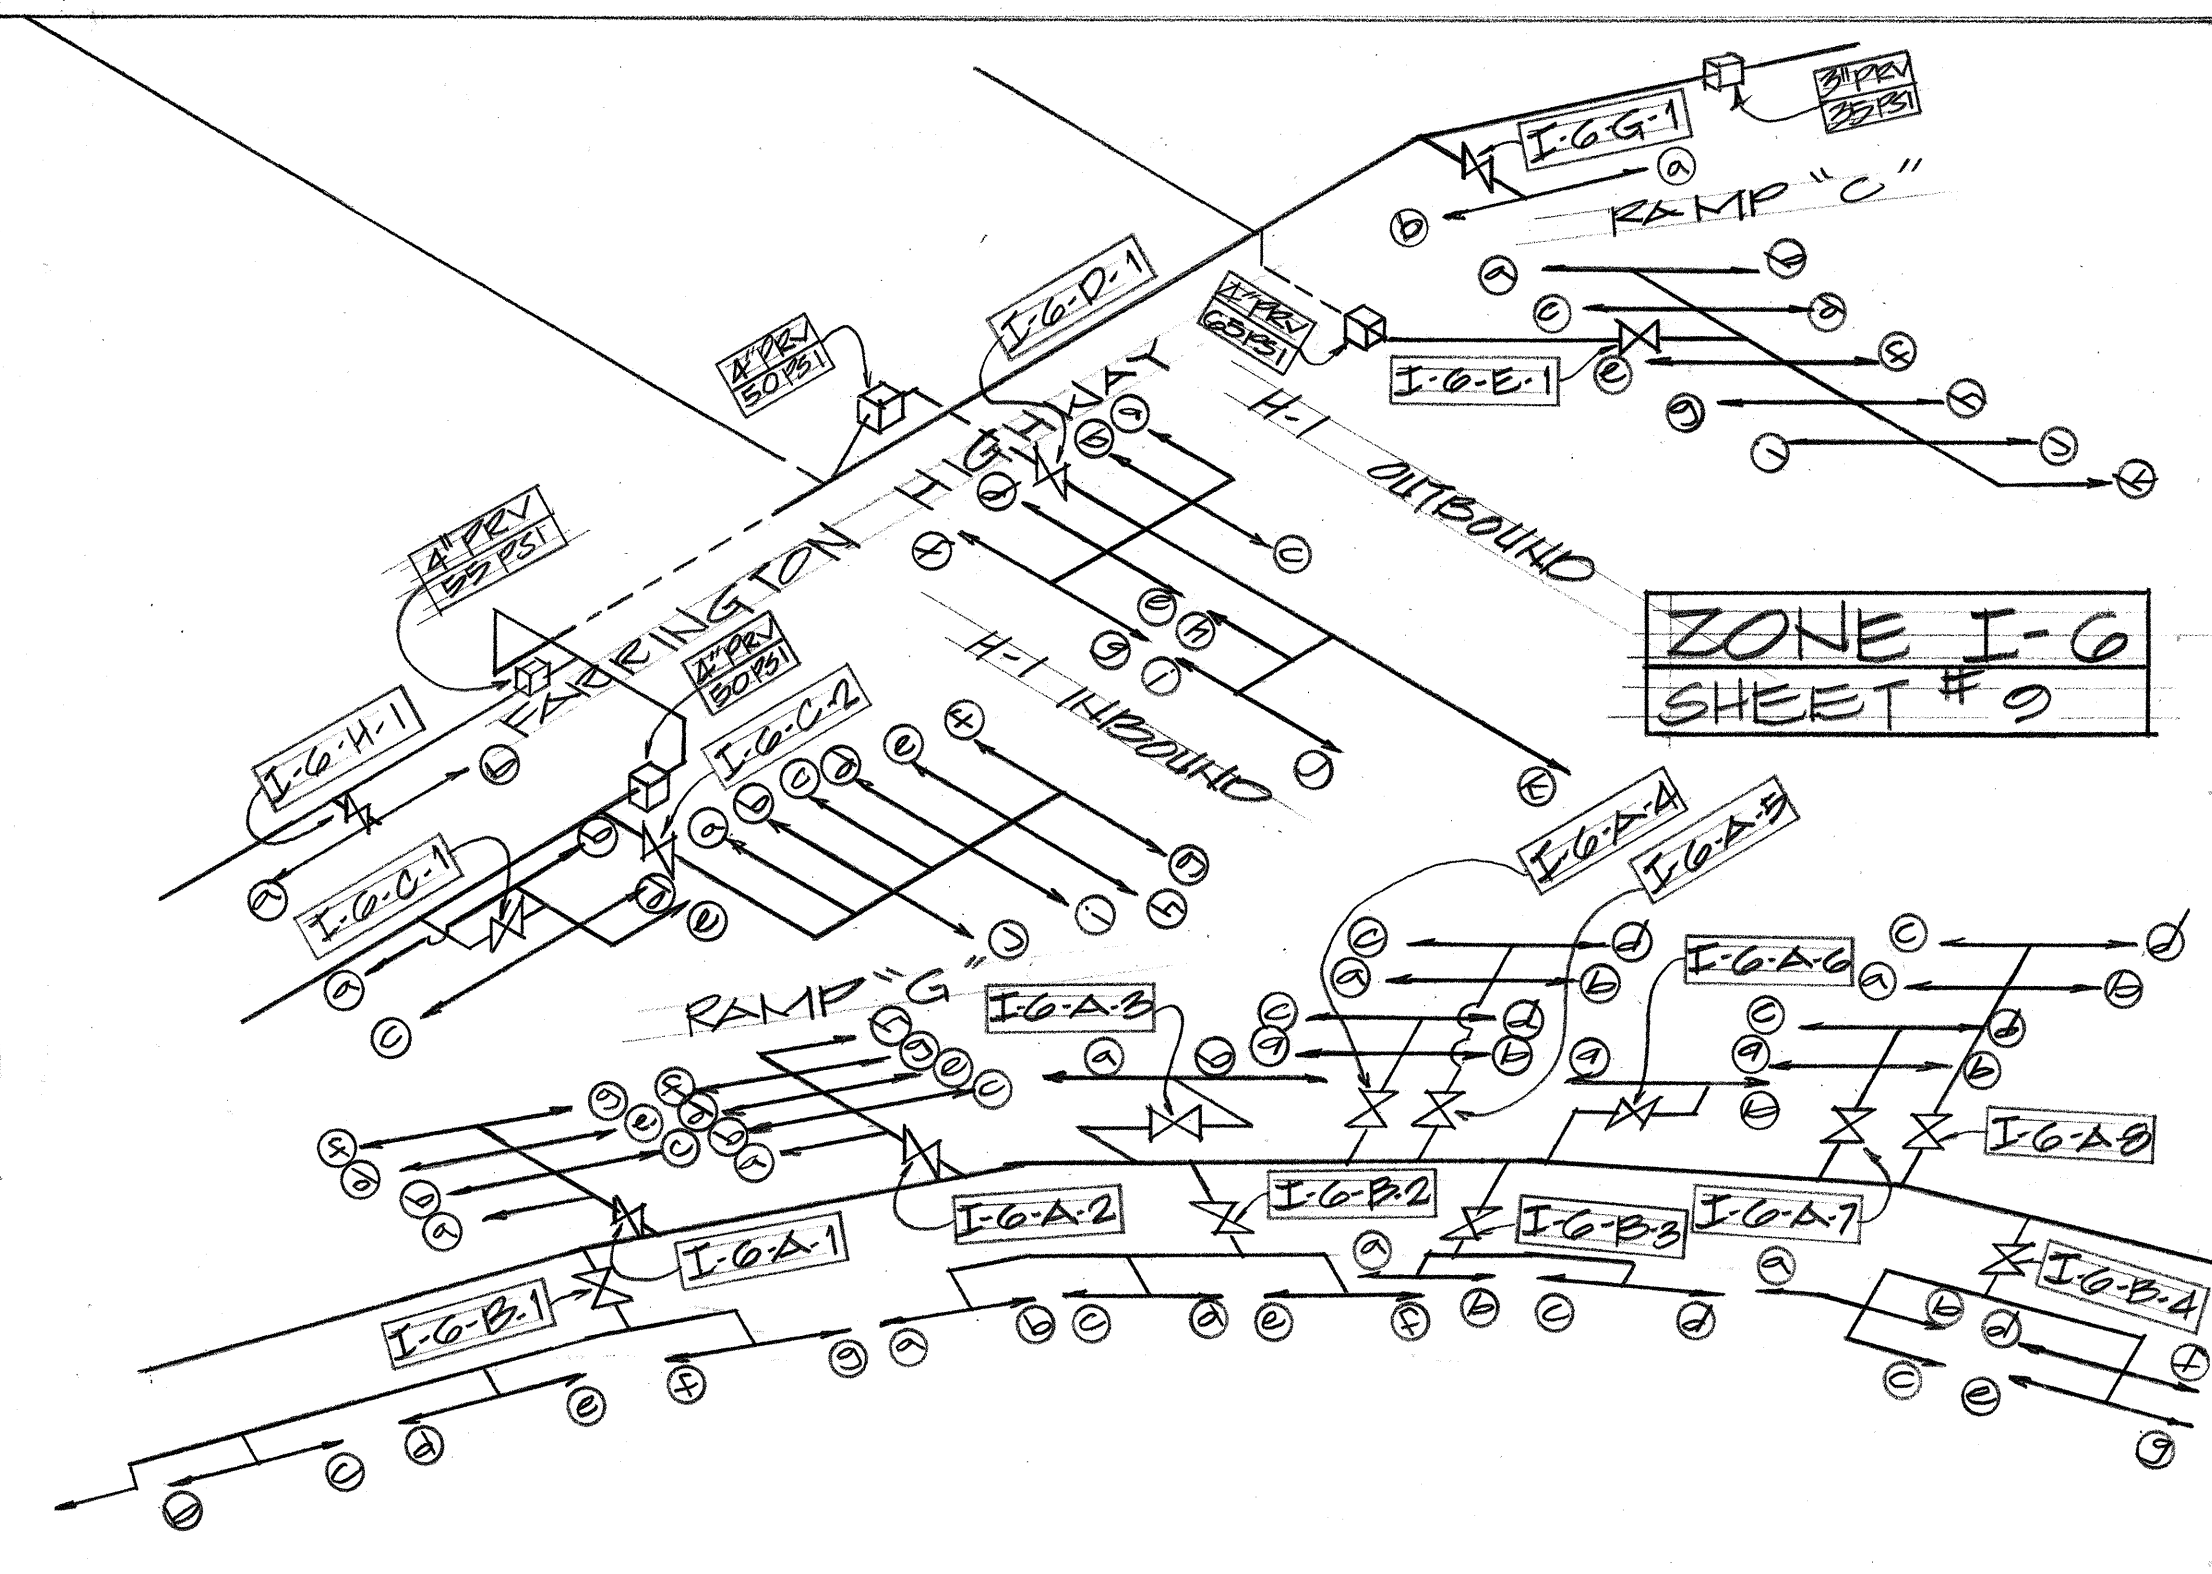
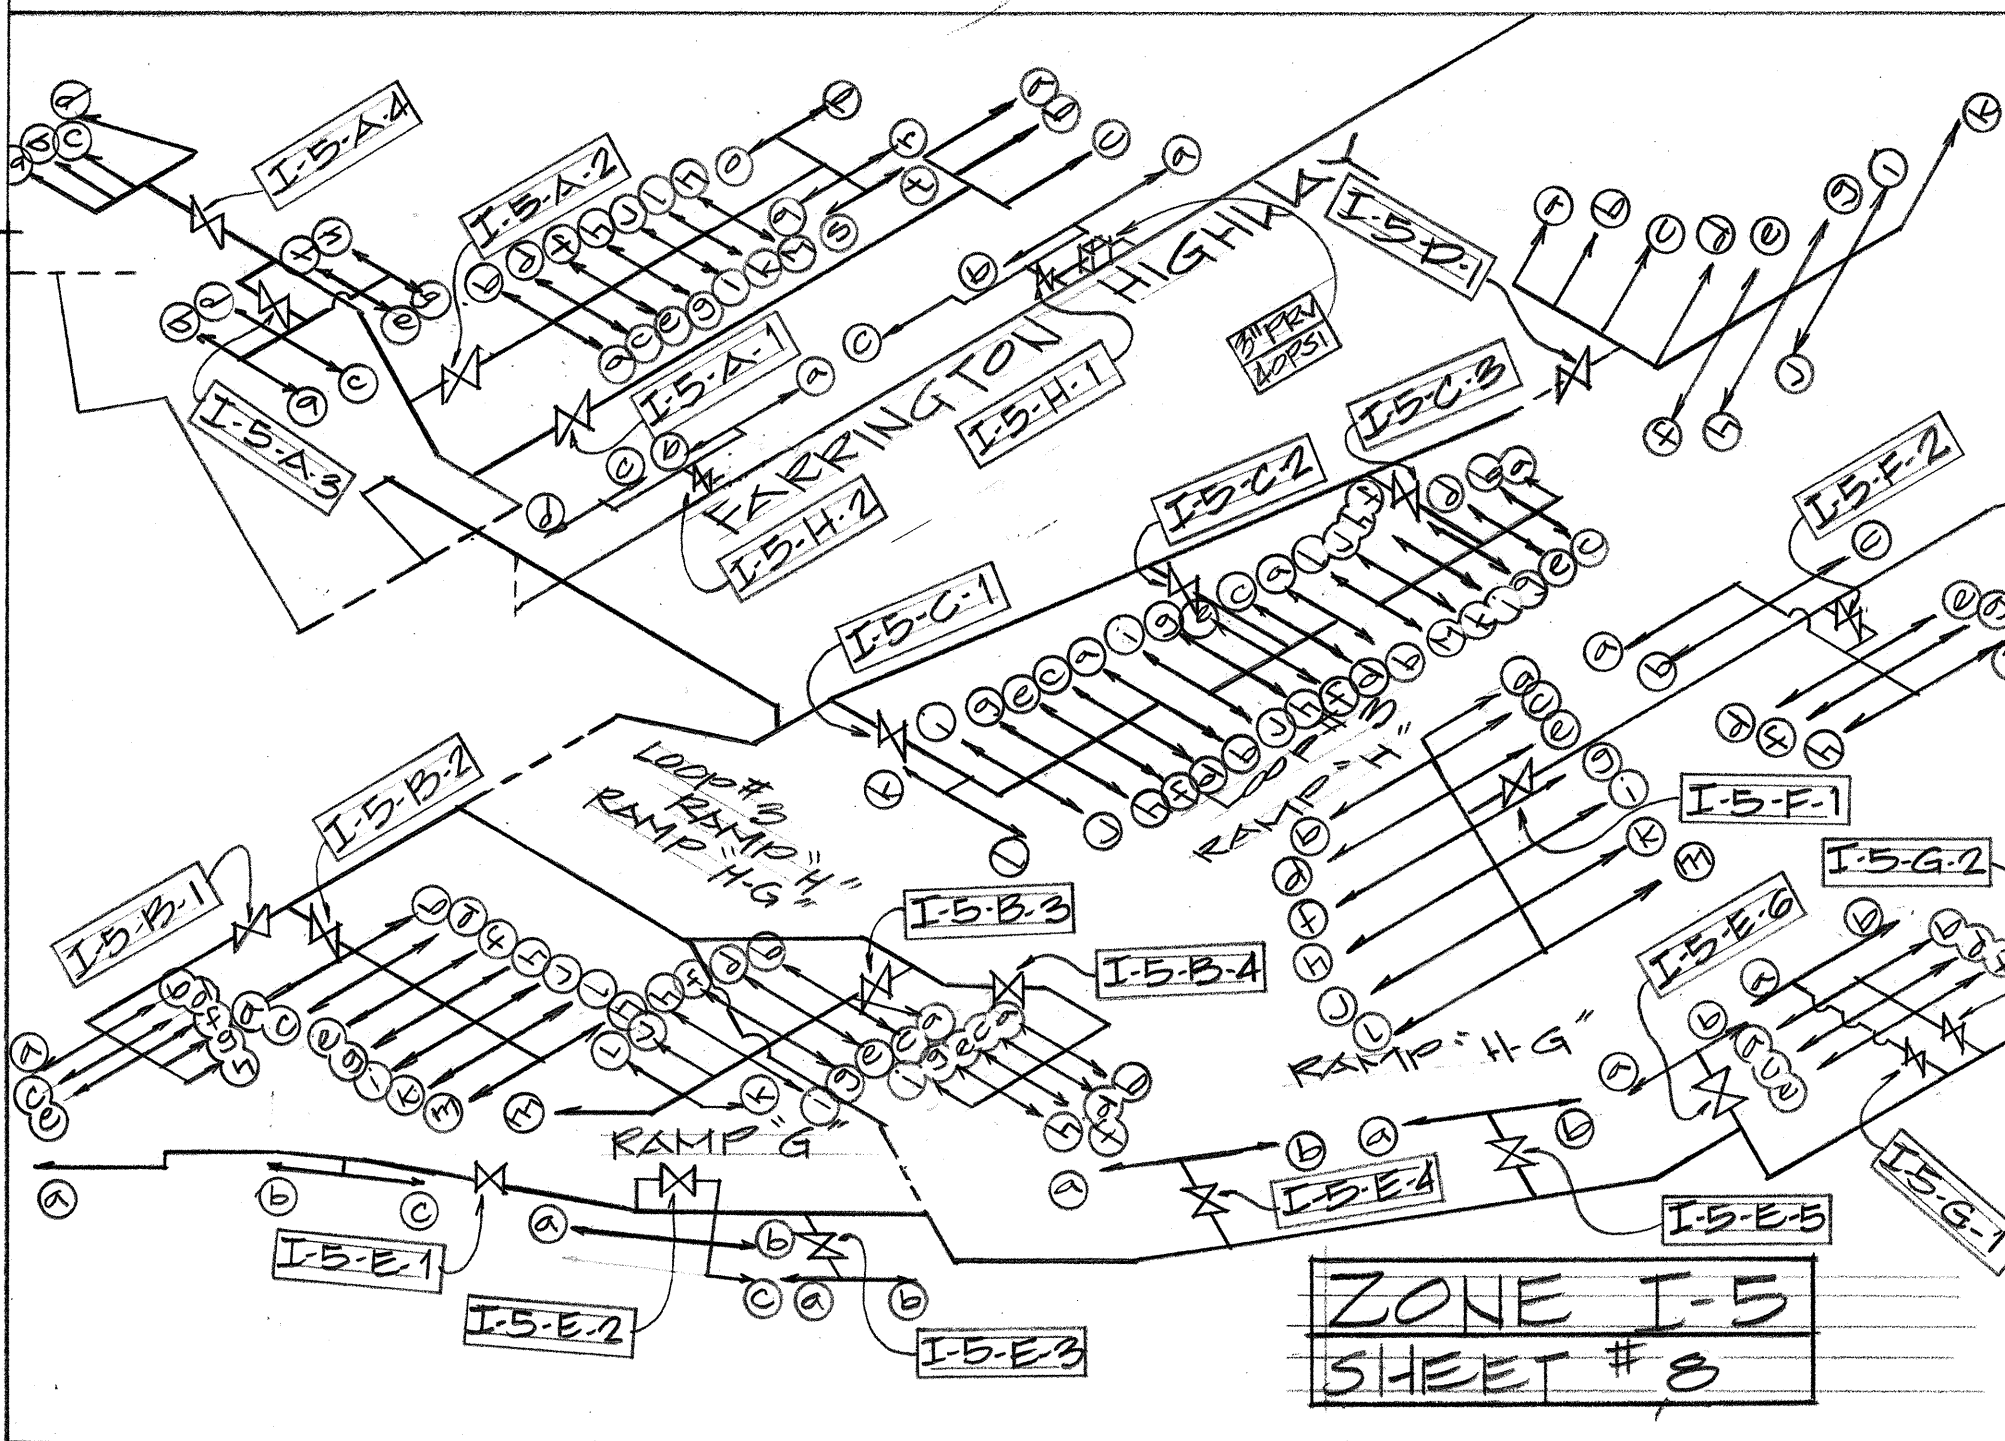
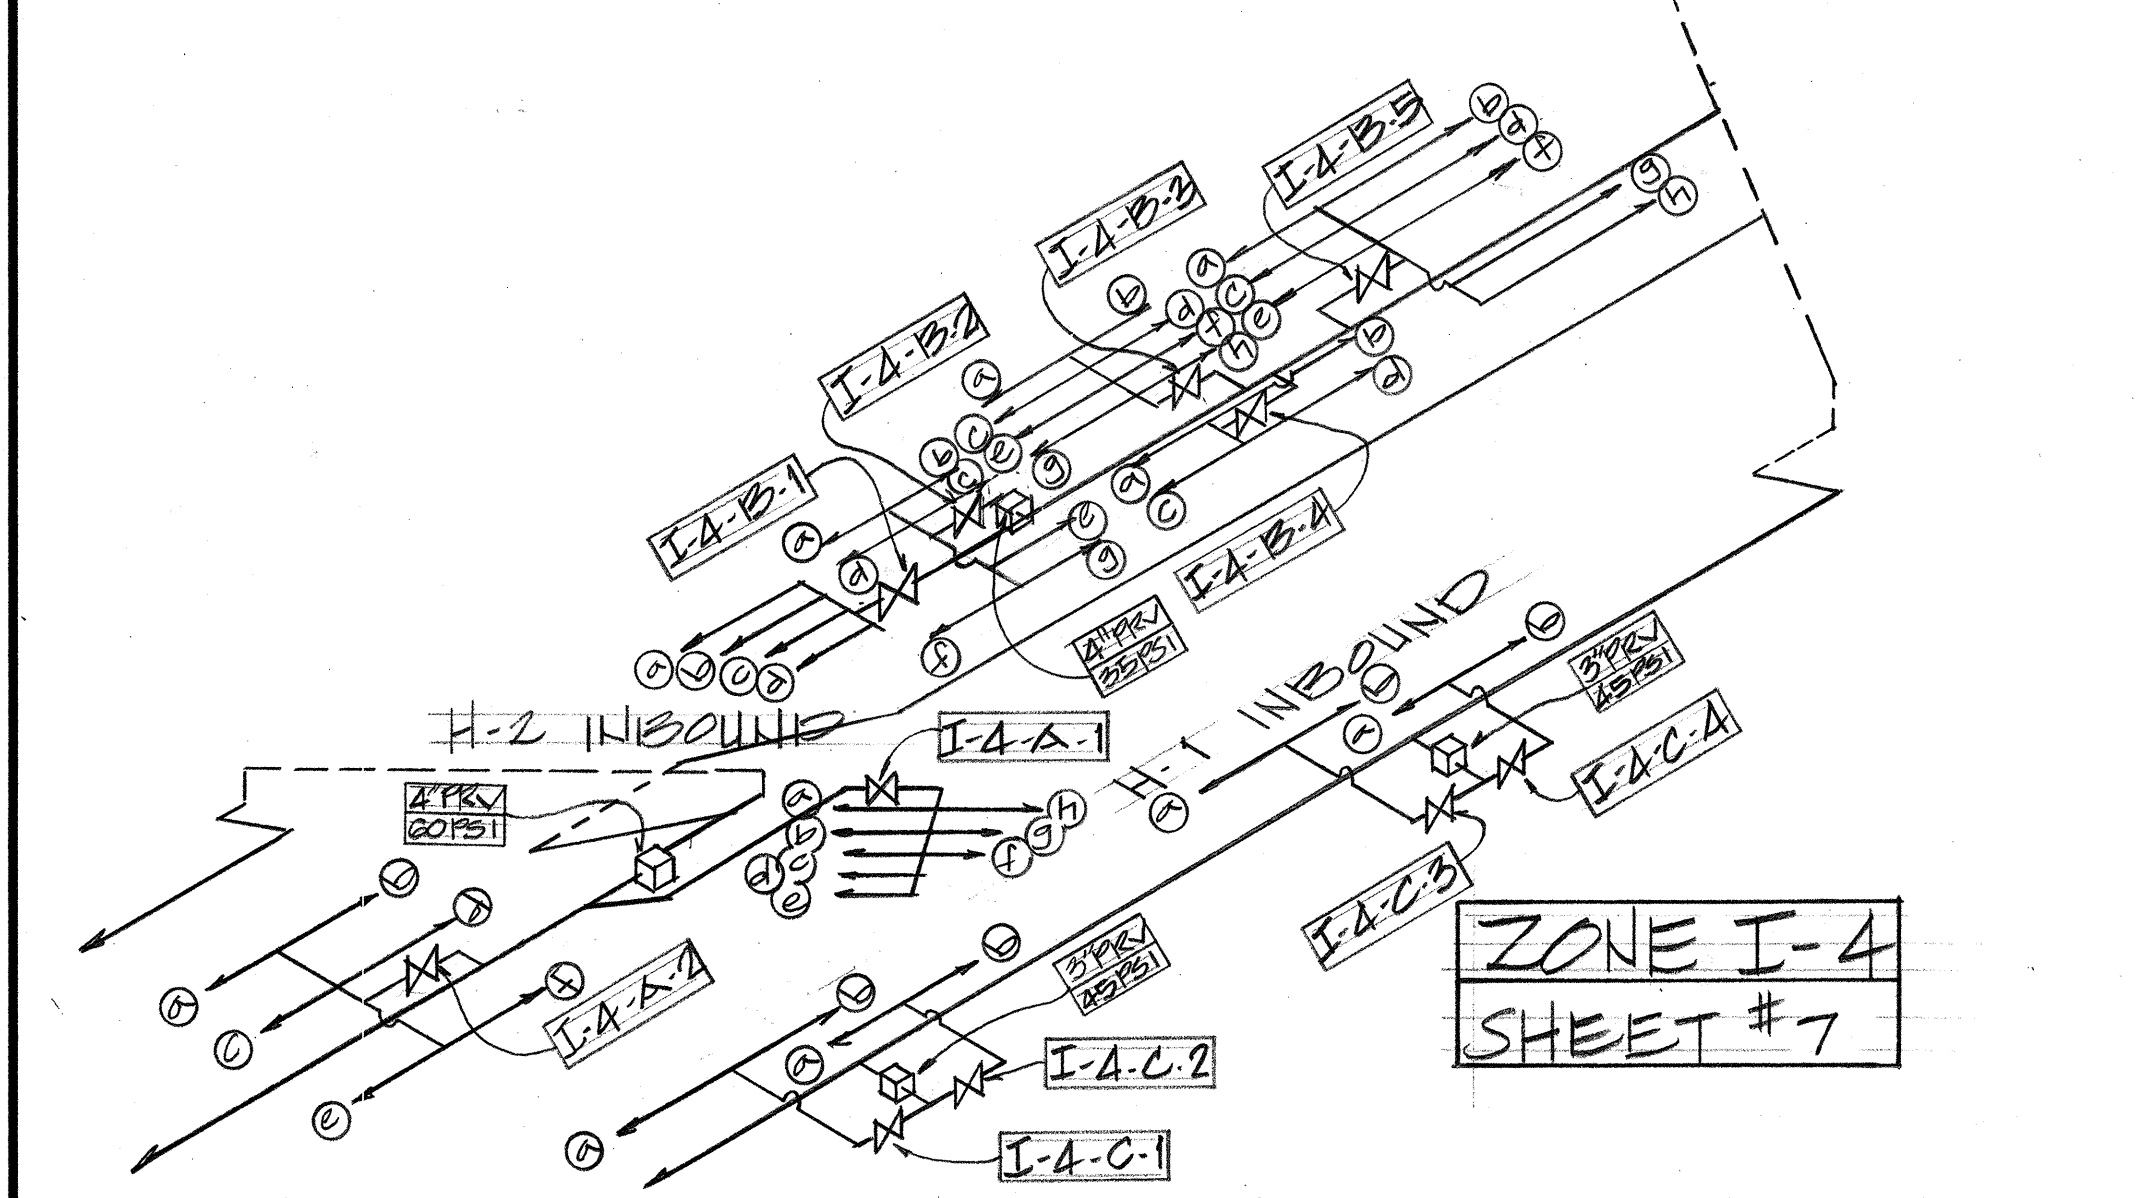
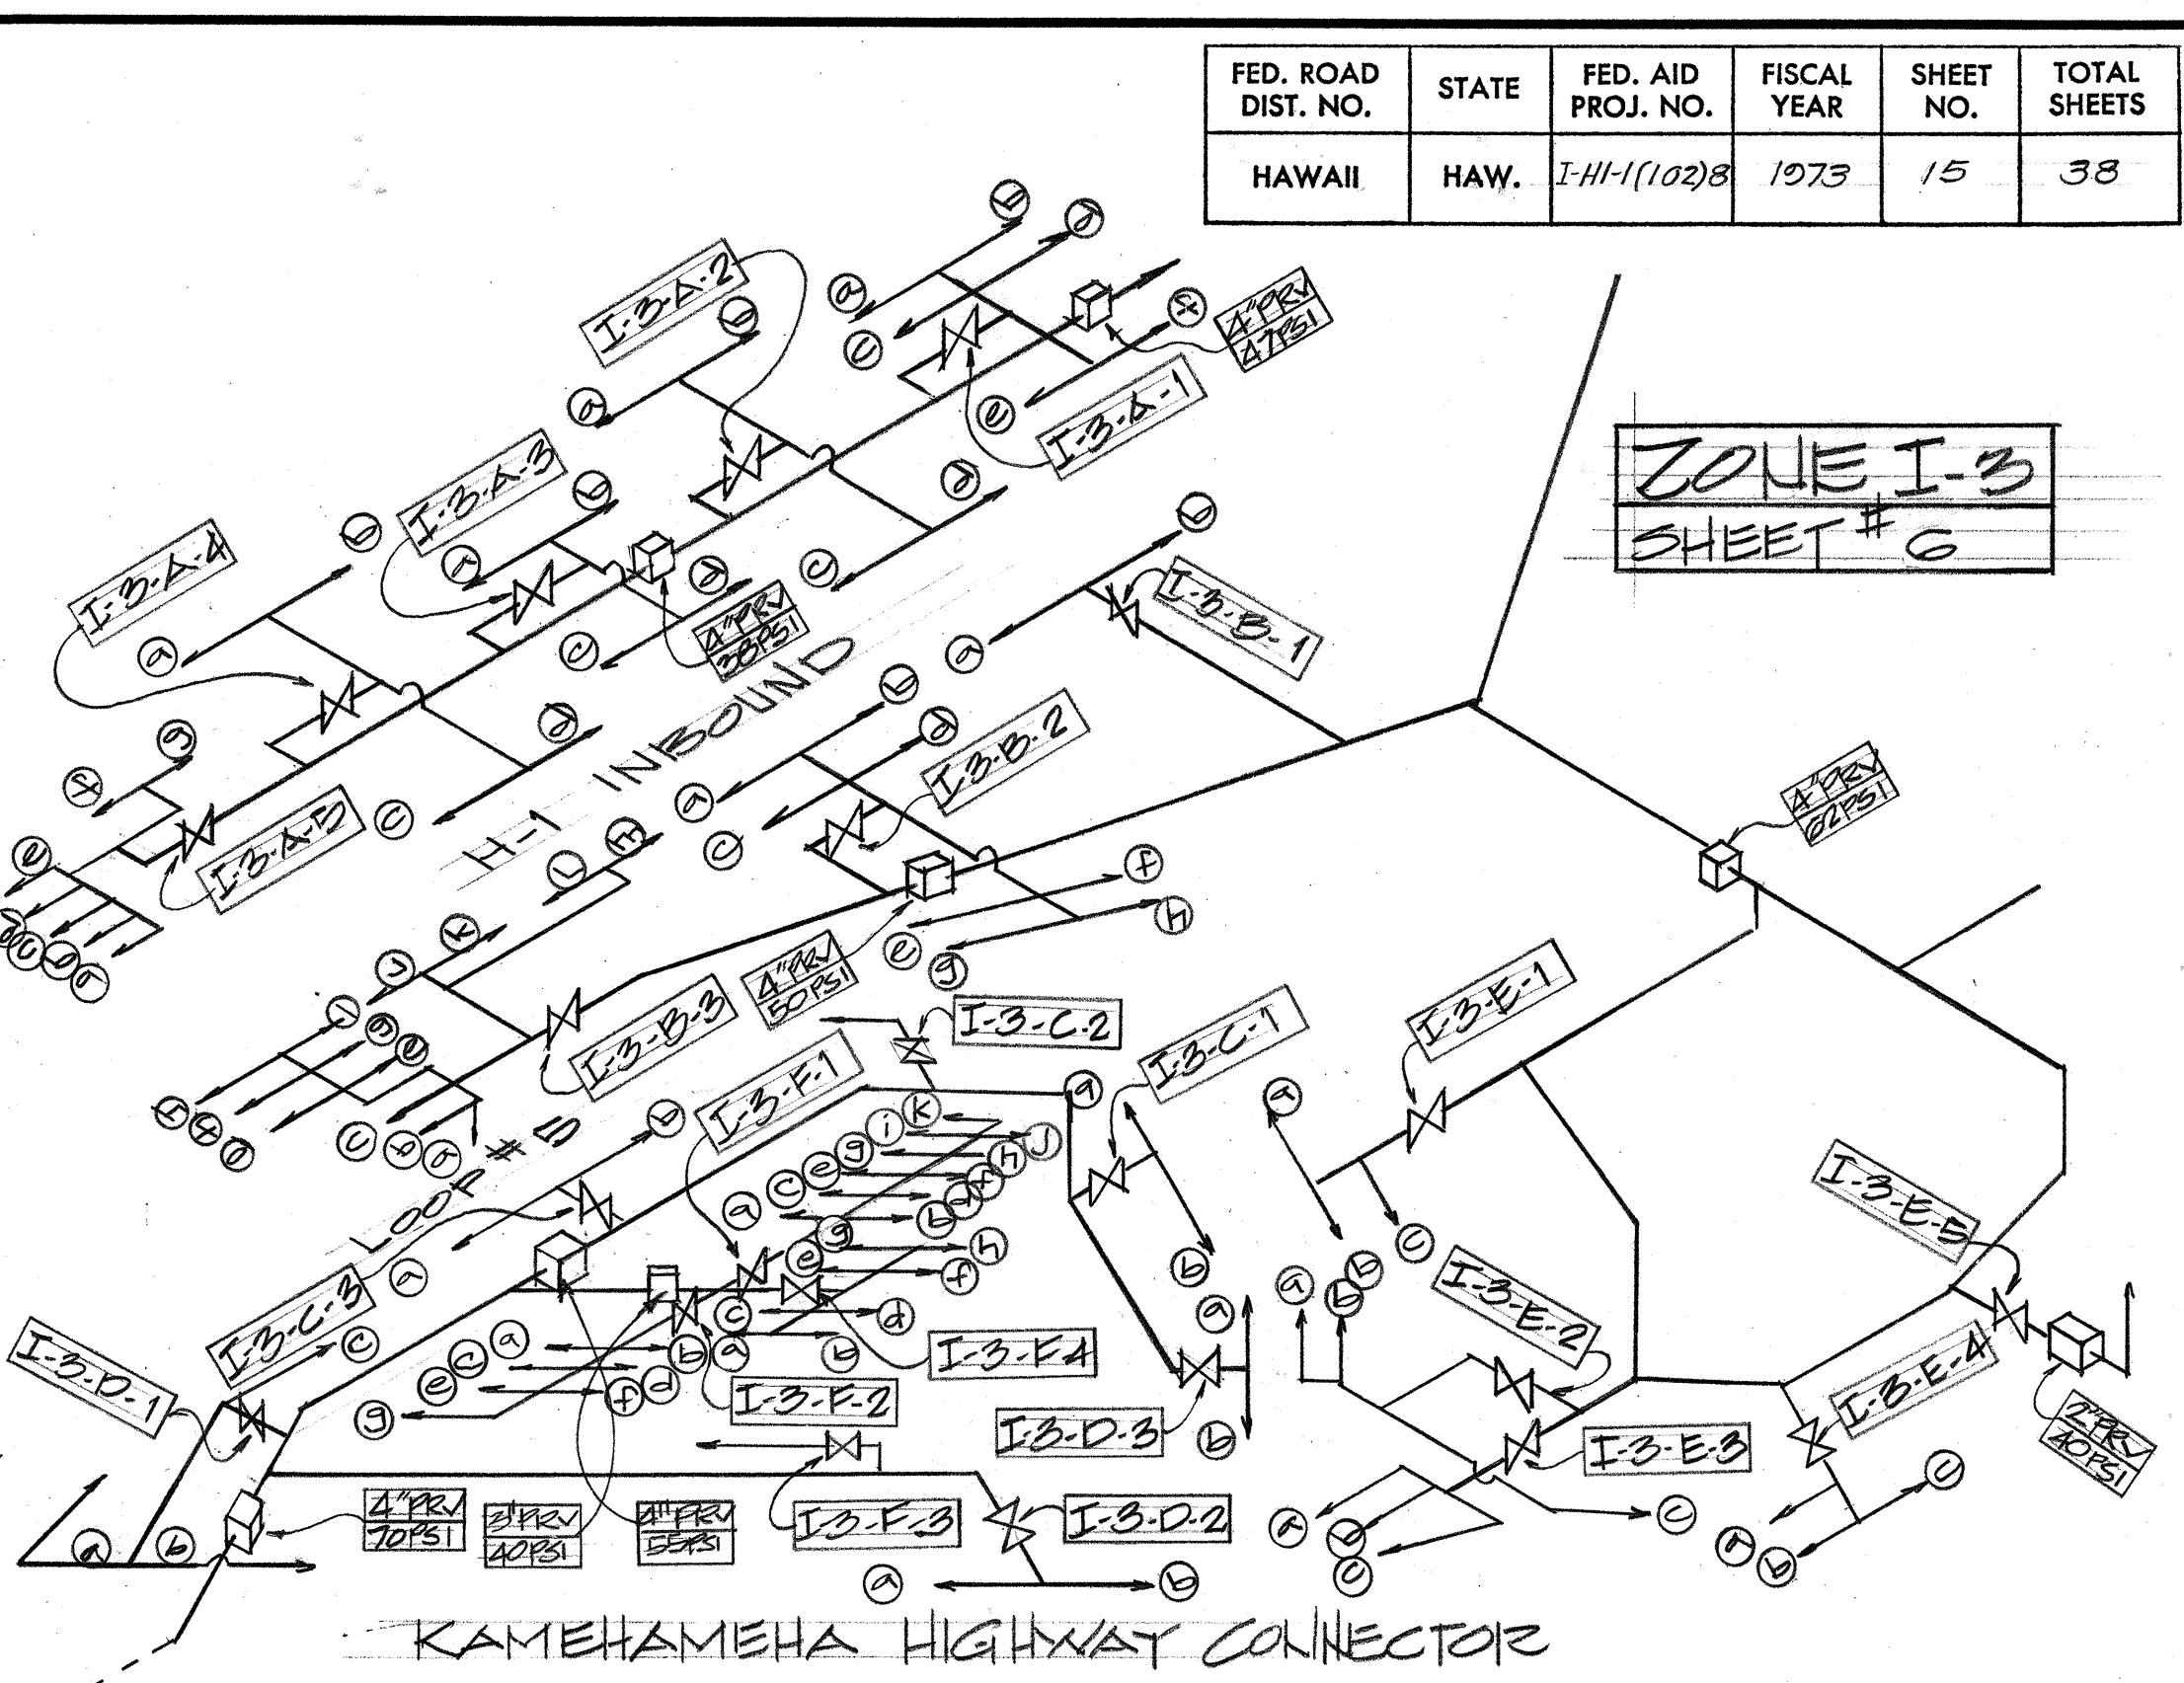
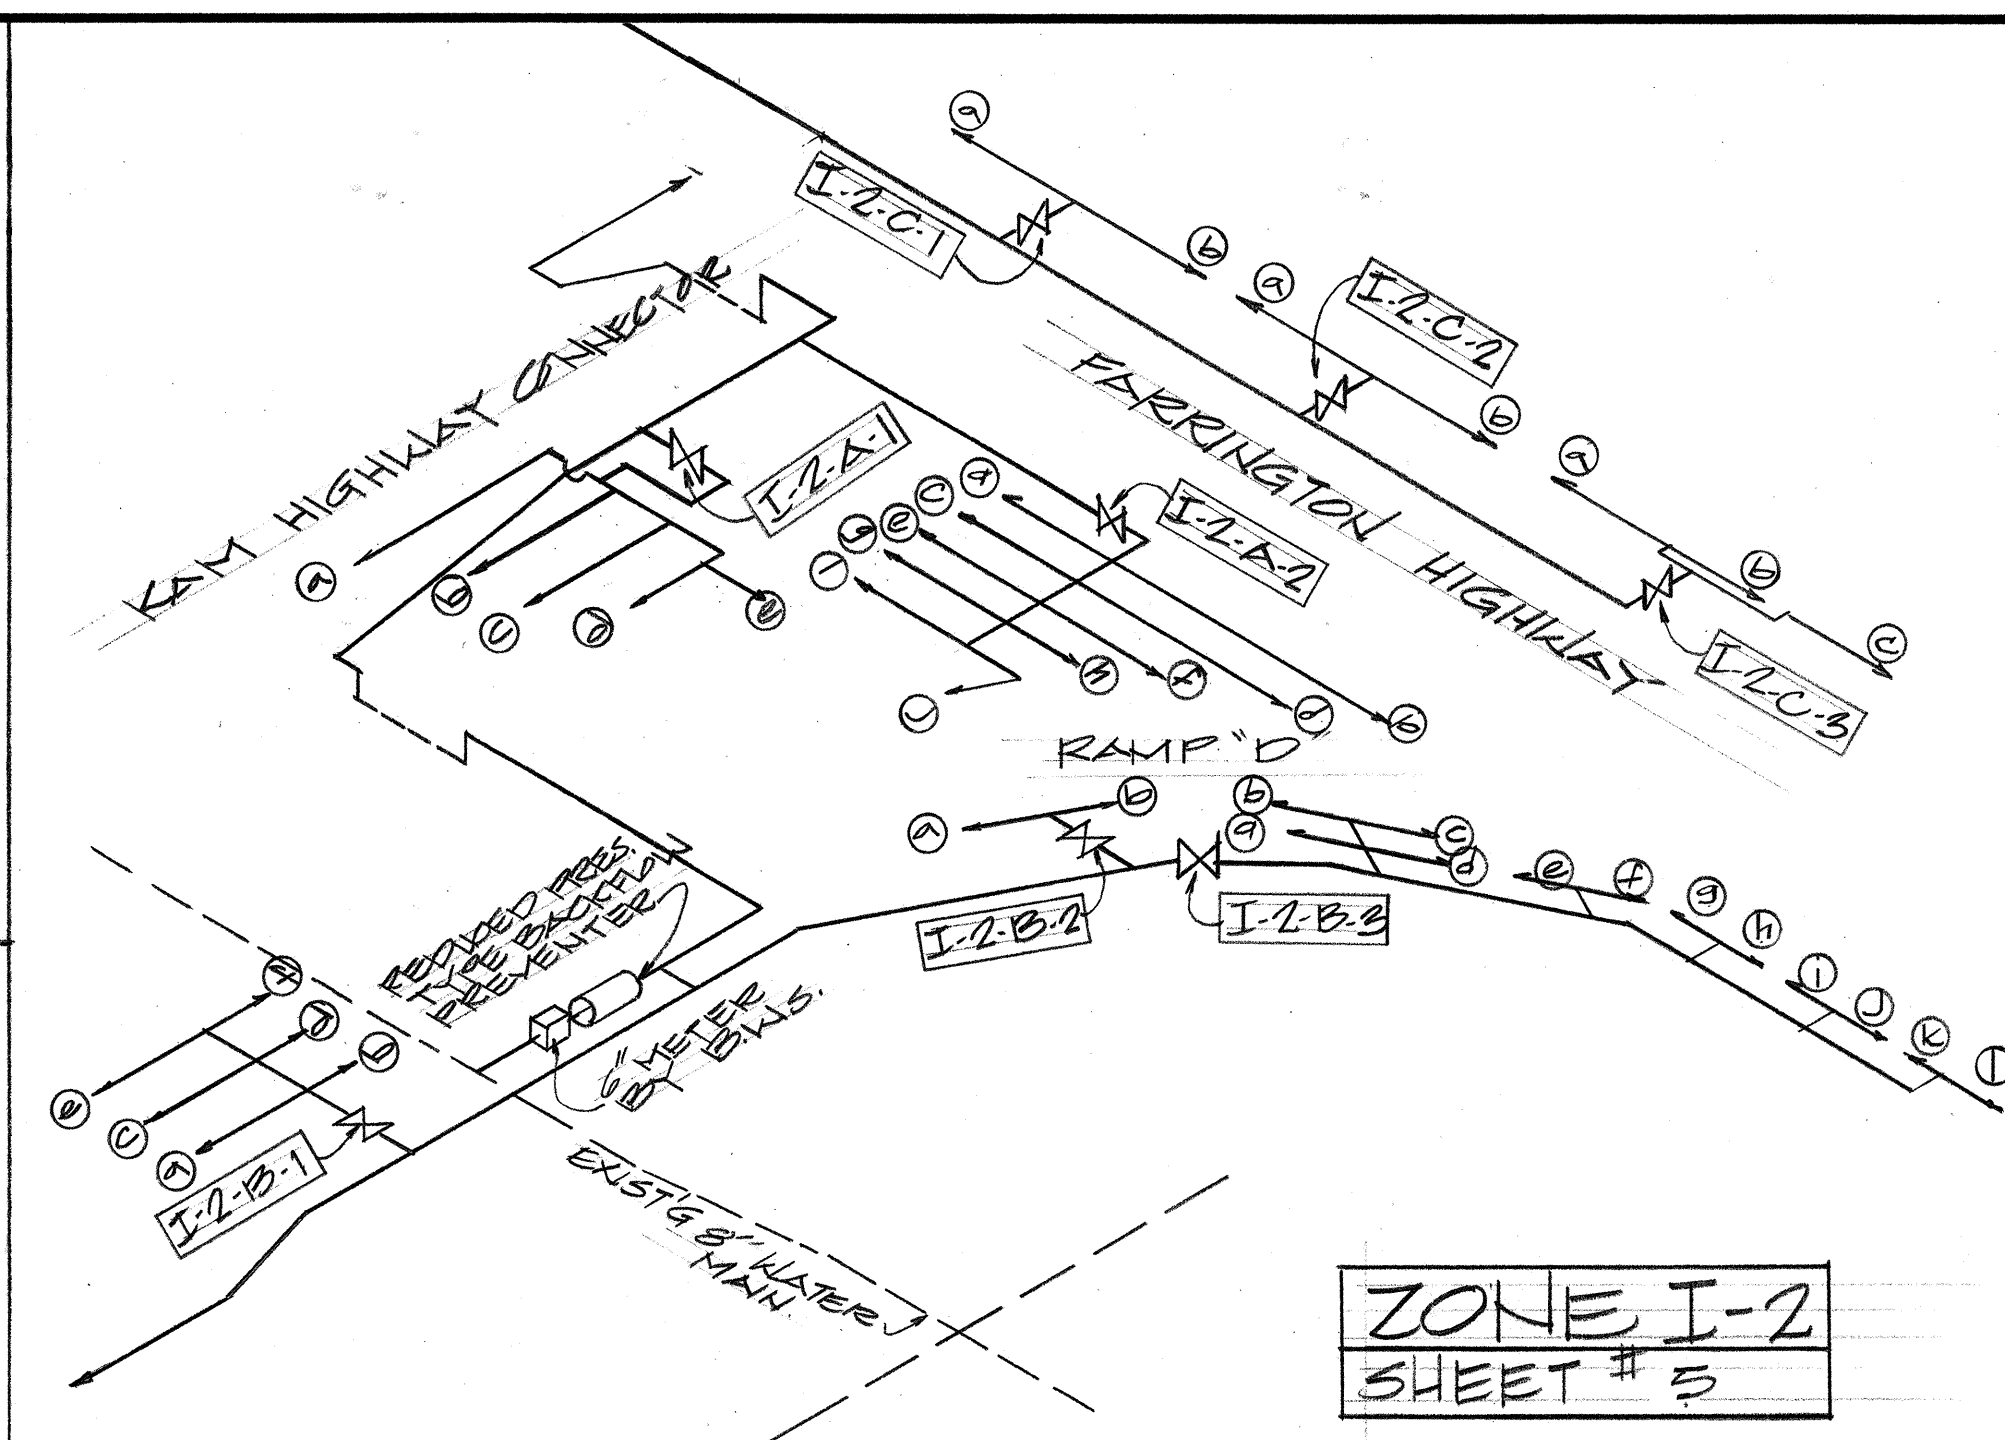


FED. ROAD DIST. NO.	STATE	FED. AID PROJ. NO.	FISCAL YEAR	SHEET NO.	TOTAL SHEETS
HAWAII	HAW.	I-111(102)B	1973	15	38

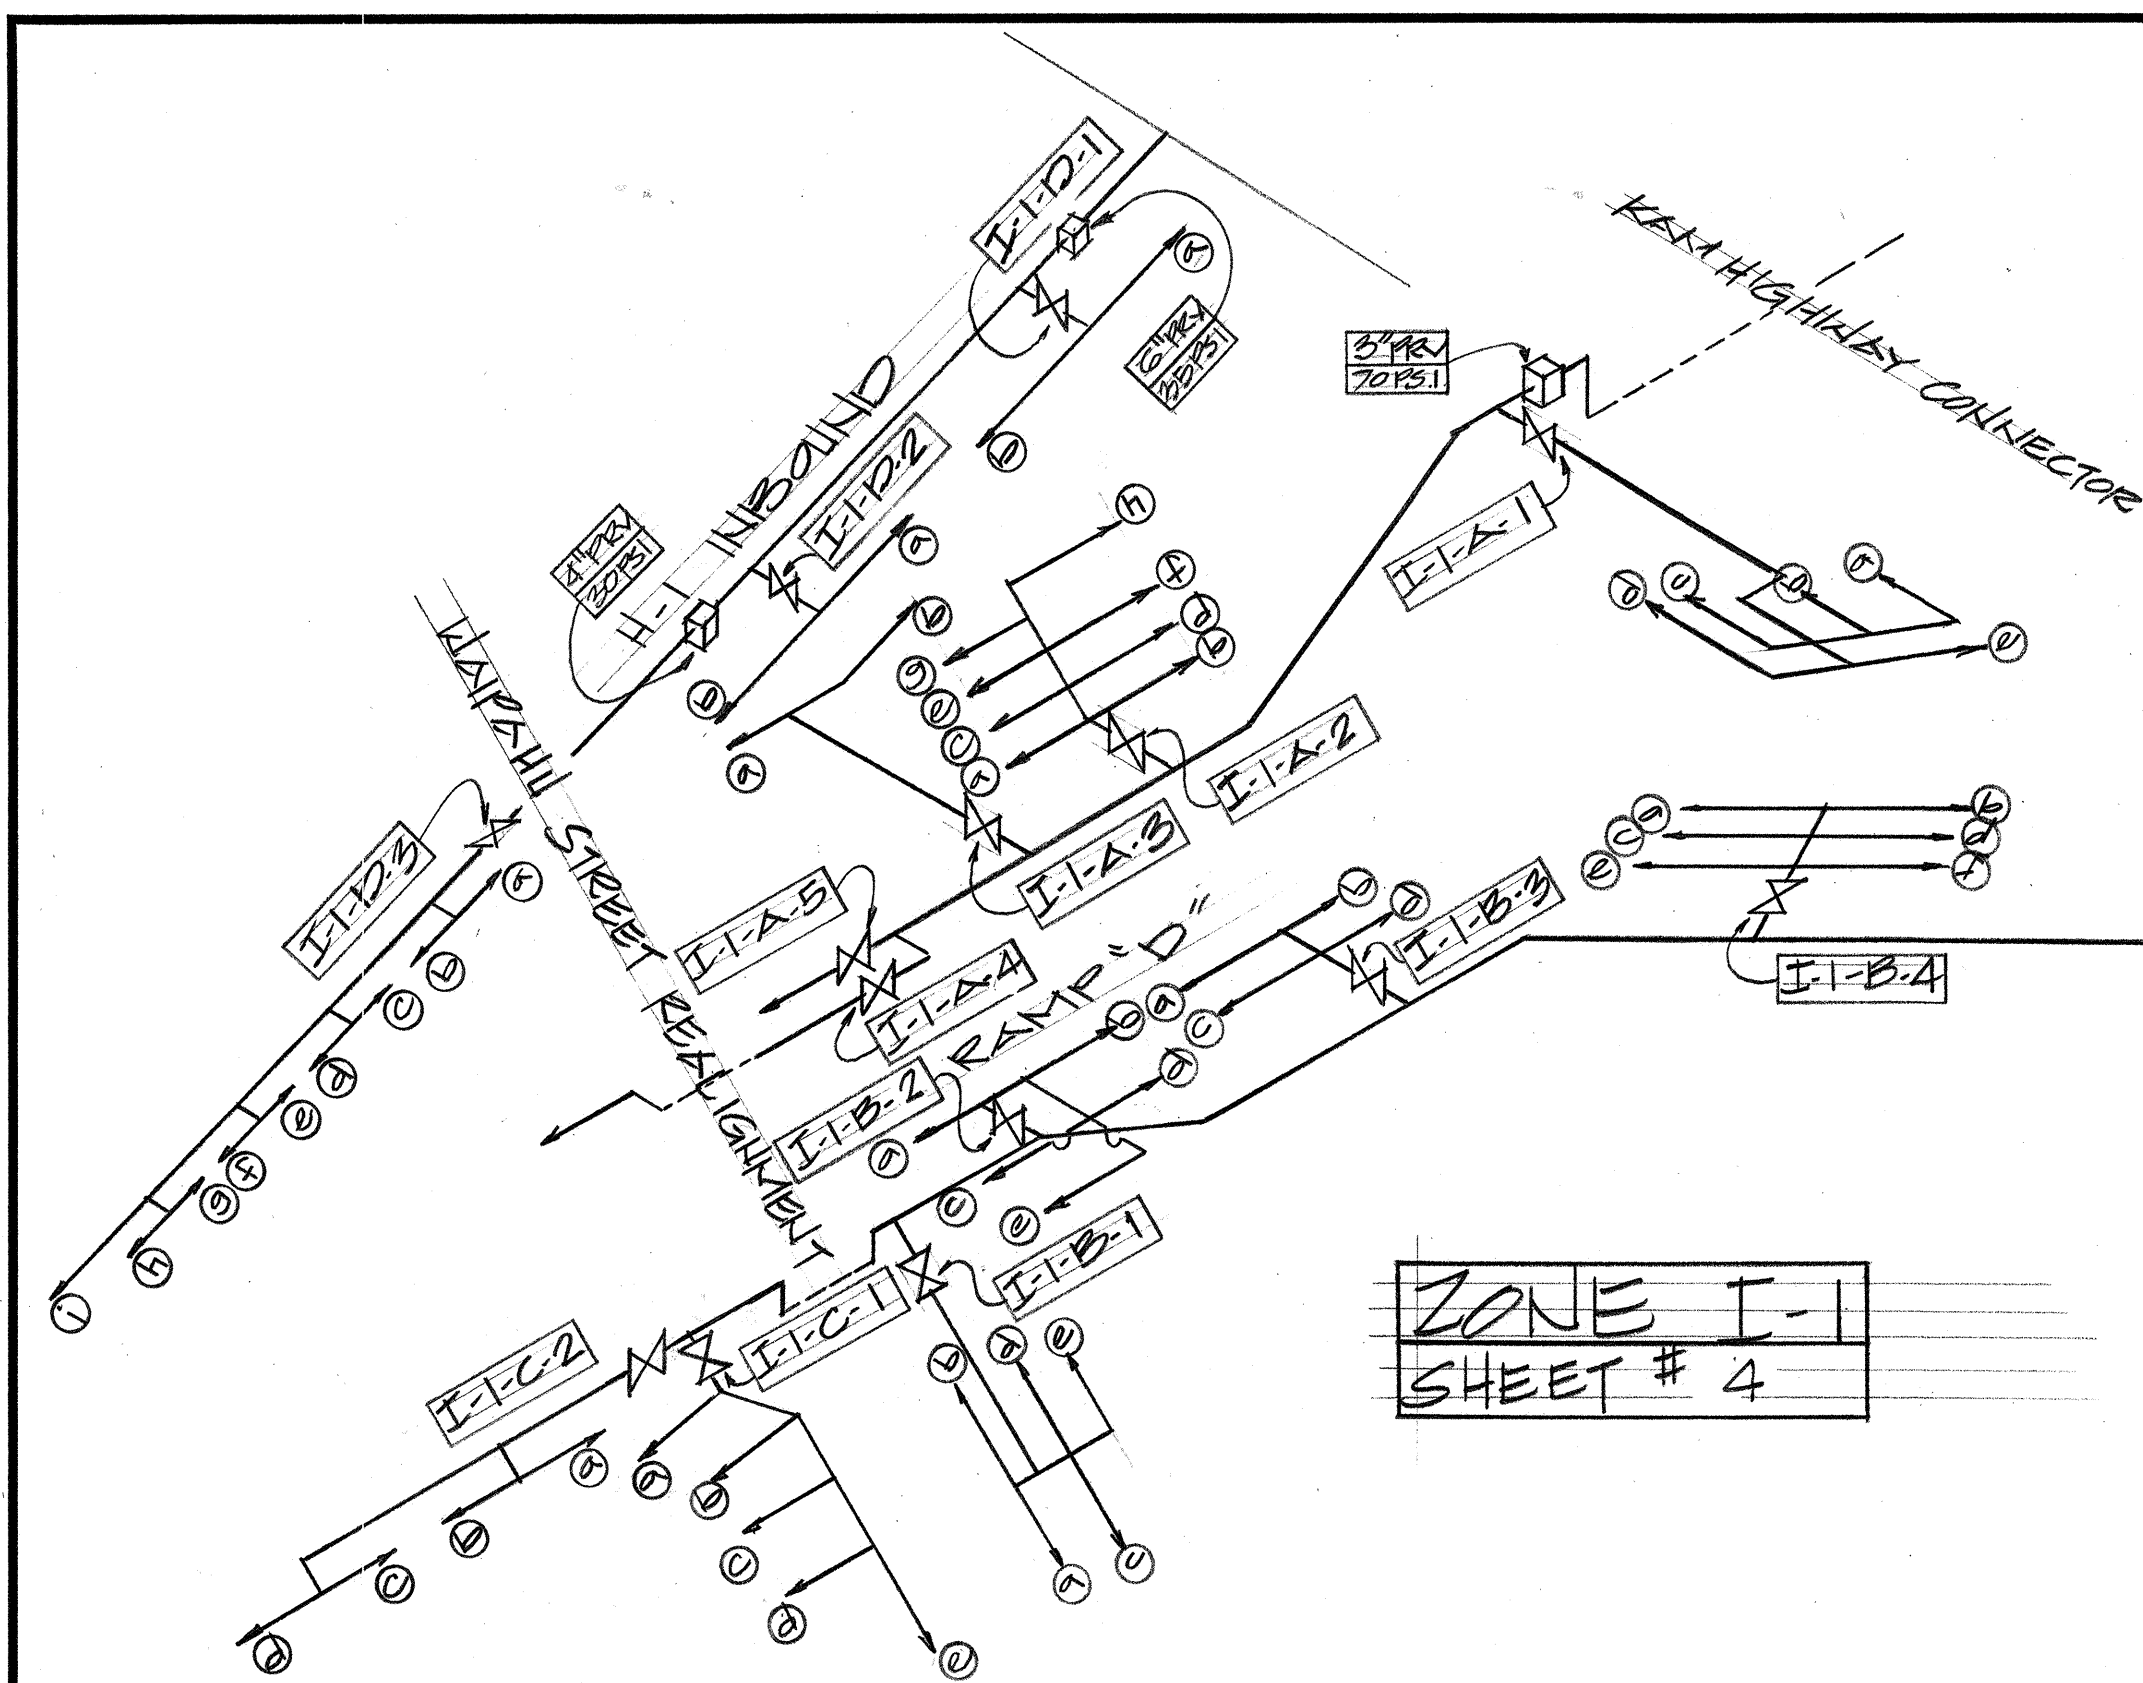

DELETE THIS SHEET SEE SHEET NO. 15-1

DATE: _____
 DRAWN BY: _____
 DESIGNED BY: _____
 CHECKED BY: _____
 ORIGINAL PLAN NO. _____
 NOTE BOOK NO. _____

PHILIP K. H. YEE & ASSOCIATES
 CONSULTING ENGINEERS
 243 Liliuokalani Ave., Rm. 101
 Honolulu, Hawaii 96815

PHILIP K. H. YEE
 REGISTERED PROFESSIONAL ENGINEER
 No. 26245
 HAWAII, U.S.A.

THIS WORK WAS PREPARED BY ME
 OR UNDER MY SUPERVISION.

STATE OF HAWAII
 DEPARTMENT OF TRANSPORTATION
 HIGHWAYS DIVISION

WAIAWA INTERCHANGE
 WATER SPRINKLER SYSTEM
 PROJ # I-111(102)B

**ISOMETRIC DIAGRAMS
 OF BRANCHES**

SHEET No. 15 OF 39 SHEETS

