


GENERAL NOTES

- 1- FARRINGTON HIGHWAY MEDIAN - PRIOR TO PLANTING OF HIBISCUS AND PLACING OF BED COURSE MATERIAL THE CONTRACTOR SHALL COVER THE MEDIAN WITH 6 MM GAGE POLYETHYLENE OR PLASTIC COATED TARPULIN.
- 2- PLANT LOCATIONS SHALL BE DIRECTLY SCALED OFF THE PLANS.
- 3- HATCHED LINES INDICATE AREAS ALREADY PLANTED.
- 4- UNLESS OTHERWISE NOTED, CROSSED HATCHED ~~XXXXX~~ AREAS INDICATE AREAS PLANTED UNDER PRIOR CONTRACTS THAT WILL REQUIRE GROUND PREPARATION WORK UNDER THIS CONTRACT. GROUND PREPARATION WORK FOR THESE AREAS SHALL INCLUDE WEEDING, TOPSOIL, HYDRO-MULCH SEEDING, REMOVAL OF STONES OVER 3 INCHES IN DIAMETER, PAPERS, TRASH AND NINE MONTHS OF PLANT ESTABLISHMENT WORK.

LEGEND

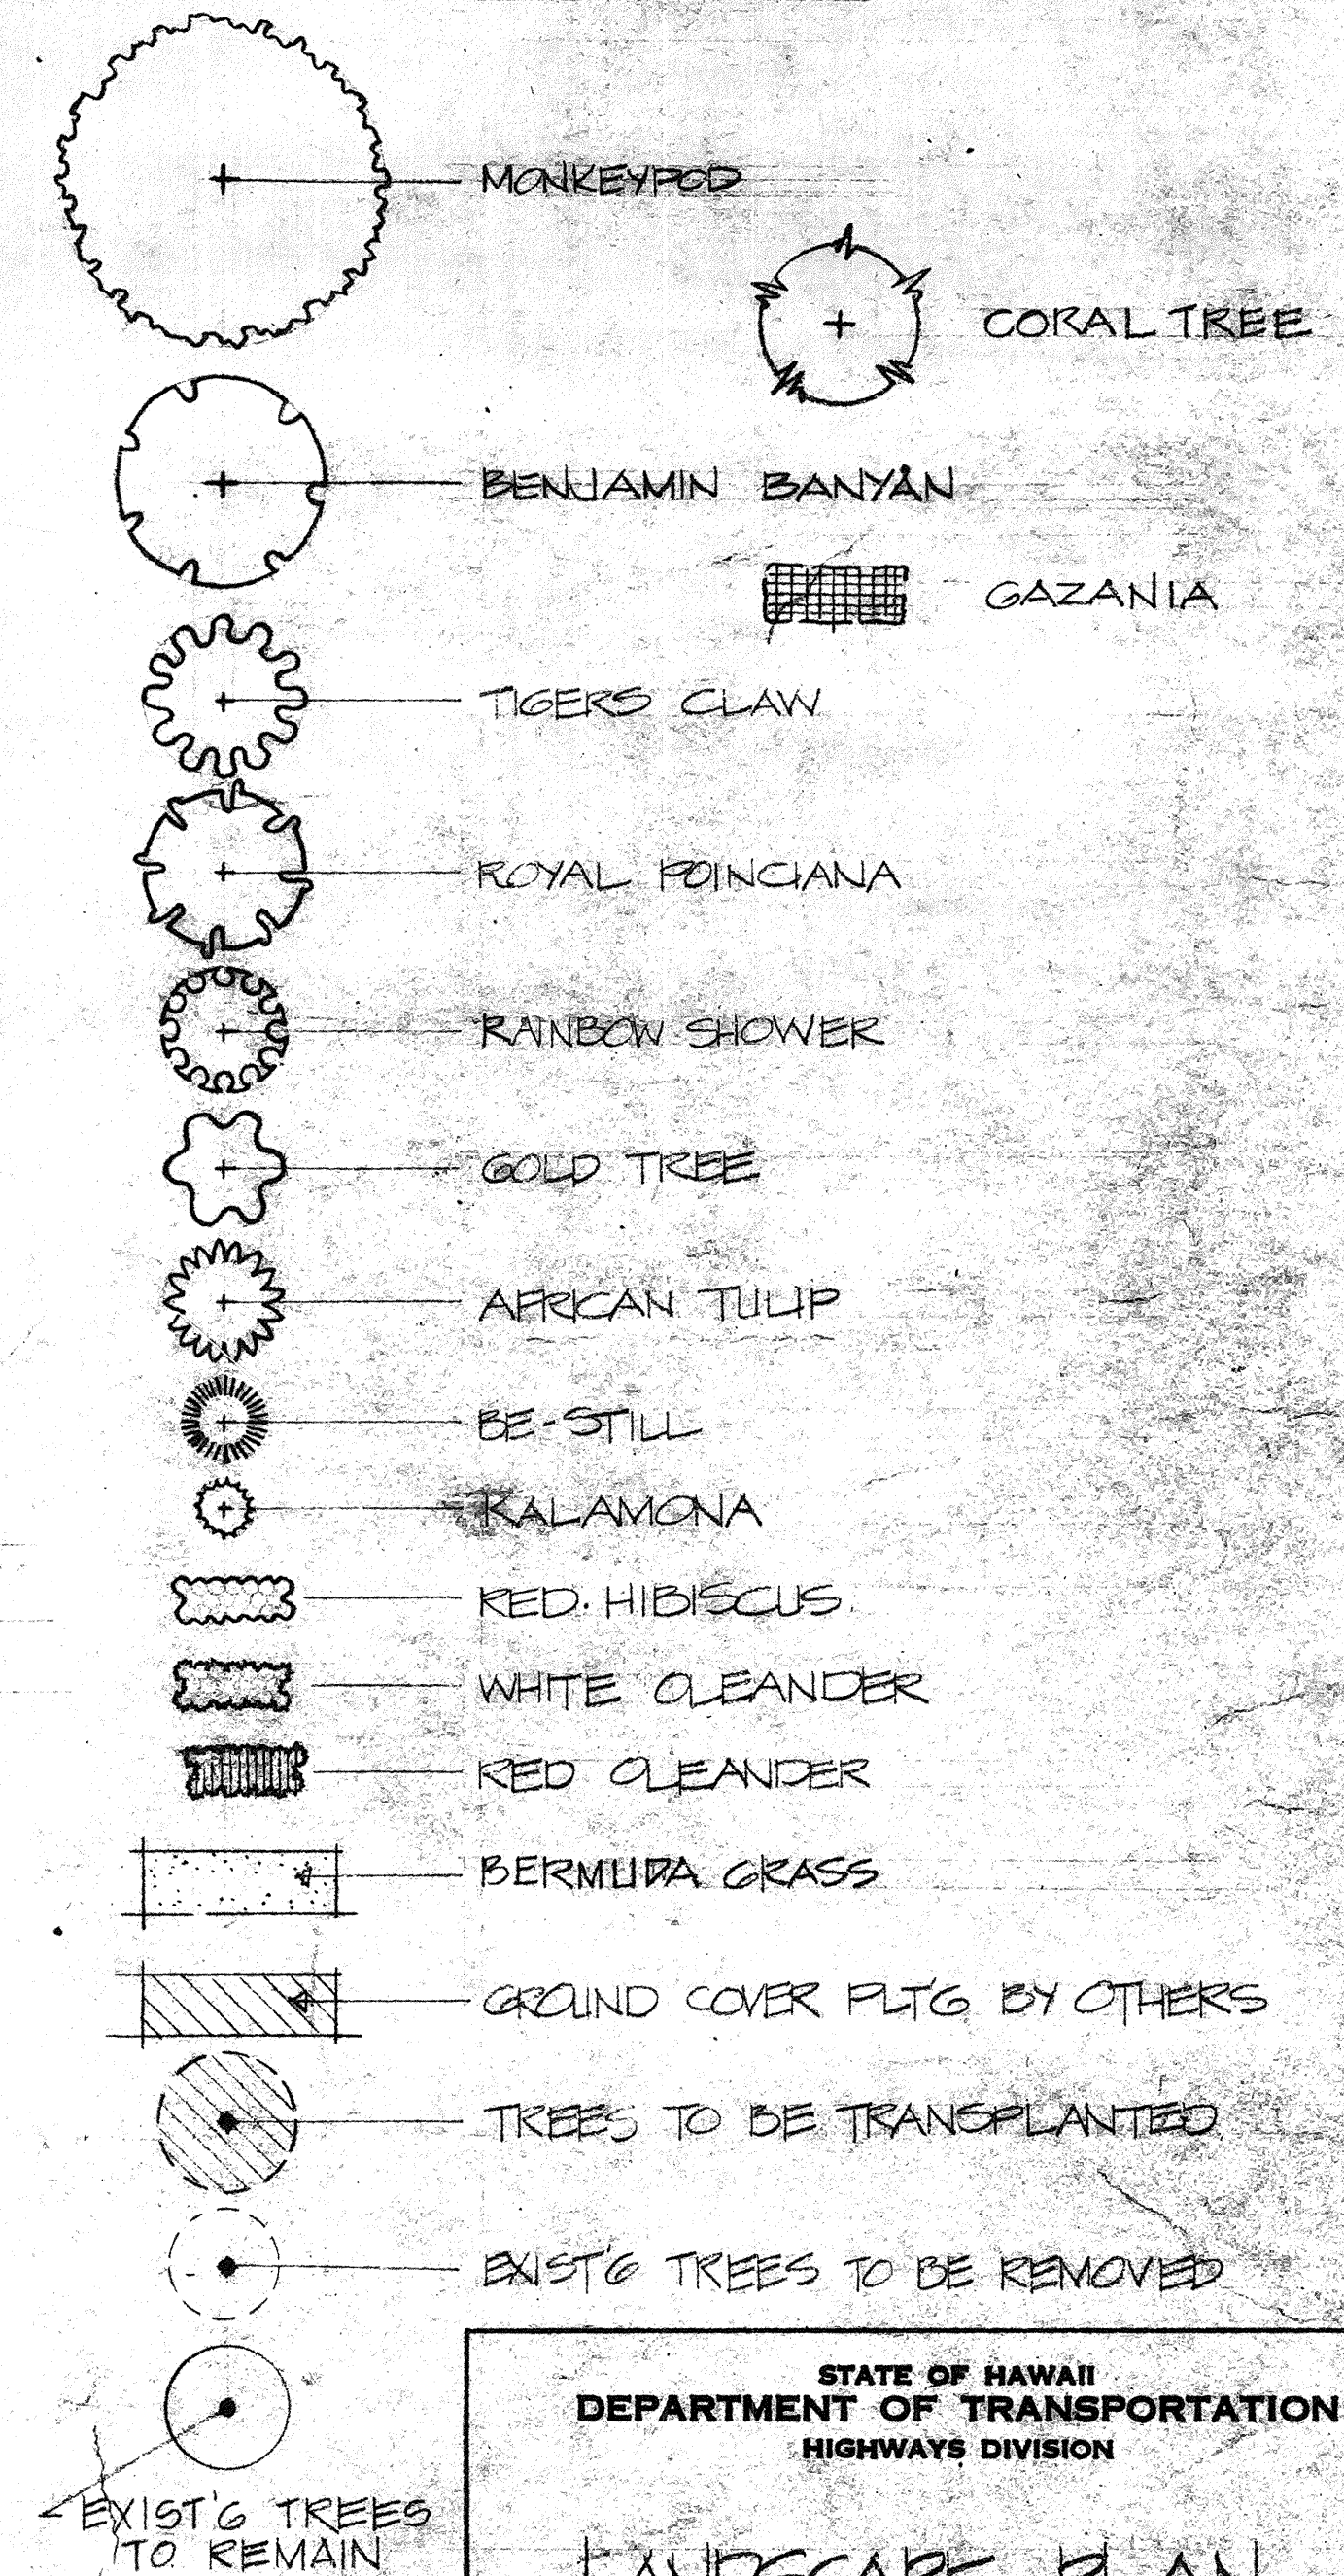

COMPLETE PLANT LIST		
QUANT.	NAME	SIZE
58	TIGERS CLAW - ERYTHRINA VARIEGATA	5 GAL. 54" HT.
78 9	GOLD TREE - TABERUEA DUNNELL-SMITHII	FG.15'-20'-5'-8" DIA.
87	RAINBOW SHOWER - CASSIA FIST. x JAV.	5 GAL. 54" HT.
98 158	KALAMONA - CASSIA GLAUCA	5 GAL. 54" HT.
13	ROYAL POINCIANA - POINCIANA REGIA	FG.10'-12'-4'-6" DIA.
35 38	MONKEYPOD - SAMANEA SAMAN	5 GAL. 54" HT.
17	AFRICAN TULIP SPATHODEA CAMPANULATA	FG.10'-12'-3'-5" DIA.
61	CHINESE BANYAN - FICUS RETUSA	FG.15'-20'-5'-8" DIA.
773	RED HIBISCUS - HIBISCUS ROSA-SINENSIS	1 GAL. 18"-24" HT.
237	BE-STILL - THEVETIA PERUVIANA	1 GAL. 24" HT.
94	RED OLEANDER - NERIUM OLEANDER	1 GAL. 24" HT.
478	WHITE OLEANDER - NERIUM OLEANDER	1 GAL. 24" HT.
340,207 #	SEEDING SURFACES - BERMUDA GRASS - ZYNDON DACTYLON	HYDRO-MULCH SEE SPEC'S
540,207 #	GROUND PREPARATION	
3,380 C.Y.	IMPORTED TOPSOIL	
88	CORAL TREE - ERYTHRINA CRISTA GALLI	FG.8'-10'-3'-5" DIA.
699 C.Y.	BED COURSE MATERIAL	
699,375 #	GROUND PREPARATION FOR EXISTING GROUND COVER	

CONTRACTOR SHALL VERIFY ALL MEASUREMENTS & QUANTITIES

STATE OF HAWAII
DEPARTMENT OF TRANSPORTATION
HIGHWAYS DIVISION

LANDSCAPE PLAN


WAI'AWA INTERCHANGE
F.A.I. PROJ. NO. I-HI-1(102):8


SCALE: AS SHOWN DATE: NOV. 1970

SHEET No. L-1 OF 7 SHEETS


ADD. 30

LOCATION PLAN
SCALE 1"=300'

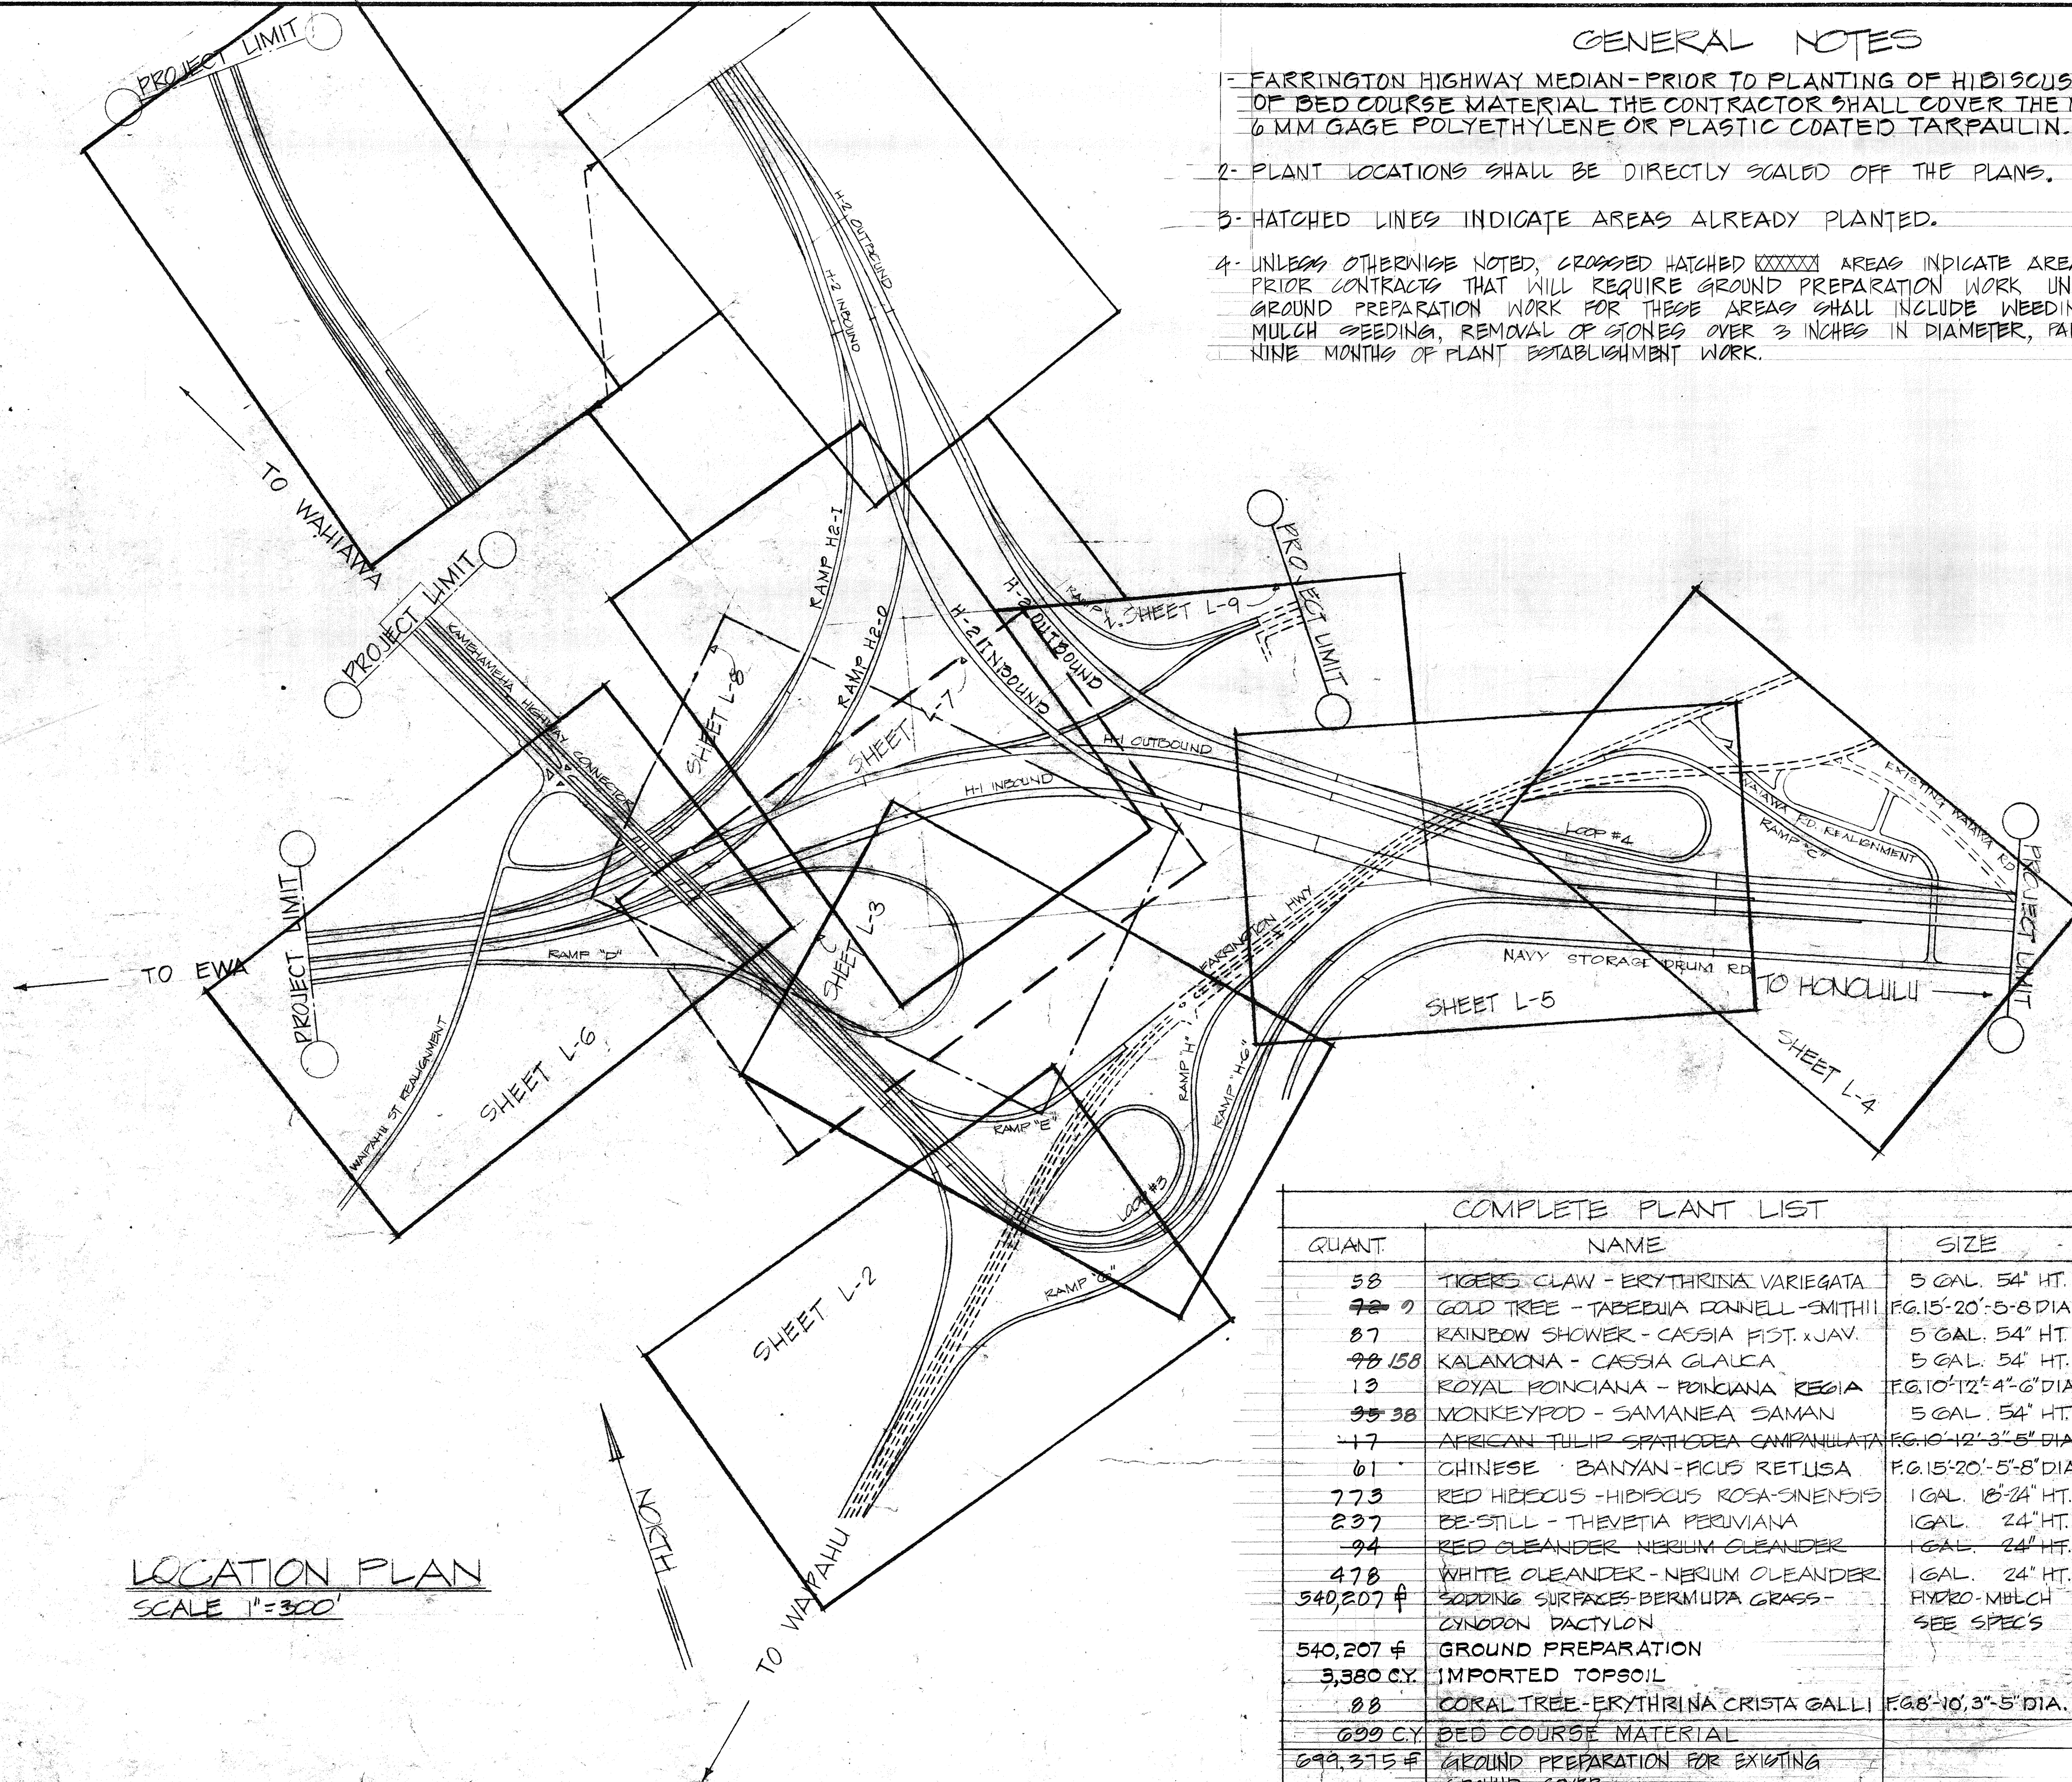


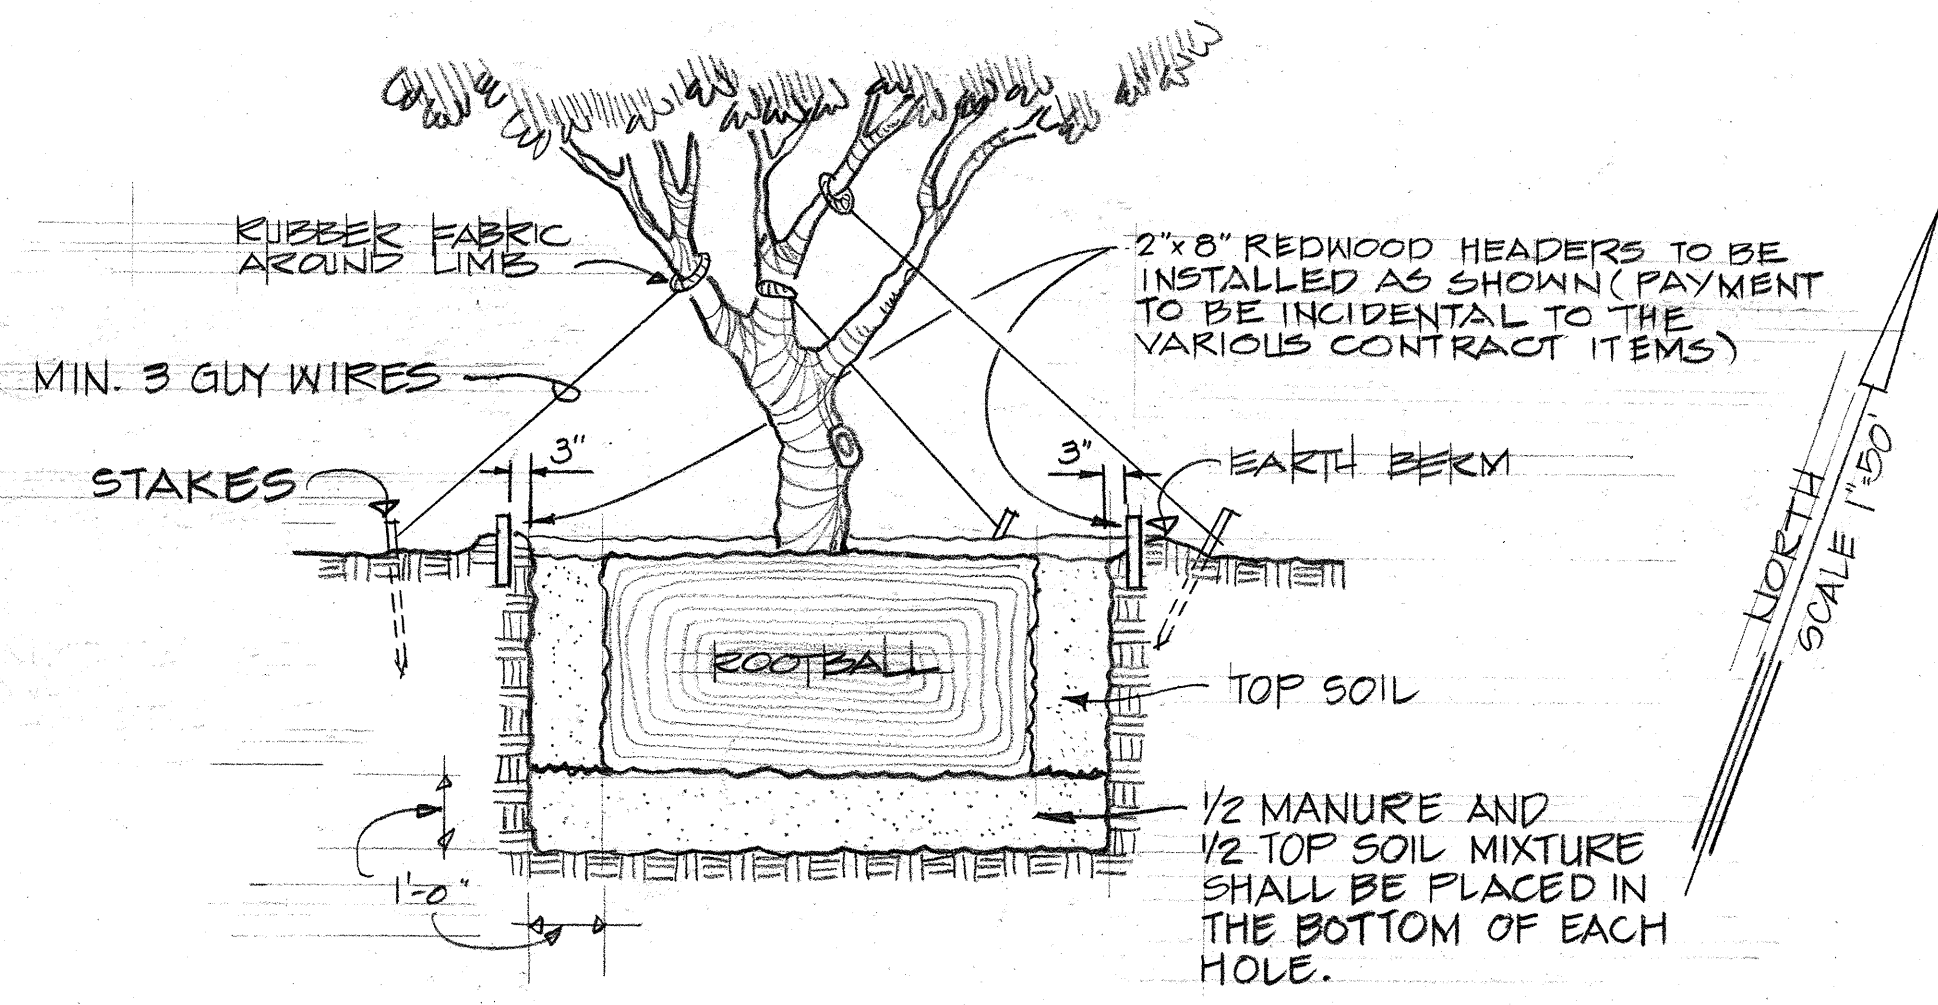


DETAIL FOR TRANSPLANTED TREE
NO SCALE

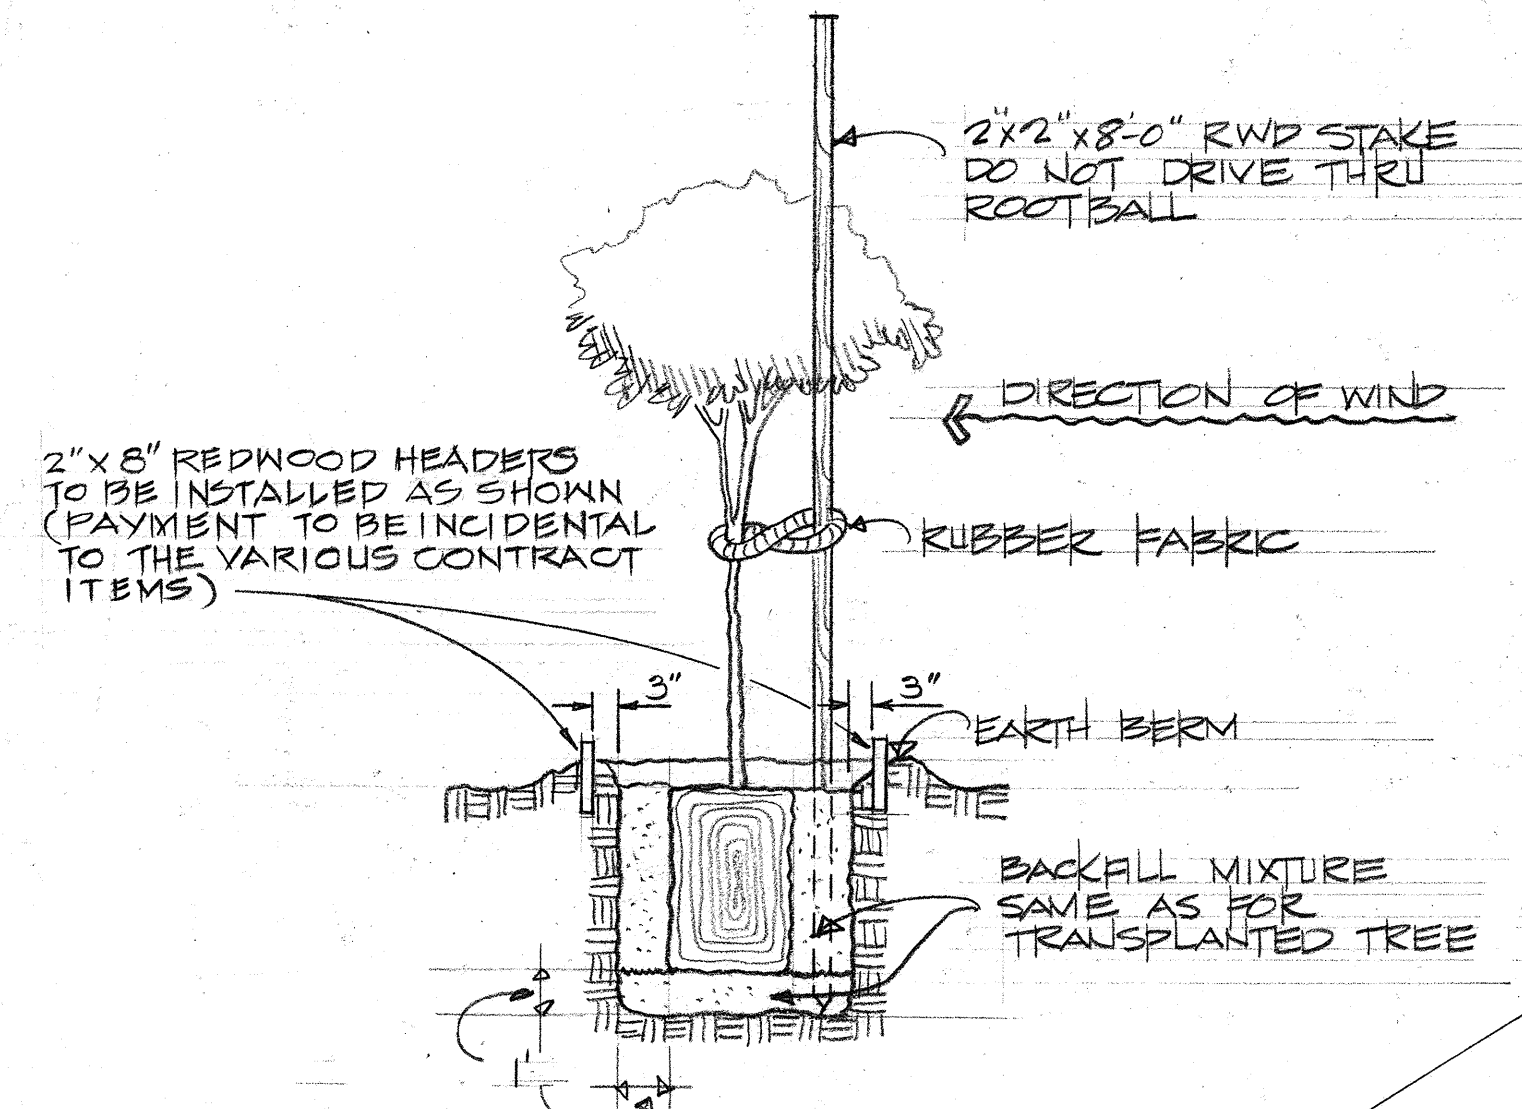

DETAIL FOR CONTAINER TREES
NO SCALE

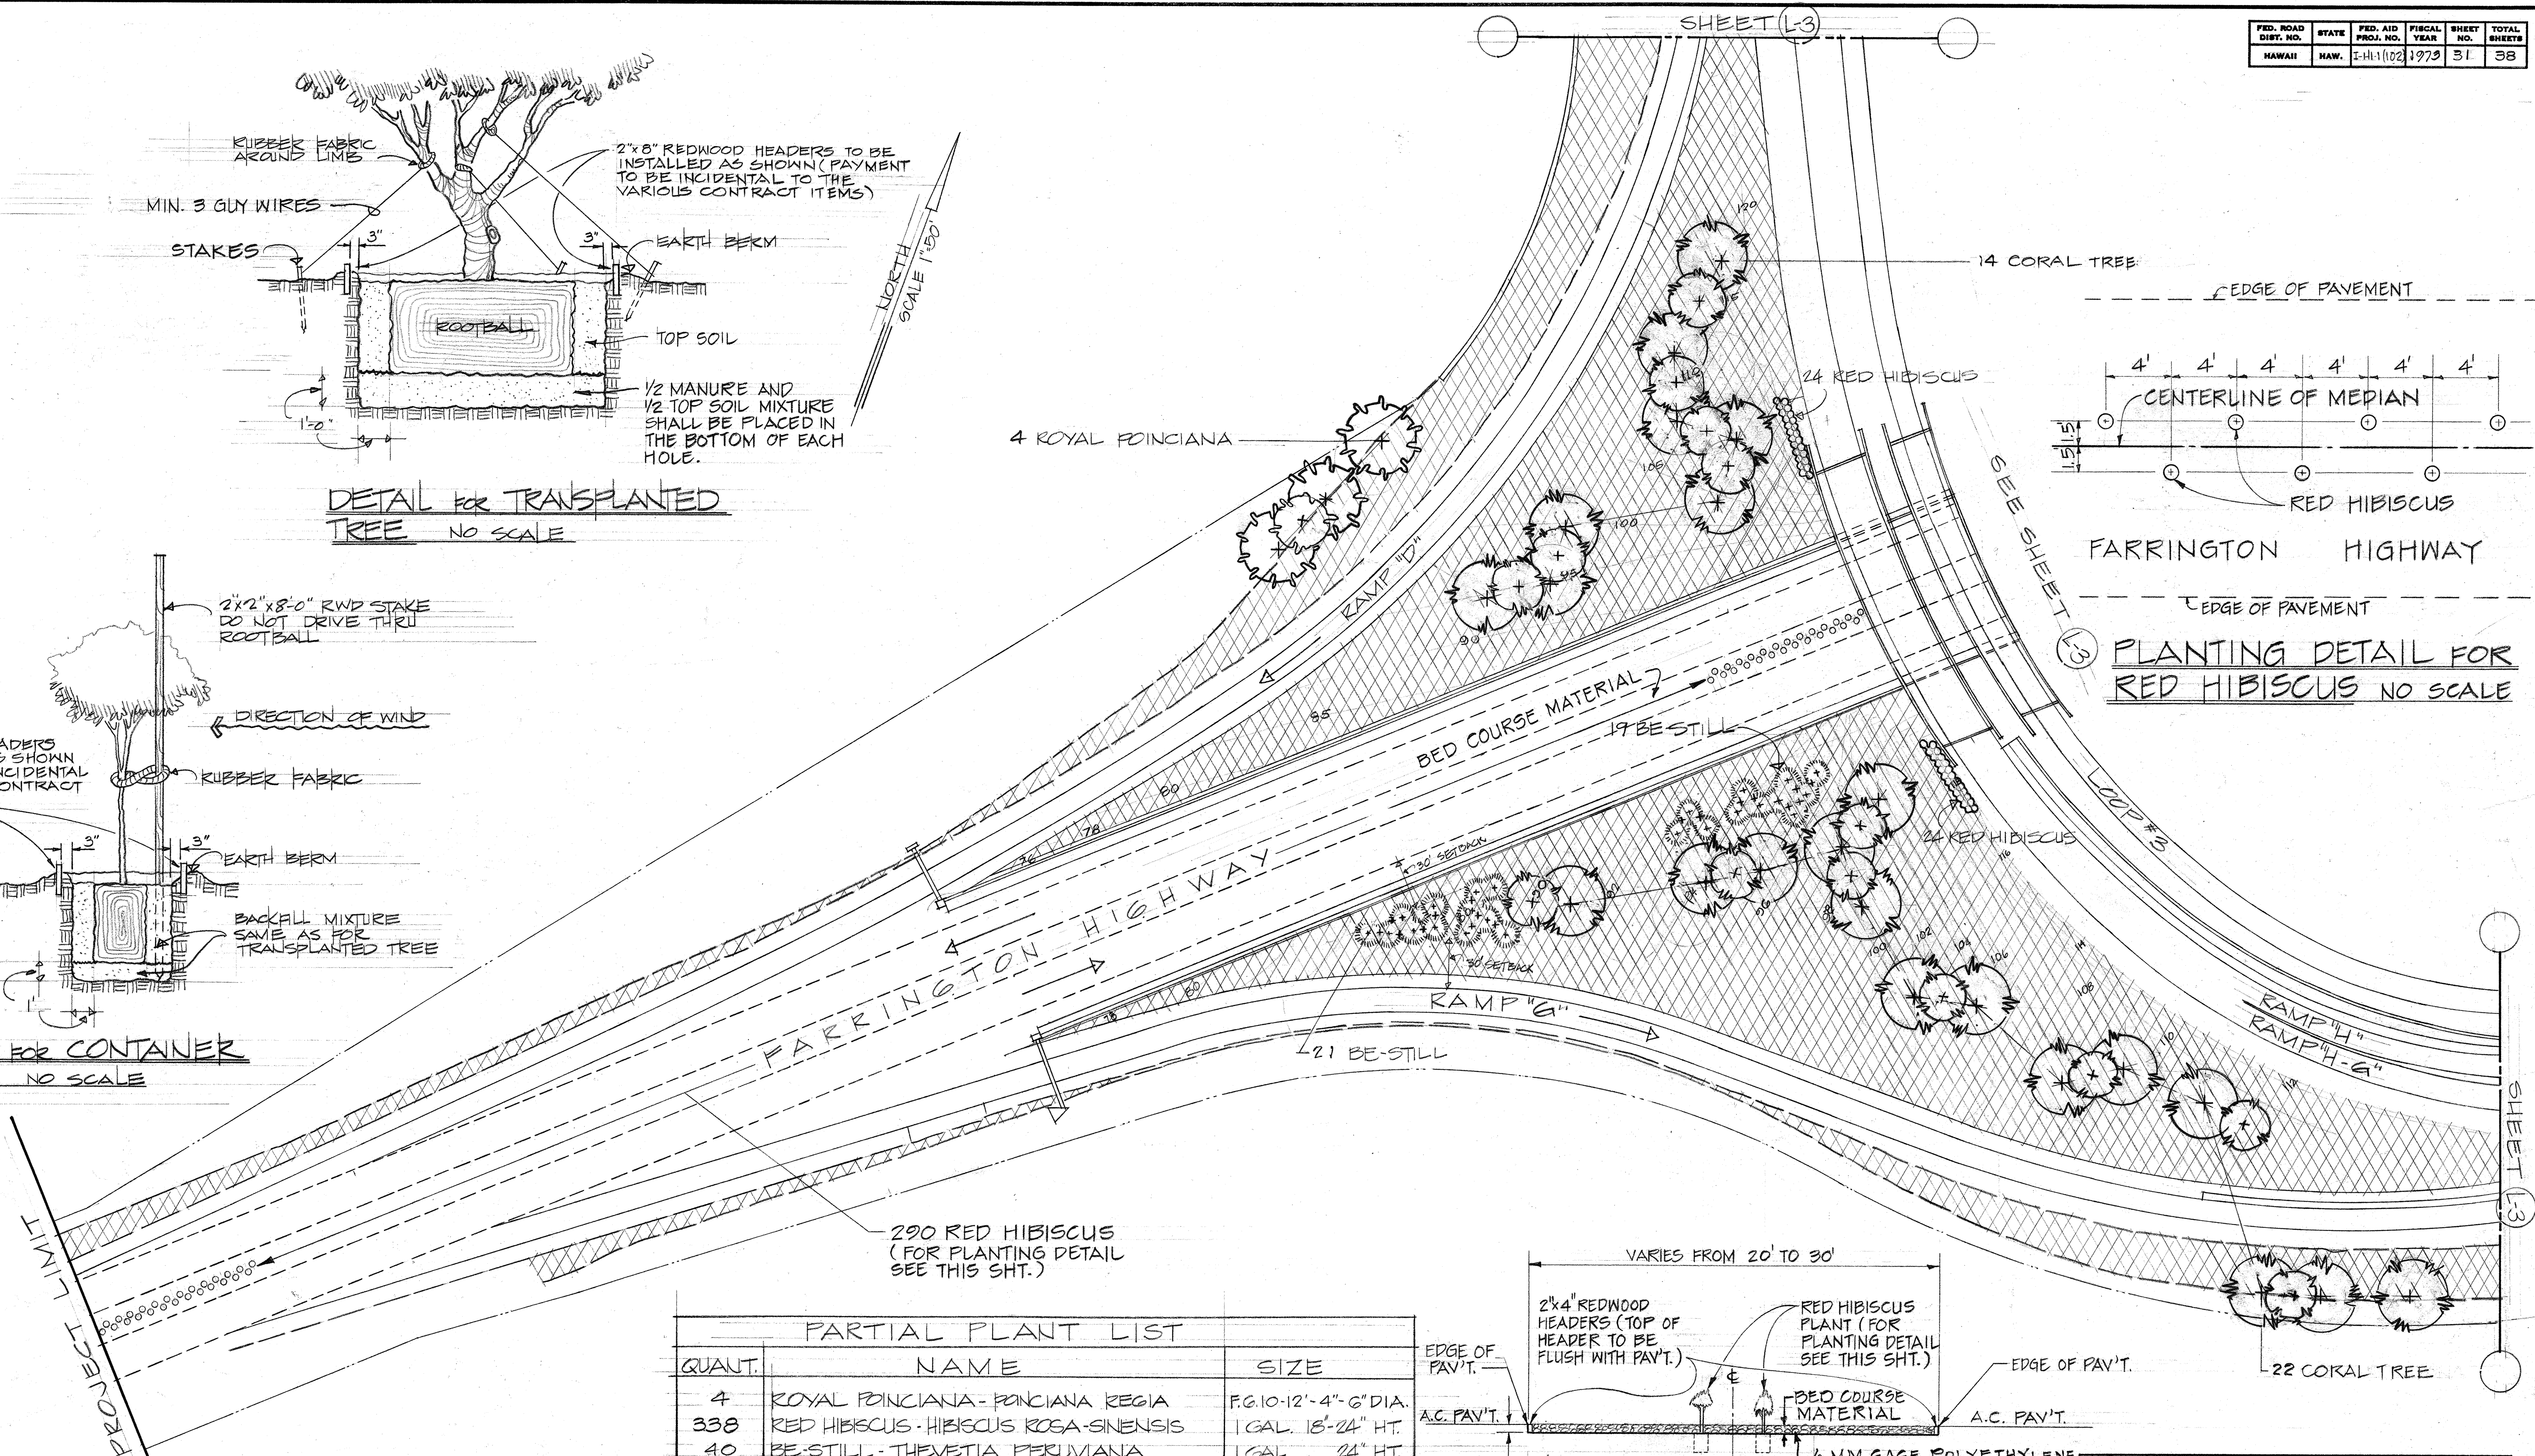

PARTIAL PLANT LIST		
QUANT.	NAME	SIZE
4	ROYAL POINCIANA - POINCIANA REGIA	F.G. 10'-12'-4"-6" DIA.
338	RED HIBISCUS - HIBISCUS ROSA-SINENSIS	1 GAL. 18"-24" HT.
40	BE STILL - THEVETIA PERUVIANA	1 GAL. 24" HT.
36	CORAL TREE - ERYTHRINA CRISTA-GALLI	F.G. 8'-1'-3"-5" DIA.
311 CY.	BED COURSE MATERIAL	
177,250#	GROUND PREPARATION FOR EXISTING GROUND COVER.	

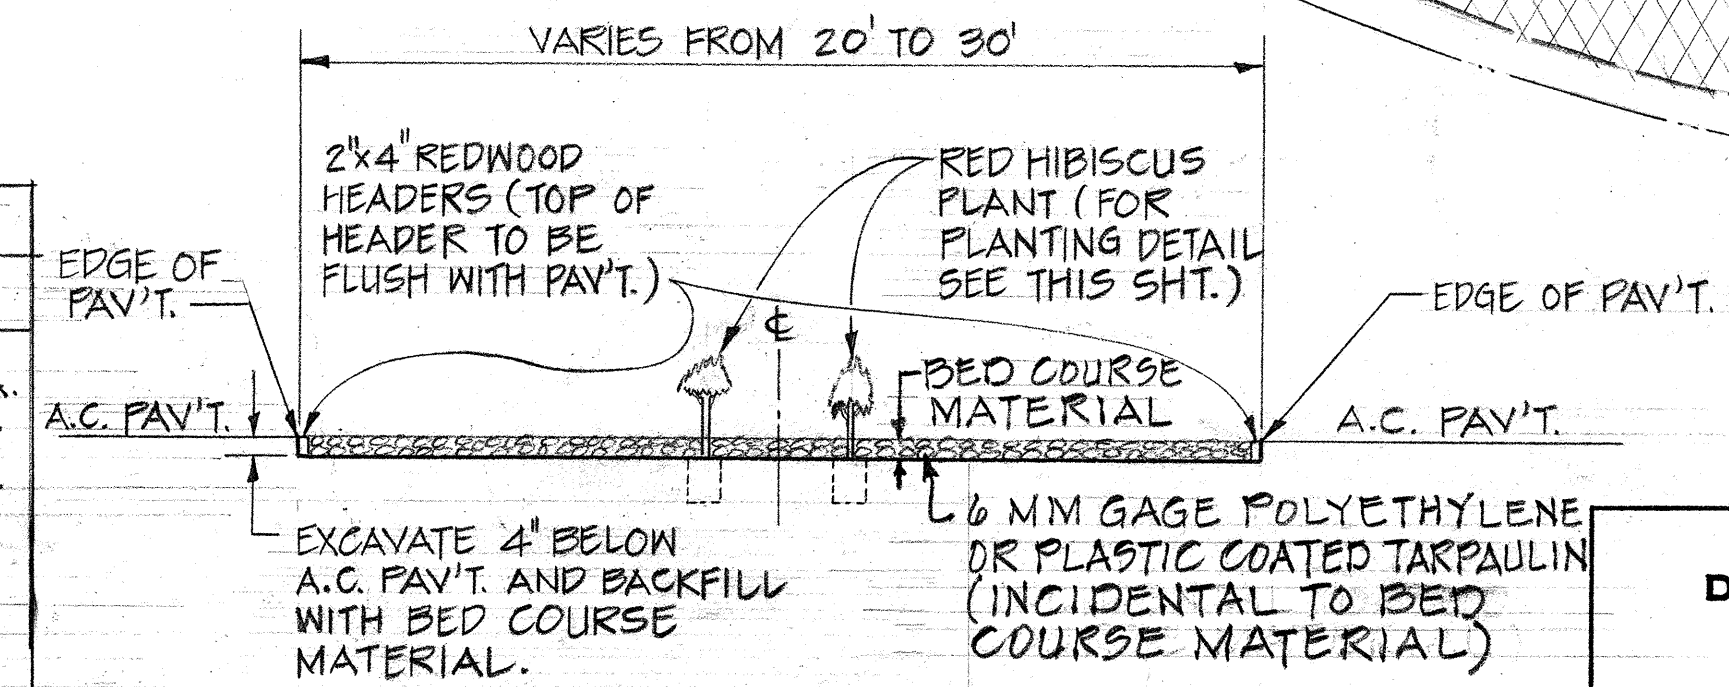

MEDIAN DETAIL FOR FARRINGTON HIGHWAY
SCALE: 1/4"=1'-0"

PLANTING DETAIL FOR RED HIBISCUS
NO SCALE

STATE OF HAWAII
DEPARTMENT OF TRANSPORTATION
HIGHWAYS DIVISION


LANDSCAPE PLAN

WAIAWA INTERCHANGE
F.A.I. PROJ. NO. I-H-1(102):8

SCALE: AS SHOWN DATE:

SHEET No. 31 OF 38 SHEETS

CONTRACTOR SHALL VERIFY ALL MEASUREMENTS & QUANTITIES

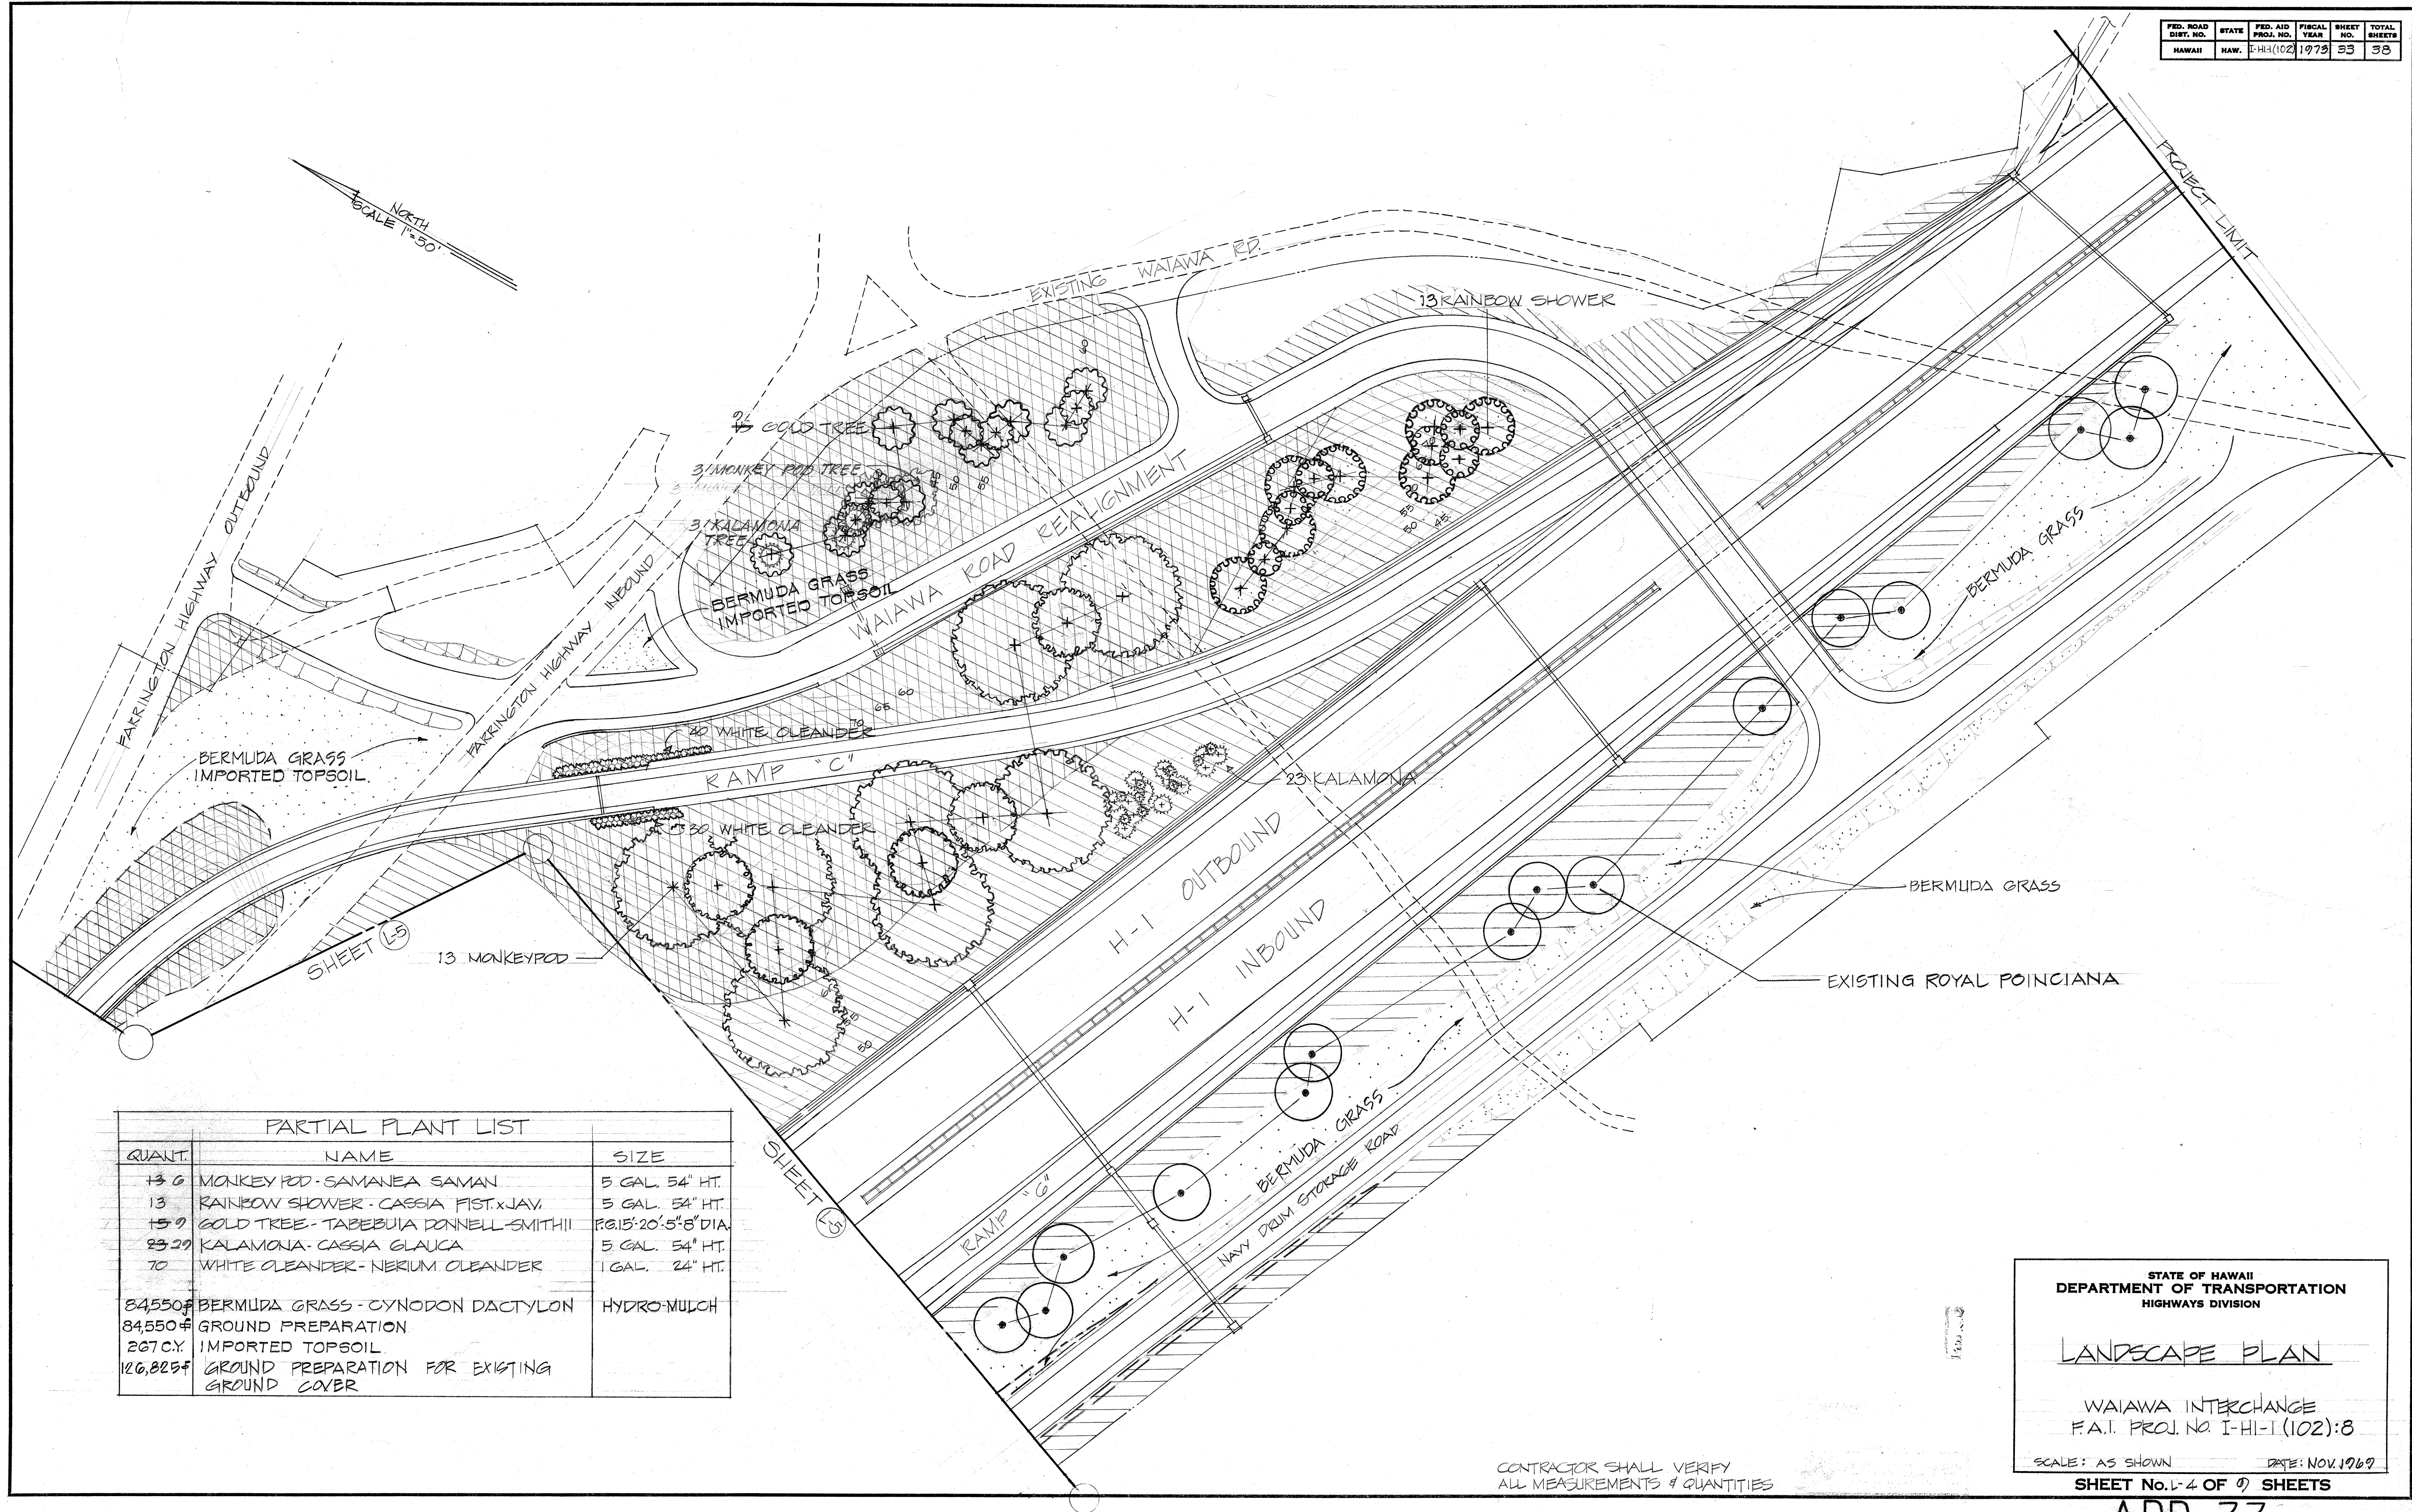

PARTIAL PLANT LIST

QUANT.	NAME	SIZE
13 G	MONKEY POD - SAMANEA SAMAN	5 GAL. 54" HT.
13	RAINBOW SHOWER - CASSIA FIST.XJAV.	5 GAL. 54" HT.
15 G	GOLD TREE - TABEBUIA DONNELL-SMITHII	FG. 15'-20' 5" 8" DIA.
23 29	KALAMONA - CASSIA GLAUCA	5 GAL. 54" HT.
70	WHITE OLEANDER - NERIUM OLEANDER	1 GAL. 24" HT.
84,550	BERMUDA GRASS - CYNODON DACTYLON	HYDRO-MULCH
84,550	GROUND PREPARATION	
267 CY.	IMPORTED TOPSOIL	
126,825	GROUND PREPARATION FOR EXISTING GROUND COVER	

STATE OF HAWAII
DEPARTMENT OF TRANSPORTATION
HIGHWAYS DIVISION

LANDSCAPE PLAN

WAIAWA INTERCHANGE
F.A.I. PROJ. NO. I-HI-1(102):8


SCALE: AS SHOWN DATE: NOV. 1969

SHEET No. 4 OF 9 SHEETS

ADD. 33

CONTRACTOR SHALL VERIFY
ALL MEASUREMENTS & QUANTITIES

DATE: _____
SURVEY PLOTTED BY: _____
DRAWN BY: _____
DESIGNED BY: _____
CHECKED BY: _____
ORIGINAL PLAN: _____
NOTE BOOK: _____
No. _____

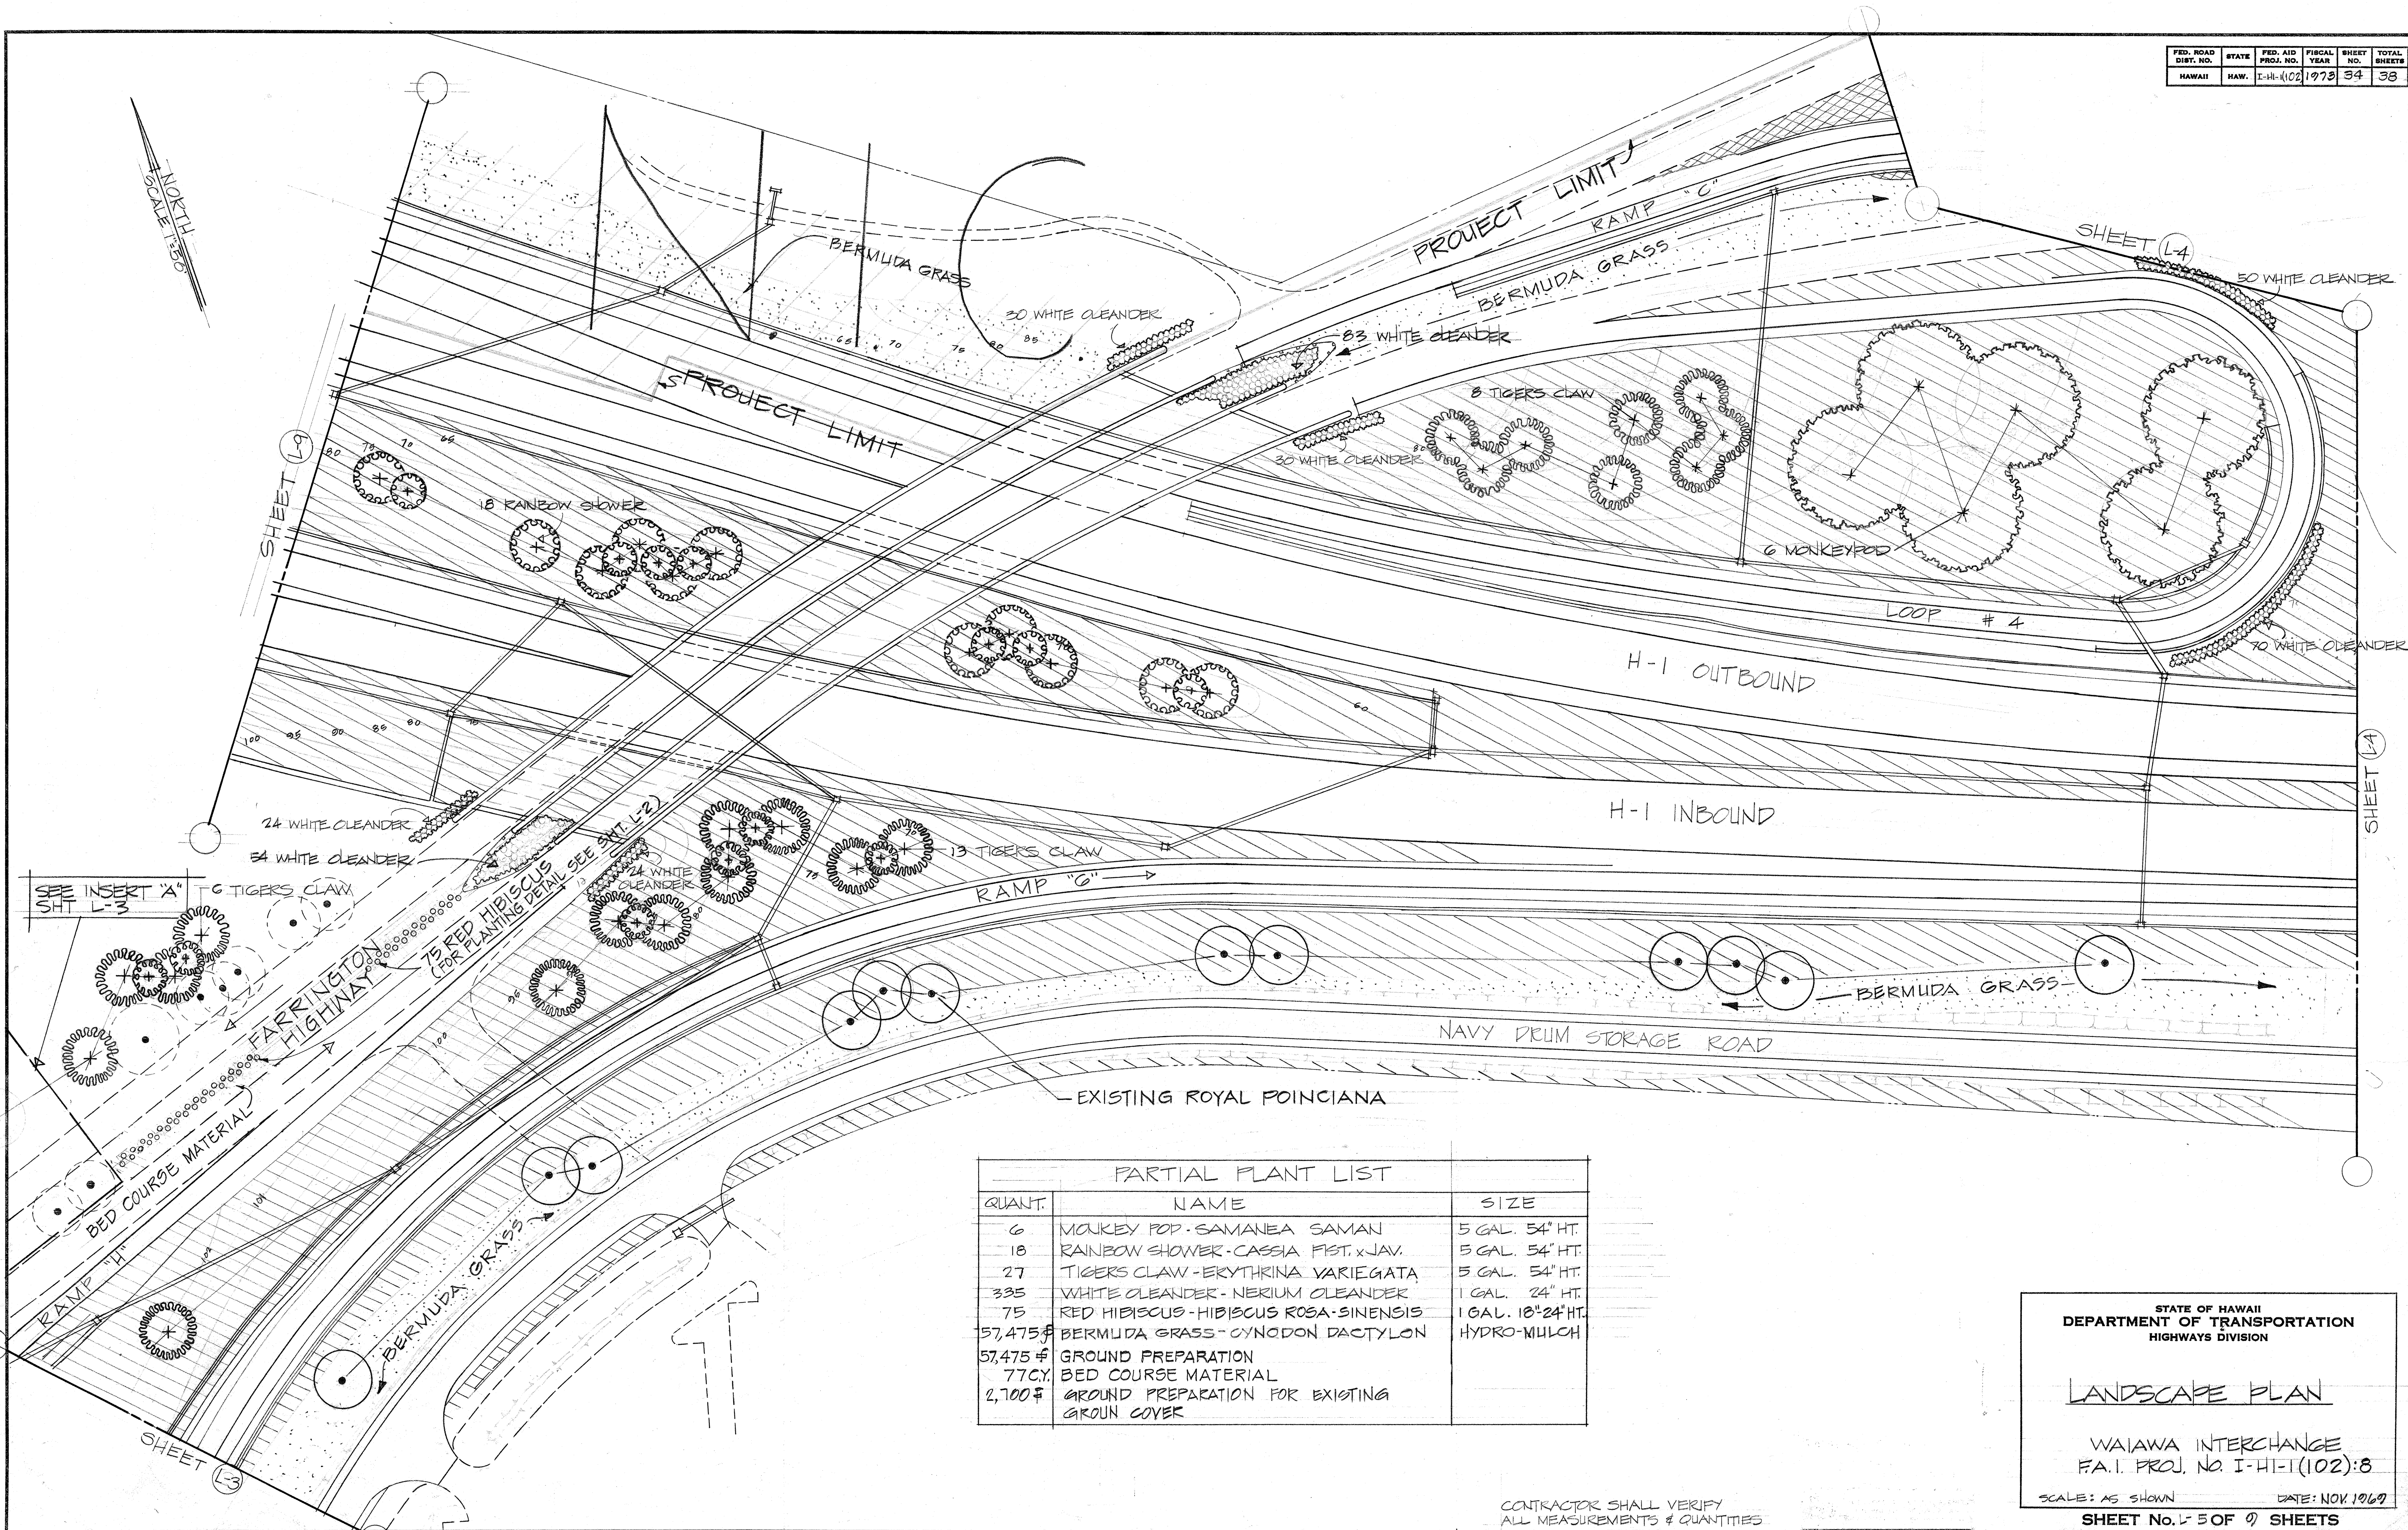

PARTIAL PLANT LIST		
QUANT.	NAME	SIZE
6	MONKEY POD - SAMANEA SAMAN	5 GAL. 54" HT.
18	RAINBOW SHOWER - CASSIA FIST. x JAV.	5 GAL. 54" HT.
27	TIGERS CLAW - ERYTHRA VARIEGATA	5 GAL. 54" HT.
335	WHITE OLEANDER - NERIUM OLEANDER	1 GAL. 24" HT.
75	RED HIBISCUS - HIBISCUS ROSA-SINENSIS	1 GAL. 18" 24" HT.
57,475	BERMUDA GRASS - CYNODON DACTYLON	HYDRO-MULCH
57,475	GROUND PREPARATION	
77CY	BED COURSE MATERIAL	
2,100	GROUND PREPARATION FOR EXISTING GROUND COVER	

STATE OF HAWAII
DEPARTMENT OF TRANSPORTATION
HIGHWAYS DIVISION



LANDSCAPE PLAN

WAIAWA INTERCHANGE
F.A.I. PROJ. NO. I-H-102:8

SCALE: AS SHOWN DATE: NOV. 1969

SHEET No. 15 OF 17 SHEETS

CONTRACTOR SHALL VERIFY ALL MEASUREMENTS & QUANTITIES

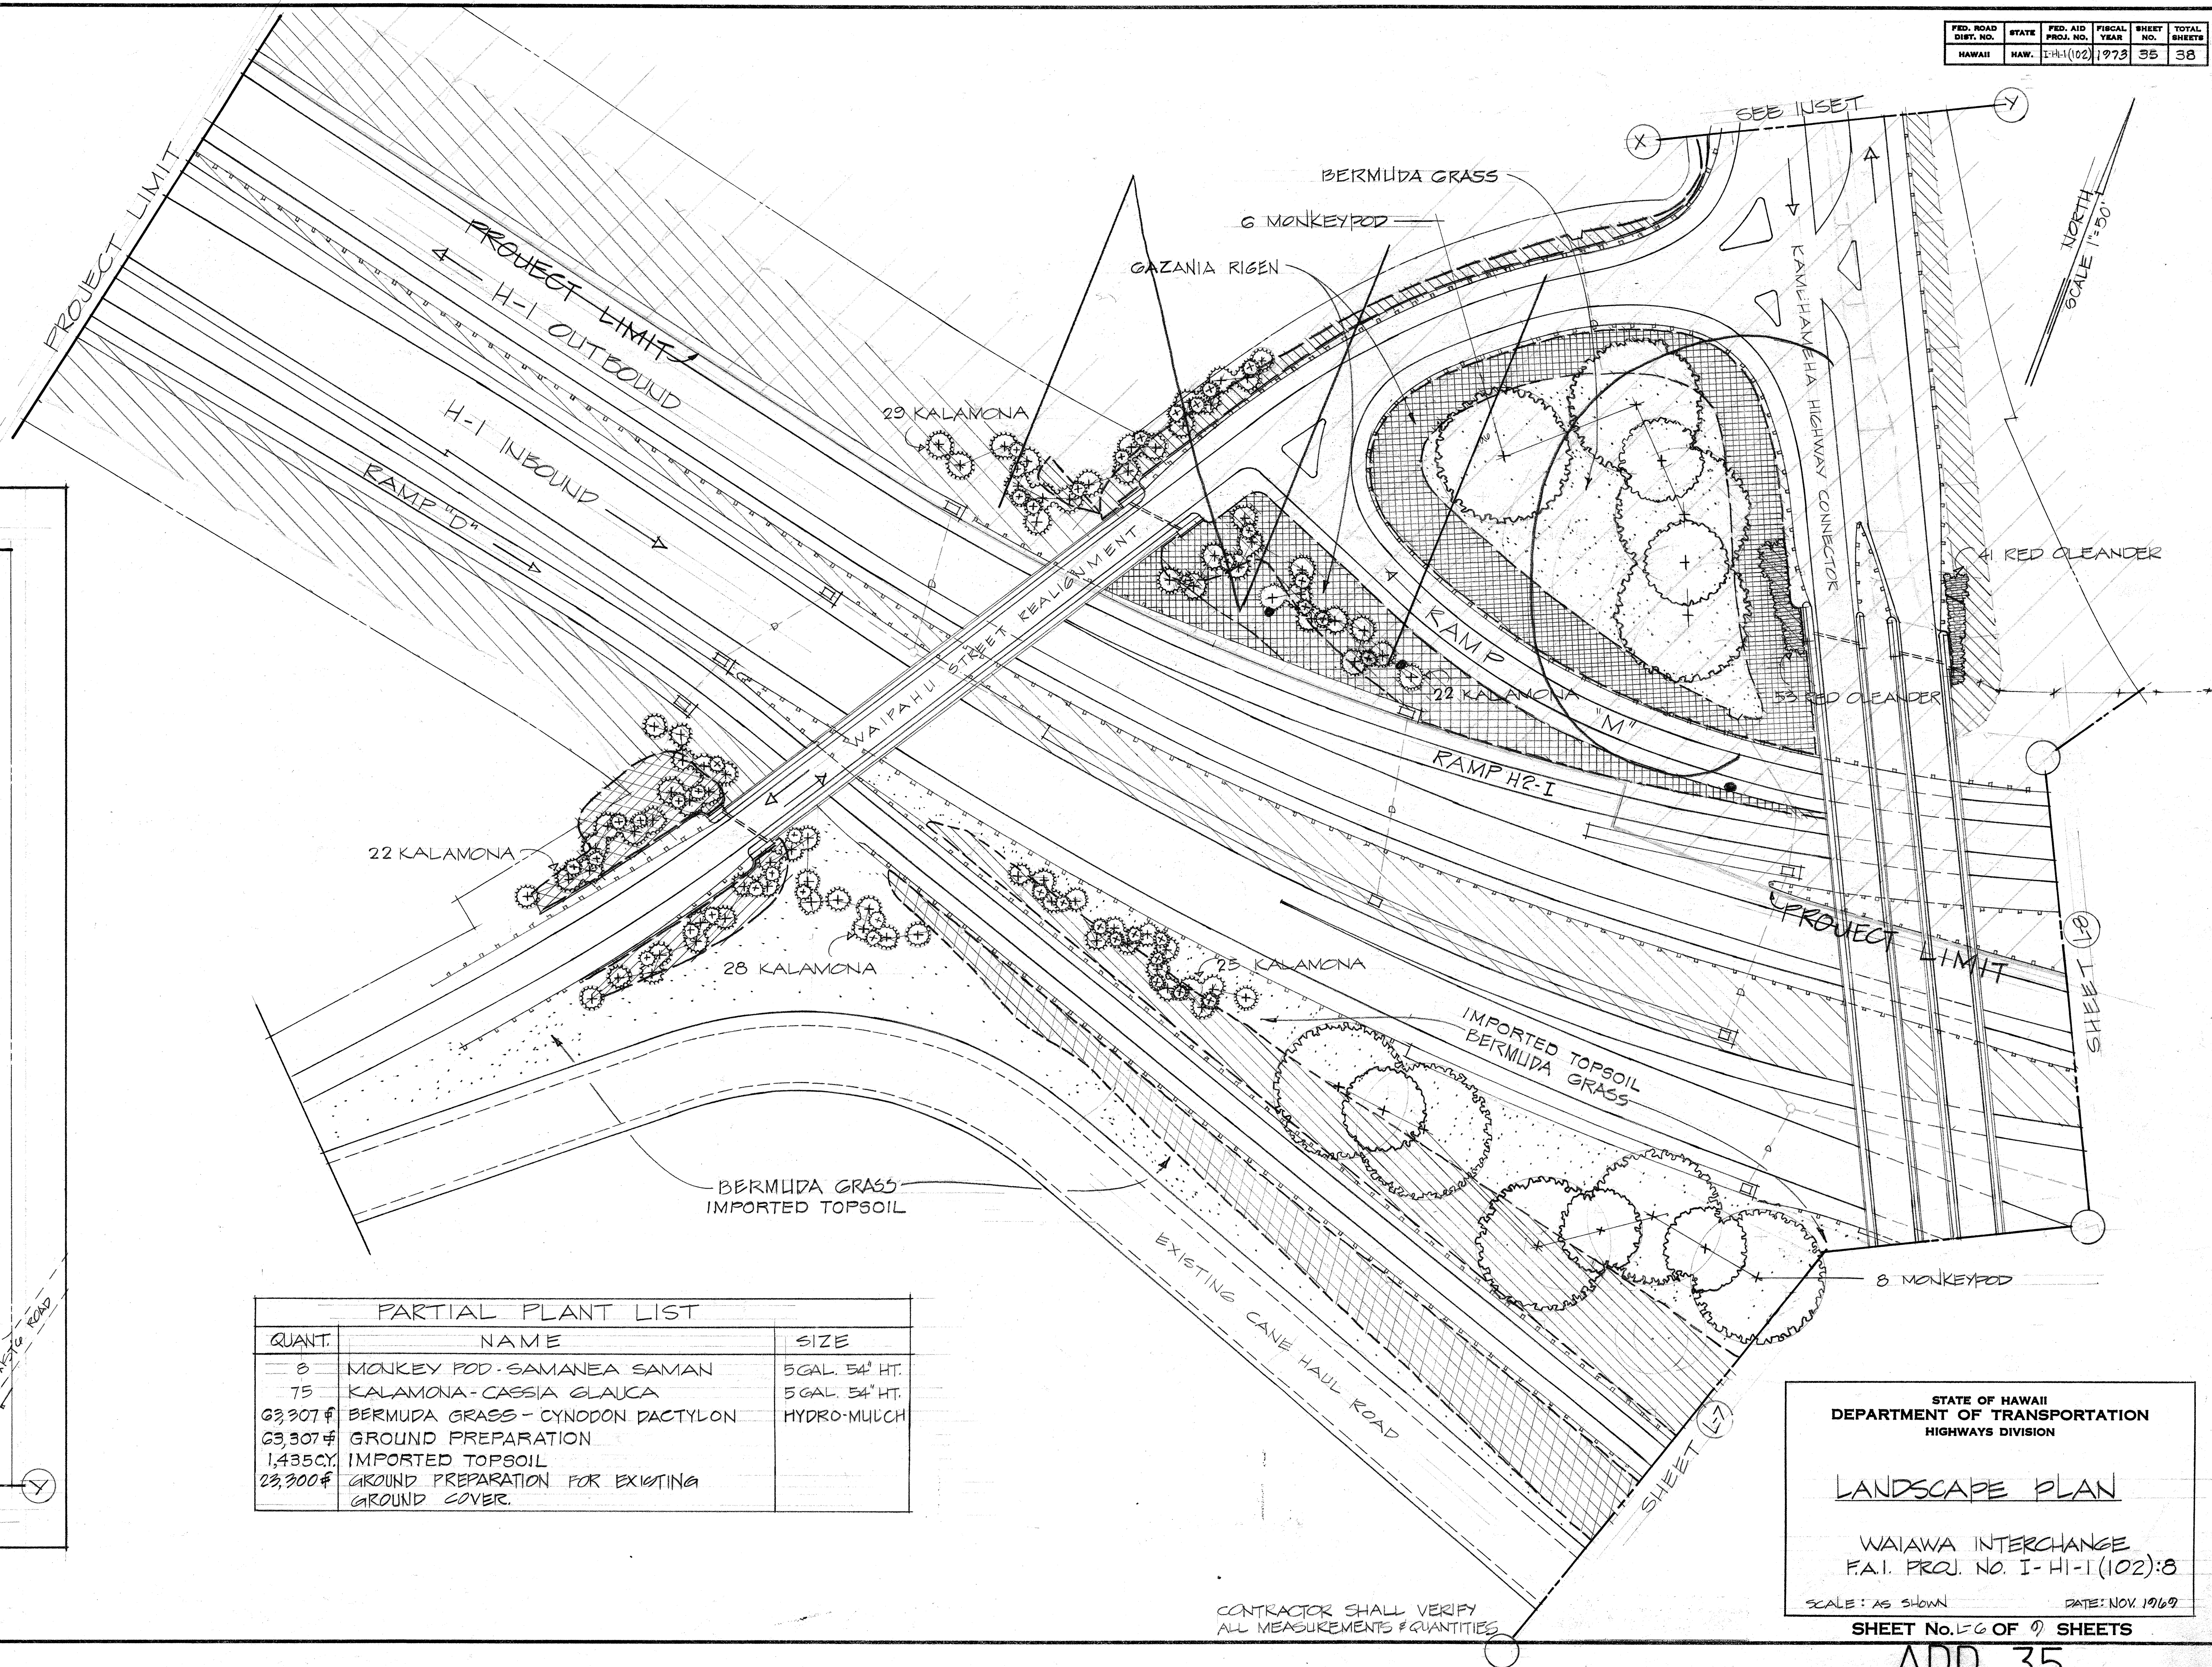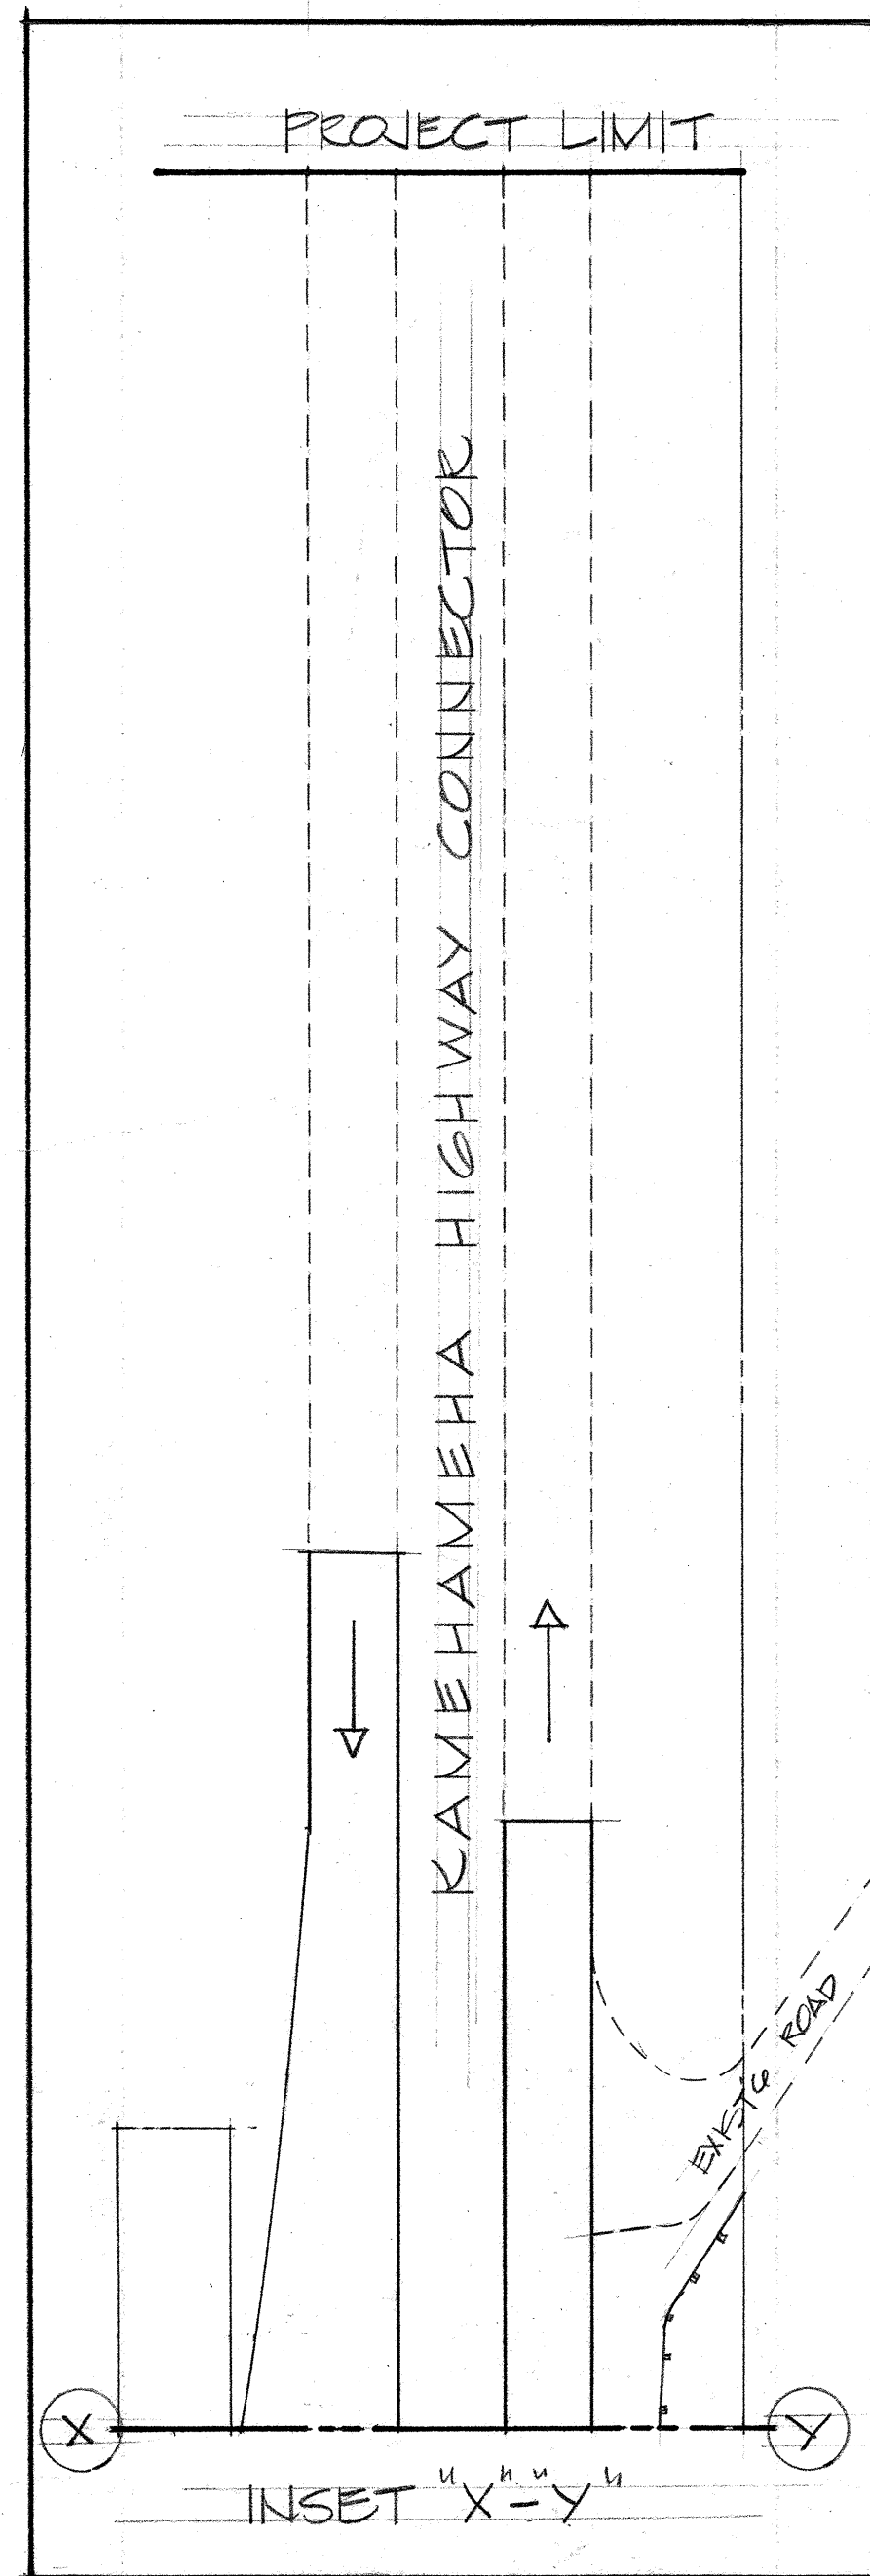

PARTIAL PLANT LIST		
QUANT.	NAME	SIZE
8	MONKEY POD - SAMANEA SAMAN	5 GAL. 54" HT.
75	KALAMONA - CASSIA GLAUCA	5 GAL. 54" HT.
63,307 #	BERMUDA GRASS - CYNODON DACTYLON	HYDRO-MULCH
63,307 #	GROUND PREPARATION	
1,435 CY.	IMPORTED TOPSOIL	
23,300 #	GROUND PREPARATION FOR EXISTING GROUND COVER.	

STATE OF HAWAII
DEPARTMENT OF TRANSPORTATION
HIGHWAYS DIVISION

LANDSCAPE PLAN

WAIAWA INTERCHANGE
F.A.I. PROJ. NO. I-HI-1(102):8

SCALE: AS SHOWN DATE: NOV. 1969

SHEET No. 156 OF 9 SHEETS

CONTRACTOR SHALL VERIFY ALL MEASUREMENTS & QUANTITIES



PARTIAL PLANT LIST		
QUANT.	NAME	SIZE
8	MONKEY POD - SAMANEA SAMAN	5 GAL. 54" HT.
39	GOLD TREE - TAPSCOTTIA DONNELL SMITHII	5 GAL. 54" HT.
38	CHINESE BANYAN - FICUS RETUSA	5 GAL. 54" HT.
29	BESTILL - THEVETIA PERUVIANA	1 GAL. 24" HT.
100,600 #	BERMUDA GRASS - CYNODON DACTYLON	HYDRO-MULCH
100,600 #	GROUND PREPARATION	
44,900 #	GROUND PREPARATION FOR EXISTING GROUND COVER	

NORTH
SCALE 1"=50'

CONTRACTOR SHALL VERIFY
ALL MEASUREMENTS & QUANTITIES


STATE OF HAWAII
DEPARTMENT OF TRANSPORTATION
HIGHWAYS DIVISION

LANDSCAPE PLAN

WAIAWA INTERCHANGE
F.A.I. PROJ. NO. I-HI-L(102):8

SCALE: AS SHOWN
DATE: NOV. 1969

SHEET No. 6 OF 7 SHEETS

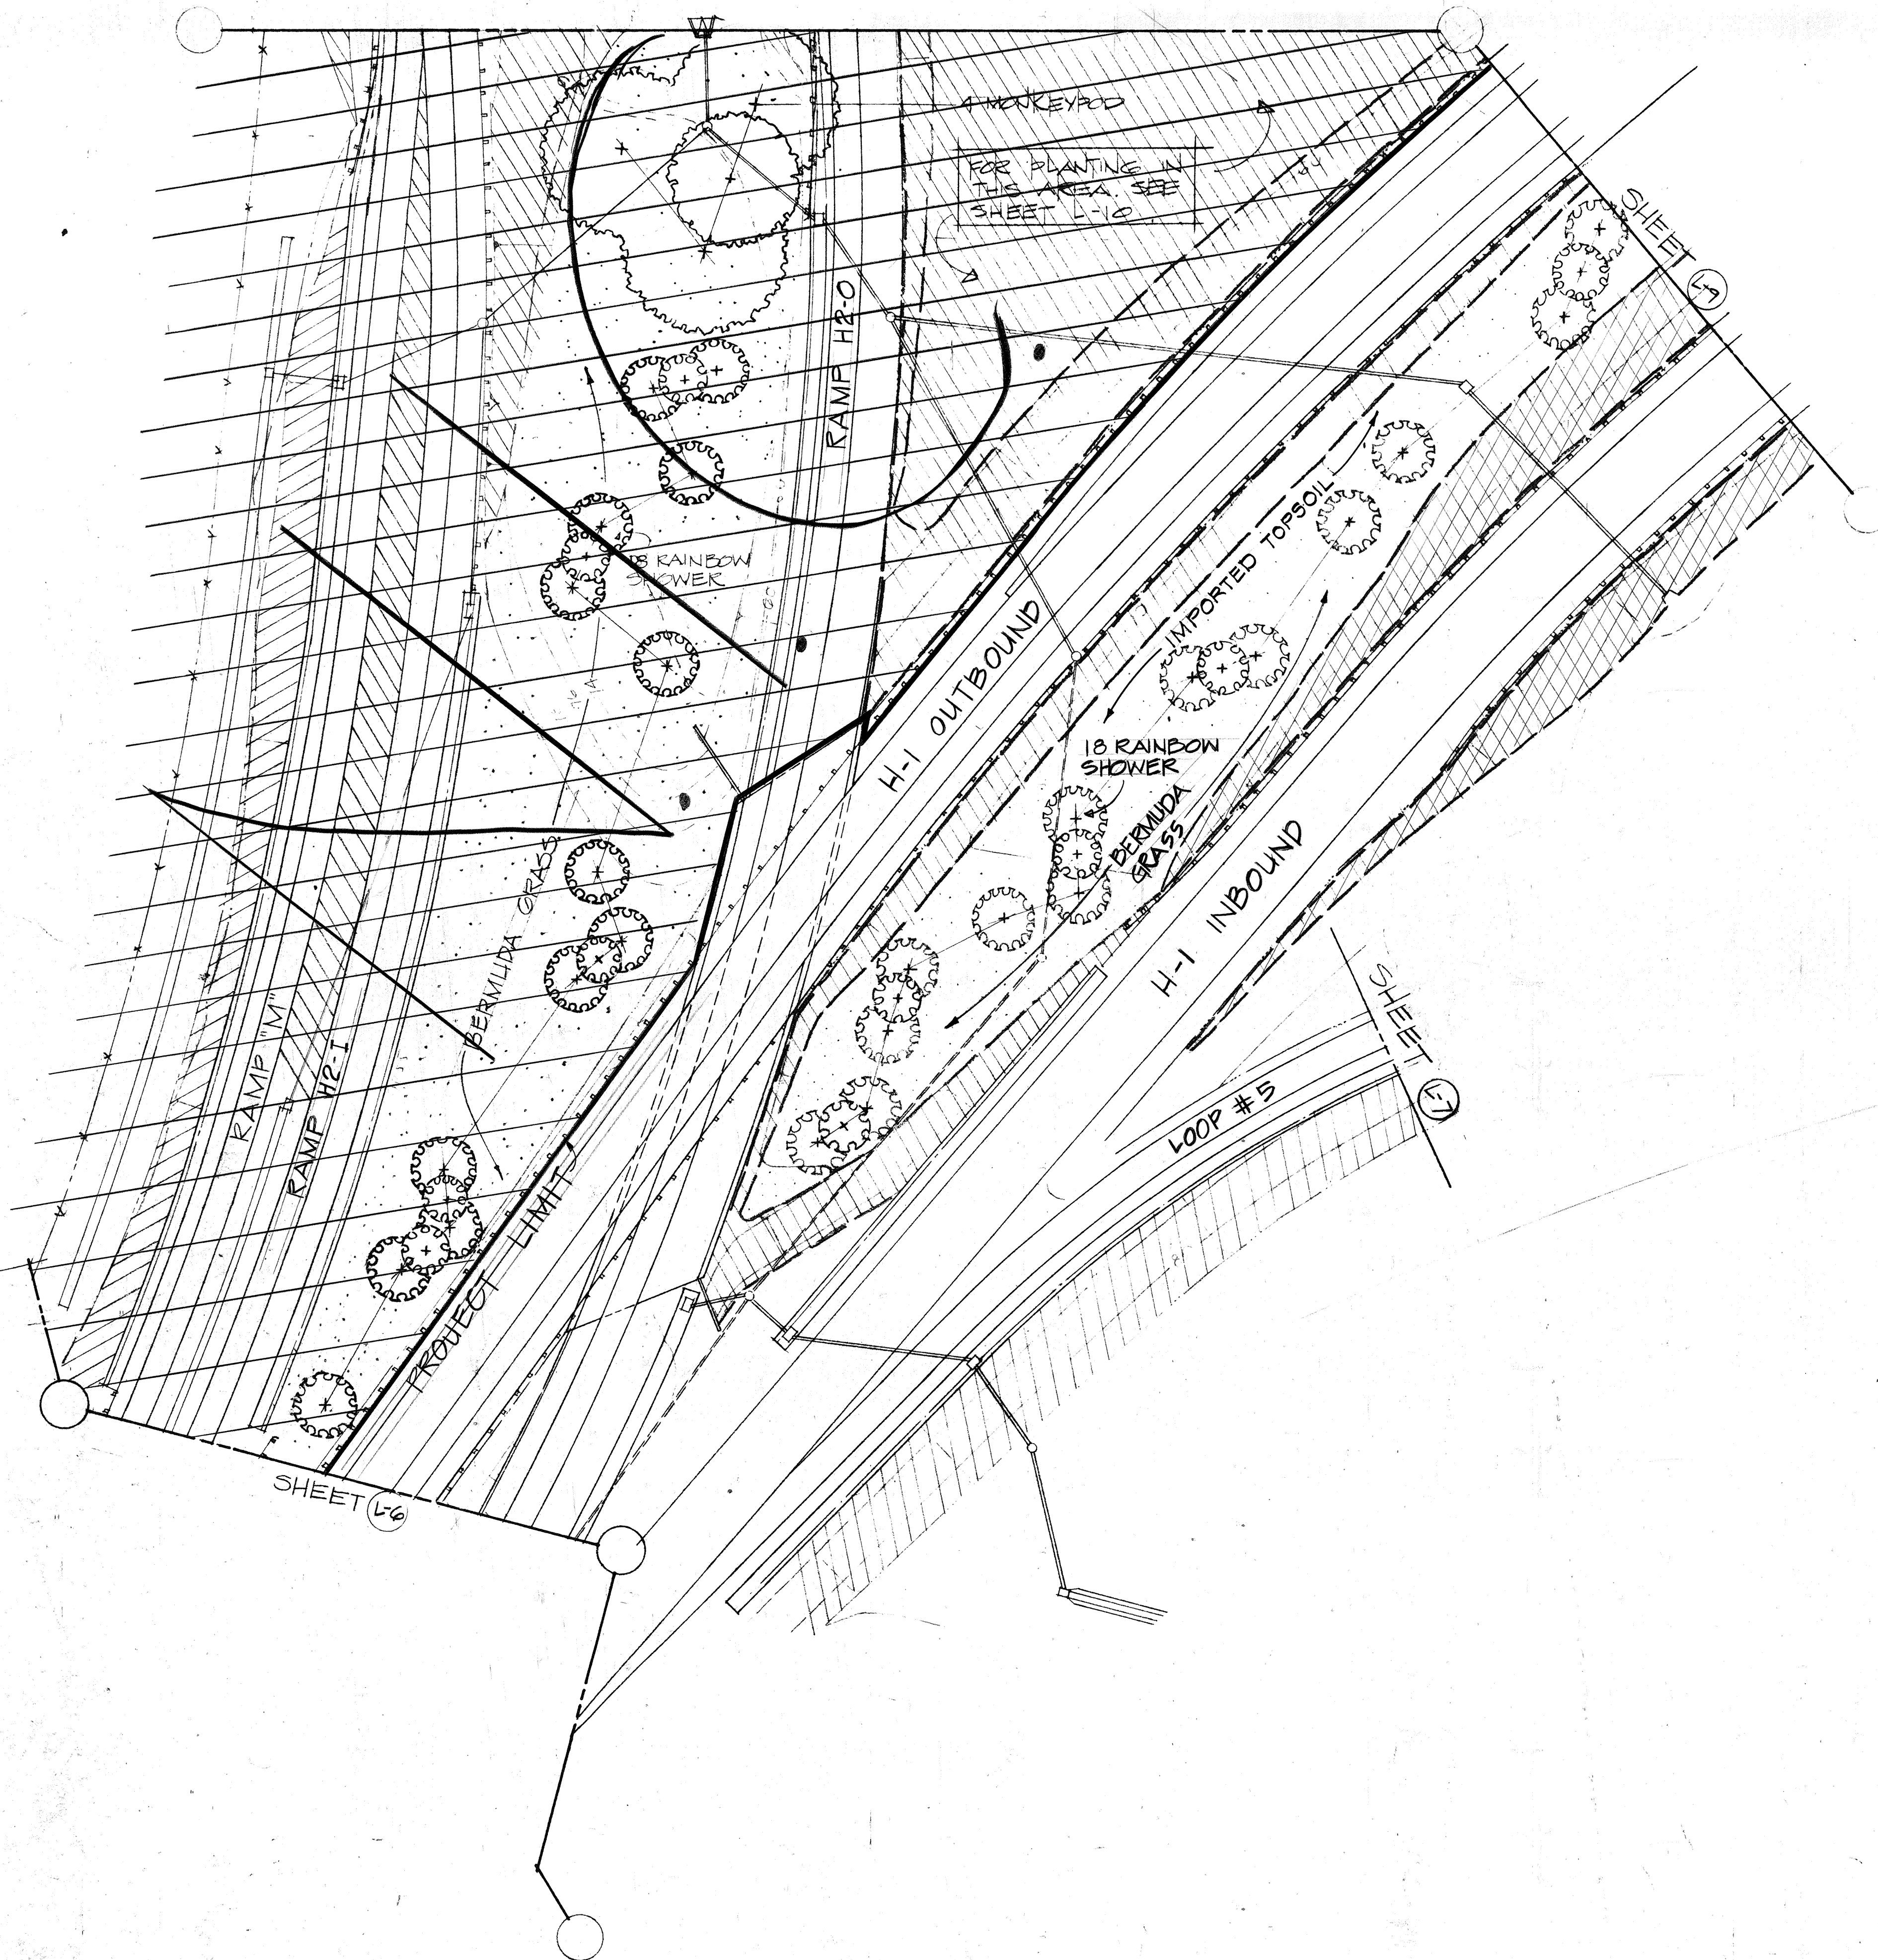

PARTIAL PLANT LIST		
QUANT.	NAME	SIZE
18	RAINBOW SHOWER - CASSIA FIST. x JAV.	5 GAL. 54" HT.
44,825 #	BERMUDA GRASS - CYNODON DACTYLON	HYDRO-MULCH
44,825 #	GROUND PREPARATION	
722 C.Y.	IMPORTED TOPSOIL	
19,115 #	GROUND PREPARATION FOR EXISTING GROUND COVER	

CONTRACTOR SHALL VERIFY
ALL MEASUREMENTS & QUANTITIES

STATE OF HAWAII
DEPARTMENT OF TRANSPORTATION
HIGHWAYS DIVISION

LANDSCAPE PLAN

WAIAWA INTERCHANGE
F.A.I. PROJ. NO. I-41-1(102):8

SCALE: AS SHOWN DATE: NOV. 1969

SHEET No. L-8 OF 9 SHEETS

ADD. 37

ORIGINAL	DATE
PLAN	
DESIGNED BY	
NOTED BY	
CHECKED BY	
DATE	

