




FED. ROAD DIST. NO.	STATE	FED. AID PROJ. NO.	FISCAL YEAR	SHEET NO.	TOTAL SHEETS
HAWAII	HAW.	I-HI-1(102)8	1973	14	38

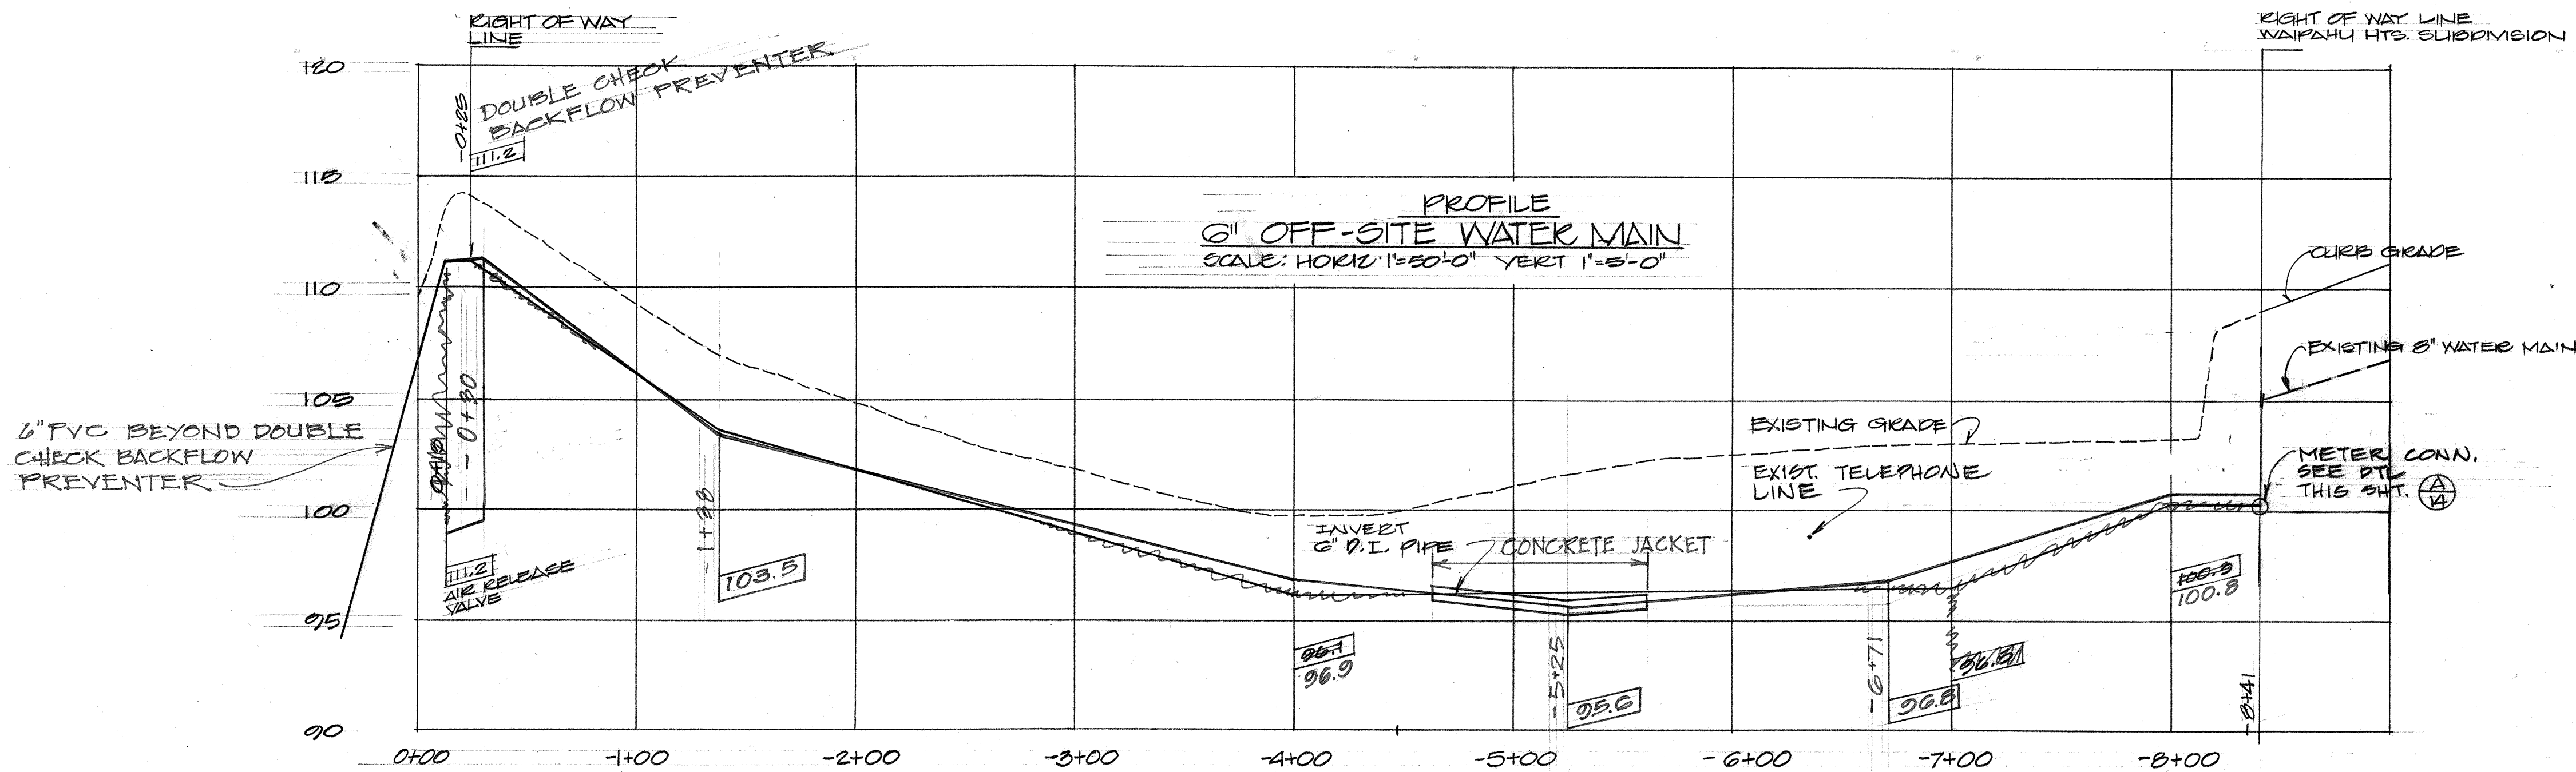

NOTE: SEWER (12" V.C.)
CROSSING @ 4+48. SEWER
INVERT 82.31.

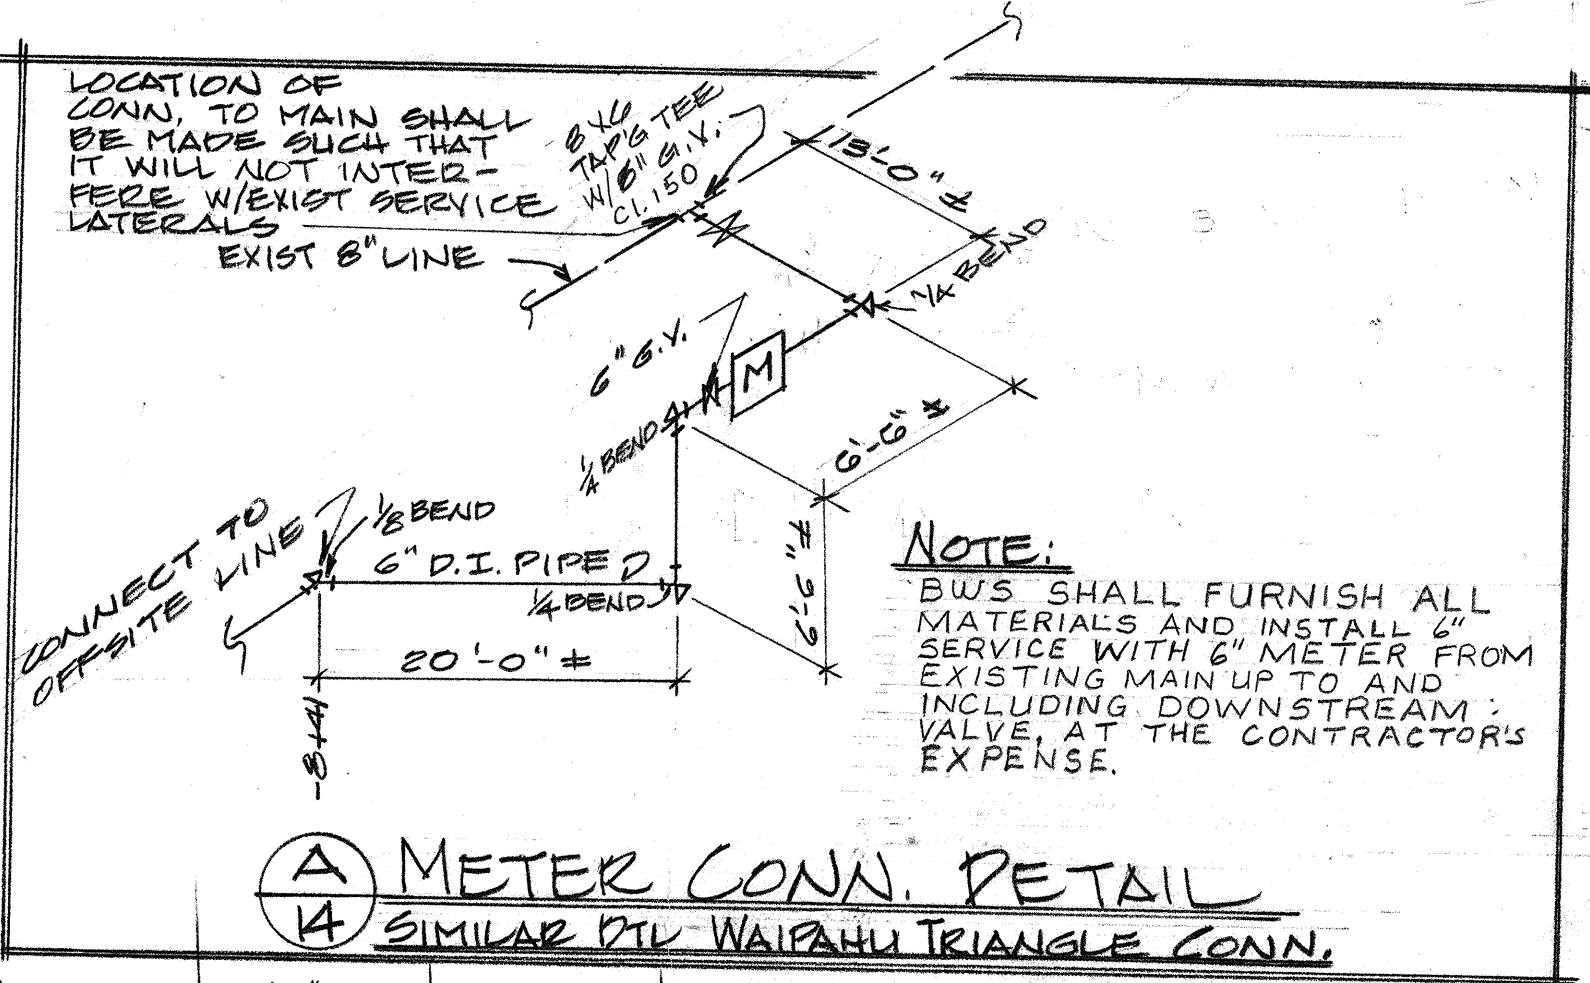

- STA. -8+74
1-8"x6" TAPPING TEE
W/6" GATE VALVE CL. 150
1- VALVE BOX
2- CONC. BLK.
1-6" 1/4 BEND
18 L.F. 6" D.I. PIPE, 0.31" IN. THICK.

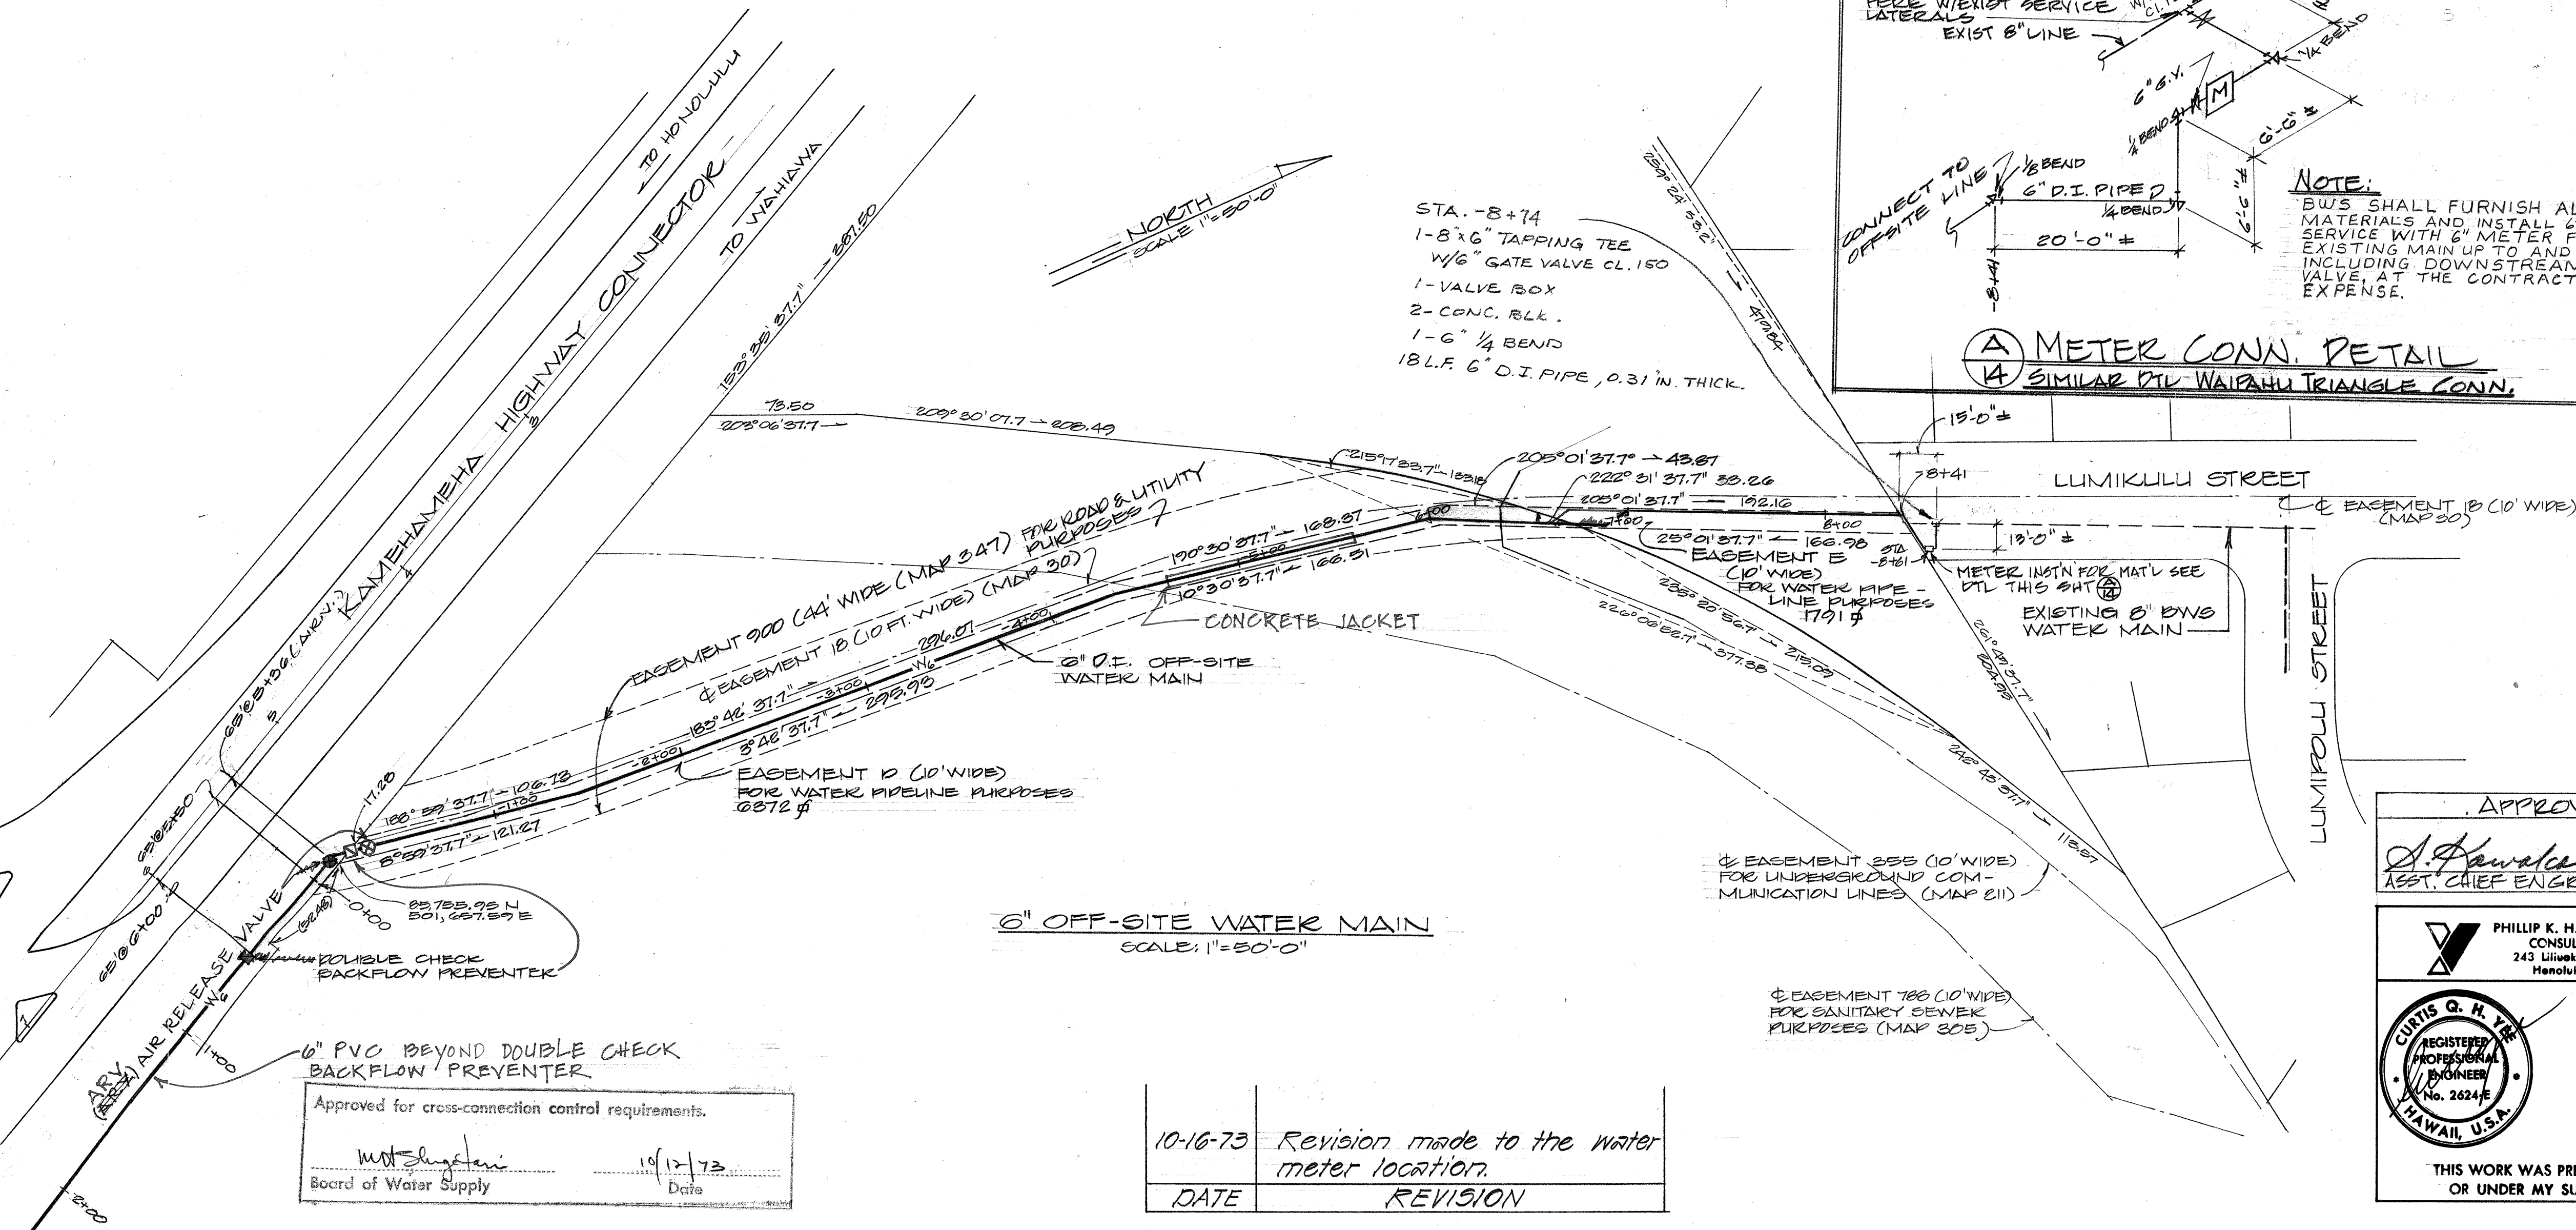

APPROVED
[Signature] 10/14/73
ASST. CHIEF ENGR. - BWS

PHILLIP K. H. YEE & ASSOCIATES
CONSULTING ENGINEERS
243 Liliuokalani Ave., Rm. 101
Honolulu, Hawaii 96815

CURTIS Q. H. YEE
REGISTERED PROFESSIONAL ENGINEER
No. 2624/E
HAWAII, U.S.A.

THIS WORK WAS PREPARED BY ME
OR UNDER MY SUPERVISION.

STATE OF HAWAII
DEPARTMENT OF TRANSPORTATION
HIGHWAYS DIVISION

WAI'AWA INTERCHANGE
WATER SPRINKLER SYSTEM
PROJ # I-HI-1(102)8

6" OFF-SITE
WATER MAIN