



FED. ROAD DIST. NO.	STATE	FED. AID PROJ. NO.	FISCAL YEAR	SHEET NO.	TOTAL SHEETS
HAWAII	HAW.	I-HI-1(102)B	1973	11	38

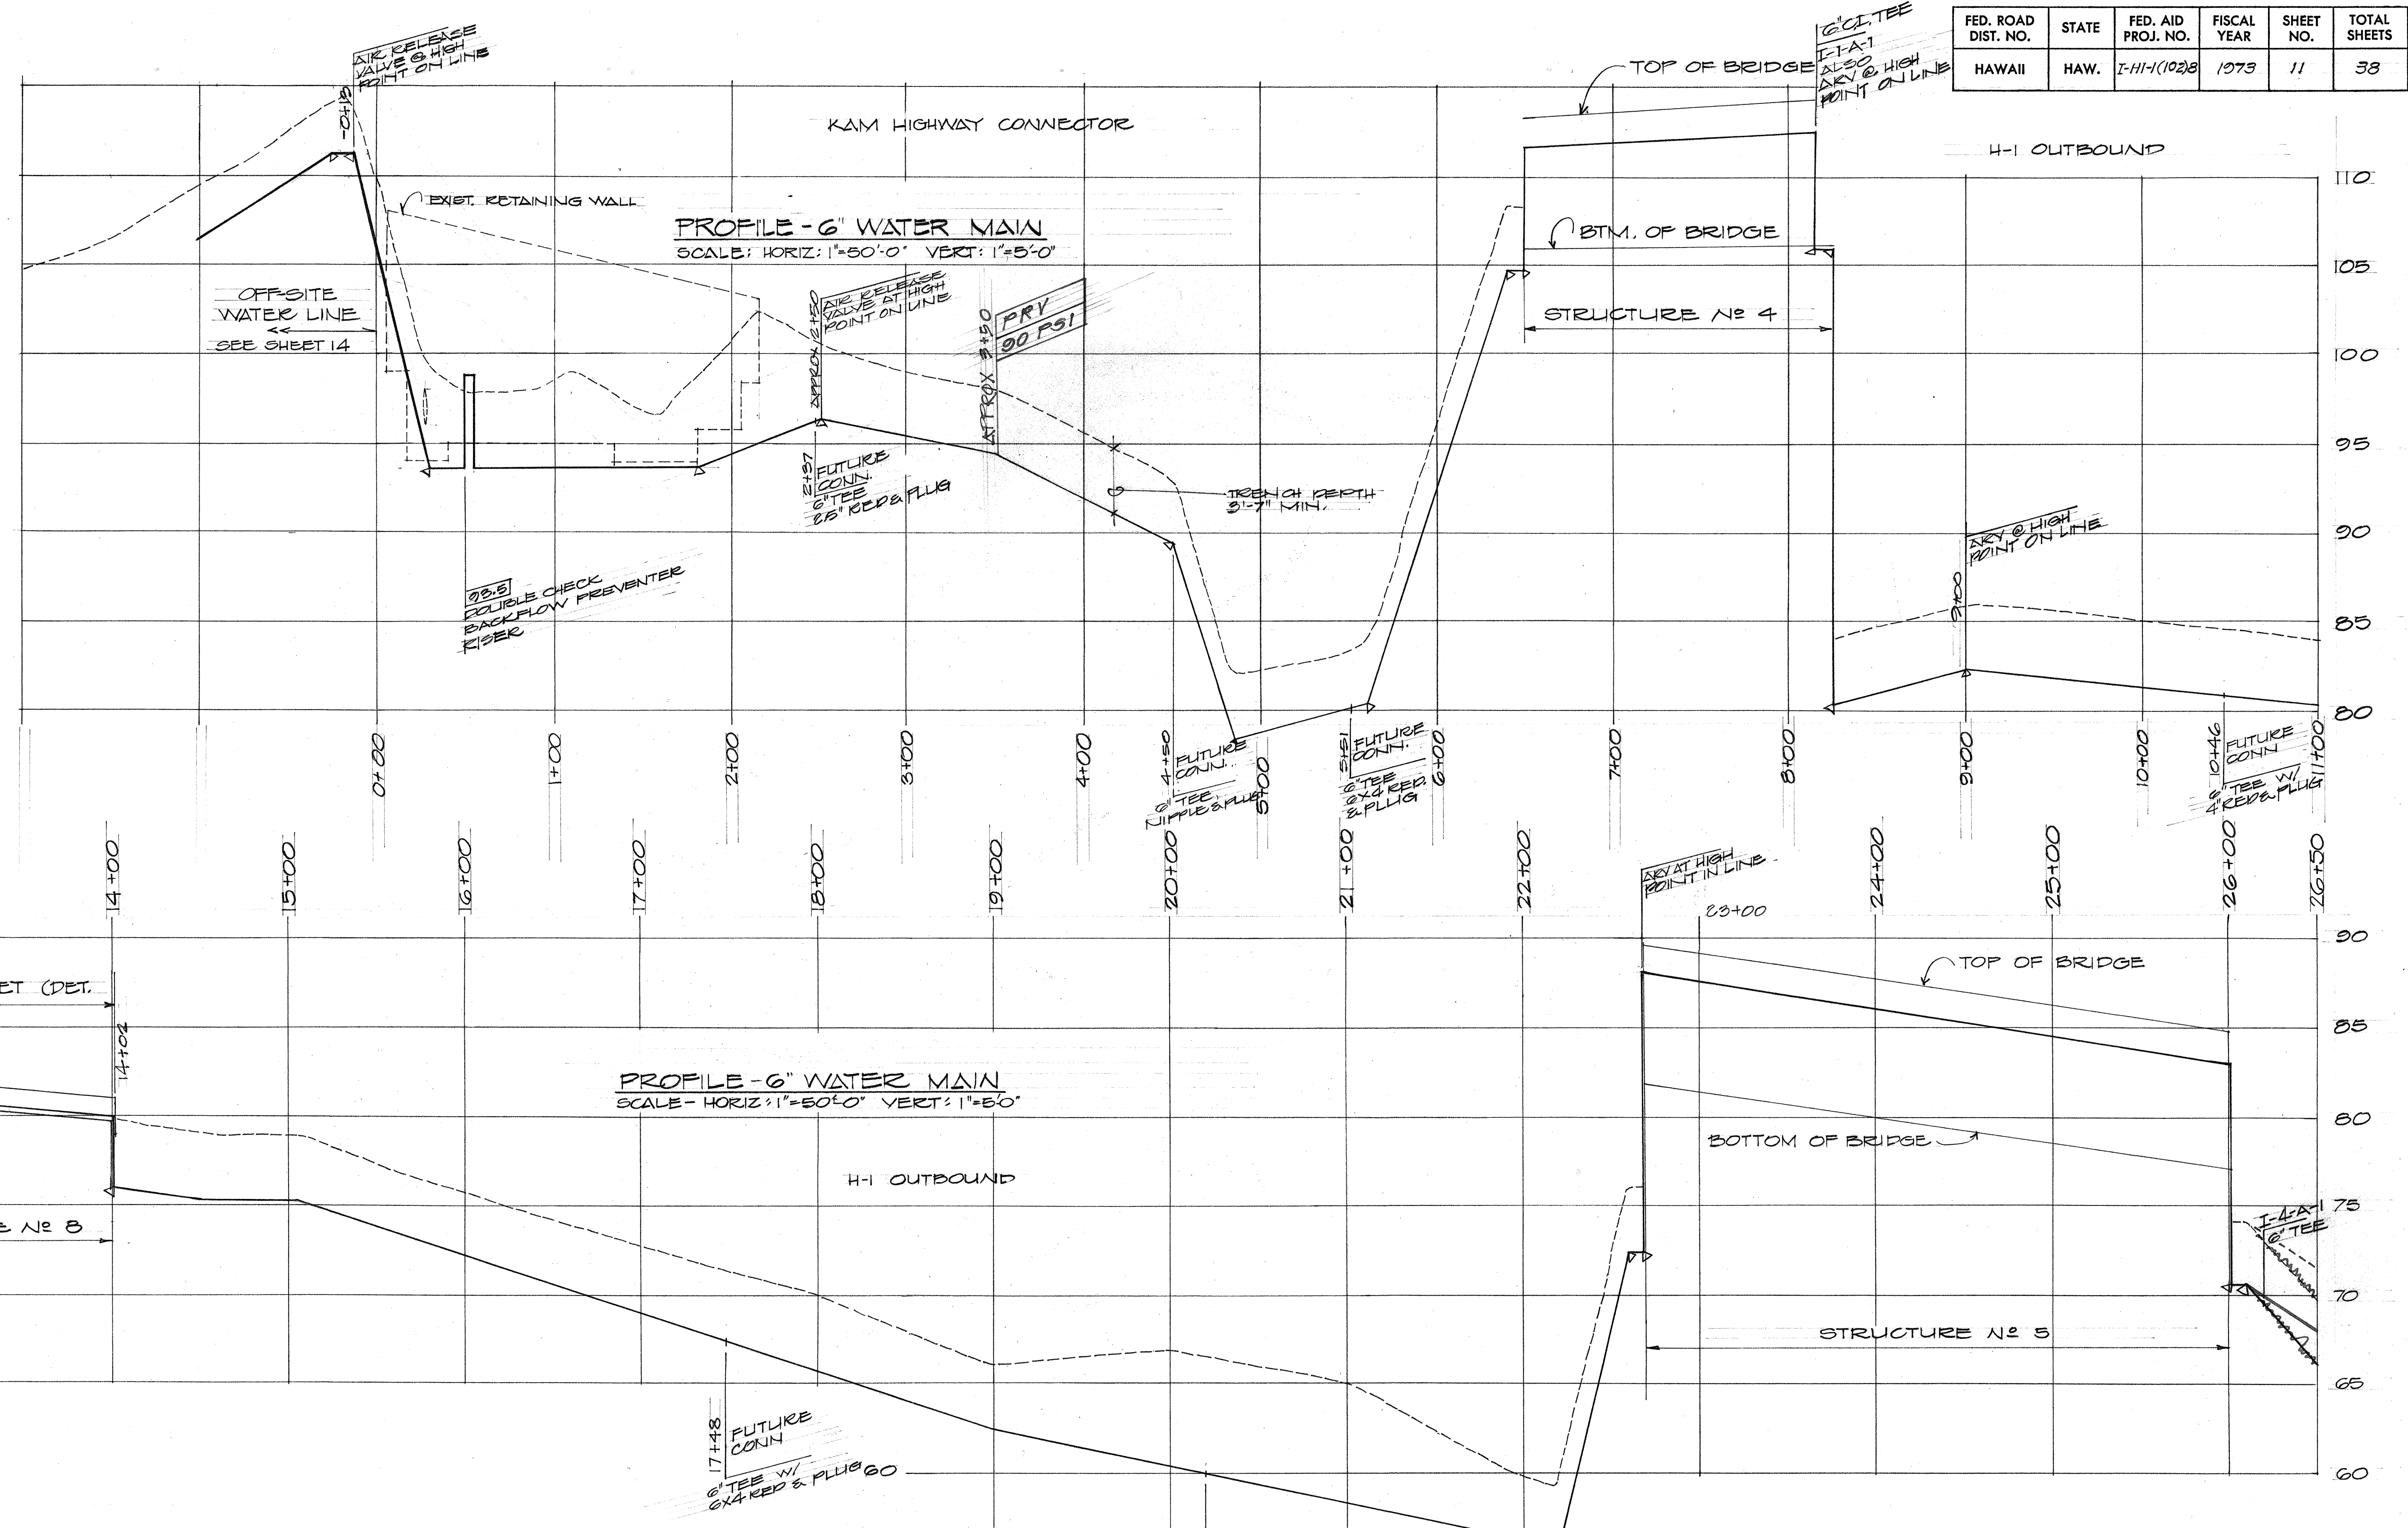

LEGEND

- EXIST GRADE
- INVERT - NEW 6" PIPE
- ▴ CONG. REACTION BLOCK
- ▴ CONG. STRAP TYPE REAC. BLK.

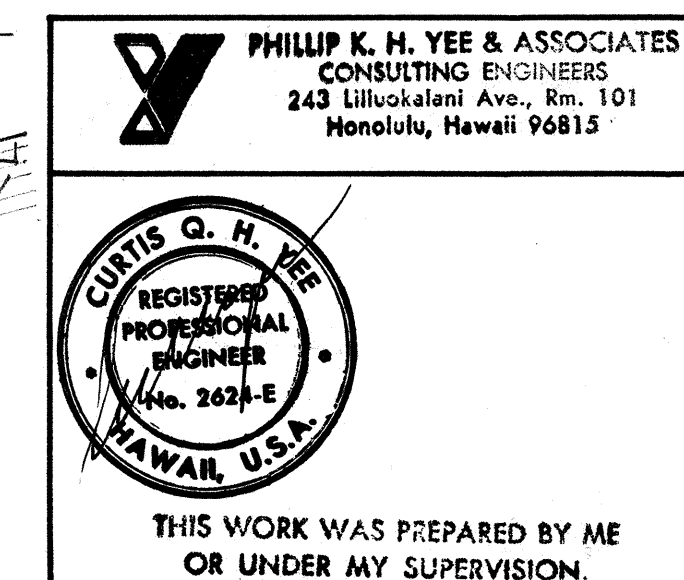

STATE OF HAWAII
DEPARTMENT OF TRANSPORTATION
HIGHWAYS DIVISION


WAIAWA INTERCHANGE
WATER SPRINKLER SYSTEM
PROJ # I-HI-1(102)B

**PROFILE -
6" WATER MAIN
LINE 'A'**

SHEET No. 11 OF 29 SHEETS

ORIGINAL PLAN	DATE
SURVEY PLOTTED BY	
DESIGNED BY	
NOTED BY	
CHECKED BY	

FED. ROAD DIST. NO.	STATE	FED. AID PROJ. NO.	FISCAL YEAR	SHEET NO.	TOTAL SHEETS
HAWAII	HAW.	I-H-1(102)8	1973	12	38

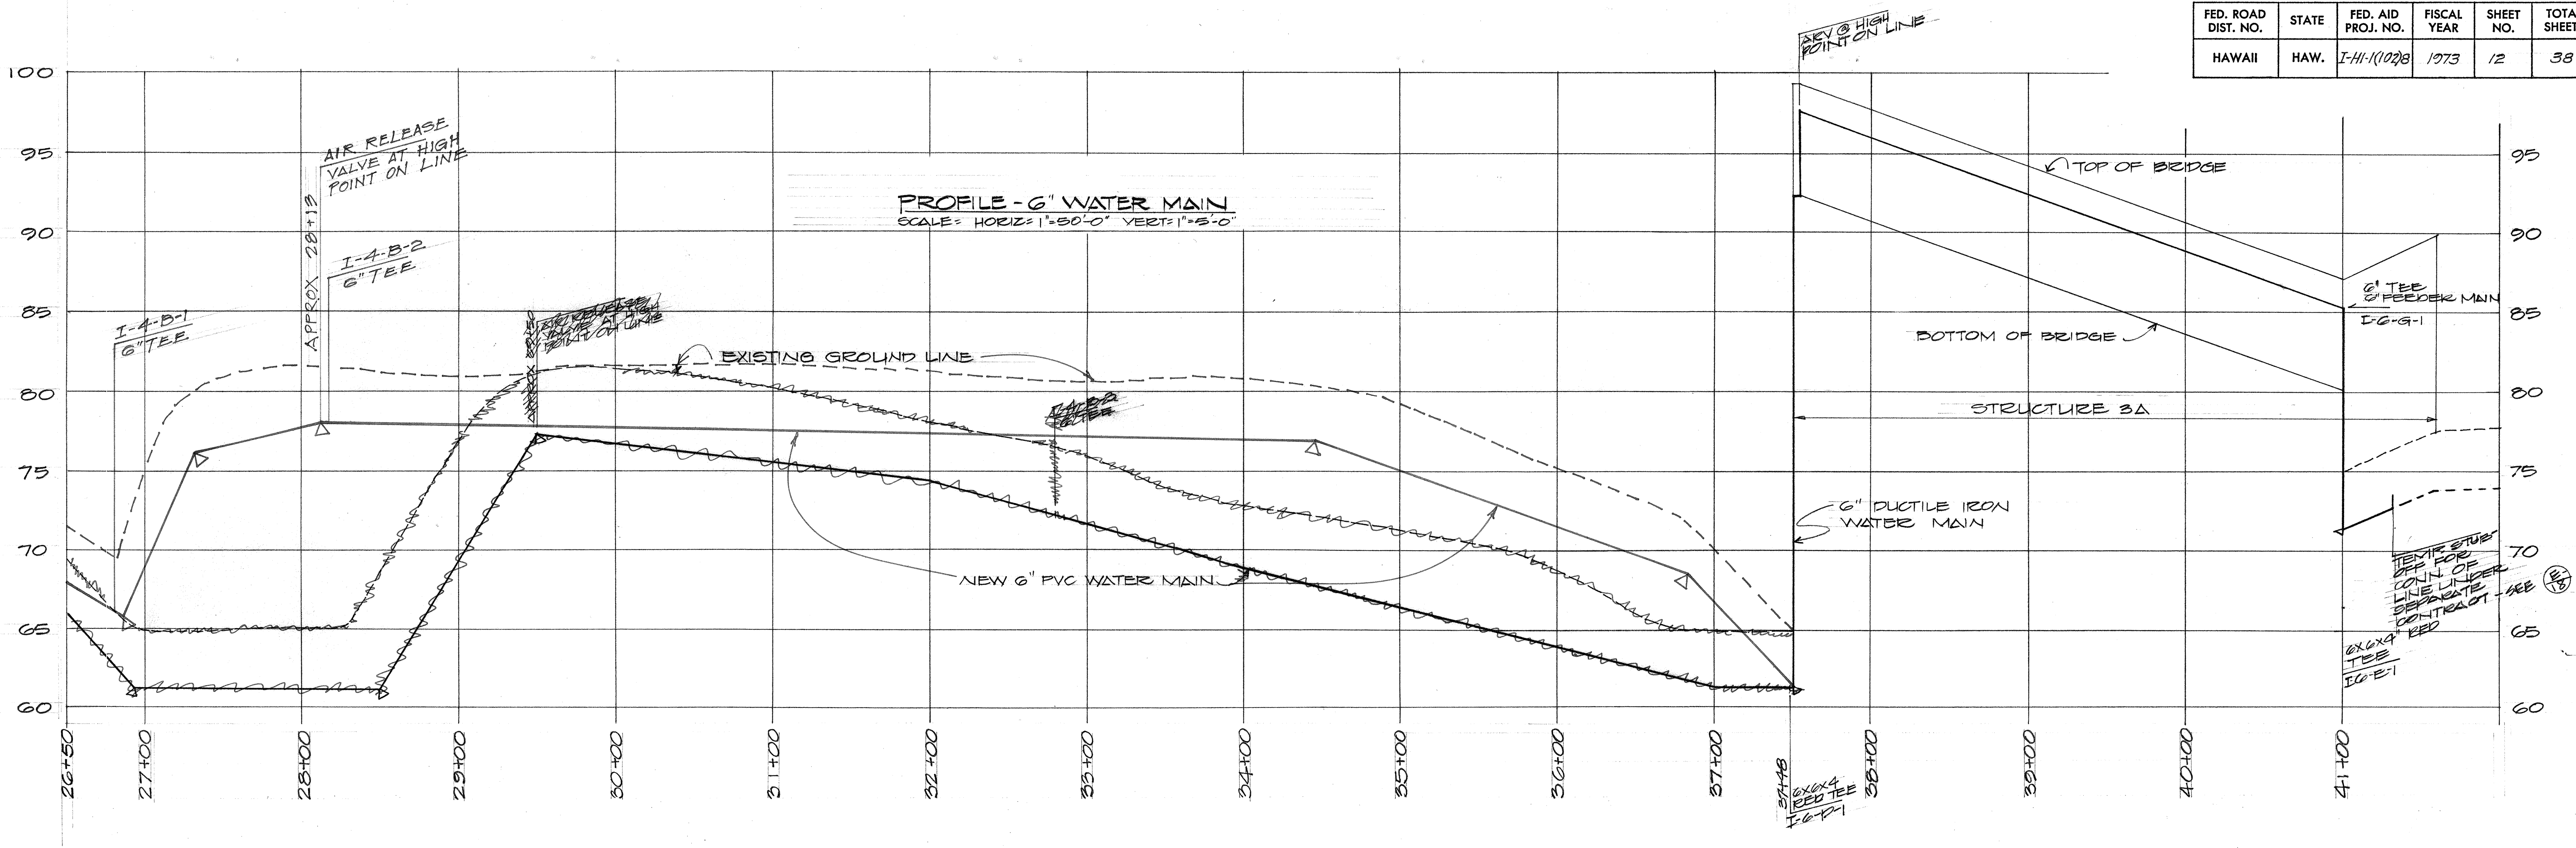


NOTE: AS BUILT PROFILE OF LINE A BETWEEN STA. 26+00 & STA. 37+48 NOT EXACTLY AS SHOWN.

ORIGINAL PLAN	DATE
NOTED BY	DESIGNED BY
QUANTITIES BY	CHECKED BY
NO.	



PHILIP K. H. YEE & ASSOCIATES
CONSULTING ENGINEERS
243 Ulukoulani Ave., Rm. 101
Honolulu, Hawaii 96815

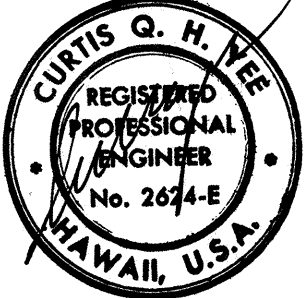

THIS WORK WAS PREPARED BY ME OR UNDER MY SUPERVISION.

STATE OF HAWAII

DEPARTMENT OF TRANSPORTATION

HIGHWAYS DIVISION

WAIAWA INTERCHANGE

WATER SPRINKLER SYSTEM

PROJ # I-H-1(102)8


PROFILE -

6" WATER MAIN


LINE "A"

SHEET No. 12 OF 38 SHEETS

FED. ROAD DIST. NO.	STATE	FED. AID PROJ. NO.	FISCAL YEAR	SHEET NO.	TOTAL SHEETS
HAWAII	HAW.	HA-11(102)B	1973	13	38

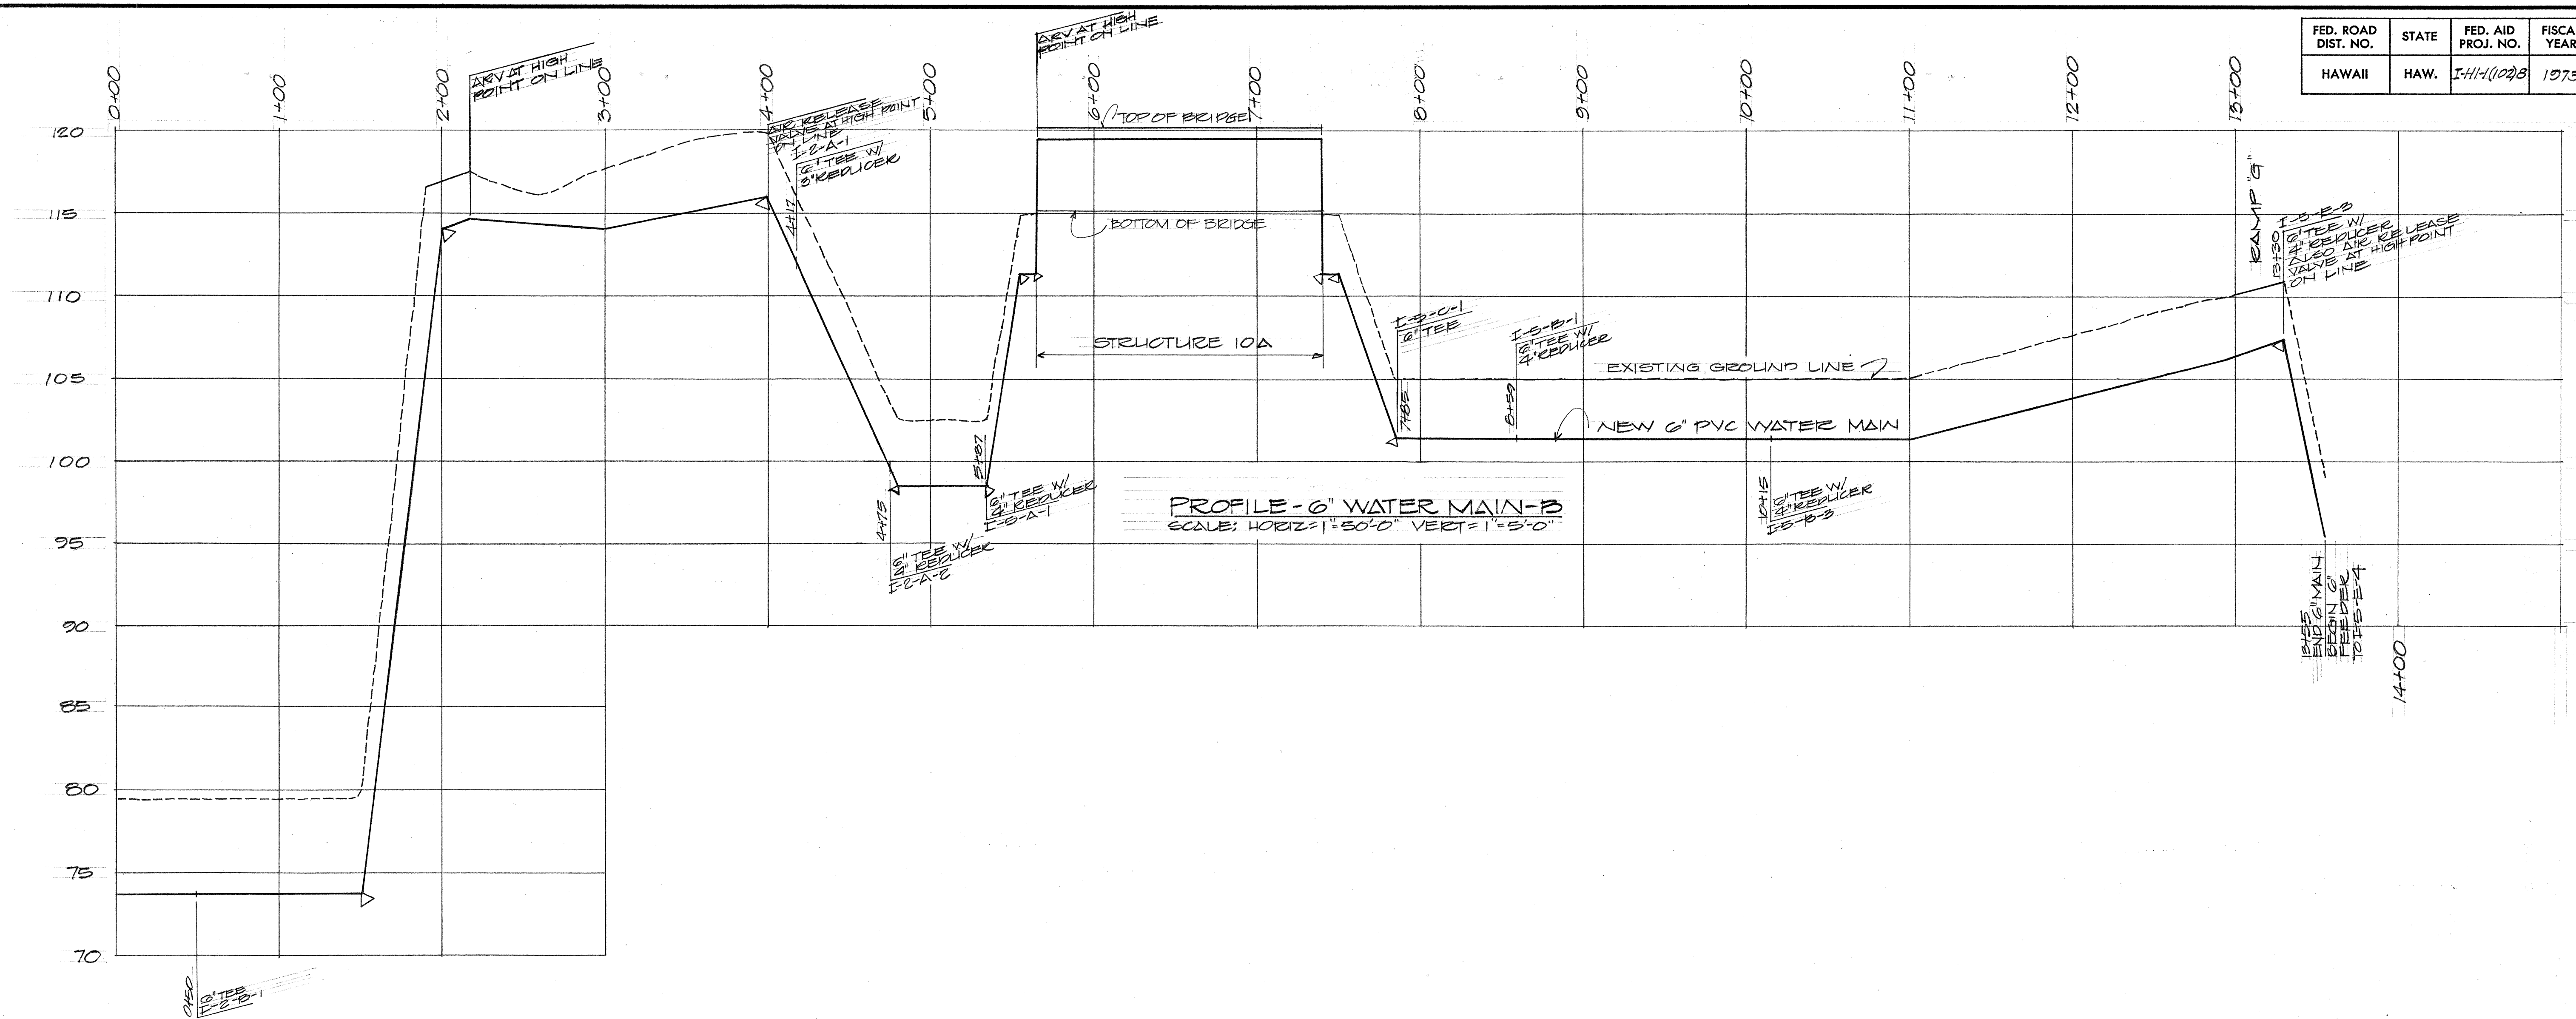

ORIGINAL PLAN	SURVEY PLOTTED BY _____	DATE _____
NOTE BOOK	DRAWN BY <u>SB</u>	" "
	TRACED BY _____	" "
	DESIGNED BY _____	" "
	QUANTITIES BY _____	" "
No. _____	CHECKED BY _____	" "

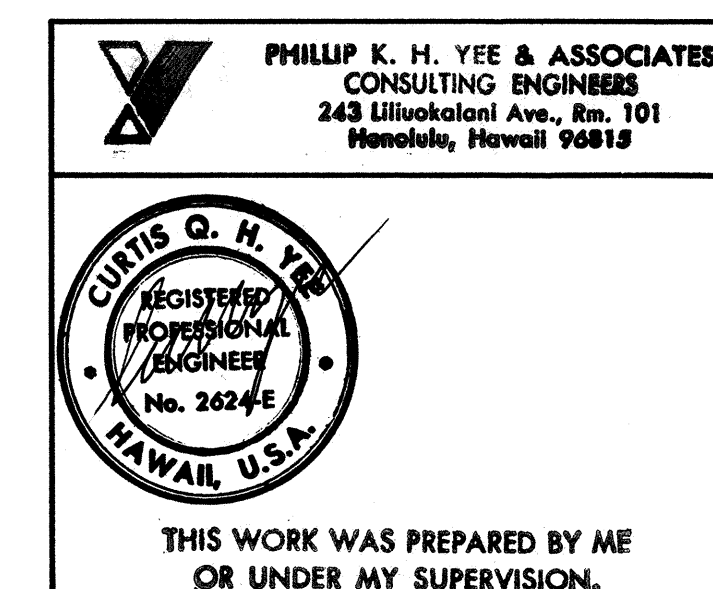

**STATE OF HAWAII
DEPARTMENT OF TRANSPORTATION
HIGHWAYS DIVISION**

WAIAWA INTERCHANGE

WATER SPRINKLER SYSTEM
PROJ # I-HI-1(02):8

PROFILE
6" WATER MAIN
LINE "B"

SHEET No. 13 OF 29 SHEETS