IN	DEX TO DRAWINGS
SHEET NO.	DESCRIPTION
Į.	TITLE SHEET
2	TYPICAL SECTIONS &
<b>9</b>	GENERAL NOTES
3	TRANSITION DETAILS
1	AT STRUCTURES
*4 - 8	ROADWAY PLANS
<sup>条米</sup> 9 - 17	PAVEMENT MARKING PLANS
1 2	



STATE OF HAWAII

DEPARTMENT OF TRANSPORTATION HIGHWAYS DIVISION

HONOLULU, HAWAII

PLANS FOR


FARRINGTON HIGHWAY RESURFACING VICINITY OF WAIPAHU DEPOT ST. TO KAMEHAMEHA HWY.

PROJECT NO. 90A-01-77M

DISTRICT OF EWA ISLAND OF OAHU

PLAN SHEET NOS. \*3R S-1 & \*\* C.O. 8S-1, C.O. 8S-2, C.O. 8S-3, 8R S-4, 8R S-5 ARE SUPPLEMENTARY SHEETS TO THIS PROJECT.

TOTAL SHEET COUNT AFTER "AS-BUILT" POSTINGS: 23 SHEETS.

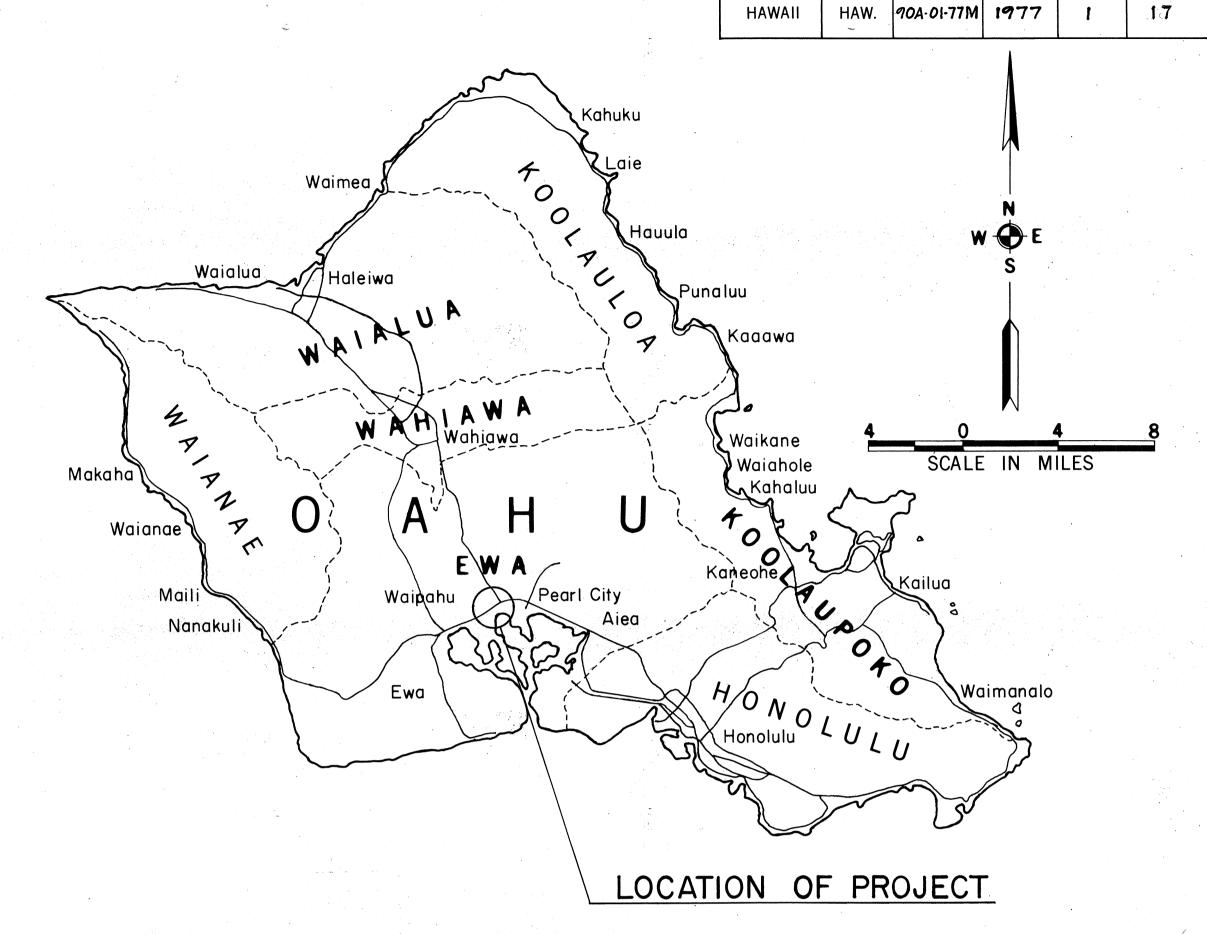

FED. ROAD STATE PROJ. NO.

