


QUANTITY SUMMARY FOR WILIKINA DRIVE AT KUNIA ROAD

Item No	Quantity	DESCRIPTION
621.5300	3 Ea.	Install R17-3 Sign with posts
623.2012	1 Ea.	Type II Traffic Signal Standard with 20 Foot Mastarm and Foundation
623.3001	2 Ea.	One new 12" R,Y,G Traffic Signal Head with Type I Mounting
623.3011	2 Ea.	One new 12" R,Y,G Traffic Signal Head and one new 12" R,Y,← Traffic Signal with Type II Mounting
623.3067	1 Ea.	One relocated 12" Traffic Signal Head (R,Y,G indication changed to R,Y,↑) with Type VI Mounting
623.3049	1 Ea.	One new 12" R,Y,← Programmed visibility Traffic Signal Head and one relocated 12" R,Y,↑ Traffic Signal Head with Type V Mounting
623.2003	1 Ea.	Relocated Type I Traffic Signal Standard and new foundation
623.4300	4 Ea.	One new Pedestrian Signal Head with Type IV Mounting
623.4400	1 Ea.	Two new Pedestrian Signal Head with Type V Mounting
623.6010	3 Ea.	Type "B" Pullbox
623.8060	2 Ea.	Loop Detector Sensing Unit (6 Ft. x 8 Ft.) 2 Loops
623.8050	3 Ea.	Loop Detector Sensing Unit (6 Ft. x 6 Ft.) 6 Loops
623.5000	265 L.F.	2 Inch Conduit
623.7020	1225 L.F.	No. 14 - 2 Conductor Loop Detector Cable
623.1010	340 L.F.	Pavement Striping
650.0010	1 Ea.	Type "A" Wheel Chair Ramp
650.0040	1 Ea.	Type "D" Wheel Chair Ramp
650.0050	6 Ea.	Type "E" Wheel Chair Ramp
623.3070	1 Ea.	Existing 12" Traffic Signal Head (R,Y,G indication changed to R,Y,↑)
623.4600	6 Ea.	Pedestrian Pushbutton with R10-4a Sign
415 L.F.		Pedestrian Pushbutton Control Cable (1-2c #14)

FED. ROAD DIST. NO.	STATE	FED. AID PROJ. NO.	FISCAL YEAR	SHEET NO.	TOTAL SHEETS
HAWAII	HAW.	HWY-0-03-75	1978	35	79

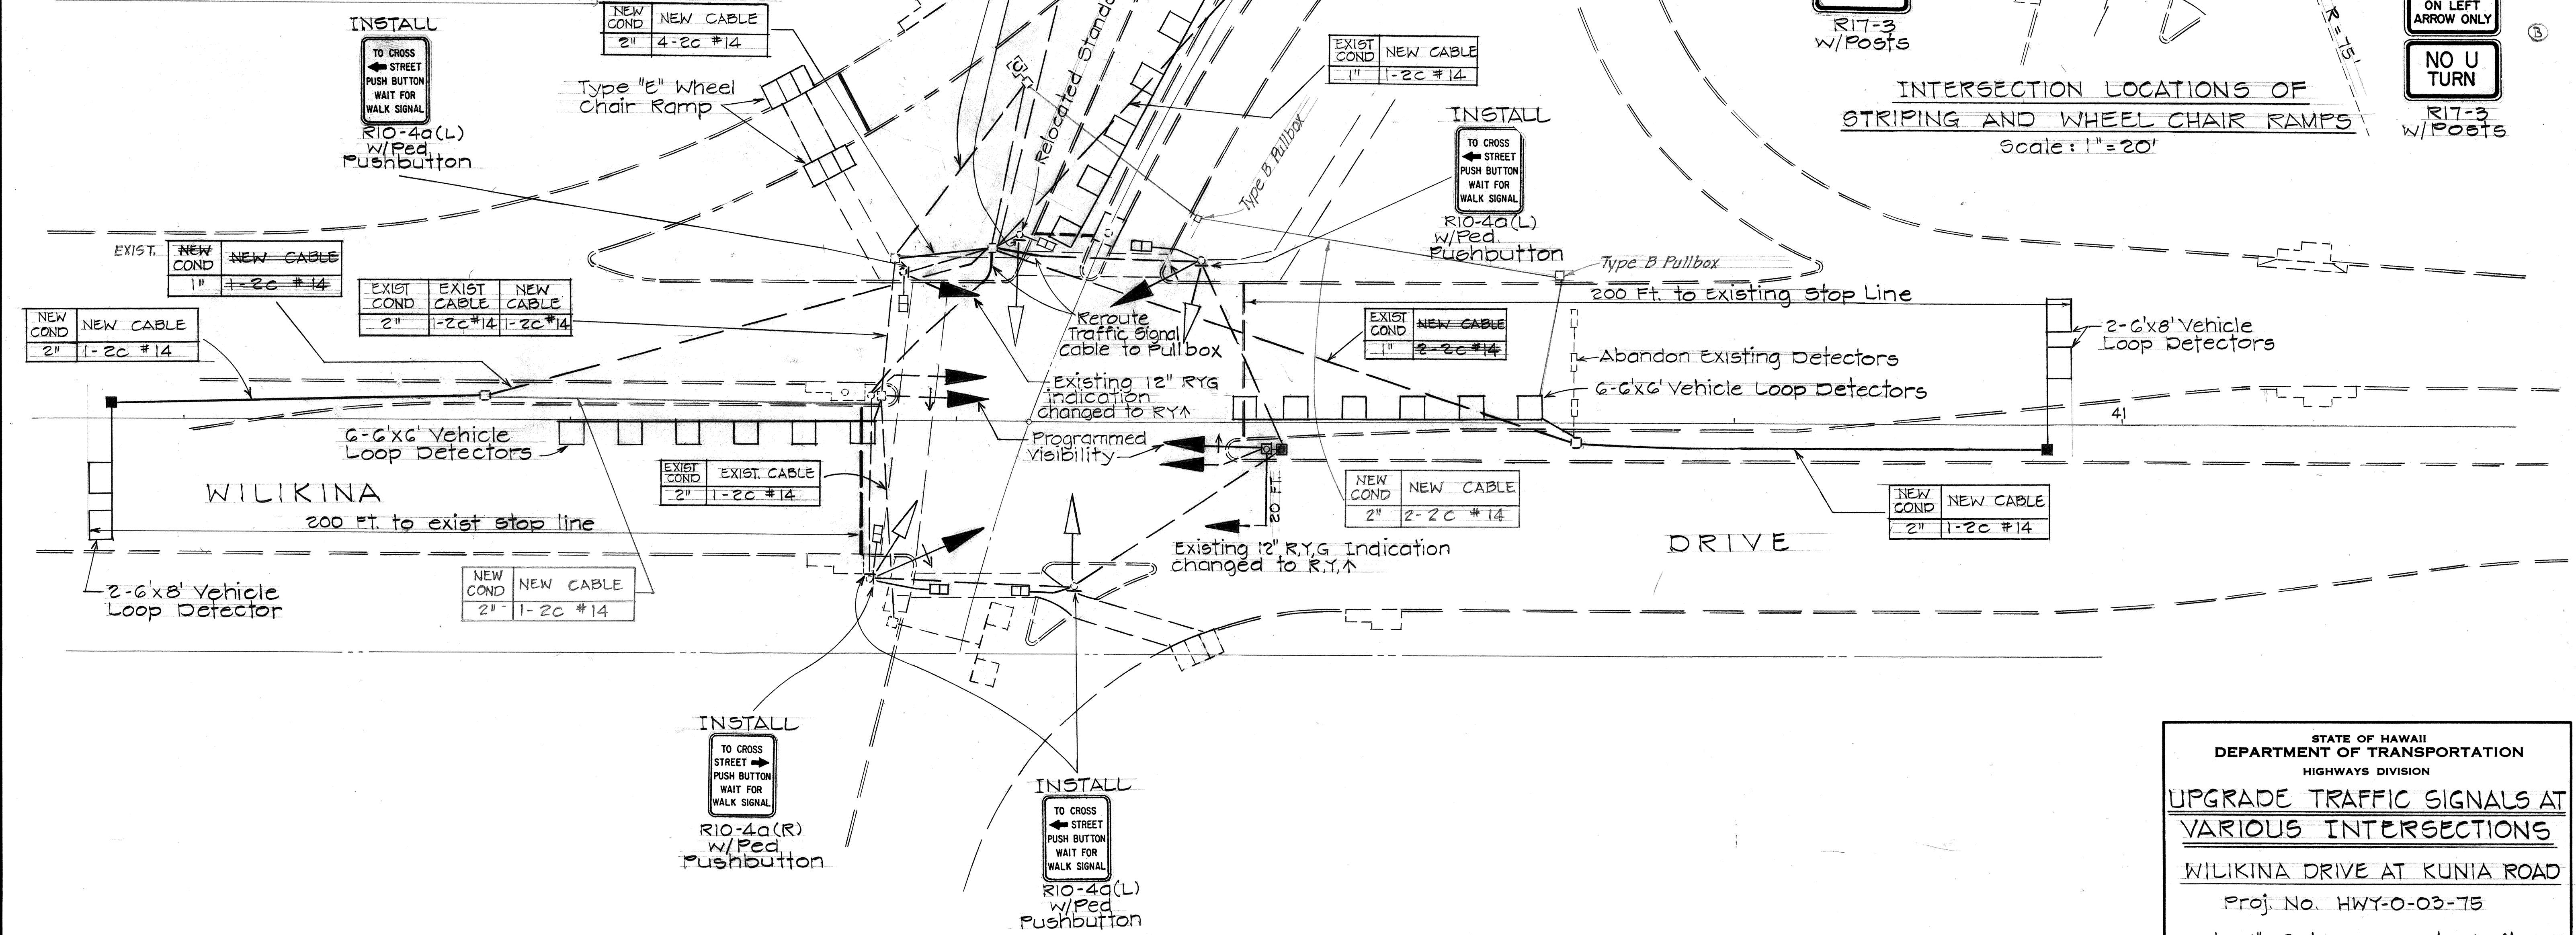

DATE	_____
DRAWN BY	_____
DESIGNED BY	_____
CHECKED BY	_____
ORIGINAL PLAN	_____
NOTE BOOK	_____
QUANTITIES BY	_____
CHECKED BY	_____

STATE OF HAWAII
DEPARTMENT OF TRANSPORTATION
HIGHWAYS DIVISION

**UPGRADE TRAFFIC SIGNALS AT
VARIOUS INTERSECTIONS**

WILIKINA DRIVE AT KUNIA ROAD

Proj. No. HWY-0-03-75

Scale: 1" = 20' Date: April 1977

SHEET NO. 31 OF 49 SHEETS